
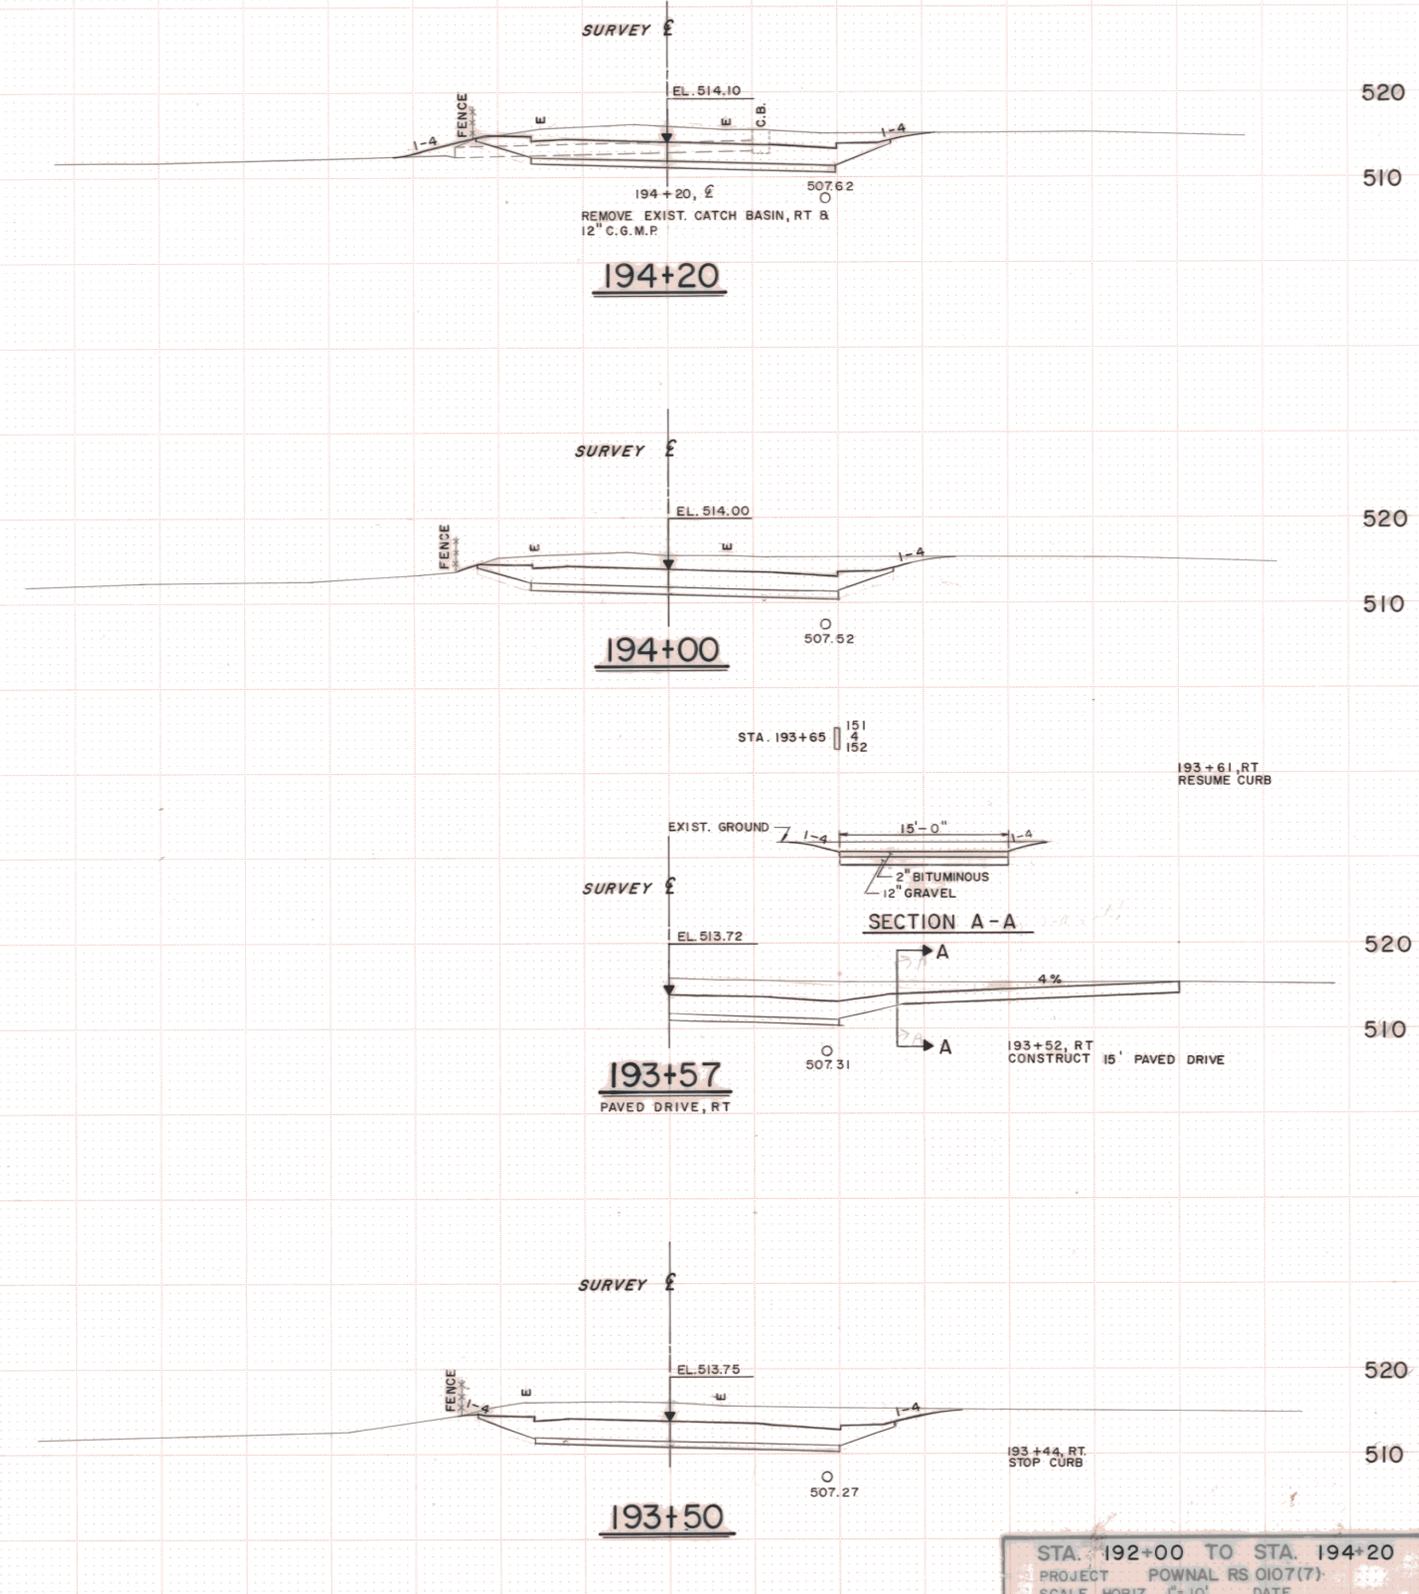


DATE: _____ BY: _____
 REVISIONS:
 1. _____
 2. _____
 3. _____
 4. _____
 5. _____
 6. _____
 7. _____
 8. _____
 9. _____
 10. _____

DATE: _____ BY: _____
 REVISIONS:
 1. _____
 2. _____
 3. _____
 4. _____
 5. _____
 6. _____
 7. _____
 8. _____
 9. _____
 10. _____

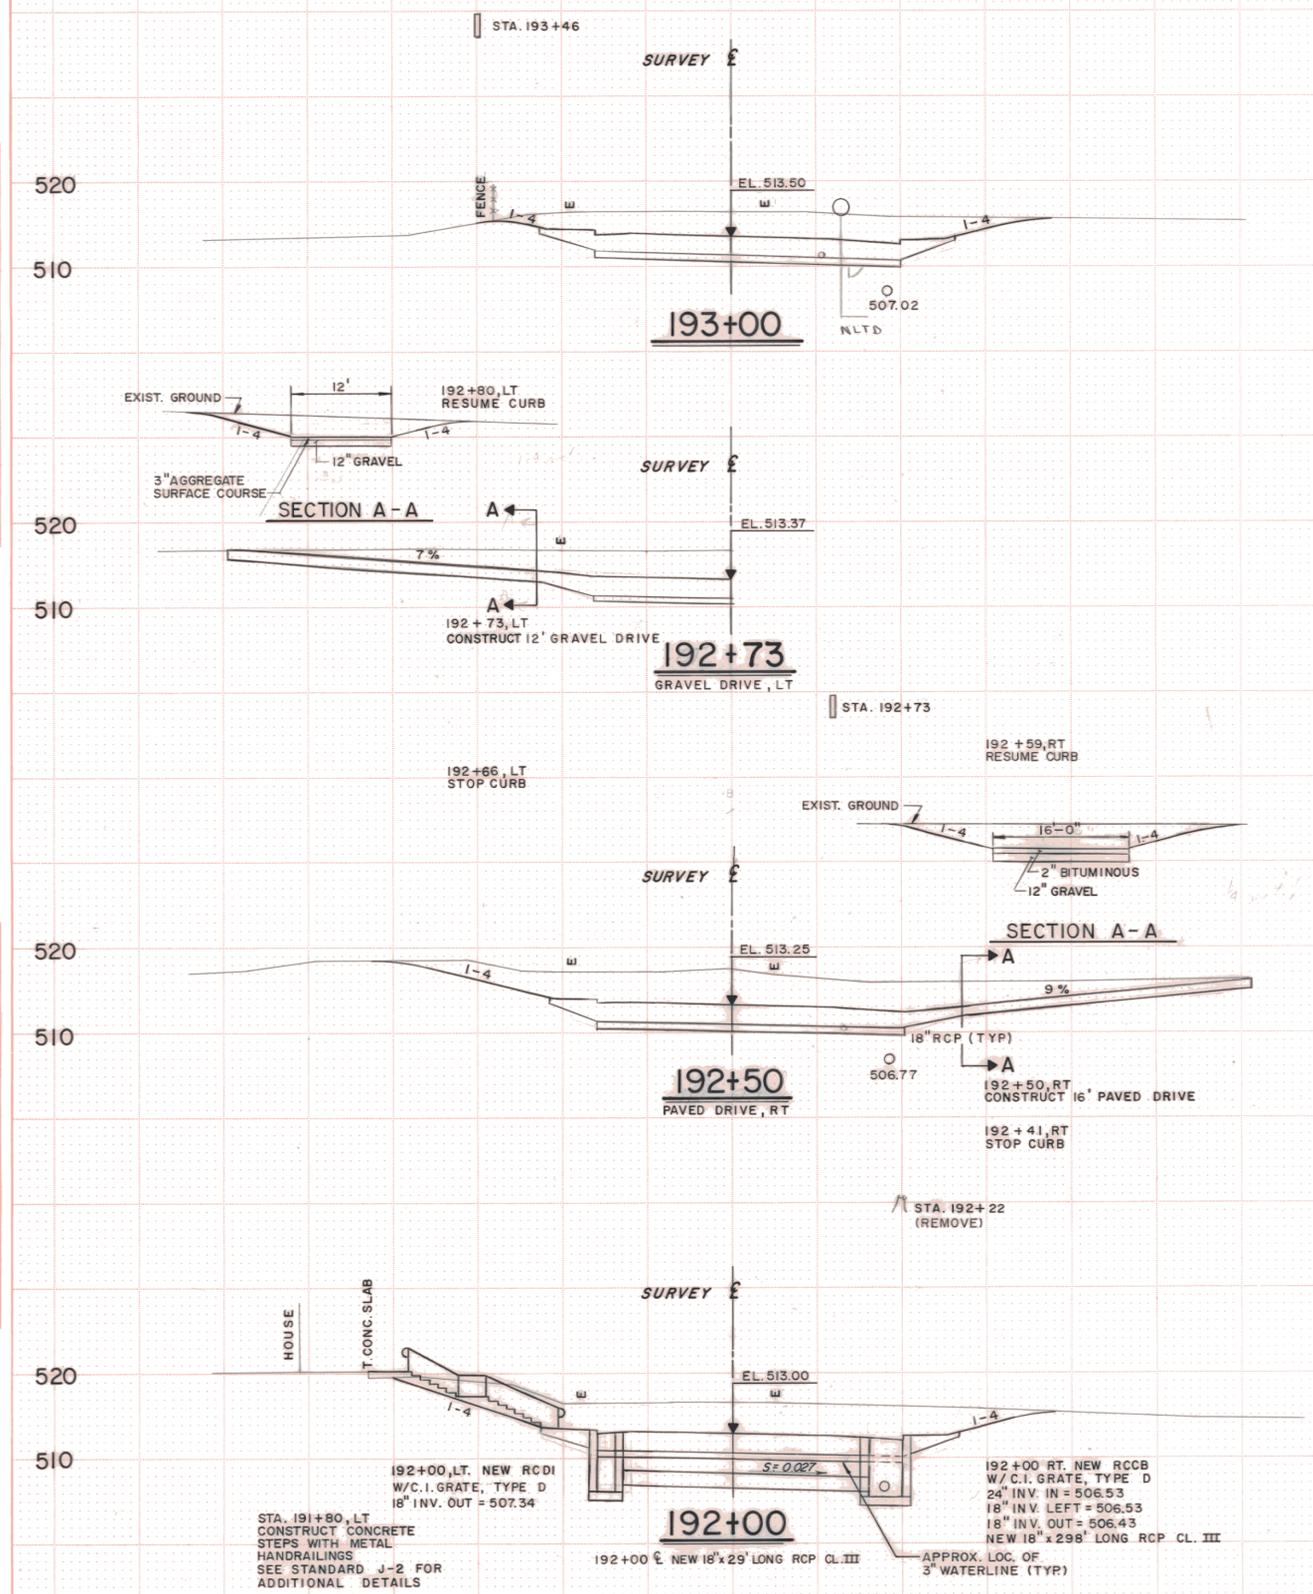

STA. 191+80, LT
 CONSTRUCT CONCRETE
 STEPS WITH METAL
 HANDRAILINGS
 SEE STANDARD J-2 FOR
 ADDITIONAL DETAILS

192+00 LT. NEW RCDI
 W/C.I. GRATE, TYPE D
 18" INV. OUT = 507.34

192+00 RT. NEW RCCB
 W/C.I. GRATE, TYPE D
 24" INV. IN = 506.53
 18" INV. LEFT = 506.53
 18" INV. OUT = 506.43
 NEW 18" x 298' LONG RCP CL. III

APPROX. LOC. OF
 3" WATERLINE (TYP)

STA. 192+00 TO STA. 194+20
 PROJECT POWNAL RS 0107(7)
 SCALE HORIZ. 1" = 10' DATE _____
 VERT. 1" = 10' SHEET 293 OF 319