


DATE: _____
 BY: _____
 REVIEWED: _____
 PLOTTED: _____
 TEMPLATE: _____
 NOTE BOOK: _____
 AREAS CHECKED: _____

DATE: _____
 BY: _____
 REVIEWED: _____
 PLOTTED: _____
 TEMPLATE: _____
 NOTE BOOK: _____
 AREAS CHECKED: _____

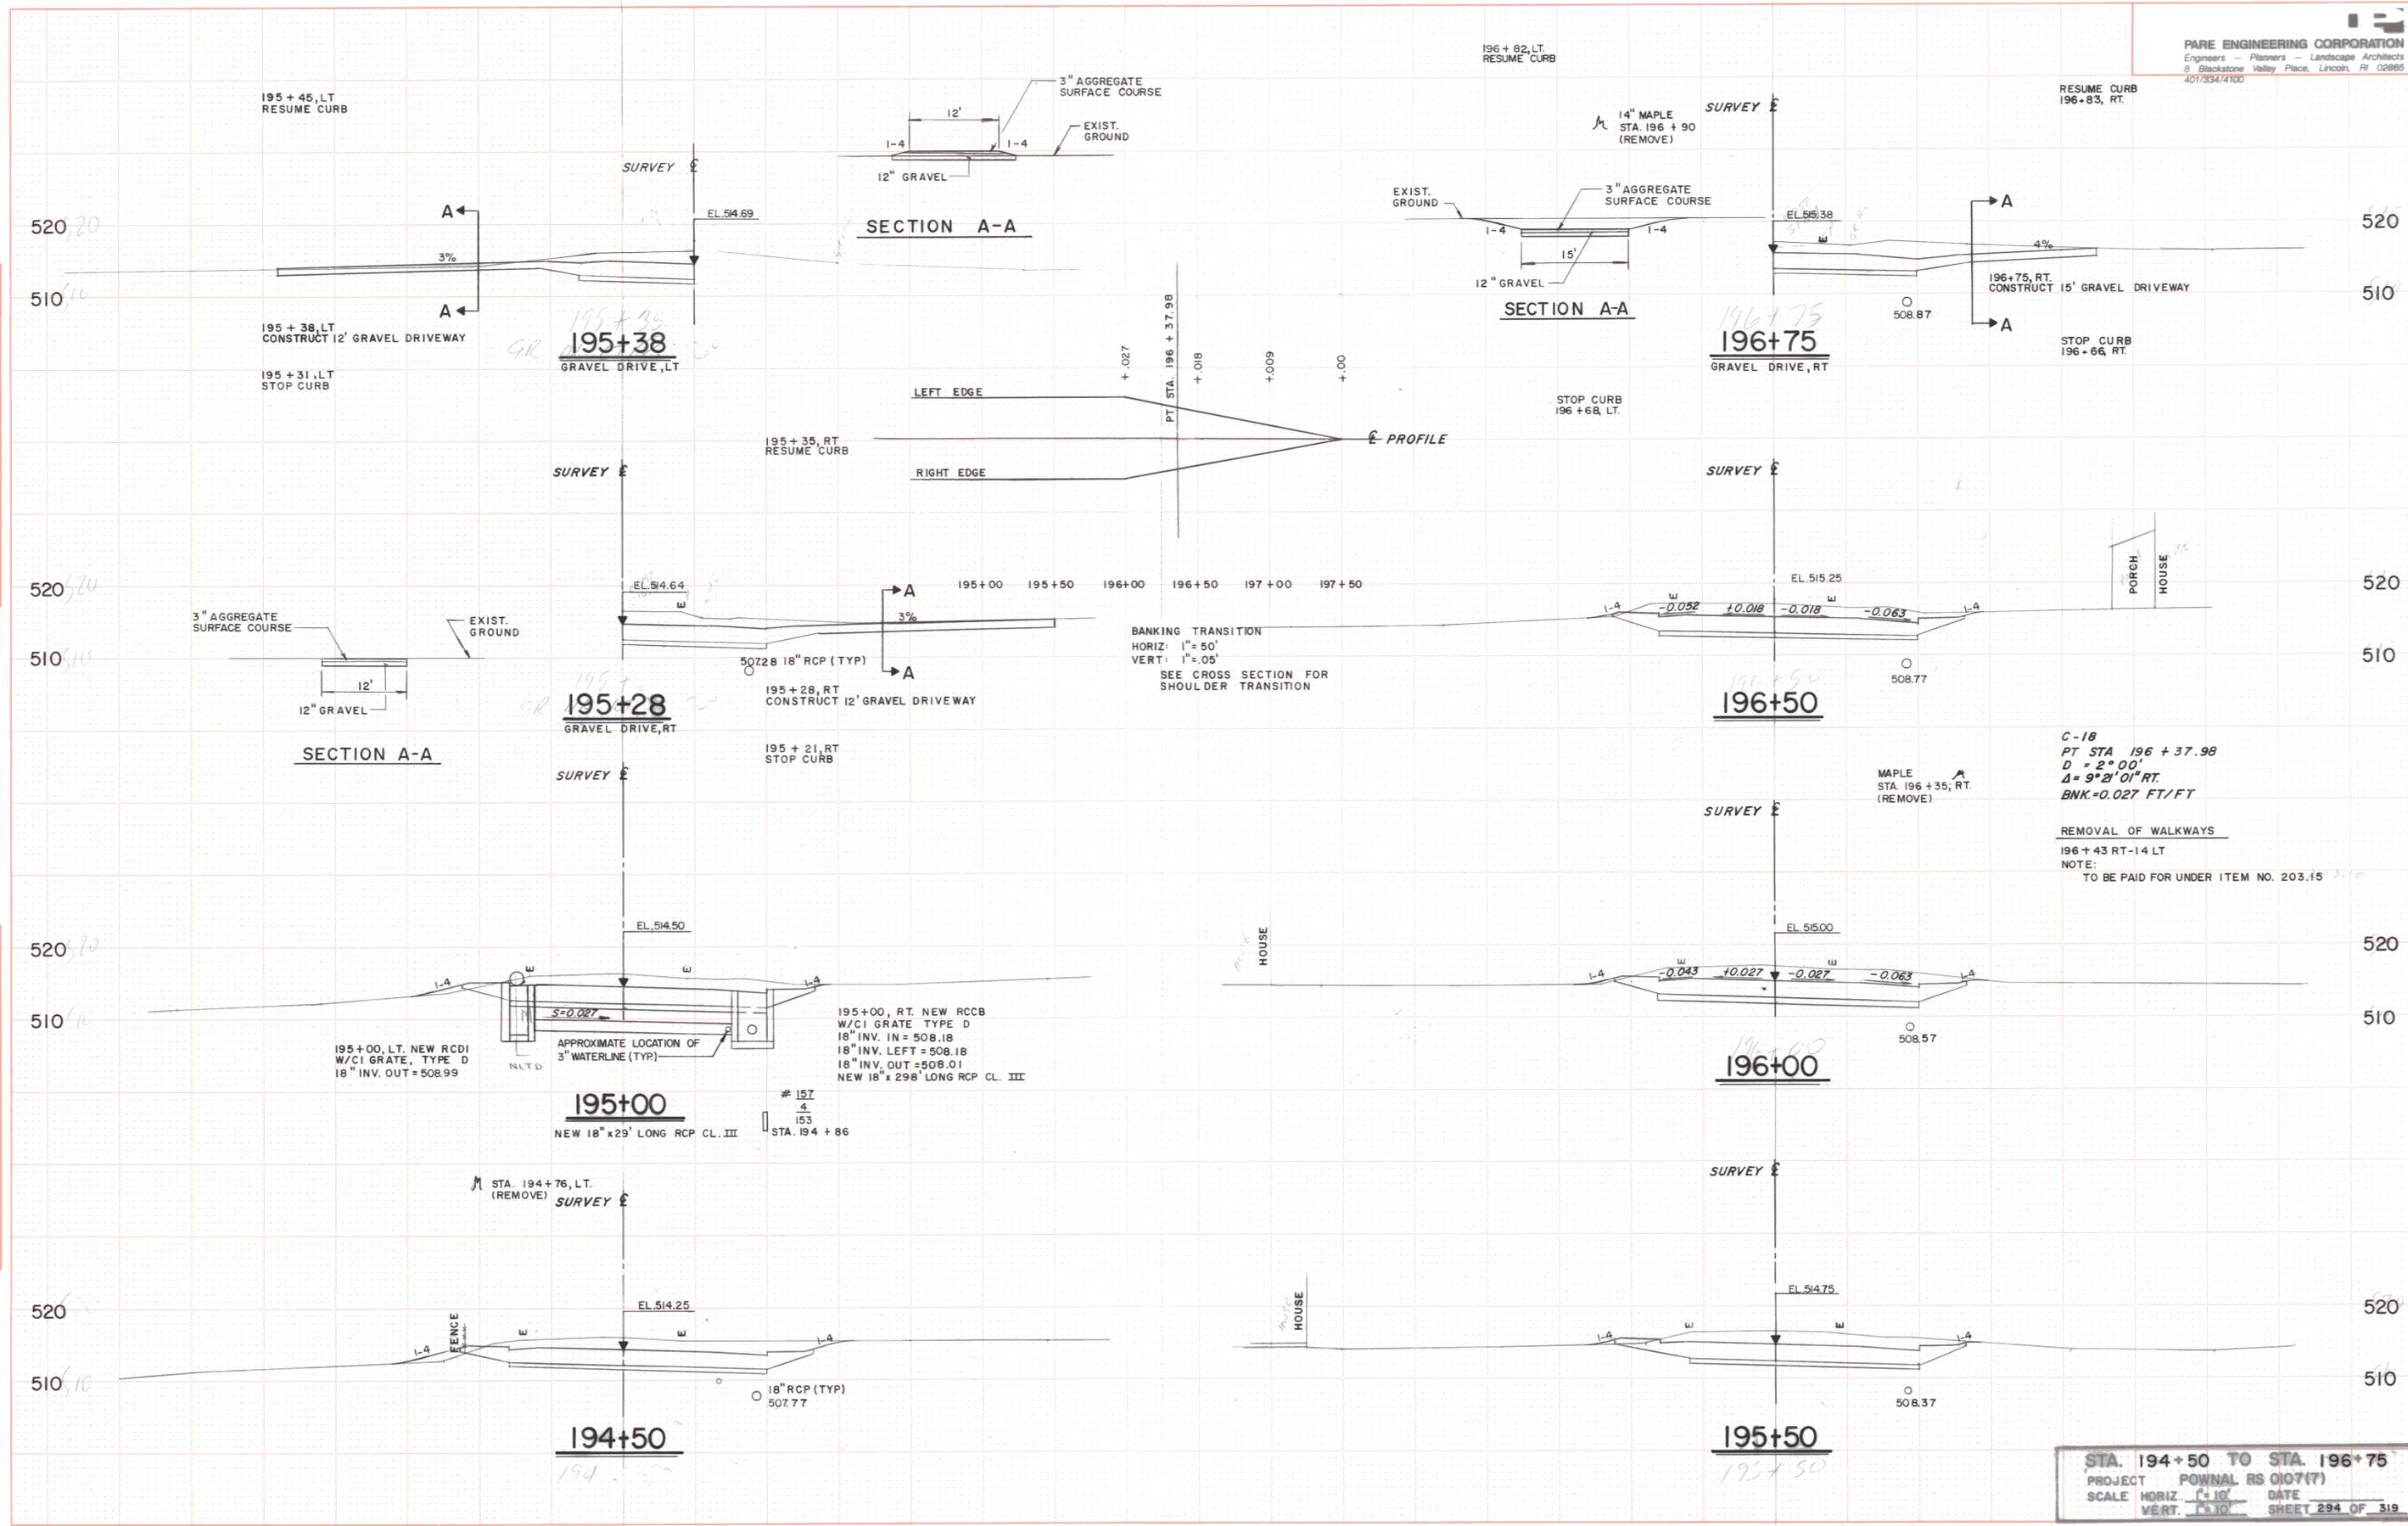

STA. 194+50 TO STA. 196+75
 PROJECT: POWNAL RS 0107(7)
 SCALE: HORIZ. 1" = 10' DATE: _____
 VERT. 1" = 10' SHEET 294 OF 319