


DATE	
BY	
REVISIONS	
NO.	
DATE	
BY	
REVISIONS	
NO.	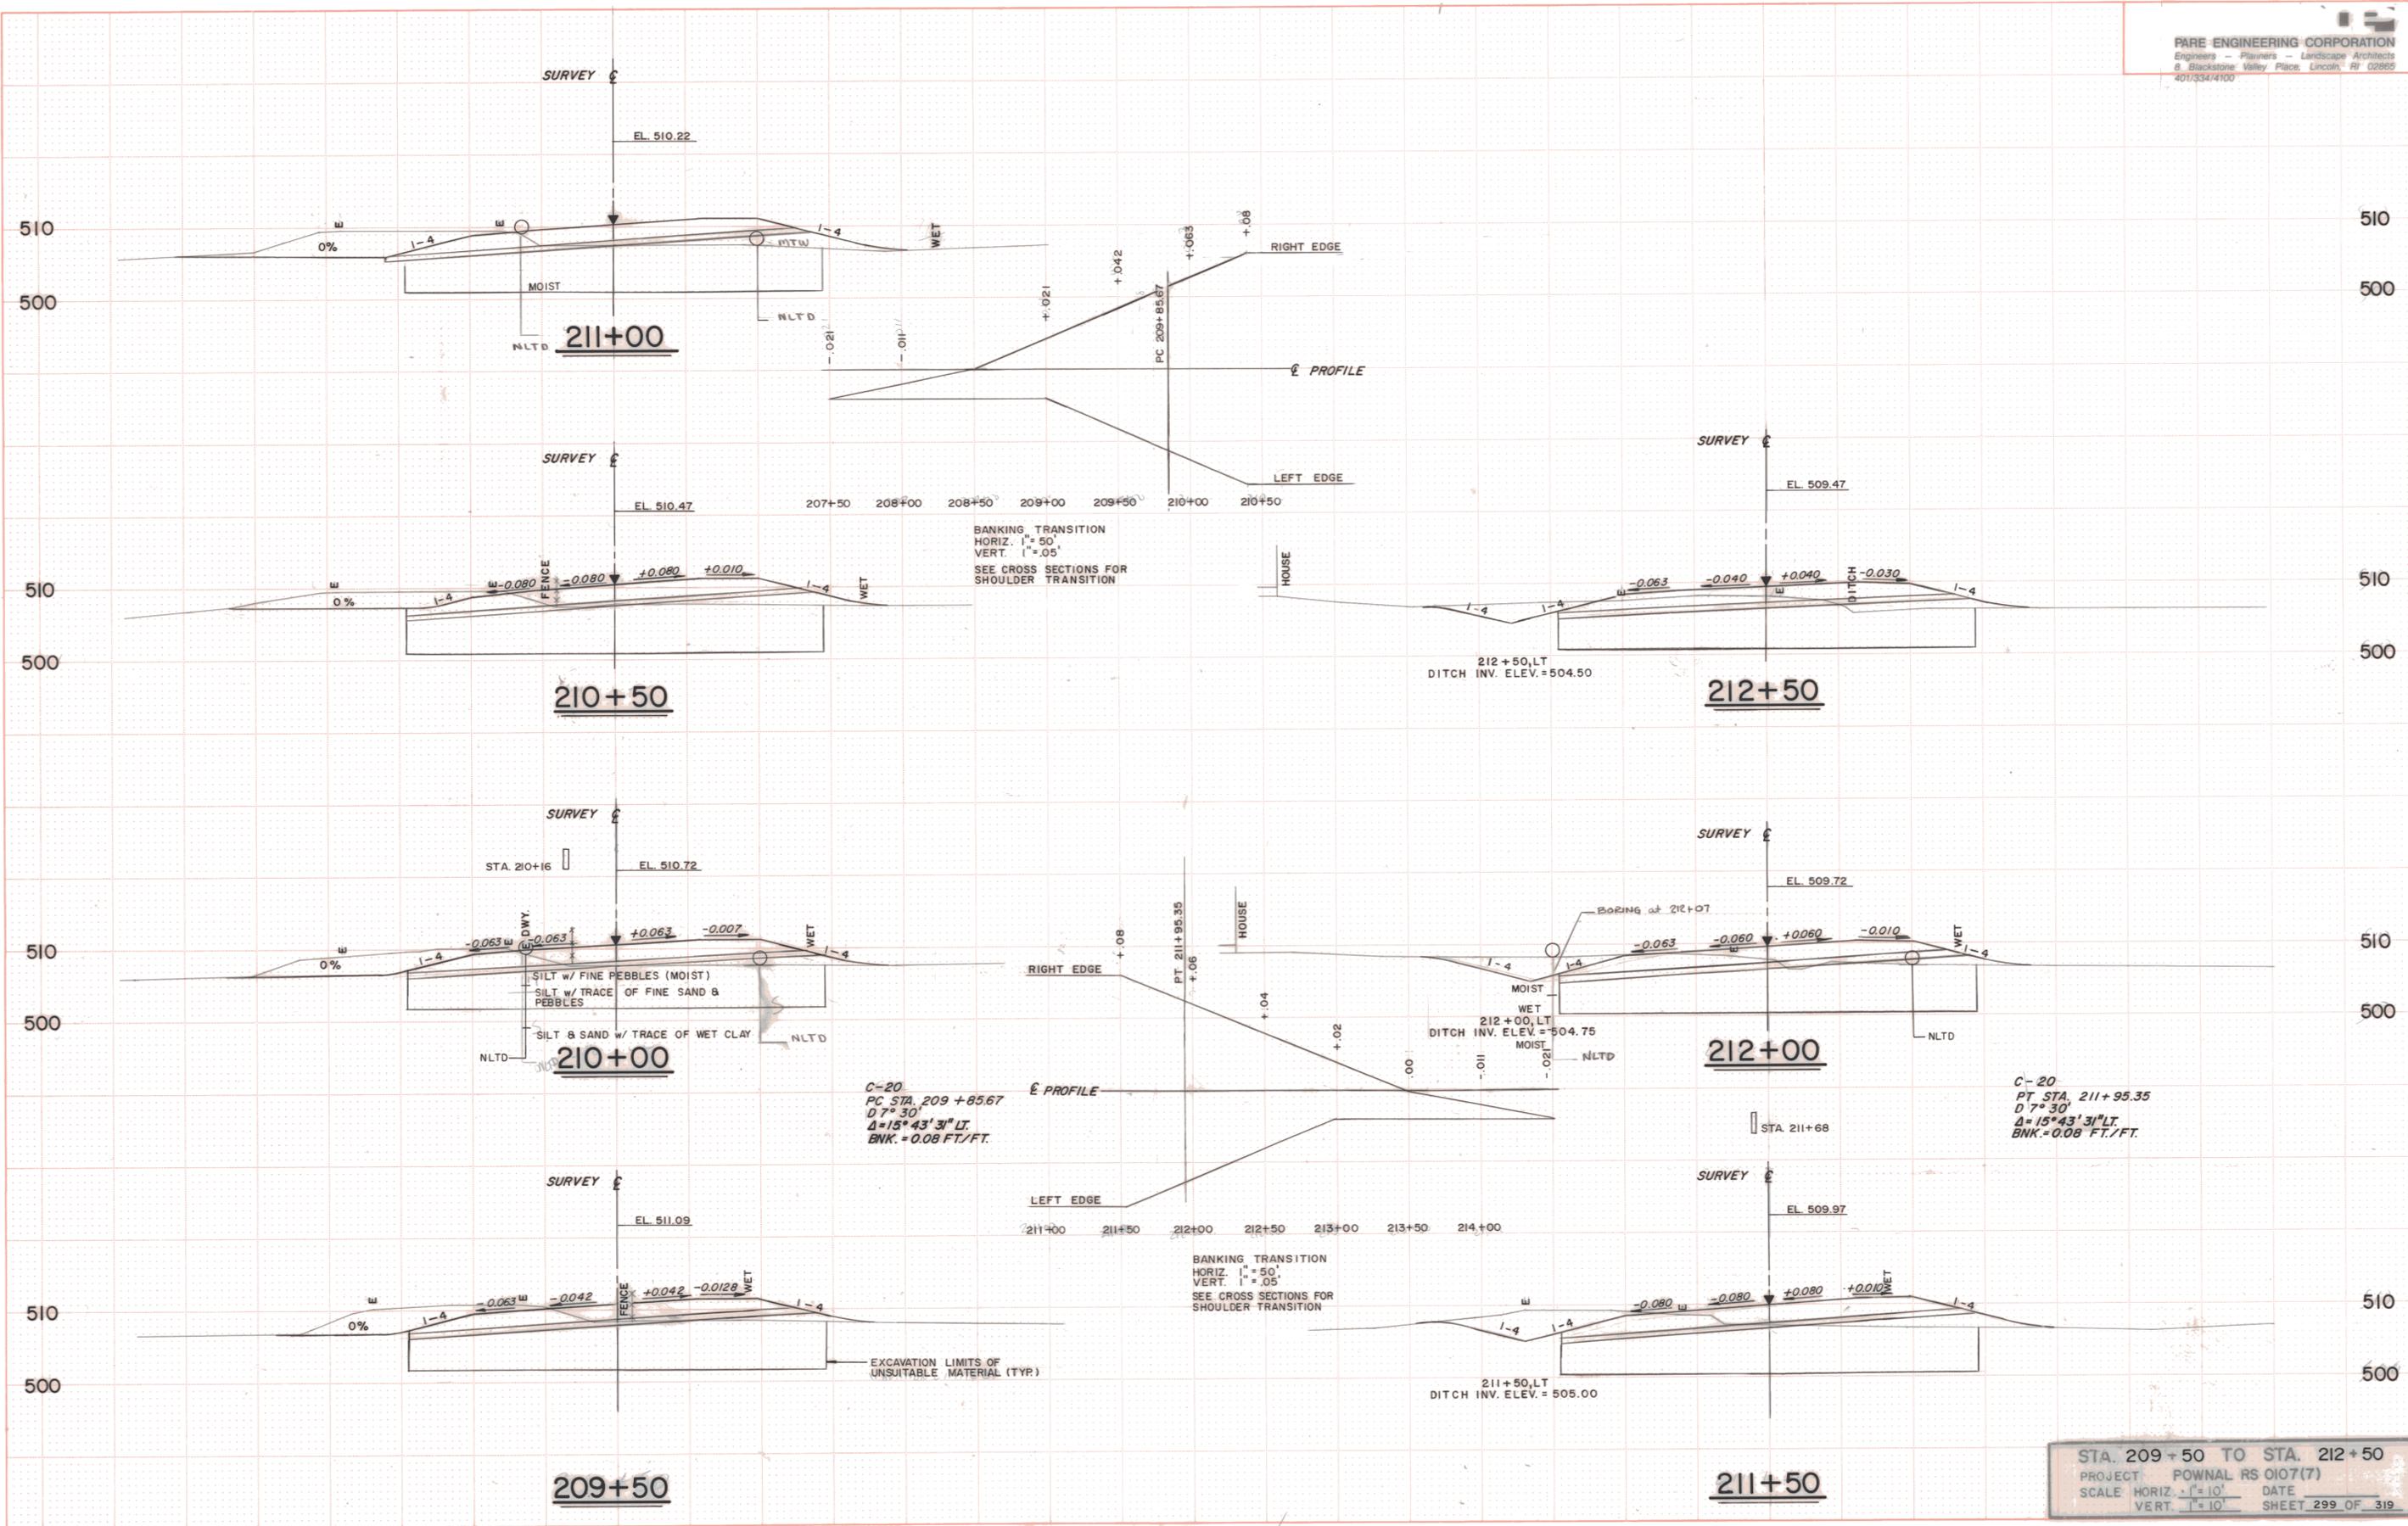
STA. 209+50 TO STA. 212+50
 PROJECT: POWNAL RS 0107(7)
 SCALE: HORIZ. 1"=10' DATE: _____
 VERT. 1"=10' SHEET 299 OF 319