
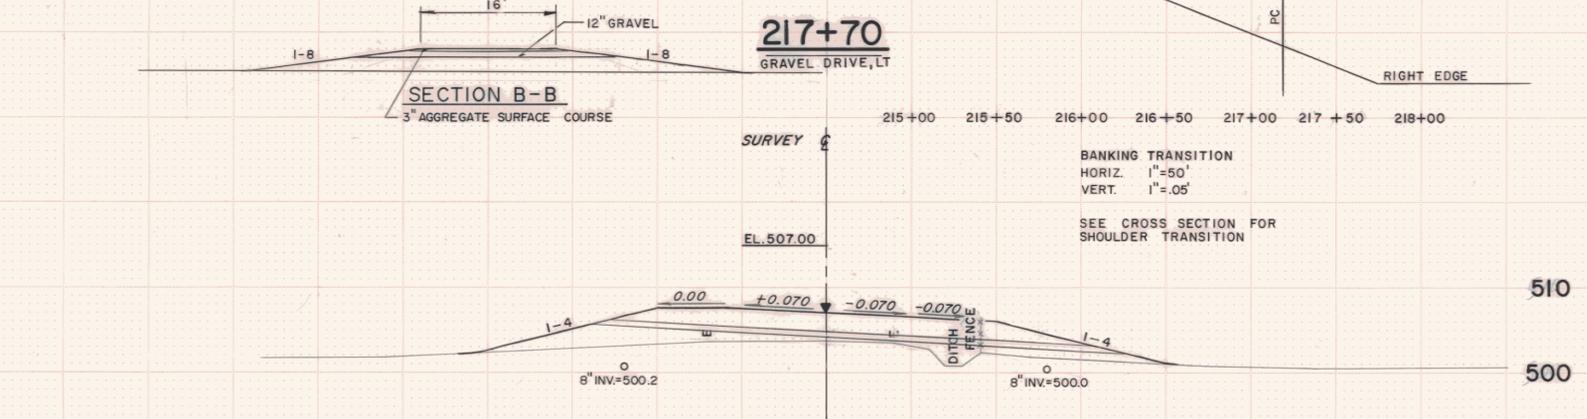
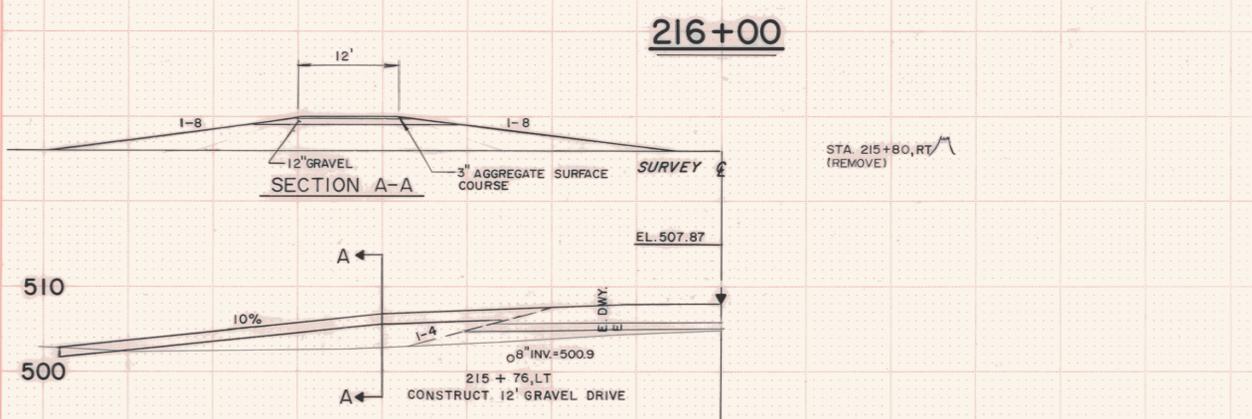
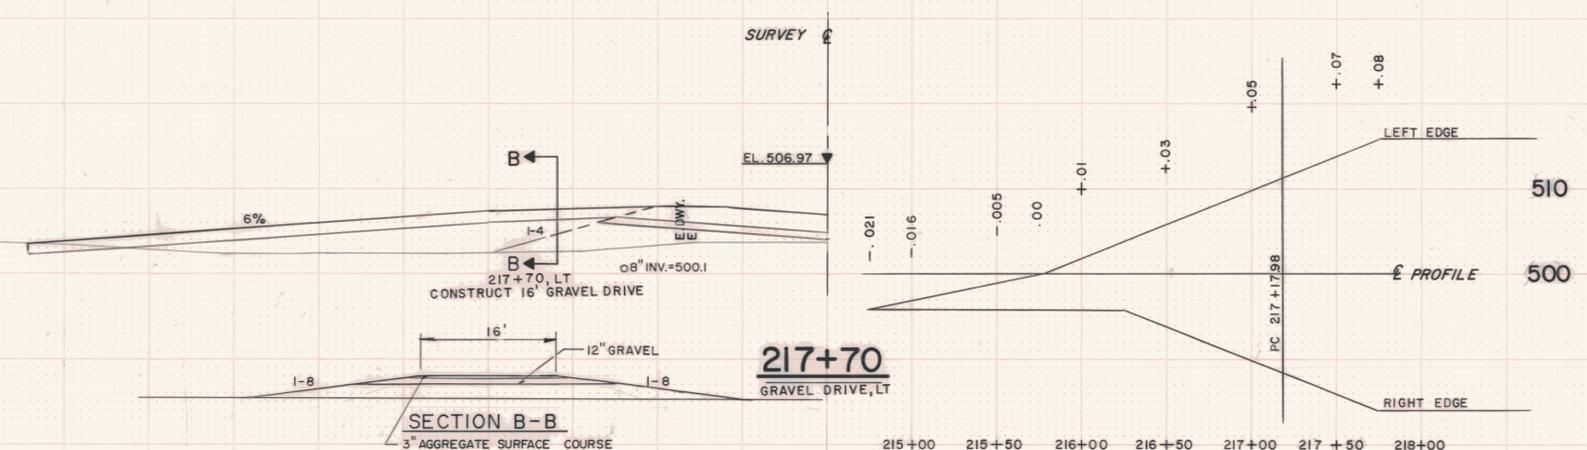
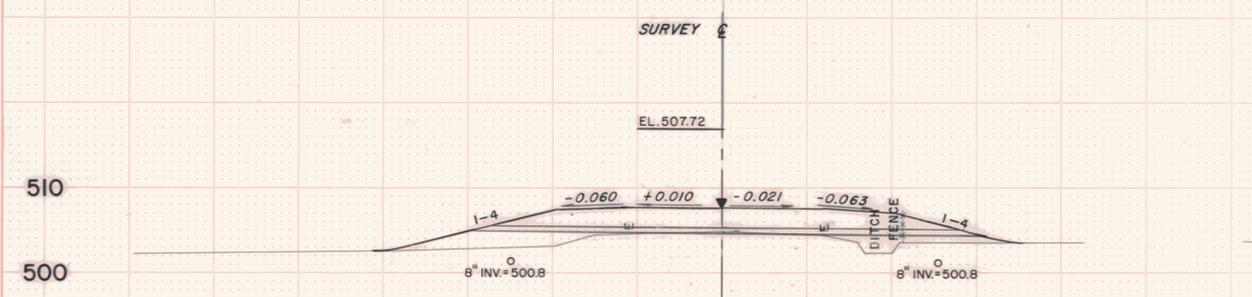
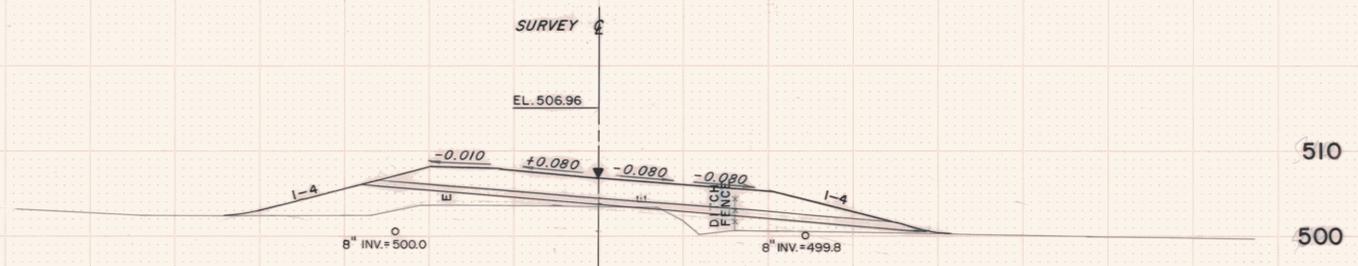
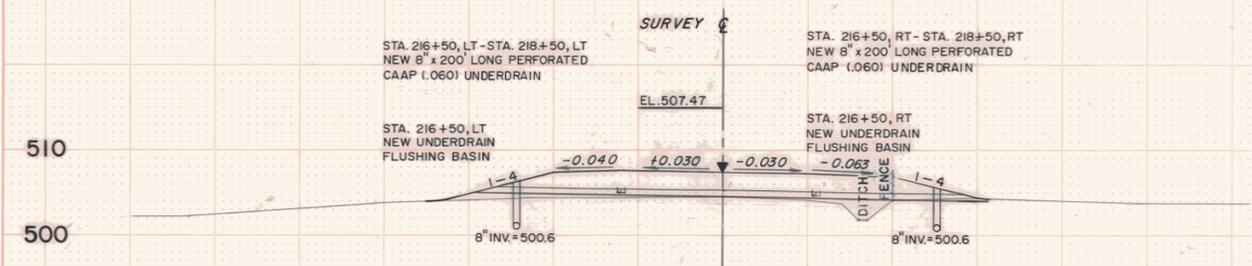
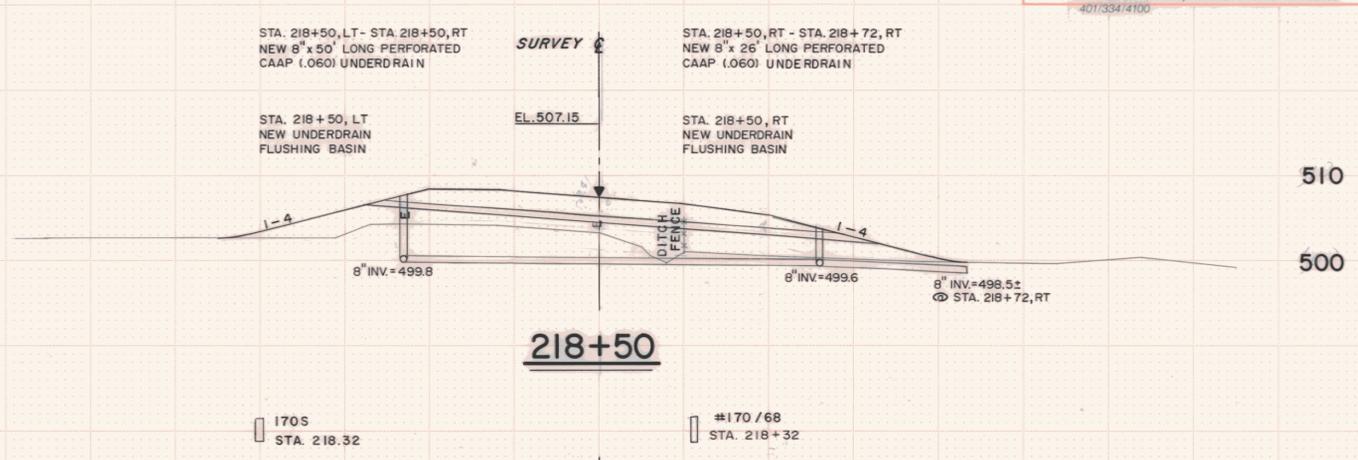


C-21
 PC 217+17.98
 D 7° 30'
 Δ=34° 51' 48" RT
 BNK.= 0.08 FT./FT.

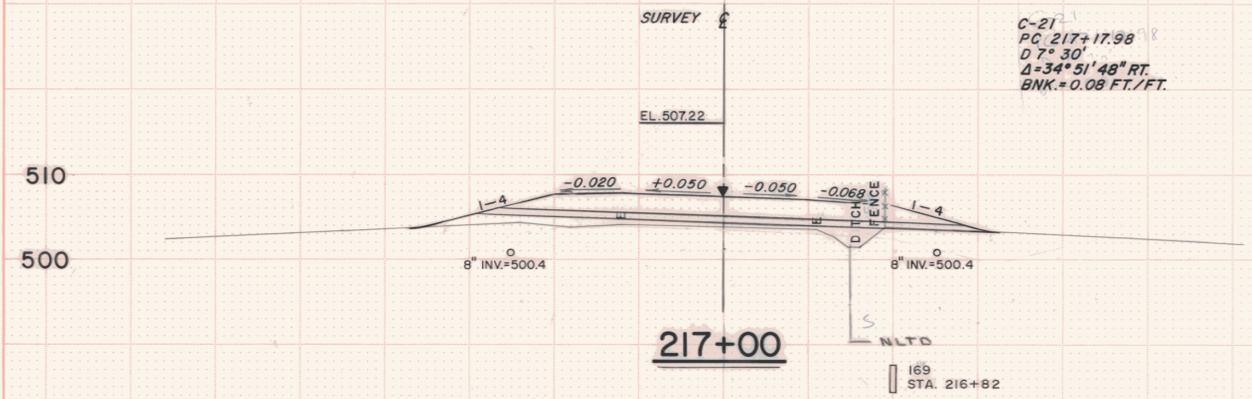

BANKING TRANSITION
 HORIZ. 1"=50'
 VERT. 1"=.05'
 SEE CROSS SECTION FOR
 SHOULDER TRANSITION

STA. 215+70 TO STA. 218+50
 PROJECT POWNAL RS 0107(7)
 SCALE HORIZ. 1"=10' DATE
 VERT. 1"=10' SHEET 301 OF 319