
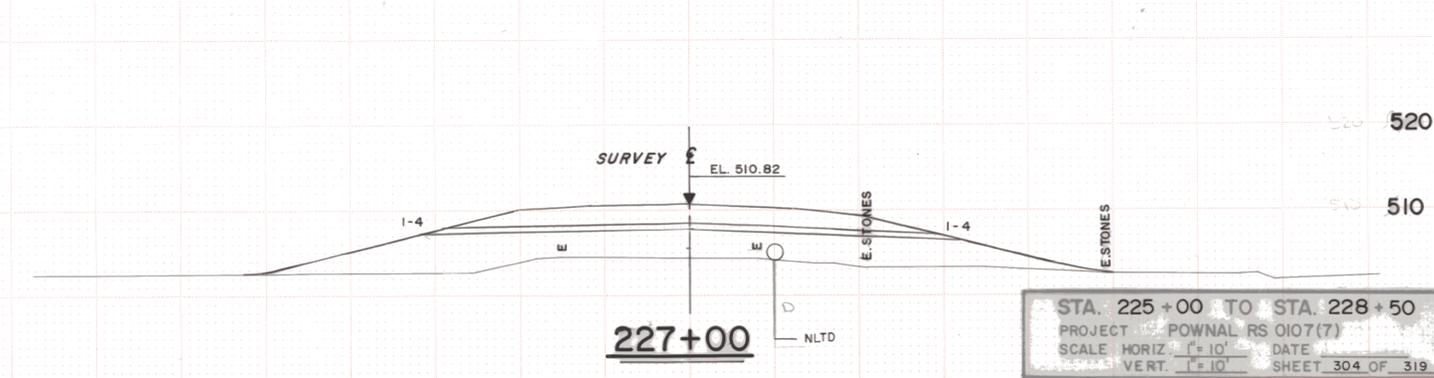
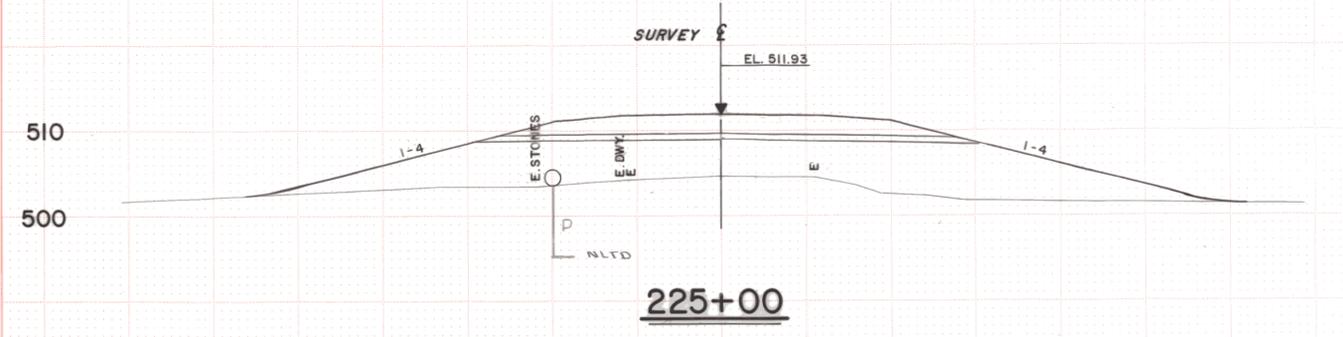
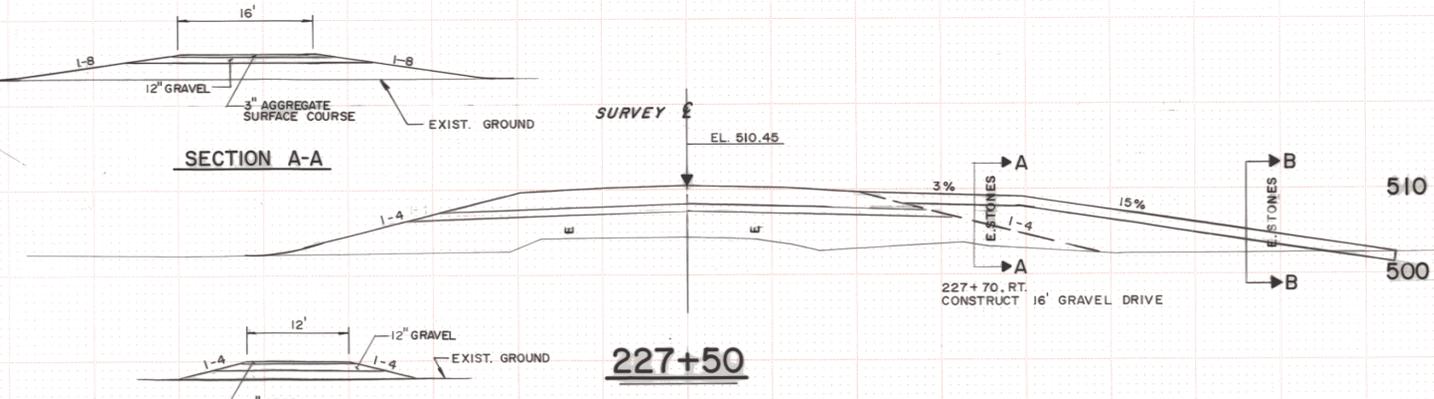
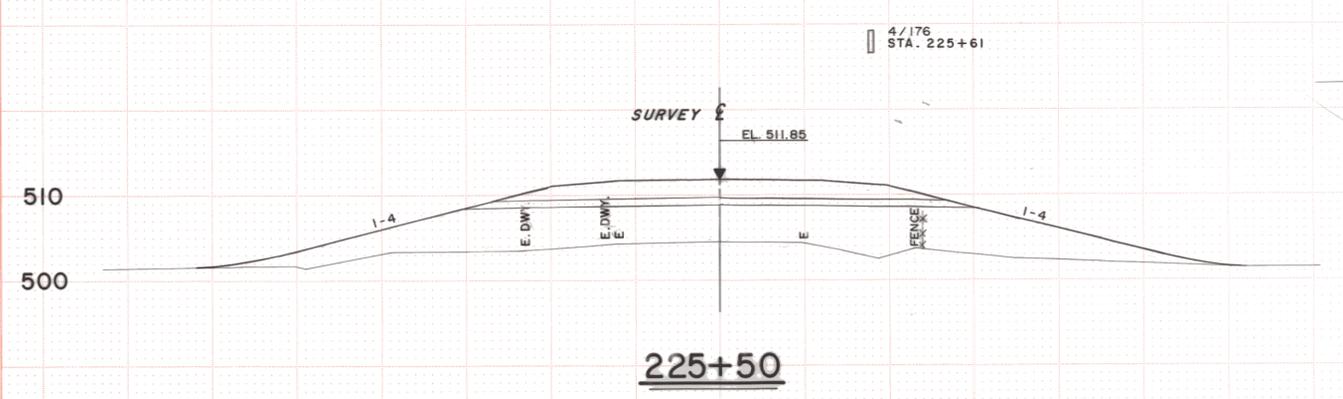
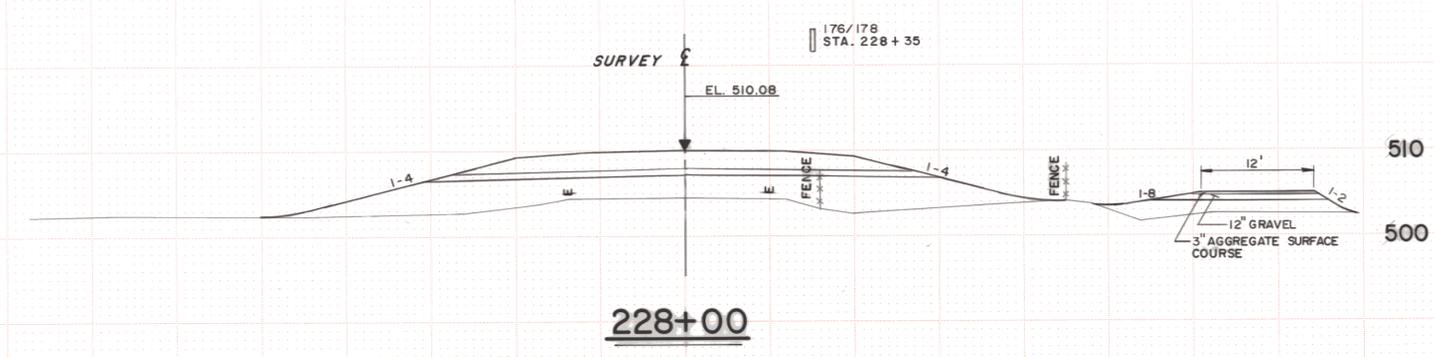
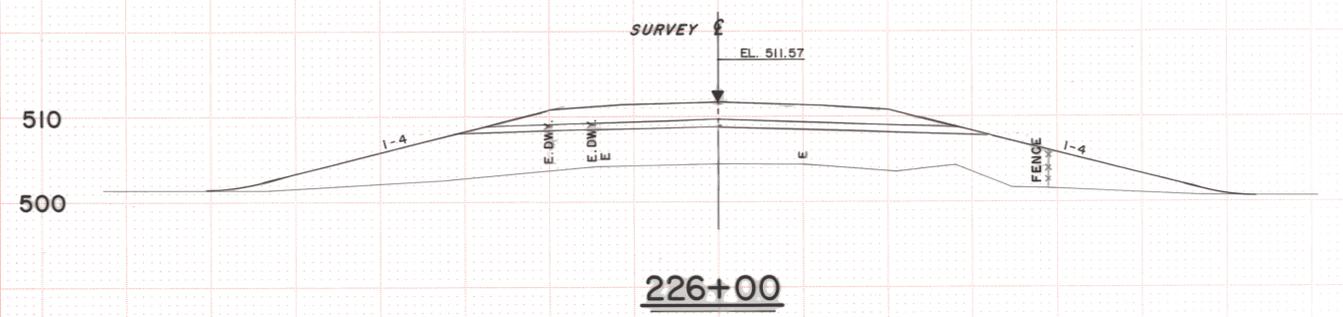
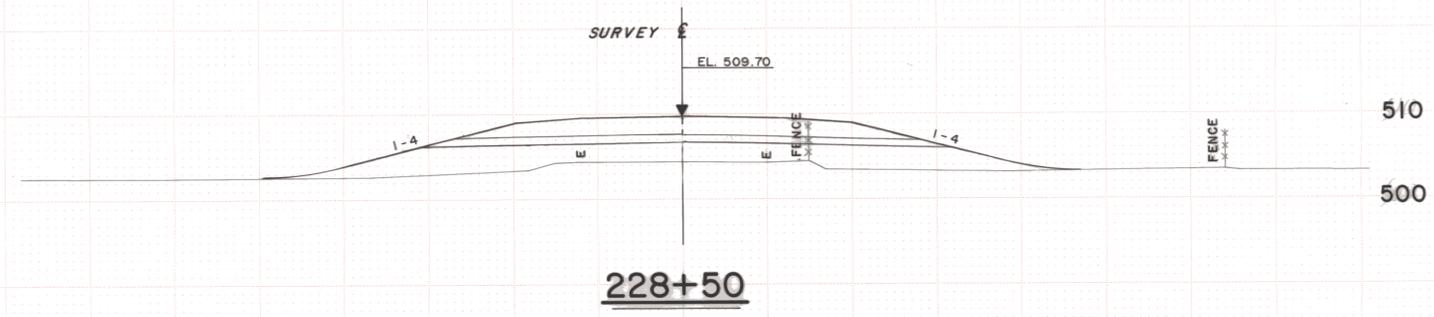


FINAL SURVEY  
 BY: \_\_\_\_\_ DATE: \_\_\_\_\_  
 SURVEY NO.: \_\_\_\_\_  
 NOTE BOOK NO.: \_\_\_\_\_  
 TEMPLATE NO.: \_\_\_\_\_  
 AREA CHECKED: \_\_\_\_\_

ORIGINAL SURVEY  
 BY: \_\_\_\_\_ DATE: \_\_\_\_\_  
 SURVEY NO.: \_\_\_\_\_  
 NOTE BOOK NO.: \_\_\_\_\_  
 TEMPLATE NO.: \_\_\_\_\_  
 AREA CHECKED: \_\_\_\_\_

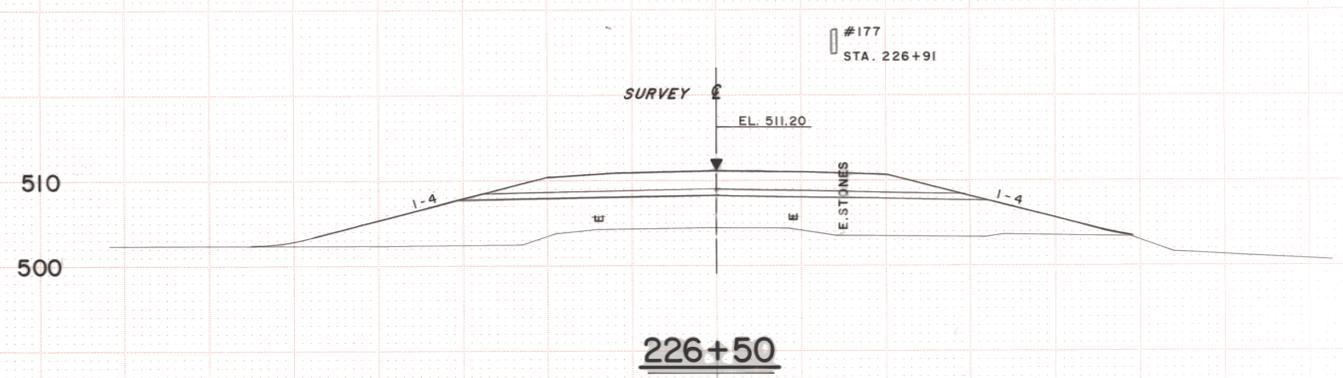

STA. 225+00 TO STA. 228+50  
 PROJECT POWNAL RS 0107(7)  
 SCALE HORIZ. 1"=10' DATE \_\_\_\_\_  
 VERT. 1"=10' SHEET 304 OF 319