


DATE	
BY	
FINAL SURVEY	SURVEYED
PLOTTED	
NOTE BOOK NO.	TEMP. PLATE NO.
AREAS CHECKED	

DATE	
BY	
ORIGINAL SURVEY	SURVEYED
PLOTTED	
NOTE BOOK NO.	TEMP. PLATE NO.
AREAS CHECKED	

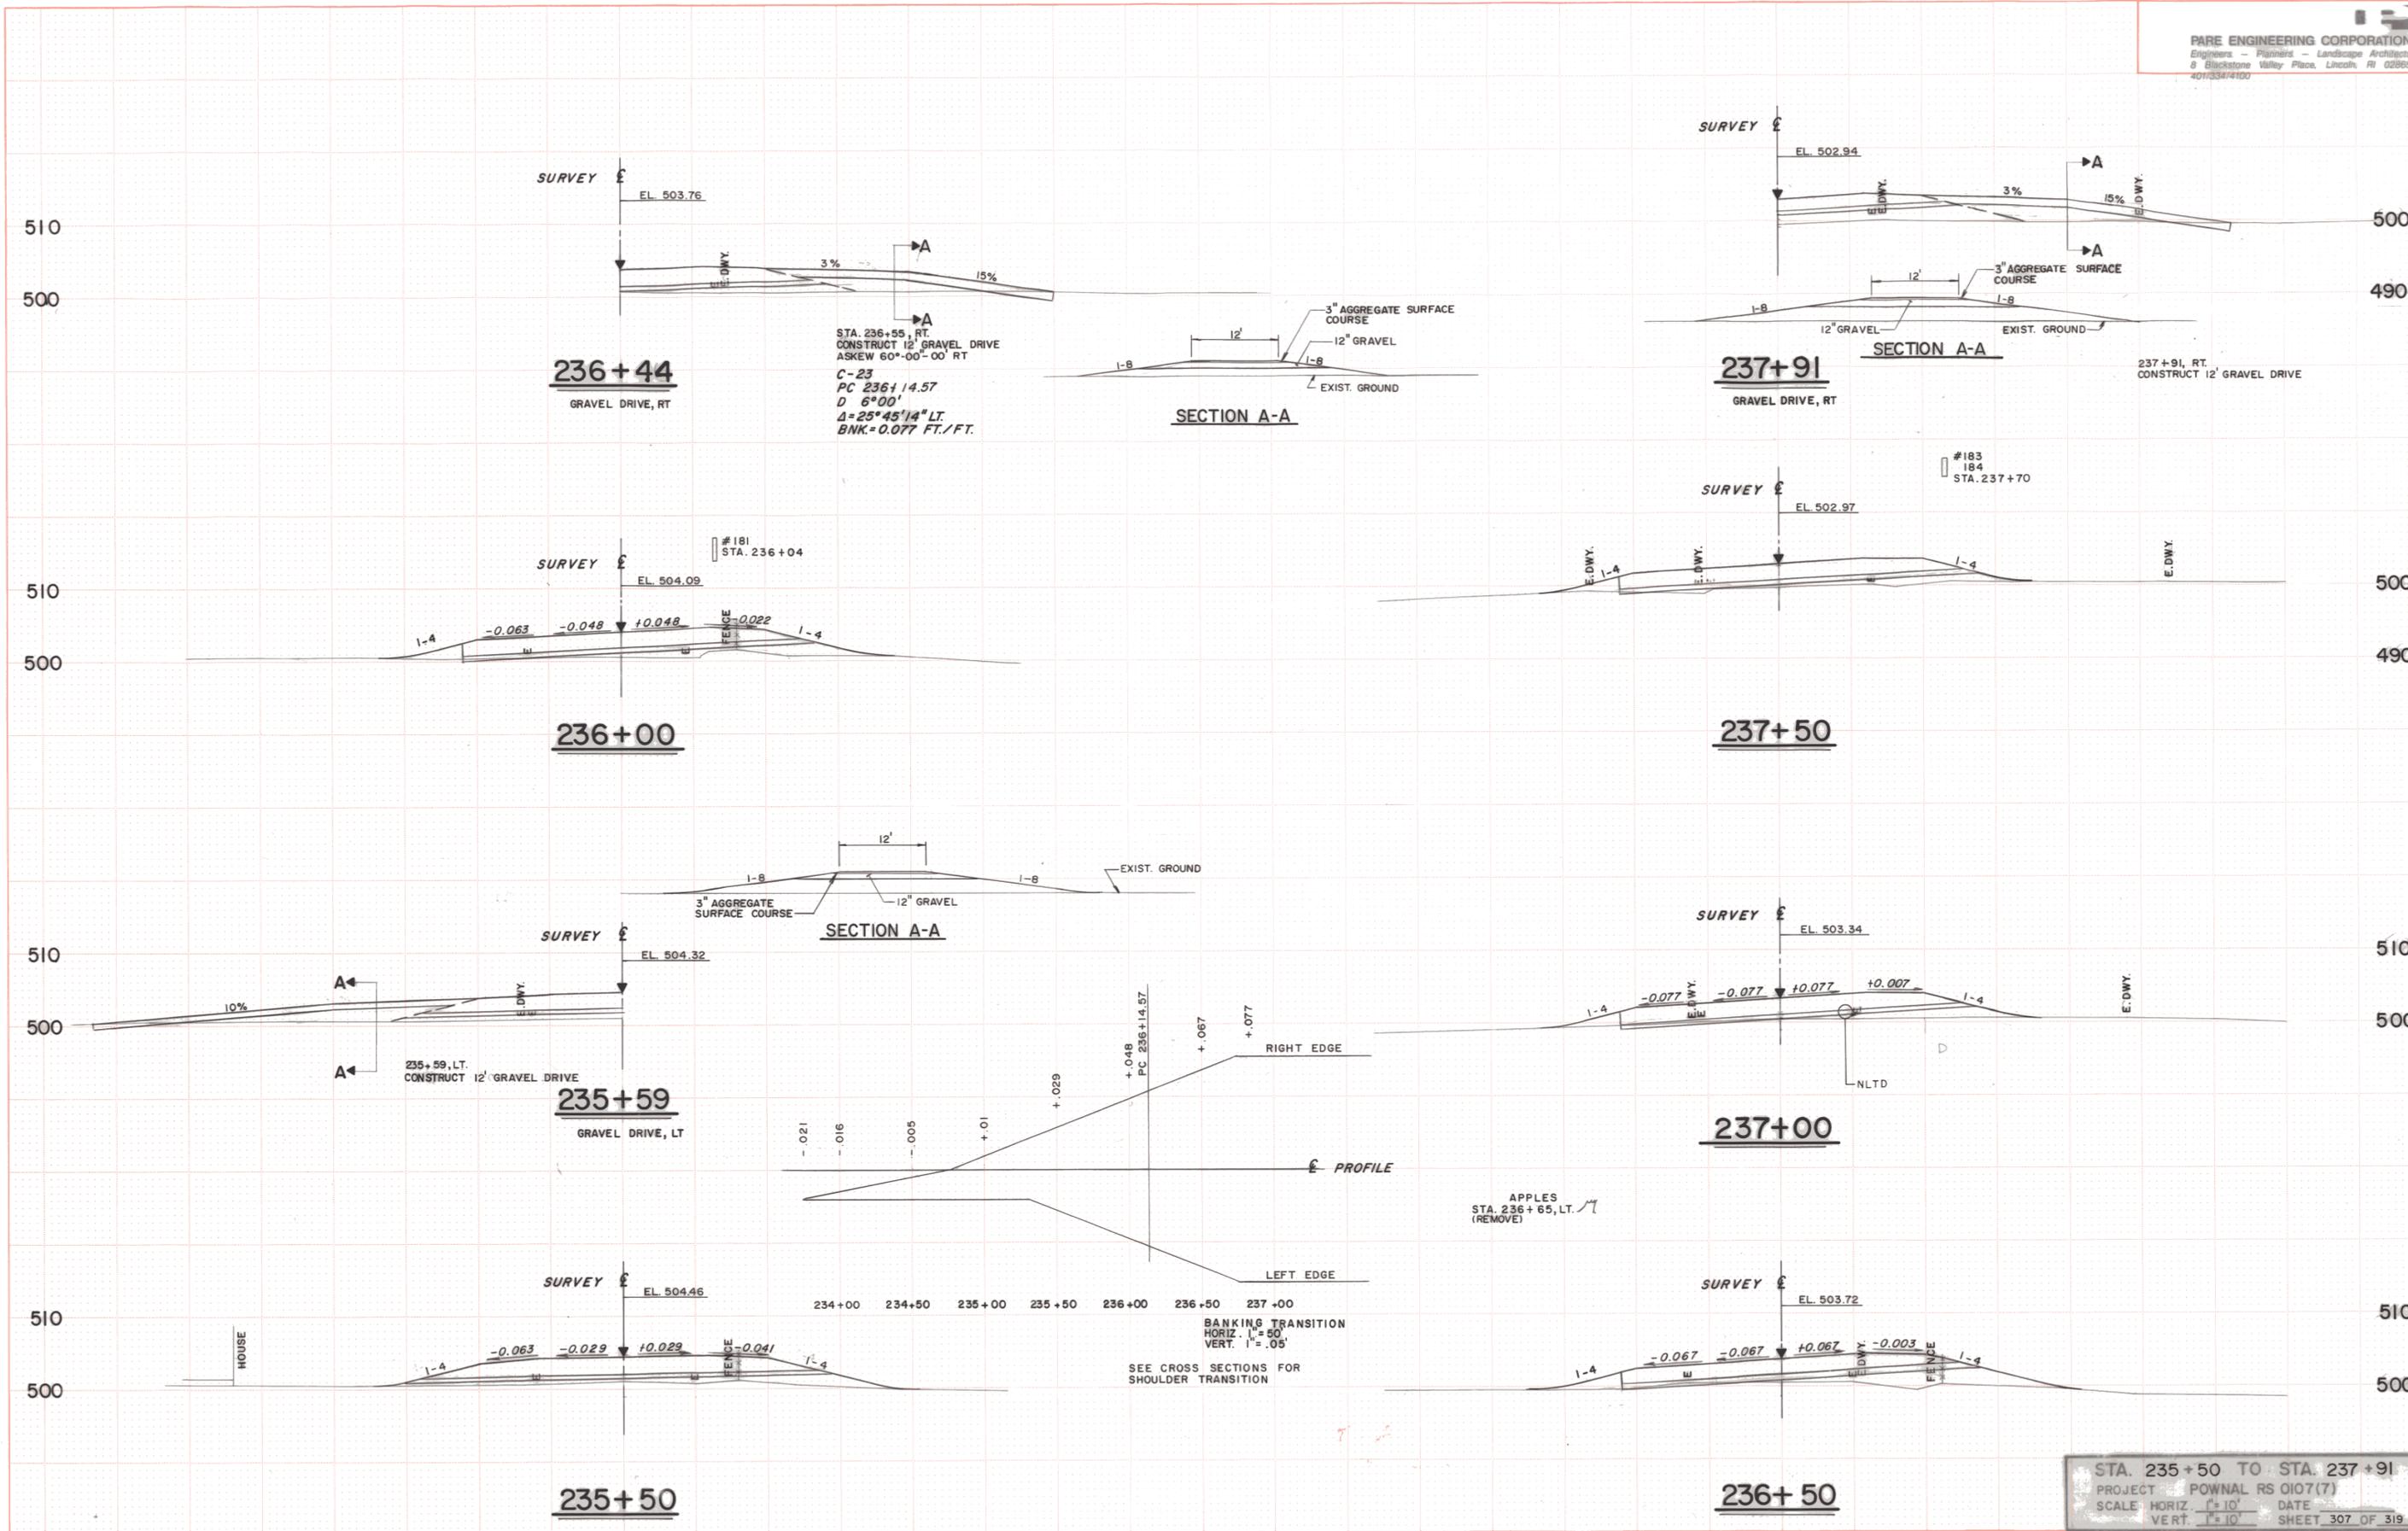

STA. 235+50 TO STA. 237+91
 PROJECT POWNAL RS 0107(7)
 SCALE HORIZ. 1"=10' DATE
 VERT. 1"=10' SHEET 307 OF 319