


186/188  
 STA. 245+35

FINAL SURVEY BY DATE  
 SURVEY PLOTTED  
 NOTE BOOK TEMPLATE  
 NO. AREAS CHECKED

ORIGINAL SURVEY BY DATE  
 SURVEY PLOTTED  
 NOTE BOOK TEMPLATE  
 NO. AREAS CHECKED

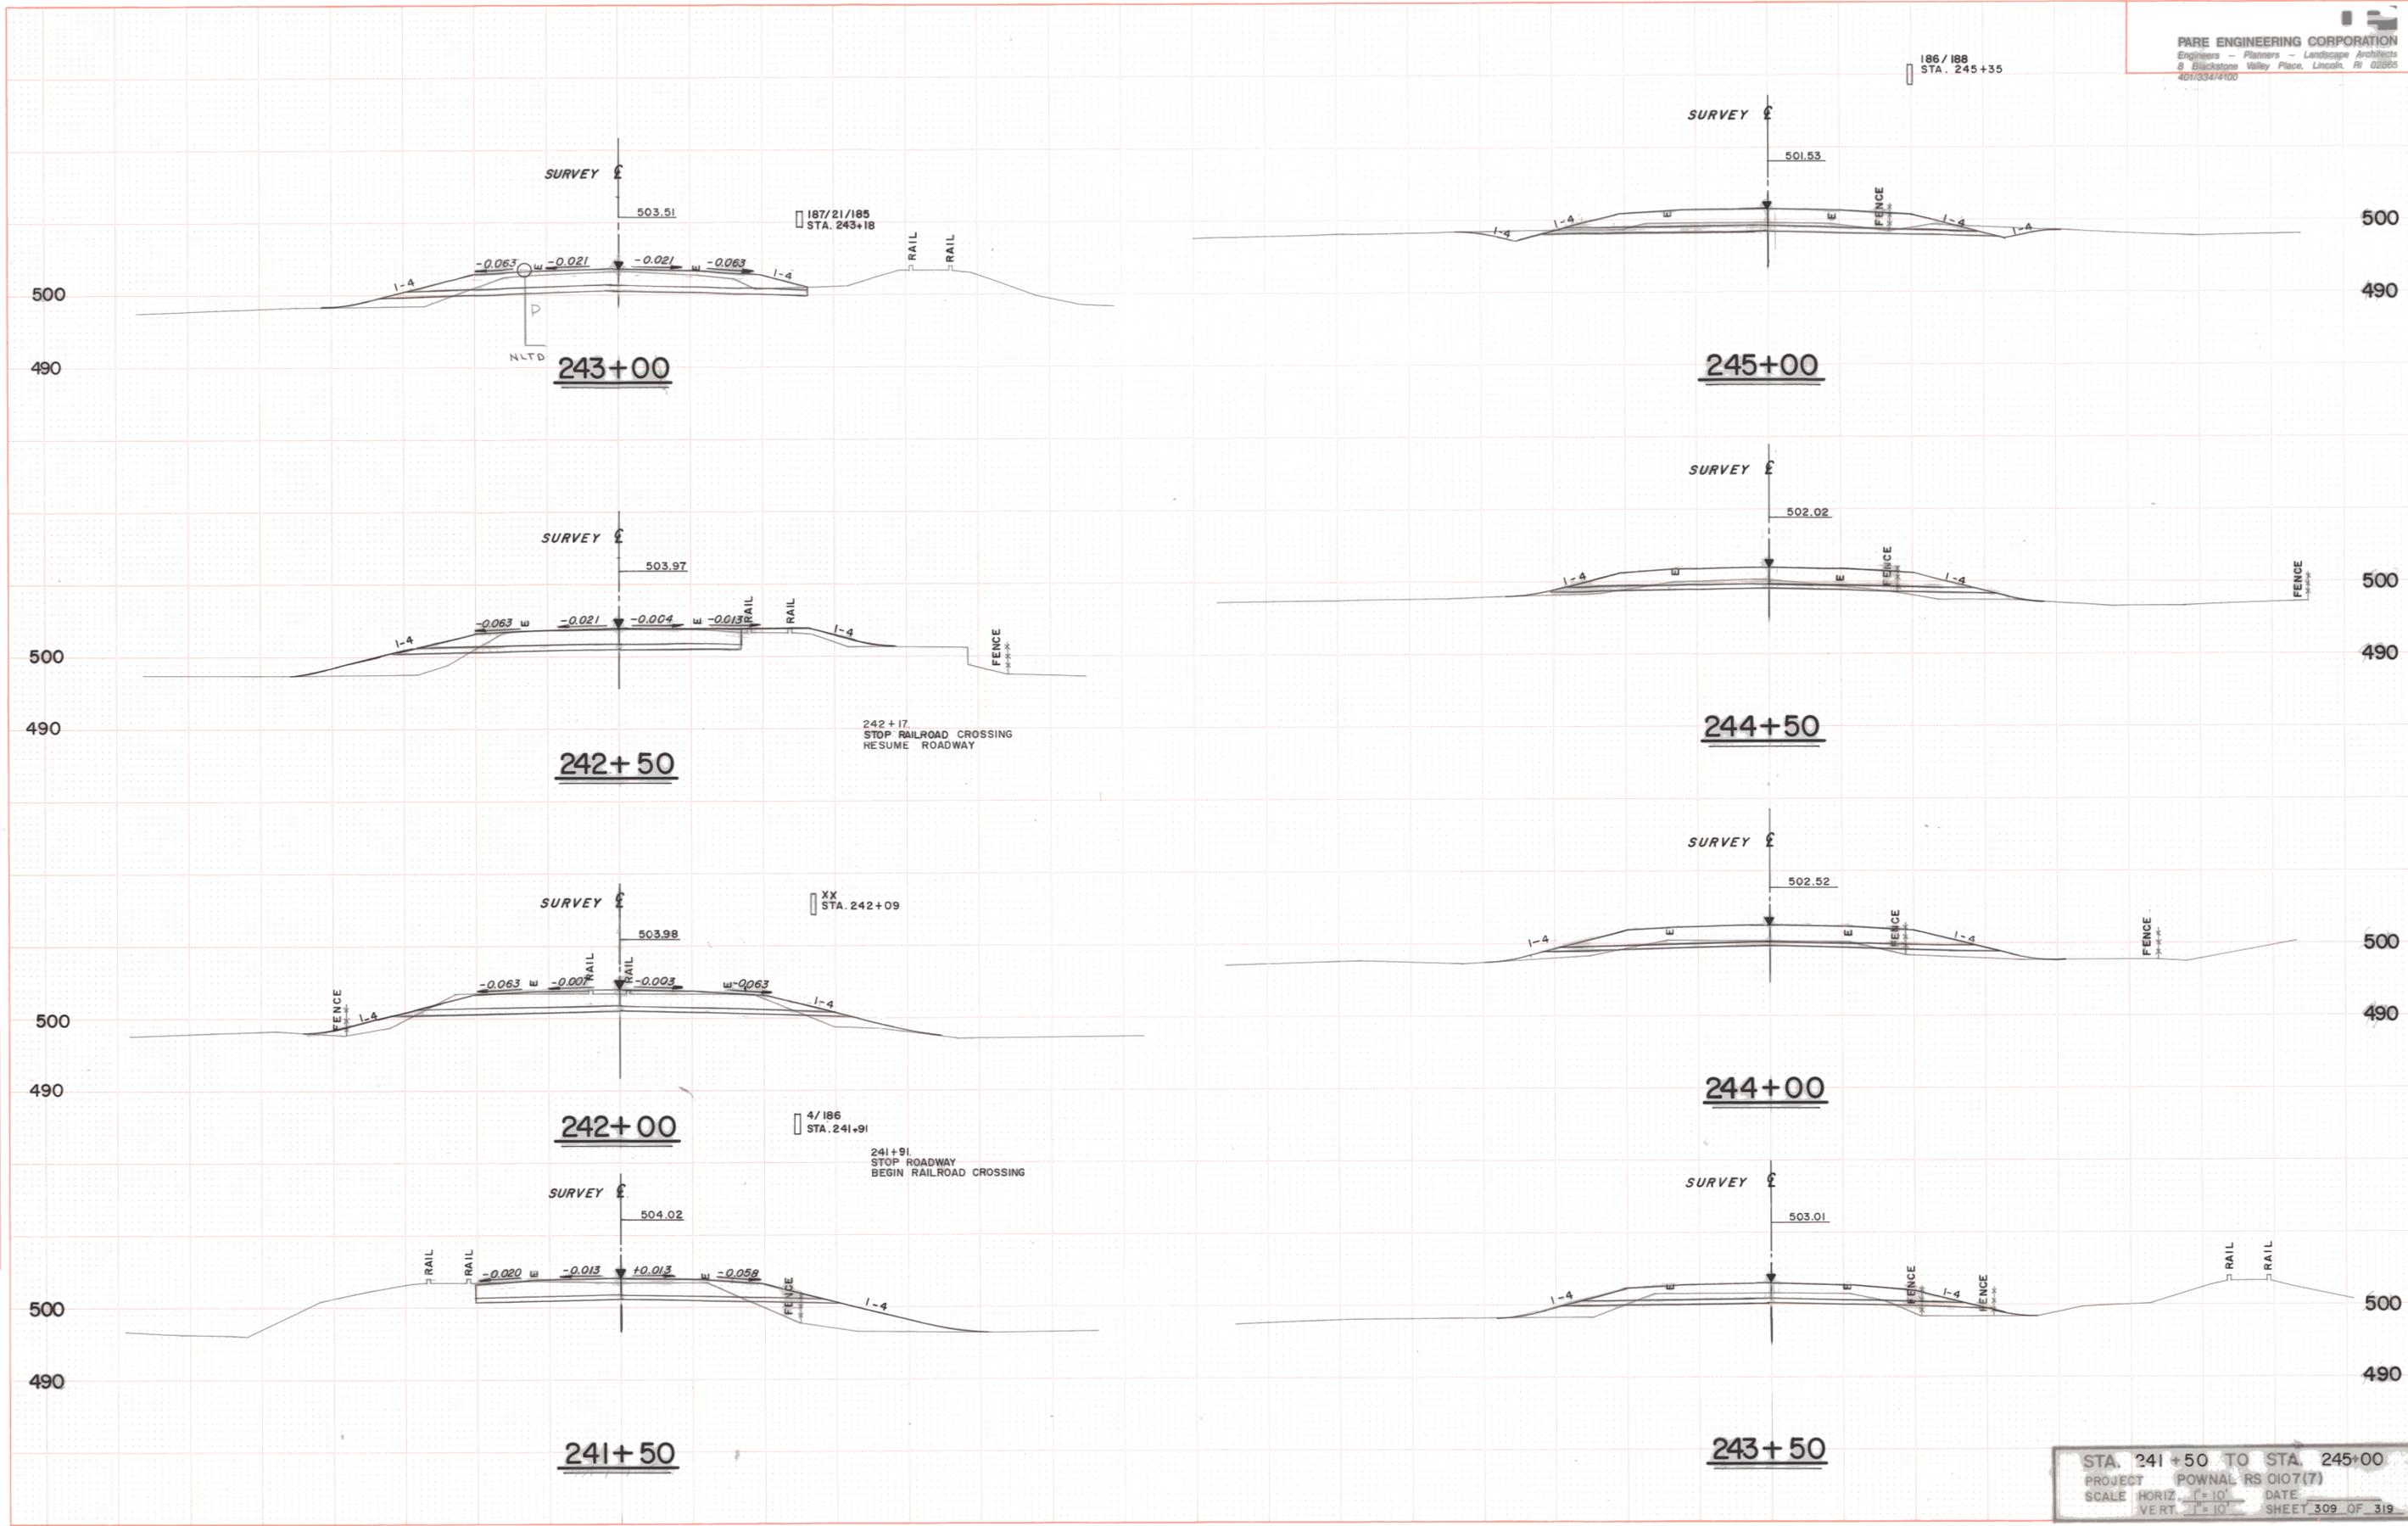

STA. 241+50 TO STA. 245+00  
 PROJECT POWNAL RS 0107(7)  
 SCALE HORIZ. 1"=10' DATE  
 VERT. 1"=10' SHEET 309 OF 319