


DATUM	
VERTICAL	NGVD 1929
HORIZONTAL	N/A

LEGEND
 R = REMOVE
 N = NEW

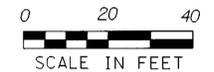

PROJECT:	ST. ALBANS	PROJECT NO.:	HES 034-1019S
DESIGN FILE NAME:	/SODC/84E076/DE076BDR.DGN	PLOT DATE:	11-JAN-1999
IPARM FILE NAME:	de076t1.i	SURVEYED BY:	R. MOREAU
SURVEYED BY:	R. MOREAU	SURVEY DATE:	9/90
SQUAD LEADER:	S. MENARD	DRAWN BY:	G. MEUNIER
		SHEET:	OF