


END APPROACH CONSTRUCTION  
BEGIN PROJECT HES 034-1(19)S

DATUM	
VERTICAL	NGVD 1929
HORIZONTAL	N/A

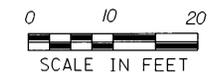

PROJECT: <b>ST. ALBANS</b>	PROJECT NO. : <b>HES 034-1(19)S</b>
DESIGN FILE NAME: /sgdc/84e076/de076xs.dgn	PLOT DATE: 12-JAN-1999
IPARM FILE NAME: de076x02j	SURVEY DATE: 9/2/90
SURVEYED BY: R. MORELL	DRAWN BY: MEDUNIER
SQUAD LEADER: S. MENARD	SHEET: _____ OF _____