




109+78
DR LT & RT

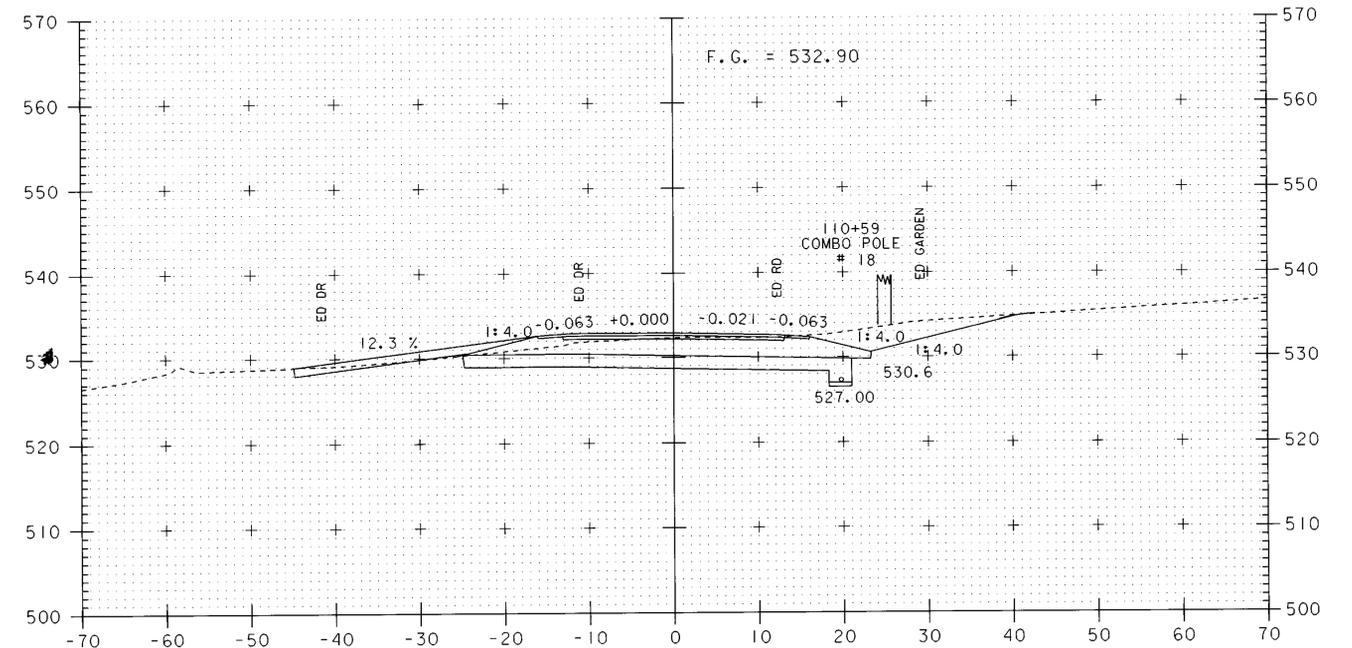

110+50
DR LT

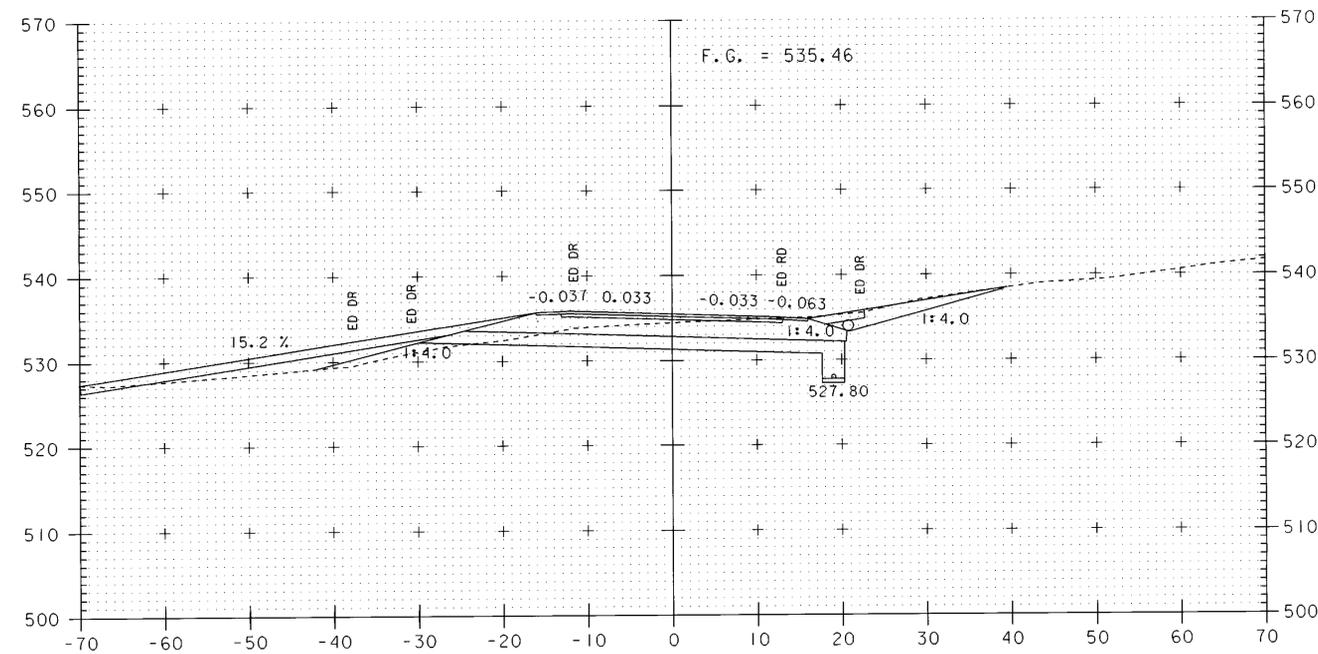


109+70
DR LT

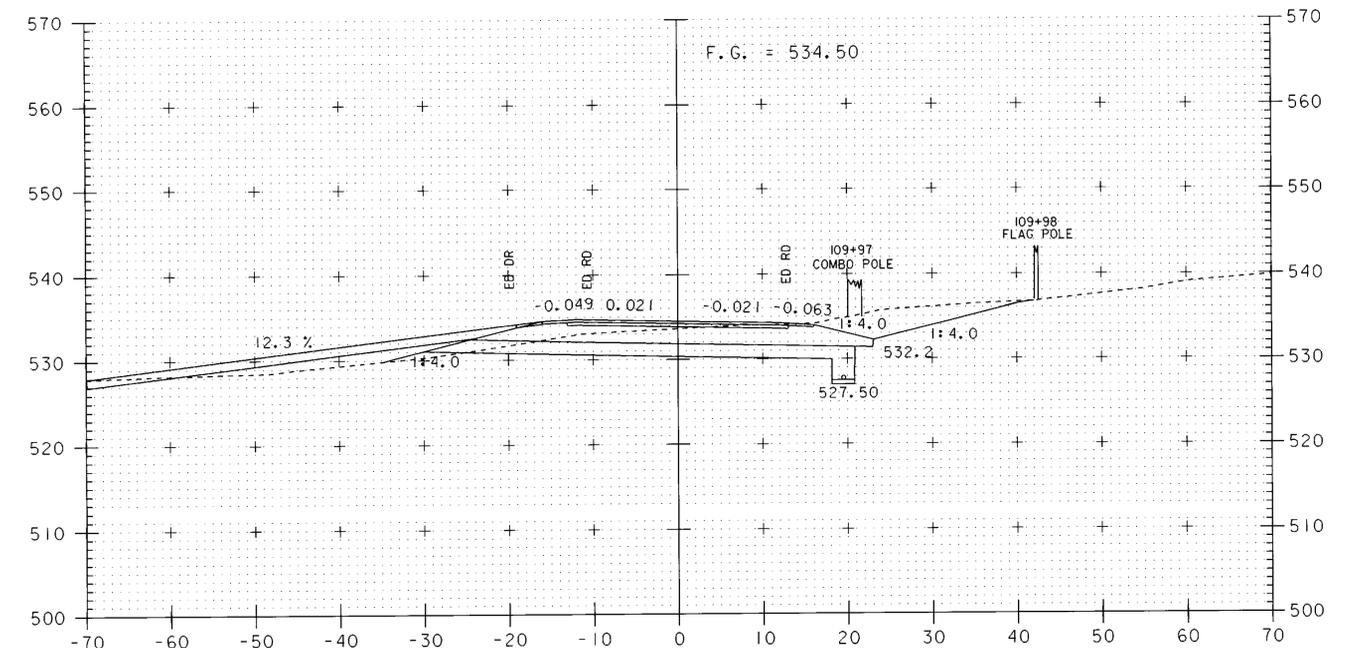

110+00

DATUM	
VERTICAL	NGVD 1929
HORIZONTAL	N/A

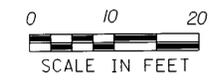

PROJECT: ST. ALBANS	PROJECT NO. : HES 034-1(19)S
DESIGN FILE NAME: /sqdc/84e076/de076XS.dgn	PLOT DATE: 7-JAN-1999
IPARM FILE NAME: de076x08.i	SURVEY DATE: 9/90
SURVEYED BY: R. MOREAU	DRAWN BY: MEUNIER
SQUAD LEADER: S. MENARD	SHEET: _____ OF _____