

- INDEX OF SHEETS**
- TITLE SHEET
 - PRELIMINARY INFORMATION
 - QUANTITY SHEET 1
 - QUANTITY SHEET 2
 - QUANTITY SHEET 3
 - TIE SHEET
 - LAYOUT SHEET 1
 - LAYOUT SHEET 2
 - PROFILE SHEET
 - TRAFFIC DETOUR SHEETS
 - TRAFFIC SIGN SUMMARY SHEET
 - BORING SHEETS
 - PLAN AND ELEVATION
 - MISCELLANEOUS DETAILS
 - GENERAL NOTES
 - DECK STRUCTURAL DETAILS
 - FRAMING PLAN
 - STRUCTURAL STEEL DETAILS
 - BEARING DETAIL SHEET
 - ABUTMENT #1 PLAN AND ELEVATION
 - ABUTMENT #2 PLAN AND ELEVATION
 - WINGWALL DETAIL SHEET
 - REINFORCING STEEL SCHEDULE
 - EPSC NARRATIVE
 - EPSC EXISTING CONDITIONS SITE PLAN
 - EPSC CONSTRUCTION SITE PLAN
 - EPSC FINAL CONDITIONS SITE PLAN
 - EPSC DETAILS
 - ROW LAYOUT
 - ROW DETAILS
 - MAIN LINE SECTIONS
 - CHANNEL LINE SECTIONS

LIST OF STANDARDS

B-71	07/08/2005
E-100	01/02/2004
E-100A	01/02/2004
E-102A	05/01/2004
E-107A	08/08/1995
E-141	09/20/1995
C-1	01/03/2000
C-1D	01/03/2000
SB-R6-82M	07/10/1997

CONVENTIONAL SYMBOLS

COUNTY LINE	—+—+—+—+—
TOWN LINE	—+—+—+—+—
LIMITS OF ACCESS	—+—+—+—+—
POINT OF ACCESS	—+—+—+—+—
FENCE LINE	X X X X X X X X
STONE WALL	—+—+—+—+—
TRAVELED WAY	—+—+—+—+—
GUARD RAIL	—+—+—+—+—
RAILROAD	—+—+—+—+—
SURVEY LINE	—+—+—+—+—
CULVERT	—+—+—+—+—
POWER POLE	—+—+—+—+—
TELEPHONE POLE	—+—+—+—+—
TREES	—+—+—+—+—
CONTROL OF ACCESS	—+—+—+—+—
PROPERTY LINE	—+—+—+—+—
S.D.M. TAKING LINE	—+—+—+—+—
SLOPE RIGHTS	—+—+—+—+—
TOP OF CUT	—+—+—+—+—
TOE OF SLOPE	—+—+—+—+—

**STATE OF VERMONT
AGENCY OF TRANSPORTATION**





TOWN OF CORINTH
COUNTY OF ORANGE

ROUTE NO 2TH 50, CL 3 BRIDGE NO : BR 34

PROJECT LOCATION : THE PROJECT BEGINS ON TH #50 0.4 km SOUTH OF THE INTERSECTION OF TH #50 AND TH #2 AND EXTENDS 60 m EASTERLY ALONG TH #50.
PROJECT DESCRIPTION : THE PROJECT SHALL CONSIST OF THE REPLACEMENT OF THE EXISTING STRUCTURE WITH A NEW STRUCTURE INCLUDING RELATED ROADWAY AND CHANNEL WORK.

LENGTH OF STRUCTURE : 22.328 METERS.
LENGTH OF ROADWAY : 37.672 METERS.
LENGTH OF PROJECT : 60.000 METERS.

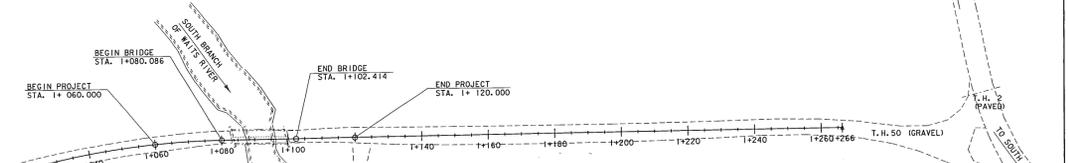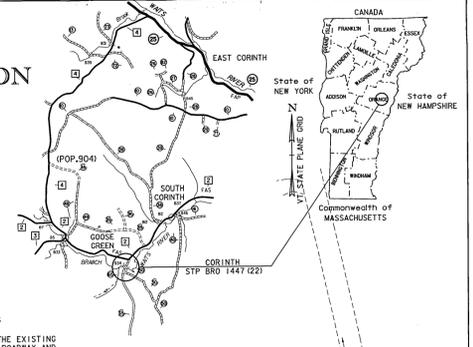

RECORD PLANS

CONTRACTOR: AUSTIN CONSTRUCTION INC - CONCORD, VT
RESIDENT ENGINEER: PETER HEDGECOCK
CONSTRUCTION BEGAN: APRIL 27, 2009
CONSTRUCTION COMPLETE: MAY 12, 2010
RECORD PLANS BY: PETER HEDGECOCK & C. PERCE
I HEREBY CERTIFY THAT ALL THE CONSTRUCTION REQUIRED BY THIS SET OF DRAWINGS HAS BEEN ACCOMPLISHED AS INDICATED HEREIN.
BY: *Peter Hedgcock* RESIDENT ENGINEER
DATE: 3/1/11

NOTE: Any further information concerning final quantities, amounts or other details relative to this project may be found at Central File in the electronic archives.

Metric
UNLESS NOTED OTHERWISE
STATIONS ARE IN KILOMETERS
ELEVATIONS ARE IN METERS
DIMENSIONS ARE IN MILLIMETERS

THESE PLANS ARE SUBJECT TO SUCH ENGINEERING CHANGES AS MAY BE REQUIRED BY THE FEDERAL HIGHWAY ADMINISTRATION OR THE DIRECTOR OF PROGRAM DEVELOPMENT.
CONSTRUCTION IS TO BE CARRIED ON IN ACCORDANCE WITH THESE PLANS AND THE STANDARD SPECIFICATIONS FOR CONSTRUCTION DATED 2006, AS APPROVED BY THE FEDERAL HIGHWAY ADMINISTRATION ON JUNE 15, 2006 FOR USE ON THIS PROJECT, INCLUDING ALL SUBSEQUENT REVISIONS AND SUCH REVISED SPECIFICATIONS AND SPECIAL PROVISIONS AS ARE INCORPORATED IN THESE PLANS.
PLOTTED 15-JUL-2008

DIRECTOR OF PROGRAM DEVELOPMENT
APPROVED: *[Signature]* DATE 2-15-08
PROJECT MANAGER : G.P. WILLIAMS
PROJECT NAME : CORINTH
PROJECT NUMBER : STP BRD 1447 (22) (RE-ADVERTISED)
SHEET 1 OF 42 SHEETS

SURVEYED BY : R. OILMAN
SURVEYED DATE : 3/15/95
DATUM
VERTICAL NAVD_88
HORIZONTAL NAD_83/22