


NOTE:
SEE CROSS SECTIONS FOR CHANGE IN CONTOURS

LEGEND	
	DISTURBED AREAS REQUIRING RE-VEGETATION
	EROSION MATTING
	LIMITS OF CONSTRUCTION
	RIPARIAN BUFFER

EPSC FINAL CONDITIONS SITE PLAN

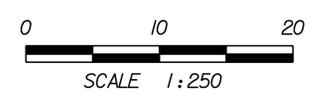

PROJECT: CORINTH	PROJECT NO.: STP BRO 1447 (22) (RE-ADVERTISED)
DESIGN FILE NAME: 93J042/structures/s93J042bdr_ero.dgn	PLOT DATE: 16-JUL-2008
IPARM FILE NAME: sj042fIncon.I	DRAWN BY: M.FESSEL
DESIGNED BY: M.FESSEL	CHECKED BY: R.S.YOUNG
SQUAD LEADER: C.P. WILLIAMS	SHEET: 31 OF 42
EPSC FINAL CONDITIONS SITE PLAN	