


FRAMING PLAN

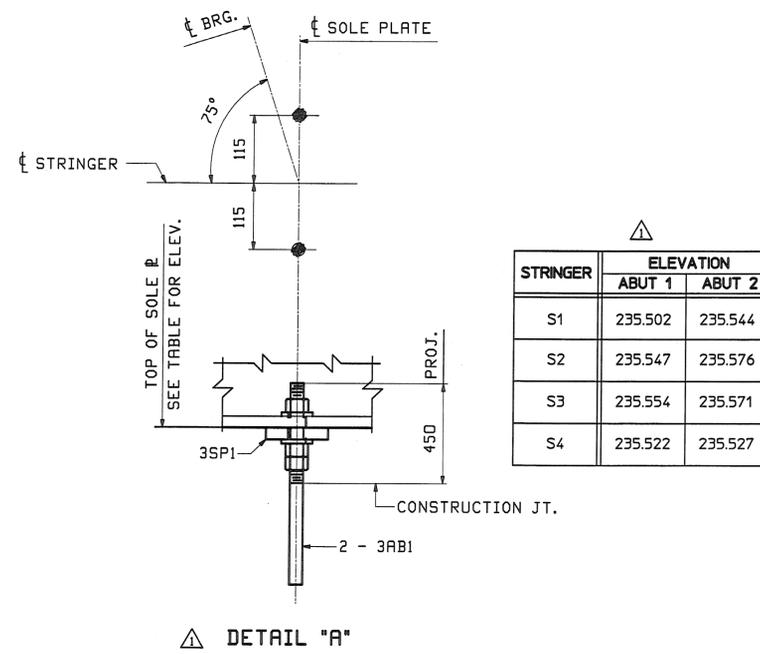

FIELD BOLT LIST										A325 Type 3 BOLTS		WASHER CODES		PIECES CONNECTED AND REMARKS	
LINE	NO. REQ'D.	BOLT DIAM.	BOLT LEN.	BOLTS # OF CONN.	GRIP	THICKNESS OF PCS. CONNECTED		WASHER CODE	PIECES CONNECTED AND REMARKS						
1									INT. DIAPHRAGMS						
2	72	3/8	24	4	18	23	10	13	1	DIAPHRAGM WEB TO CONN. PL.					
3									1: 1 Hard Flat Washer						

FIELD BOLT SUMMARY						EXACT COUNT - NONE EXTRA		REMARKS	
LINE	NO. OF BOLTS	BOLT DIAM.	TYPE	BOLT LEN.	ACTUAL COUNT				
1	72	3/8	A325 Type 3	24	72				
2									
3	72		Hard Flat Washers for 3/8 BOLT			F436-3			
4									
5									
6									

NOTE:  
FOR GENERAL NOTES SEE DRAWING GNI.

REV.	DATE	REMARKS	DWN	CHK	APVL	SHOP
11/11		ADDED ANCHOR BOLT ASS'Y	ZAD	WJL		11-12-08
MATERIAL:		SURFACE PREP. & PAINT:		HOLES:		SHOP BOLTS:
DESCRIPTION: FRAMING PLAN & FIELD BOLTS						
CASCO BAY STEEL STRUCTURES, INC. 75 SPRING HILL ROAD SACO, MAINE 04072 PHONE (207) 282-7360 FAX. (207) 282-1179						
STRUCTURE: ROUTE NO: TH 50, CL 3 BRIDGE NO: BR 34 COUNTY OF ORANGE				DATE:	10/14	
LOCATION: TOWN OF CORINTH				CHKD:	DBH 10/28	
PROJ NO. STP BRO 1447(22) (RE-ADVERTISED)				JOB NO.	380	
CUSTOMER: VERMONT ROT				REV.	E1	