




6 ~ x1a  
INT. CF CONN.  
LINES 1 & 4

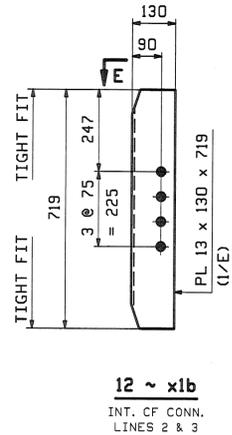

12 ~ x1b  
INT. CF CONN.  
LINES 2 & 3

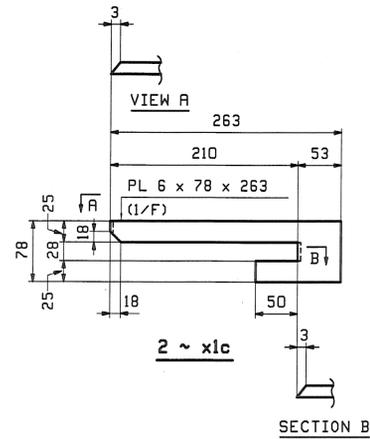

SECTION B

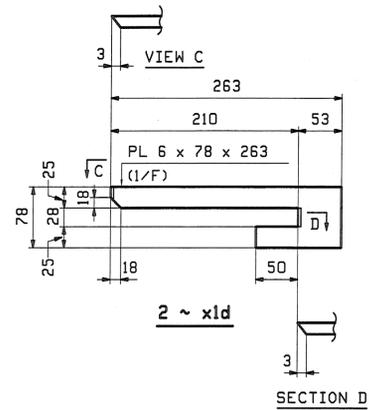

SECTION D

NOTES:  
ALL MATERIAL SHALL BE M270M-345W.  
ALL BOLT HOLES SHALL BE  $\frac{1}{16}$ " FOR  $\frac{3}{8}$ " HSB.  
FOR GENERAL NOTES SEE DRAWING GNI.

0					11-10-03	
REV.	DATE	REMARKS	DWN	CHK	APVL	SHOP
MATERIAL:		SURFACE PREP. & PAINT:		HOLES:		SHOP BOLTS:
DESCRIPTION: STRINGER STANDARD DETAILS						
CASCO BAY STEEL STRUCTURES, INC. 75 SPRING HILL ROAD SACO, MAINE 04072 PHONE (207) 282-7360 FAX. (207) 282-1179						
STRUCTURE: ROUTE NO: TH 50, CL 3 BRIDGE NO: BR 34 COUNTY OF ORANGE			DRAWN: JTB	DATE: 10/14		
			CHKD: DBH	DATE: 10/28		
LOCATION: TOWN OF CORINTH			JOB NO.	DWG NO.		
PROJ NO. STP BRO 1447(22) (RE-ADVERTISED)			380	X1		
CUSTOMER: VERMONT ROT				REV. $\Delta$		

RECEIVED  
CHKD BY LSS OK'D BY RSY  
NOV 14 2008  
APPROVED Asst  
DATE 11/25/08  
CPW