


SEE SHEET 2 FOR INDEX OF SHEETS

# STATE OF VERMONT AGENCY OF TRANSPORTATION

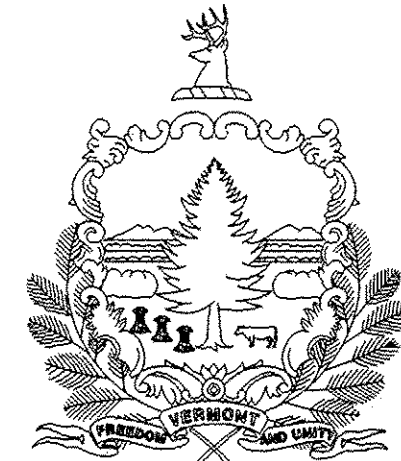

## PROPOSED IMPROVEMENT BRIDGE PROJECT


TOWN OF LUDLOW  
COUNTY OF WINDSOR

ROUTE NO : VT 100    MINOR ARTERIAL    BRIDGE NO : 98F

PROJECT LOCATION : BEGINNING AT A POINT APPROXIMATELY 0.02 MI FROM THE JUNCTION OF VT 100 AND BROOKS ROAD (TH41) AND EXTENDING NORTH ALONG VT 100 FOR 100 FEET.

PROJECT DESCRIPTION : REPLACE EXISTING CULVERT WITH A PRECAST CONCRETE ARCH.

LENGTH OF STRUCTURE :                    36.30 FEET.  
LENGTH OF ROADWAY :                    63.70 FEET.  
LENGTH OF PROJECT :                    100.00 FEET.

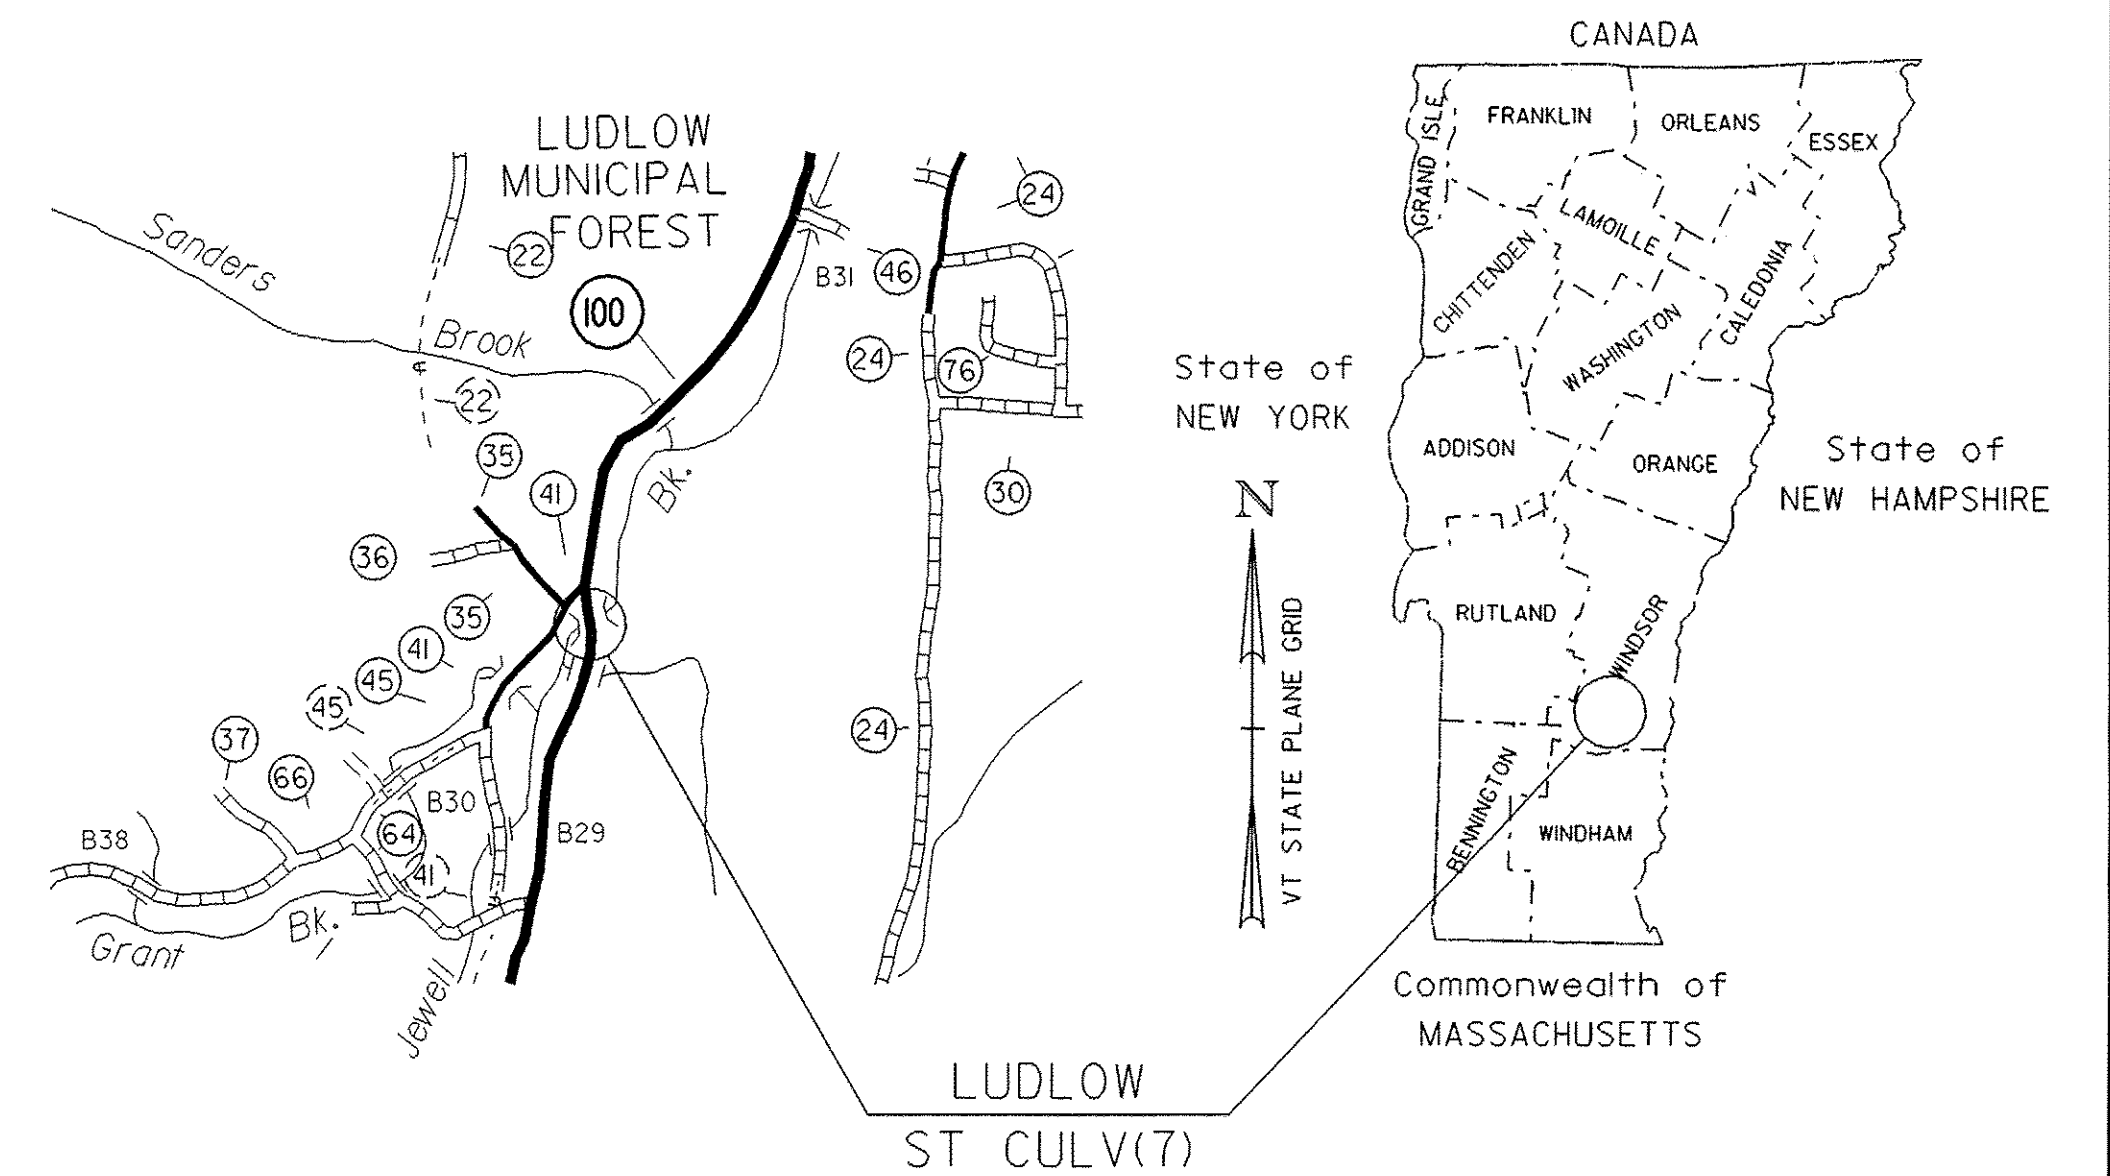

**RECORD PLANS**

CONTRACTOR: MILLER CONSTRUCTION, INC. - WINDSOR, VT

RESIDENT ENGINEER: JEREMY REED

CONSTRUCTION BEGAN: APRIL 16, 2009


CONSTRUCTION COMPLETE: JUNE 17, 2010

RECORD PLANS BY: JEREMY REED & JENNA HYDE

I HEREBY CERTIFY THAT ALL THE CONSTRUCTION REQUIRED BY THIS SET OF DRAWINGS HAS BEEN ACCOMPLISHED AS INDICATED HEREIN.

BY Jeremy Reed                    RESIDENT ENGINEER  
DATE 1/23/14

NOTE: Any further information concerning final quantities, amounts or other details relative to this project may be found at Central Files in the electronic archives.

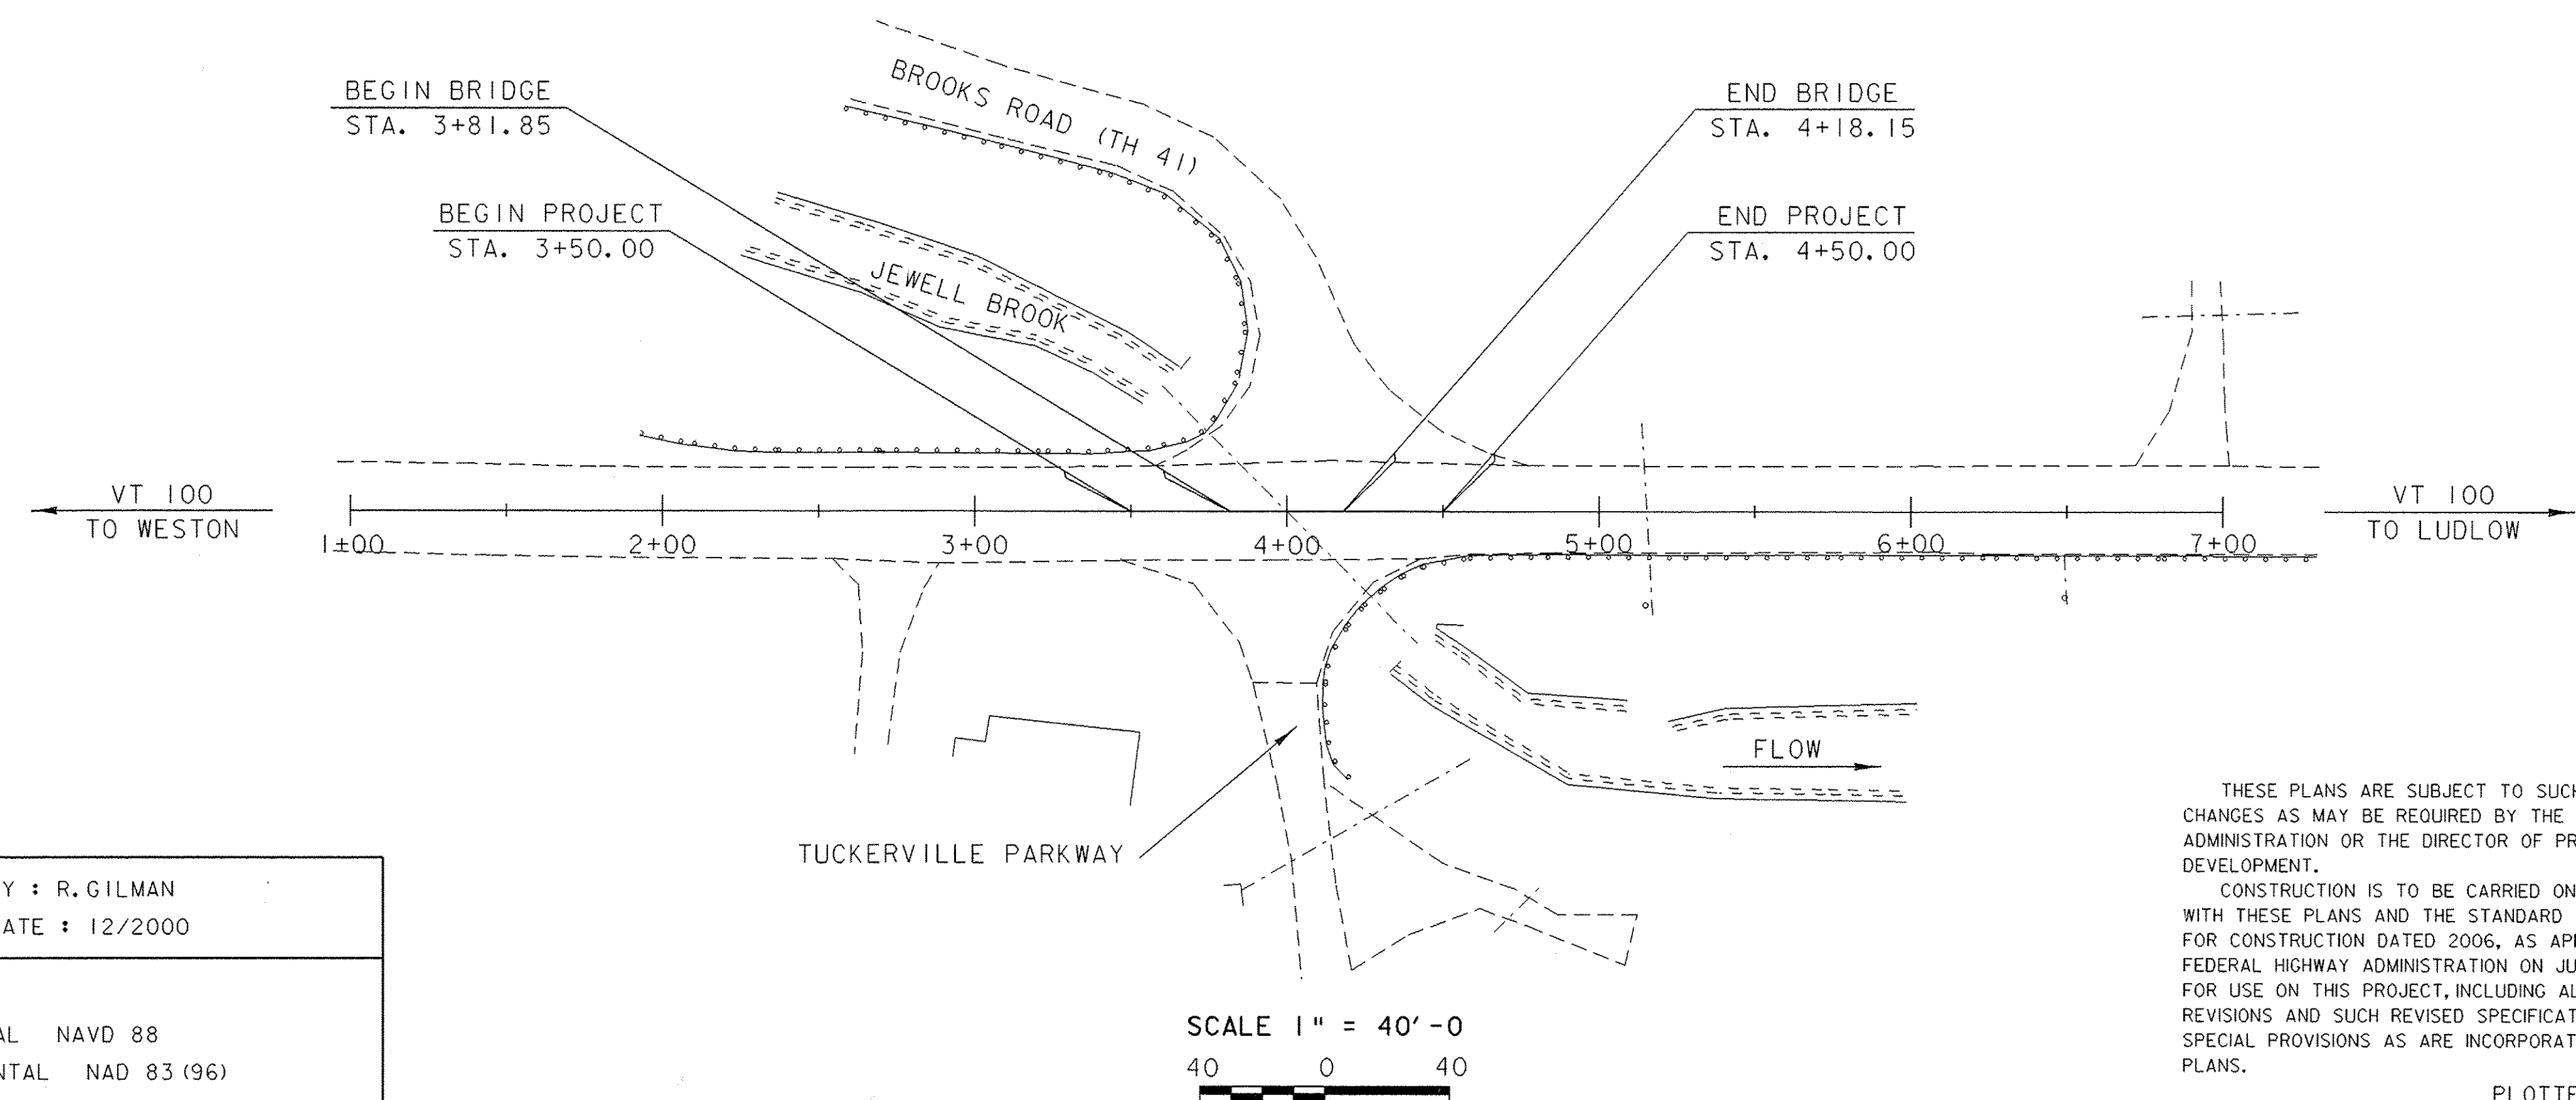

CONVENTIONAL SYMBOLS	
COUNTY LINE	
TOWN LINE	
LIMITS OF ACCESS	
POINT OF ACCESS	
FENCE LINE	
STONE WALL	
TRAVELED WAY	
GUARD RAIL	
RAILROAD	
SURVEY LINE	
CULVERT	
POWER POLE	
TELEPHONE POLE	
TREES	
CONTROL OF ACCESS	
PROPERTY LINE	
R.O.W. TAKING LINE	
SLOPE RIGHTS	
TOP OF CUT	
TOE OF SLOPE	

SURVEYED BY : R. GILMAN  
SURVEYED DATE : 12/2000

DATUM  
VERTICAL NAVD 88  
HORIZONTAL NAD 83 (96)

SCALE 1" = 40'-0"  
40      0      40

THESE PLANS ARE SUBJECT TO SUCH ENGINEERING CHANGES AS MAY BE REQUIRED BY THE FEDERAL HIGHWAY ADMINISTRATION OR THE DIRECTOR OF PROGRAM DEVELOPMENT.

CONSTRUCTION IS TO BE CARRIED ON IN ACCORDANCE WITH THESE PLANS AND THE STANDARD SPECIFICATIONS FOR CONSTRUCTION DATED 2006, AS APPROVED BY THE FEDERAL HIGHWAY ADMINISTRATION ON JUNE 15, 2006 FOR USE ON THIS PROJECT, INCLUDING ALL SUBSEQUENT REVISIONS AND SUCH REVISED SPECIFICATIONS AND SPECIAL PROVISIONS AS ARE INCORPORATED IN THESE PLANS.

DIRECTOR OF PROGRAM DEVELOPMENT	
APPROVED <u>[Signature]</u>	DATE <u>7/9/08</u>
PROJECT MANAGER : C.P. WILLIAMS	
PROJECT NAME : LUDLOW	
PROJECT NUMBER : STP ST CULV (7)	
SHEET 1 OF 34 SHEETS	

PLOTTED 20-AUG-2008