


6+00
 END APPROACH

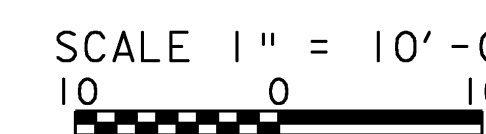

STA. 5+00 TO STA. 6+50

PROJECT: LUDLOW	PROJECT NO.: STP ST CULV (7)
DESIGN FILE NAME: s00b258\Structures\s00b258xsl.dgn	PLOT DATE: 11-SEP-2008
IPARM FILE NAME: s00b258m13.i	DRAWN BY:
DESIGNED BY: E.L.RUSTAY	CHECKED BY: R.S.YOUNG
SQUAD LEADER: C.P.WILLIAMS	SHEET: 31 OF 34
MAINLINE CROSS SECTIONS	