

646.40 DURABLE 100 mm WHITE LINE
 (ALL LINES WILL INCLUDE EDGE LINE BREAKS AND RADIUS FOR TOWN HIGHWAYS)

RUPERT:
 STA. I+080.0 - STA. I+620.0 LT & RT

646.60 TEMPORARY 100 mm WHITE LINE
 (ALL LINES WILL INCLUDE EDGE LINE BREAKS AND RADIUS FOR TOWN HIGHWAYS)


RUPERT:
 STA. I+080.0 - STA. I+620.0 LT & RT

646.41 DURABLE 100 mm YELLOW LINE
 (ALL LINES WILL INCLUDE C/L BREAKS FOR TOWN HIGHWAYS) S=SOLID, D=DASHED

RUPERT: LT C RT
 STA. I+080.0 - STA. I+095.0 D - S
 STA. I+095.0 - STA. I+561.0 S - S
 STA. I+561.0 - STA. I+620.0 S - D

646.61 TEMPORARY 100 mm YELLOW LINE
 (ALL LINES WILL INCLUDE C/L BREAKS FOR TOWN HIGHWAYS) S=SOLID, D=DASHED

RUPERT: LT C RT
 STA. I+080.0 - STA. I+095.0 D - S
 STA. I+095.0 - STA. I+561.0 S - S
 STA. I+561.0 - STA. I+620.0 S - D

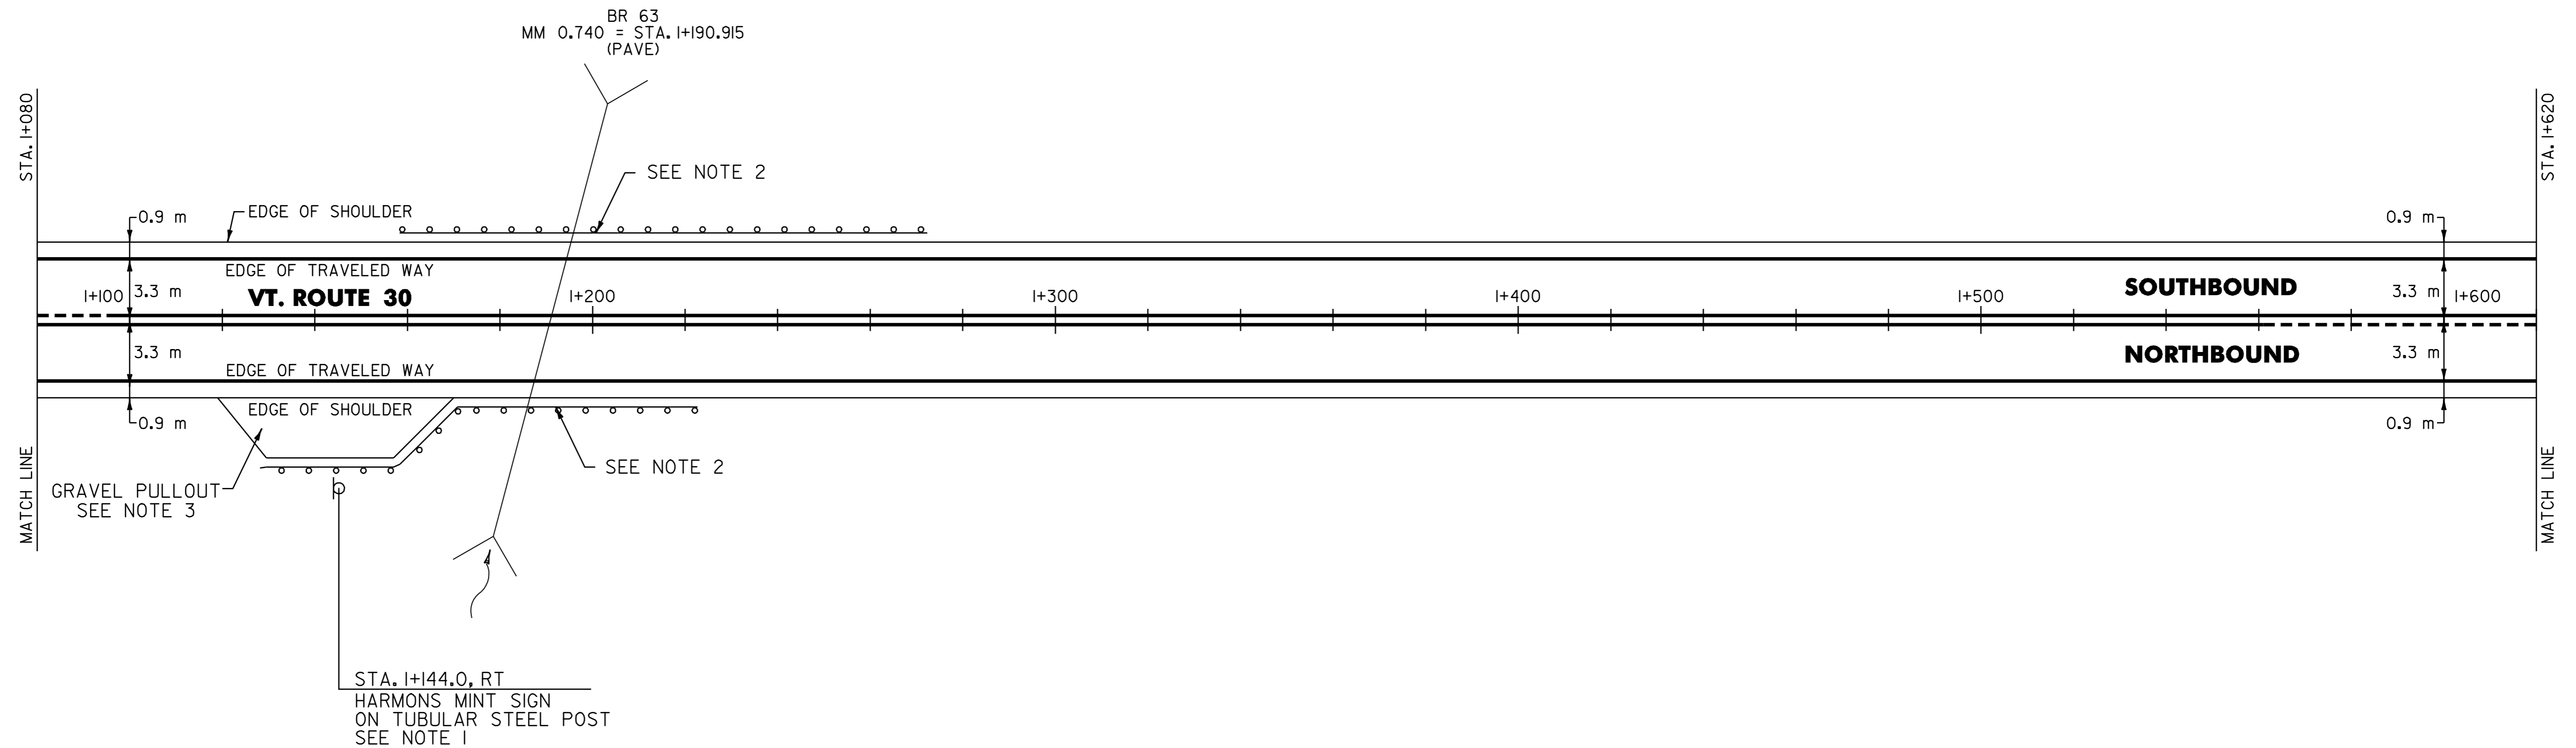

NOTES:

- SEE SHEET 38 OF 40 FOR REDUCED STEEL BEAM GUARDRAIL POST SPACING DETAIL.
- SEE SHEET 31 OF 40 FOR BR 63 DETAILS.
- PLACE 100 mm OF COMPACTED COLD PLANE GRINDINGS ON THE EXISTING GRAVEL PULLOUT AND PROVIDE A 25 mm TYPE IV 8 m WIDE APRON. ANY REQUIRED EXCAVATION SHALL BE PERFORMED AS DIRECTED BY THE RESIDENT ENGINEER AND PAID UNDER ITEM 608.25.

525.10 REMOVAL OF EXISTING RAILING
 RUPERT:
 STA. I+182.5 - STA. I+188.5 RT (5.7 m)
 STA. I+192.5 - STA. I+198.2 LT (5.7 m)

525.41 BRIDGE RAIL - H.D. STEEL/BEAM FASCIA MOUNTED (MOD. I)
 RUPERT:
 STA. I+182.5 - STA. I+188.5 RT (5.7 m)
 STA. I+192.5 - STA. I+198.2 LT (5.7 m)

621.20 STEEL BEAM GUARDRAIL
 RUPERT:

134.9 STA. I+27.4 - STA. I+173.0 RT (45.6 m) FACTORED
 STA. I+158.3 - STA. I+184.9 LT (26.6 m)
 STA. I+196.1 - STA. I+222.7 RT (26.6 m)
 STA. I+207.7 - STA. I+272.3 LT (64.6 m)

621.21 HEAVY DUTY STEEL BEAM GUARDRAIL
 RUPERT:
 STA. I+173.0 - STA. I+182.5 RT (9.5 m)
 STA. I+184.9 - STA. I+192.5 LT (7.6 m)
 STA. I+188.5 - STA. I+196.1 RT (7.6 m)
 STA. I+198.2 - STA. I+207.7 LT (9.5 m)

621.505 MANUFACTURED TERMINAL SECTION
 RUPERT:
 STA. I+27.4 RT 134.9
 STA. I+158.3 LT
 STA. I+227.7 RT
 STA. I+272.3 LT

621.80 REMOVAL AND DISPOSAL OF GUARDRAIL
 RUPERT:
 STA. I+166.0 - STA. I+192.5 LT (26.5 m)
 STA. I+170.0 - STA. I+180.9 RT (10.9 m)
 STA. I+188.5 - STA. I+215.0 RT (26.5 m)
 STA. I+198.2 - STA. I+224.0 LT (25.8 m)

621.81 REMOVAL AND DISPOSAL OF GUIDE POSTS
 RUPERT:
 STA. I+143.0 RT
 STA. I+145.0 RT

DATUM	
VERTICAL	N/A
HORIZONTAL	N/A

PAVING PROJECT LAYOUT	SURVEYED BY	N/A	DATE	N/A
	DRAWN BY	C.A.K.	DATE	4/01
	SQUAD LEADER	T.P.K.		
	DESIGN FILE NO.	/pave/00b048/pb048.dgn		
	IPARM FILE	pb048i03.i	DATE PLOTTED	\$DATE\$
PROJ. NAME	RUPERT - PAWLET			
PROJ. NO.	STP 2133(I)S			
SHEET	10	OF	40	SHEETS