

646.40 DURABLE 100 mm WHITE LINE
 (ALL LINES WILL INCLUDE EDGE LINE BREAKS AND RADIUS FOR TOWN HIGHWAYS)

RUPERT:
 STA. 3+240.0 - STA. 3+780.0 LT & RT

646.60 TEMPORARY 100 mm WHITE LINE
 (ALL LINES WILL INCLUDE EDGE LINE BREAKS AND RADIUS FOR TOWN HIGHWAYS)


RUPERT:
 STA. 3+240.0 - STA. 3+780.0 LT & RT

646.41 DURABLE 100 mm YELLOW LINE
 (ALL LINES WILL INCLUDE C/L BREAKS FOR TOWN HIGHWAYS) S=SOLID, D=DASHED

RUPERT: LT CL RT
 STA. 3+240.0 - STA. 3+315.0 D - S
 STA. 3+315.0 - STA. 3+780.0 S - S

646.61 TEMPORARY 100 mm YELLOW LINE
 (ALL LINES WILL INCLUDE C/L BREAKS FOR TOWN HIGHWAYS) S=SOLID, D=DASHED

RUPERT: LT CL RT
 STA. 3+240.0 - STA. 3+315.0 D - S
 STA. 3+315.0 - STA. 3+780.0 S - S

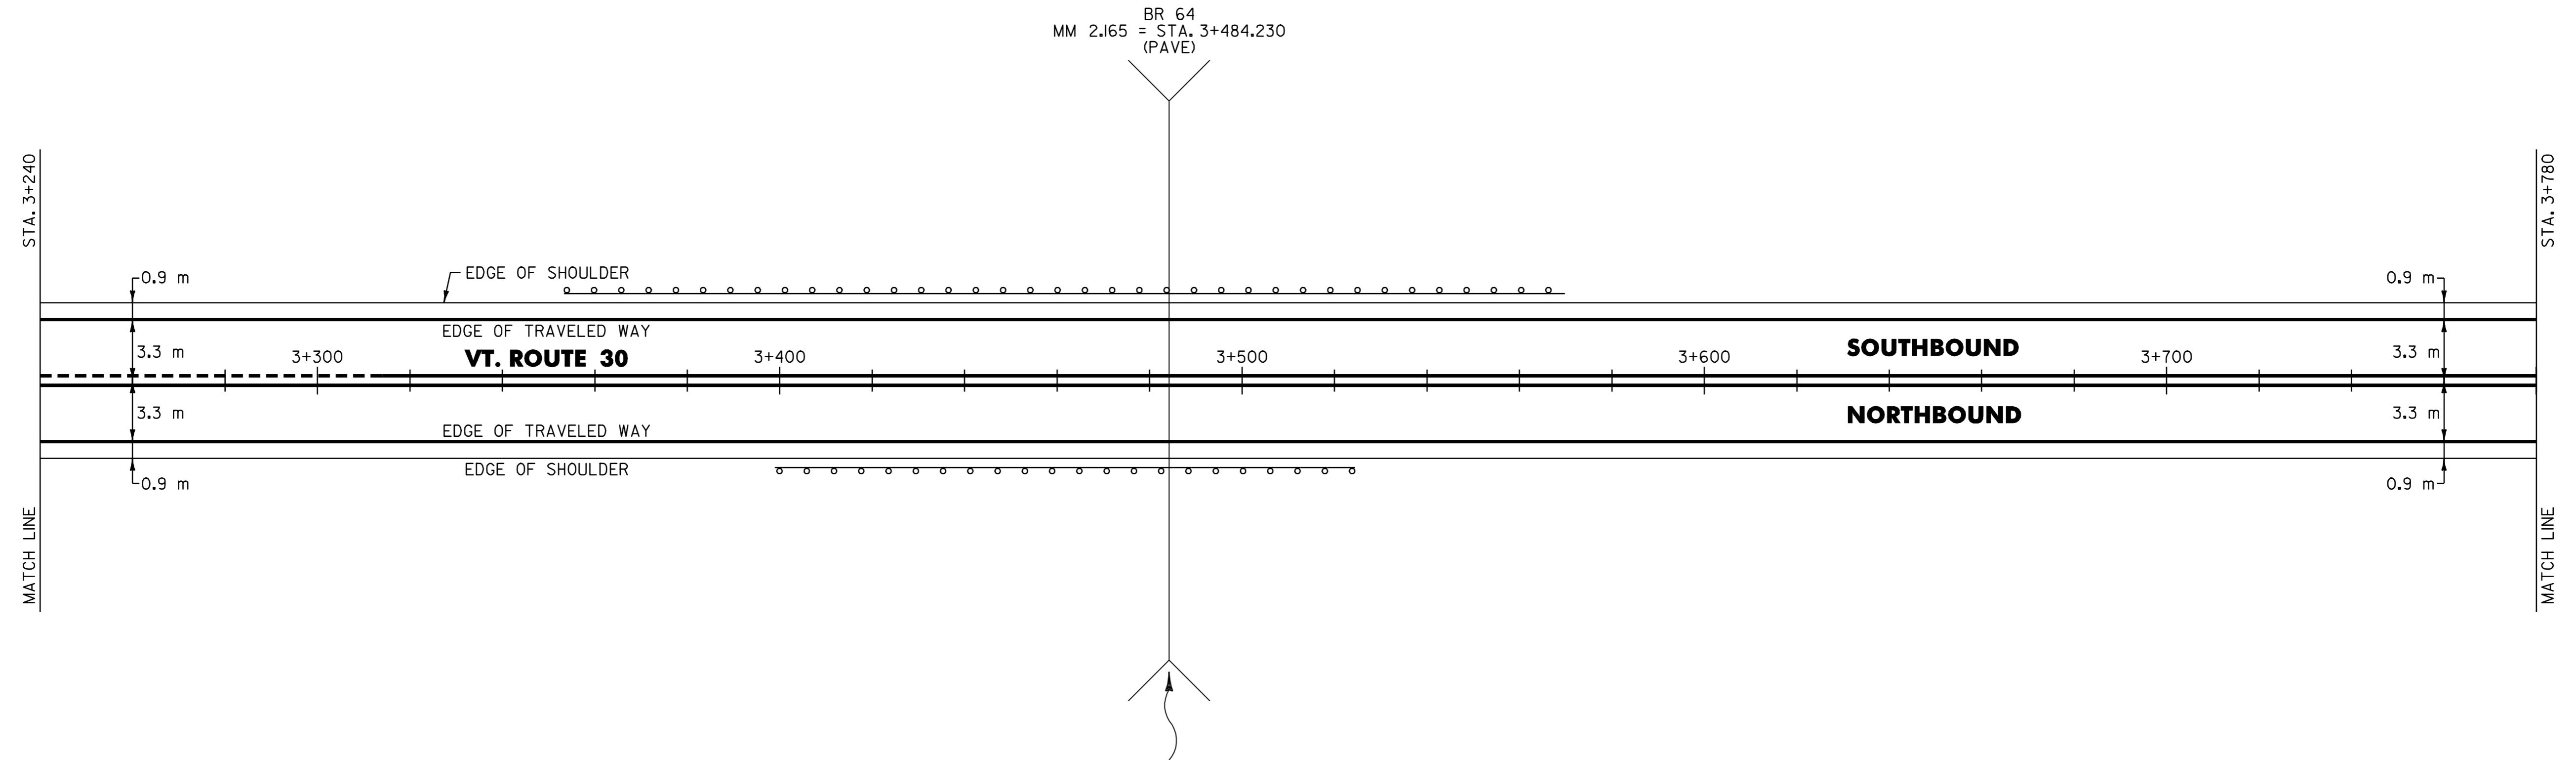

621.20 STEEL BEAM GUARDRAIL

RUPERT:
 STA. 3+411.8 - STA. 3+518.2 RT (106.4 m)

621.20 STEEL BEAM GUARDRAIL W/2.4 m POST (MOD.)

RUPERT:
 STA. 3+363.8 - STA. 3+557.6 LT (193.8 m)

621.505 MANUFACTURED TERMINAL SECTION

RUPERT:
 STA. 3+363.8 LT
 STA. 3+411.8 RT
 STA. 3+518.2 RT
 STA. 3+557.6 LT

621.80 REMOVAL AND DISPOSAL OF GUARDRAIL

RUPERT:
 STA. 3+386.0 - STA. 3+554.0 LT (168 m)
 STA. 3+420.0 - STA. 3+520.0 RT (100 m)

DATUM	
VERTICAL	N/A
HORIZONTAL	N/A

PAVING PROJECT LAYOUT	SURVEYED BY	N/A	DATE	N/A
	DRAWN BY	C.A.K.	DATE	4/01
	SQUAD LEADER	T.P.K.		
	DESIGN FILE NO.	/pave/00b048/pb048.dgn		
	IPARM FILE	pb048i07.i	DATE PLOTTED	\$DATE\$
	PROJ. NAME	RUPERT - PAWLET		
	PROJ. NO.	STP 2133(I)S		
	SHEET	14	OF	40 SHEETS