

646.40 DURABLE 100 mm WHITE LINE  
 (ALL LINES WILL INCLUDE EDGE LINE BREAKS AND RADIUS FOR TOWN HIGHWAYS)

RUPERT:  
 STA. 4+860.0 - STA. 5+400.0 LT & RT

646.60 TEMPORARY 100 mm WHITE LINE  
 (ALL LINES WILL INCLUDE EDGE LINE BREAKS AND RADIUS FOR TOWN HIGHWAYS)


RUPERT:  
 STA. 4+860.0 - STA. 5+400.0 LT & RT

646.41 DURABLE 100 mm YELLOW LINE  
 (ALL LINES WILL INCLUDE C/L BREAKS FOR TOWN HIGHWAYS) S=SOLID, D=DASHED

RUPERT: LT Q RT  
 STA. 4+860.0 - STA. 5+053.0 D - S  
 STA. 5+053.0 - STA. 5+327.0 S - S  
 STA. 5+327.0 - STA. 5+400.0 S - D

646.61 TEMPORARY 100 mm YELLOW LINE  
 (ALL LINES WILL INCLUDE C/L BREAKS FOR TOWN HIGHWAYS) S=SOLID, D=DASHED

RUPERT: LT Q RT  
 STA. 4+860.0 - STA. 5+053.0 D - S  
 STA. 5+053.0 - STA. 5+327.0 S - S  
 STA. 5+327.0 - STA. 5+400.0 S - D

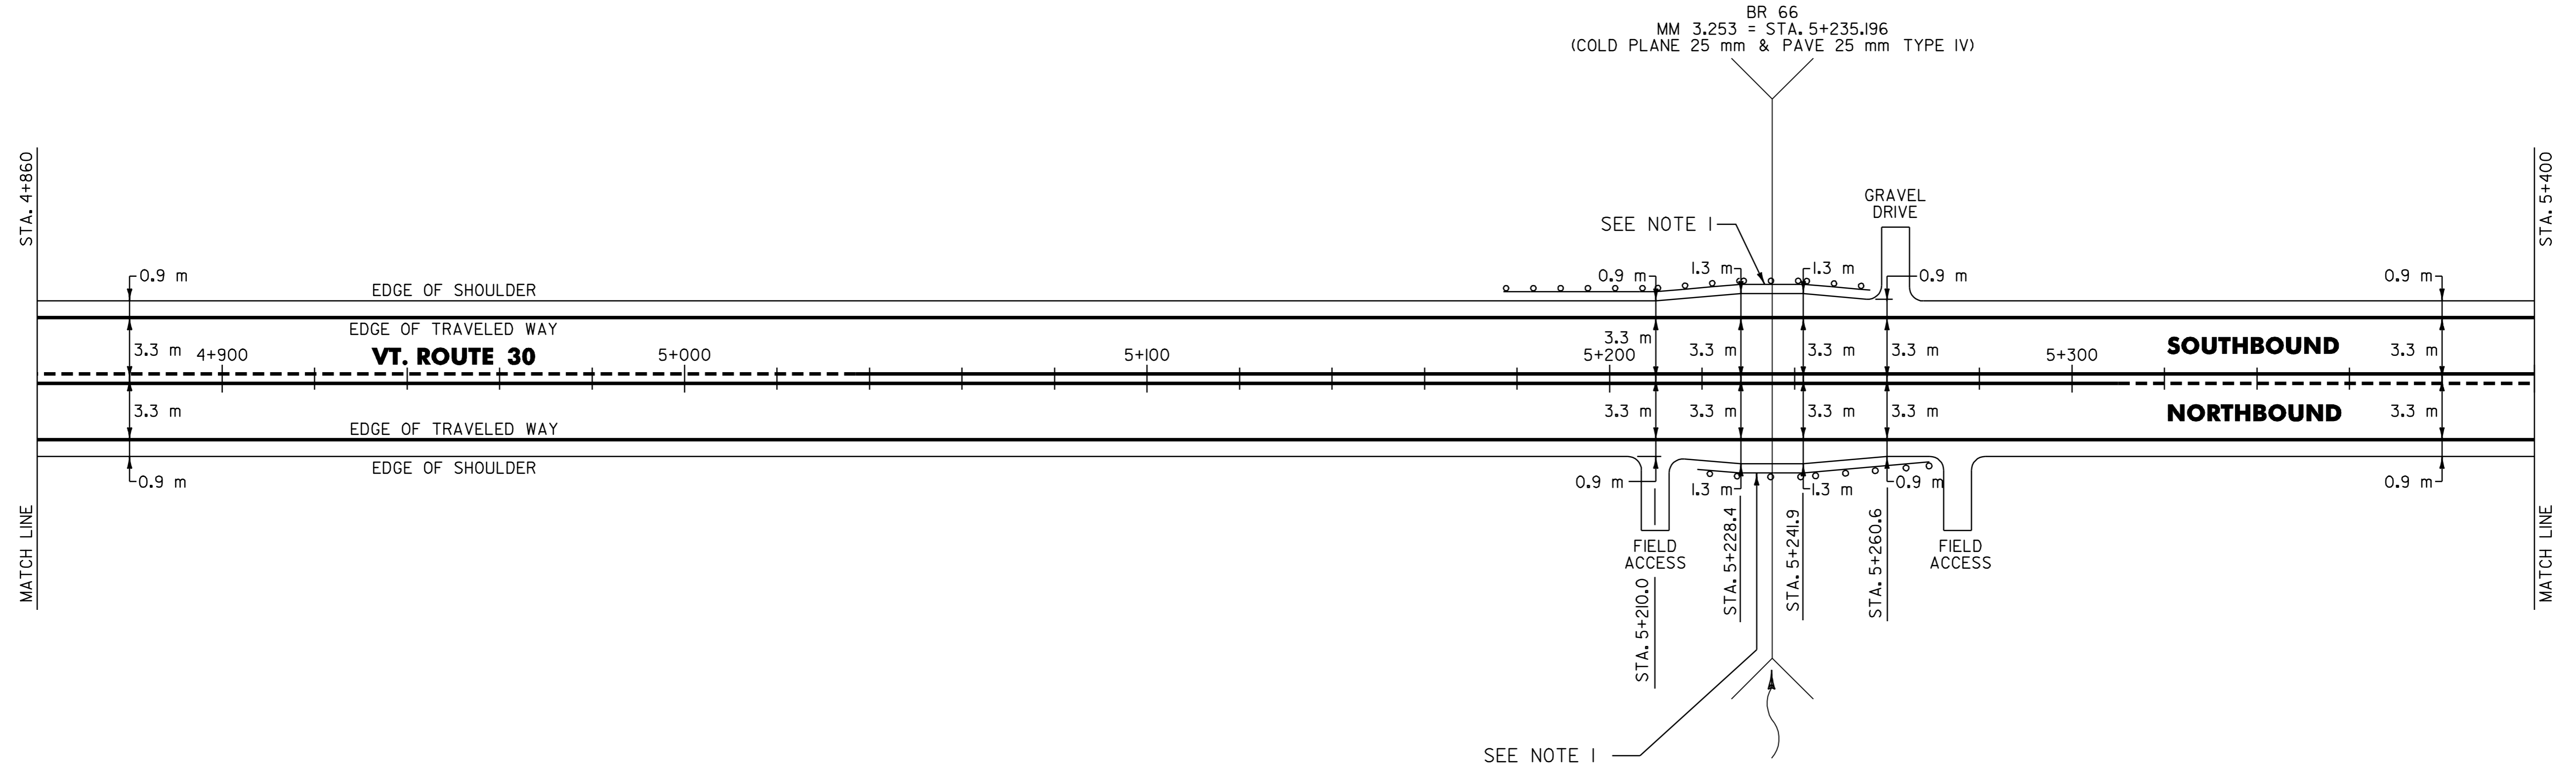

621.20 STEEL BEAM GUARDRAIL

RUPERT:  
 STA. 5+190.8 - STA. 5+221.2 LT (30.4 m)  
 STA. 5+219.0 - STA. 5+227.2 RT (8.2 m)  
 STA. 5+242.8 - STA. 5+251.0 LT (8.2 m)  
 STA. 5+247.8 - STA. 5+251.6 RT (3.8 m)

621.505 MANUFACTURED TERMINAL SECTION

RUPERT:  
 STA. 5+190.8 LT  
 STA. 5+251.6 RT

621.60 ANCHOR FOR STEEL BEAM RAIL

RUPERT:  
 STA. 5+221.5 RT  
 STA. 5+248.5 LT

621.70 GUARDRAIL APPROACH SECTION, TYPE II

RUPERT:  
 STA. 5+221.2 - STA. 5+225.0 LT (11EA)  
 STA. 5+227.2 - STA. 5+231.0 RT (11EA)  
 STA. 5+239.0 - STA. 5+242.8 LT (11EA)  
 STA. 5+244.0 - STA. 5+247.8 RT (11EA)

621.80 REMOVAL AND DISPOSAL OF GUARDRAIL

RUPERT:  
 STA. 5+214.0 - STA. 5+225.0 LT (11 m)  
 STA. 5+220.0 - STA. 5+231.0 RT (11EA)  
 STA. 5+239.0 - STA. 5+251.0 LT (12 EA) 11m  
 STA. 5+244.0 - STA. 5+265.0 RT (21EA) 11m

NOTE:

1. SEE SHEET 33 OF 40 FOR BR 66 DETAILS.  
 SEE SHEETS 36 OF 40 & 37 OF 40 FOR BRIDGE APPROACH SECTION DETAILS.

DATUM	
VERTICAL	N/A
HORIZONTAL	N/A

<b>PAVING PROJECT LAYOUT</b>	SURVEYED BY	N/A	DATE	N/A
	DRAWN BY	C.A.K.	DATE	4/01
	SQUAD LEADER	T.P.K.		
	DESIGN FILE NO.	/pave/00b048/pb048.dgn		
	IPARM FILE	pb048i10.i	DATE PLOTTED	\$DATE\$
PROJ. NAME	RUPERT - PAWLET			
PROJ. NO.	STP 2133(I)S			
SHEET 17 OF 40	SHEETS			