


646.40 DURABLE 100 mm WHITE LINE
 (ALL LINES WILL INCLUDE EDGE LINE BREAKS AND RADIUS FOR TOWN HIGHWAYS)
 PAWLET:
 STA. 2+360.0 - STA. 2+900.0 LT & RT

646.41 DURABLE 100 mm YELLOW LINE
 (ALL LINES WILL INCLUDE C/L BREAKS FOR TOWN HIGHWAYS) S=SOLID, D=DASHED
 PAWLET: LT C RT
 STA. 2+360.0 - STA. 2+900.0 S - S

646.60 TEMPORARY 100 mm WHITE LINE
 (ALL LINES WILL INCLUDE EDGE LINE BREAKS AND RADIUS FOR TOWN HIGHWAYS)
 PAWLET:
 STA. 2+360.0 - STA. 2+900.0 LT & RT

646.61 TEMPORARY 100 mm YELLOW LINE
 (ALL LINES WILL INCLUDE C/L BREAKS FOR TOWN HIGHWAYS) S=SOLID, D=DASHED
 PAWLET: LT C RT
 STA. 2+360.0 - STA. 2+900.0 S - S

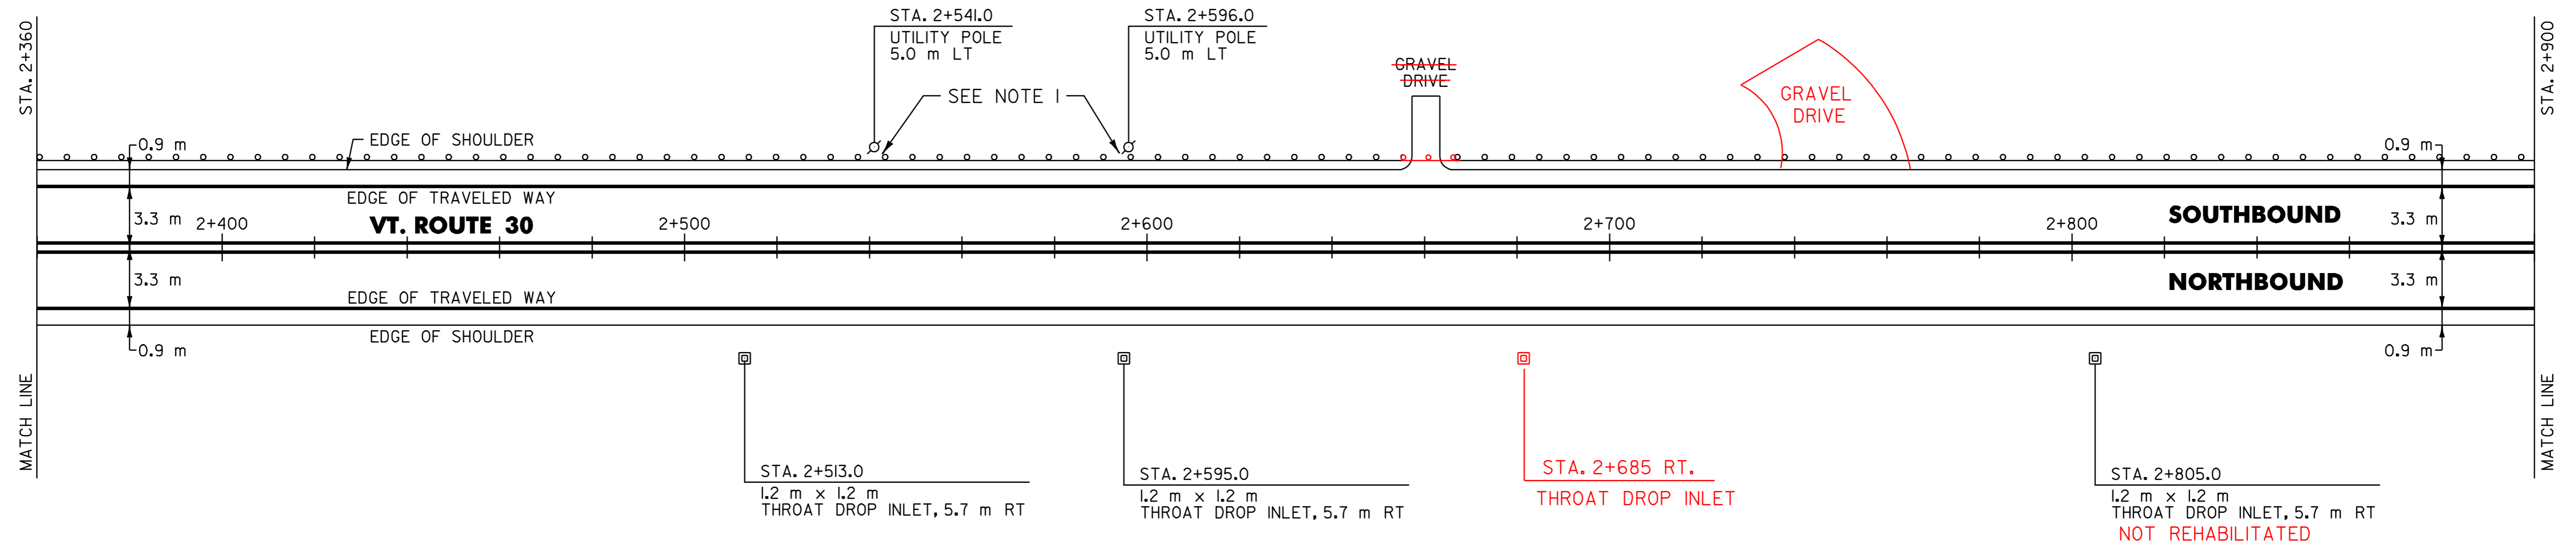

604.412 REHABING DI, CB OR MH, CLASS I

PAWLET:
 STA. 2+513.0 RT
 STA. 2+595.0 RT
 STA. 2+805.0 RT
 685.0

621.20 STEEL BEAM GUARDRAIL

PAWLET:
 STA. 2+777.4 - STA. 2+900.0 LT (122.6 m)
 777.51

621.20 STEEL BEAM GUARDRAIL W/2.4 m POSTS (MOD.)

PAWLET:
 STA. 2+360.0 - STA. 2+740.6 LT (380.6 m)
 740.6
 737.57

621.505 MANUFACTURED TERMINAL SECTION

PAWLET:
 STA. 2+740.6 LT 737.57
 STA. 2+777.4 LT 777.51

621.80 REMOVAL AND DISPOSAL OF GUARDRAIL

PAWLET: 749.0 389
 STA. 2+360.0 - STA. 2+740.6 LT (380.6 m)
 STA. 2+766.0 - STA. 2+900.0 LT (134 m)

NOTE:

1. SEE SHEET 38 OF 40 FOR REDUCED STEEL BEAM GUARDRAIL POST SPACING DETAIL.

DATUM	
VERTICAL	N/A
HORIZONTAL	N/A

PAVING PROJECT LAYOUT

SURVEYED BY	N/A	DATE	N/A
DRAWN BY	C.A.K.	DATE	4/01
SQUAD LEADER	T.P.K.		
DESIGN FILE NO.	/pave/00b048/pb048.dgn		
IPARM FILE	pb048117.i	DATE PLOTTED	\$DATE\$
PROJ. NAME	RUPERT - PAWLET		
PROJ. NO.	STP 2133(I)S		
SHEET	24 OF 40	SHEETS	