


646.40 DURABLE 100 mm WHITE LINE
 (ALL LINES WILL INCLUDE EDGE LINE BREAKS AND RADIUS FOR TOWN HIGHWAYS)
 PAWLET:
 STA. 2+900.0 - STA. 3+440.0 LT & RT

646.41 DURABLE 100 mm YELLOW LINE
 (ALL LINES WILL INCLUDE C/L BREAKS FOR TOWN HIGHWAYS) S=SOLID, D=DASHED
 PAWLET: LT CL RT
 STA. 2+900.0 - STA. 3+440.0 S - S

646.60 TEMPORARY 100 mm WHITE LINE
 (ALL LINES WILL INCLUDE EDGE LINE BREAKS AND RADIUS FOR TOWN HIGHWAYS)
 PAWLET:
 STA. 2+900.0 - STA. 3+440.0 LT & RT

646.61 TEMPORARY 100 mm YELLOW LINE
 (ALL LINES WILL INCLUDE C/L BREAKS FOR TOWN HIGHWAYS) S=SOLID, D=DASHED
 PAWLET: LT CL RT
 STA. 2+900.0 - STA. 3+440.0 S - S

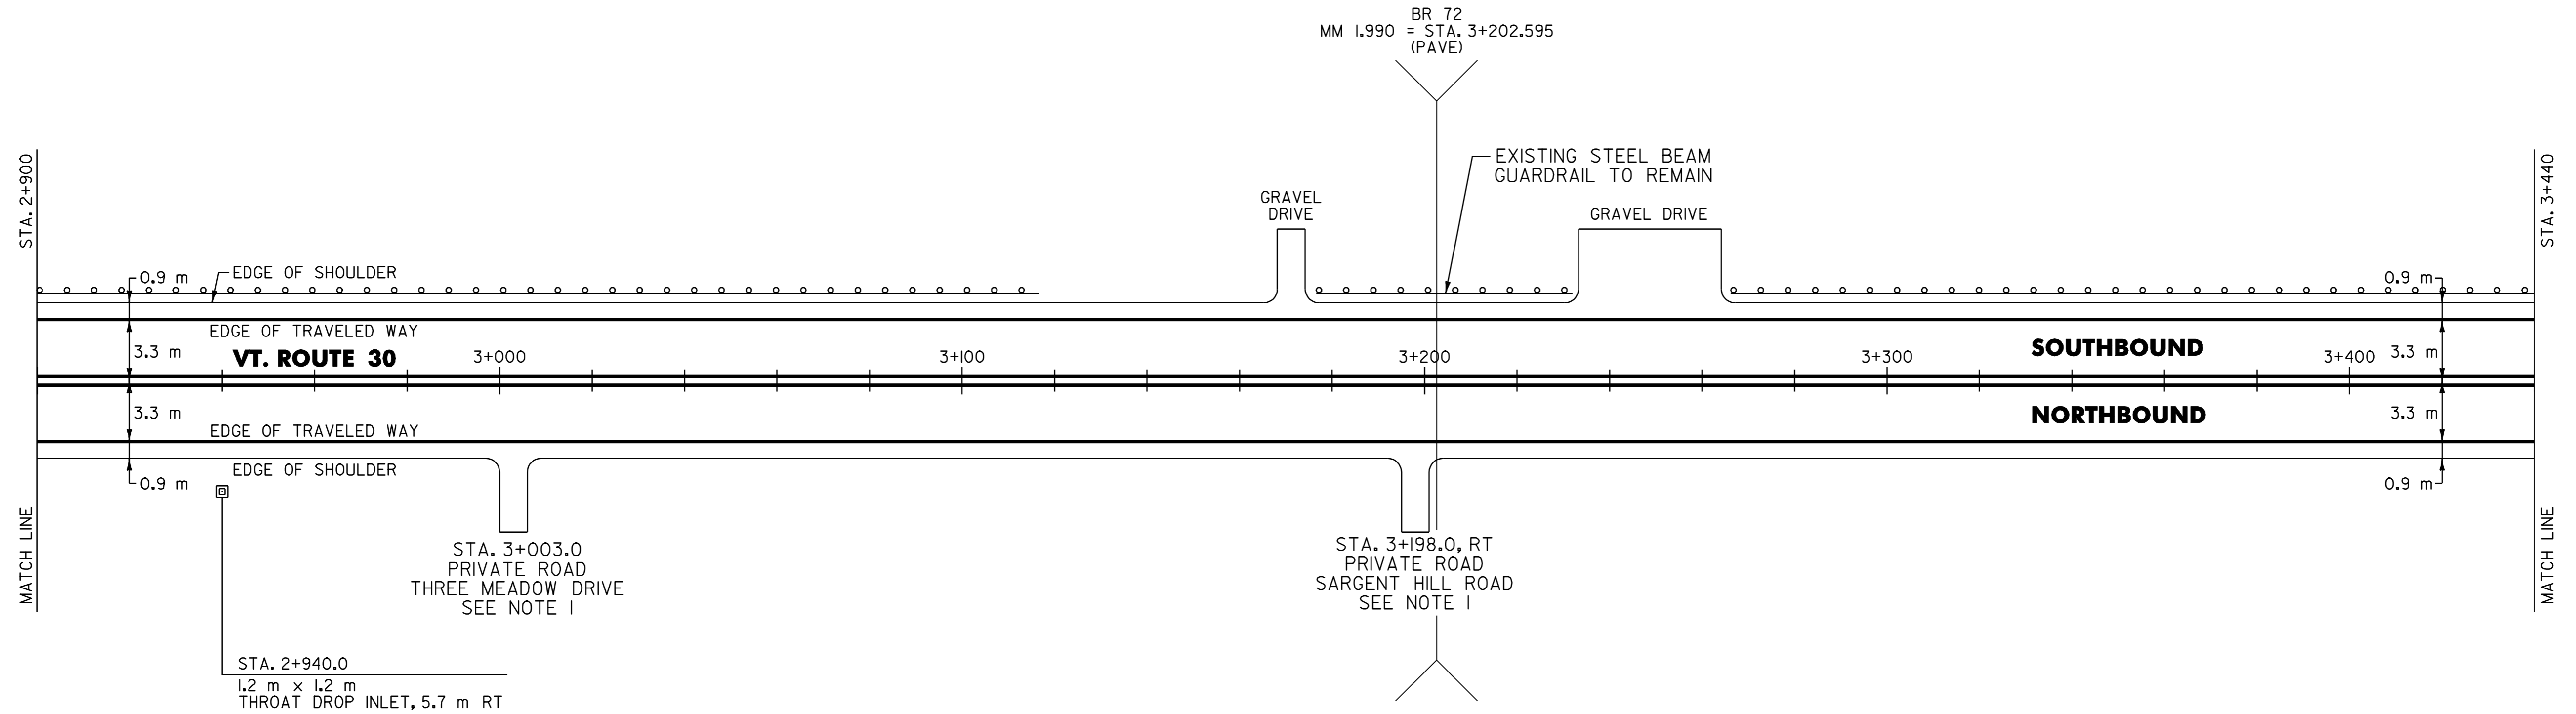

NOTE:

- I. PROVIDE A 25 mm TYPE IV 5 m WIDE APRON FOR THE EXISTING PRIVATE ROAD. ANY REQUIRED EXCAVATION SHALL BE PERFORMED AS DIRECTED BY THE RESIDENT ENGINEER AND PAID FOR UNDER ITEM 210.10 OR 608.25

604.412 REHABING DI, CB OR MH, CLASS I
 PAWLET:
 STA. 2+940.0 RT

621.20 STEEL BEAM GUARDRAIL
 PAWLET:
 STA. 2+900.0 - STA. 3+15.6 LT (215.6 m)
 STA. 3+282.5 - STA. 3+434.5 LT (152 m)

621.505 MANUFACTURED TERMINAL SECTION
 PAWLET:
 STA. 3+15.6 LT 116.6
 STA. 3+282.5 LT
 STA. 3+434.5 LT

621.80 REMOVAL AND DISPOSAL OF GUARDRAIL
 PAWLET:
 STA. 2+900.0 - STA. 3+118.0 LT (218 m)
 STA. 3+271.0 - STA. 3+440.0 LT (169 m)

DATUM	
VERTICAL	N/A
HORIZONTAL	N/A

**PAVING
PROJECT
LAYOUT**

SURVEYED BY	N/A	DATE	N/A
DRAWN BY	C.A.K.	DATE	4/01
SQUAD LEADER	T.P.K.		
DESIGN FILE NO.	/pave/00b048/pb048.dgn		
IPARM FILE	pb048118.i	DATE PLOTTED	\$DATE\$
PROJ. NAME	RUPERT - PAWLET		
PROJ. NO.	STP 2133(I)S		
SHEET	25 OF 40	SHEETS	