


646.40 DURABLE 100 mm WHITE LINE
 (ALL LINES WILL INCLUDE EDGE LINE BREAKS AND RADIUS FOR TOWN HIGHWAYS)
 PAWLET:
 STA. 3+440.0 - STA. 3+860.816 LT & RT

646.41 DURABLE 100 mm YELLOW LINE
 (ALL LINES WILL INCLUDE C/L BREAKS FOR TOWN HIGHWAYS) S=SOLID, D=DASHED
 PAWLET: LT C RT
 STA. 3+440.0 - STA. 3+860.816 S - S

646.60 TEMPORARY 100 mm WHITE LINE
 (ALL LINES WILL INCLUDE EDGE LINE BREAKS AND RADIUS FOR TOWN HIGHWAYS)
 PAWLET:
 STA. 3+440.0 - STA. 3+860.816 LT & RT

646.61 TEMPORARY 100 mm YELLOW LINE
 (ALL LINES WILL INCLUDE C/L BREAKS FOR TOWN HIGHWAYS) S=SOLID, D=DASHED
 PAWLET: LT C RT
 STA. 3+440.0 - STA. 3+860.816 S - S

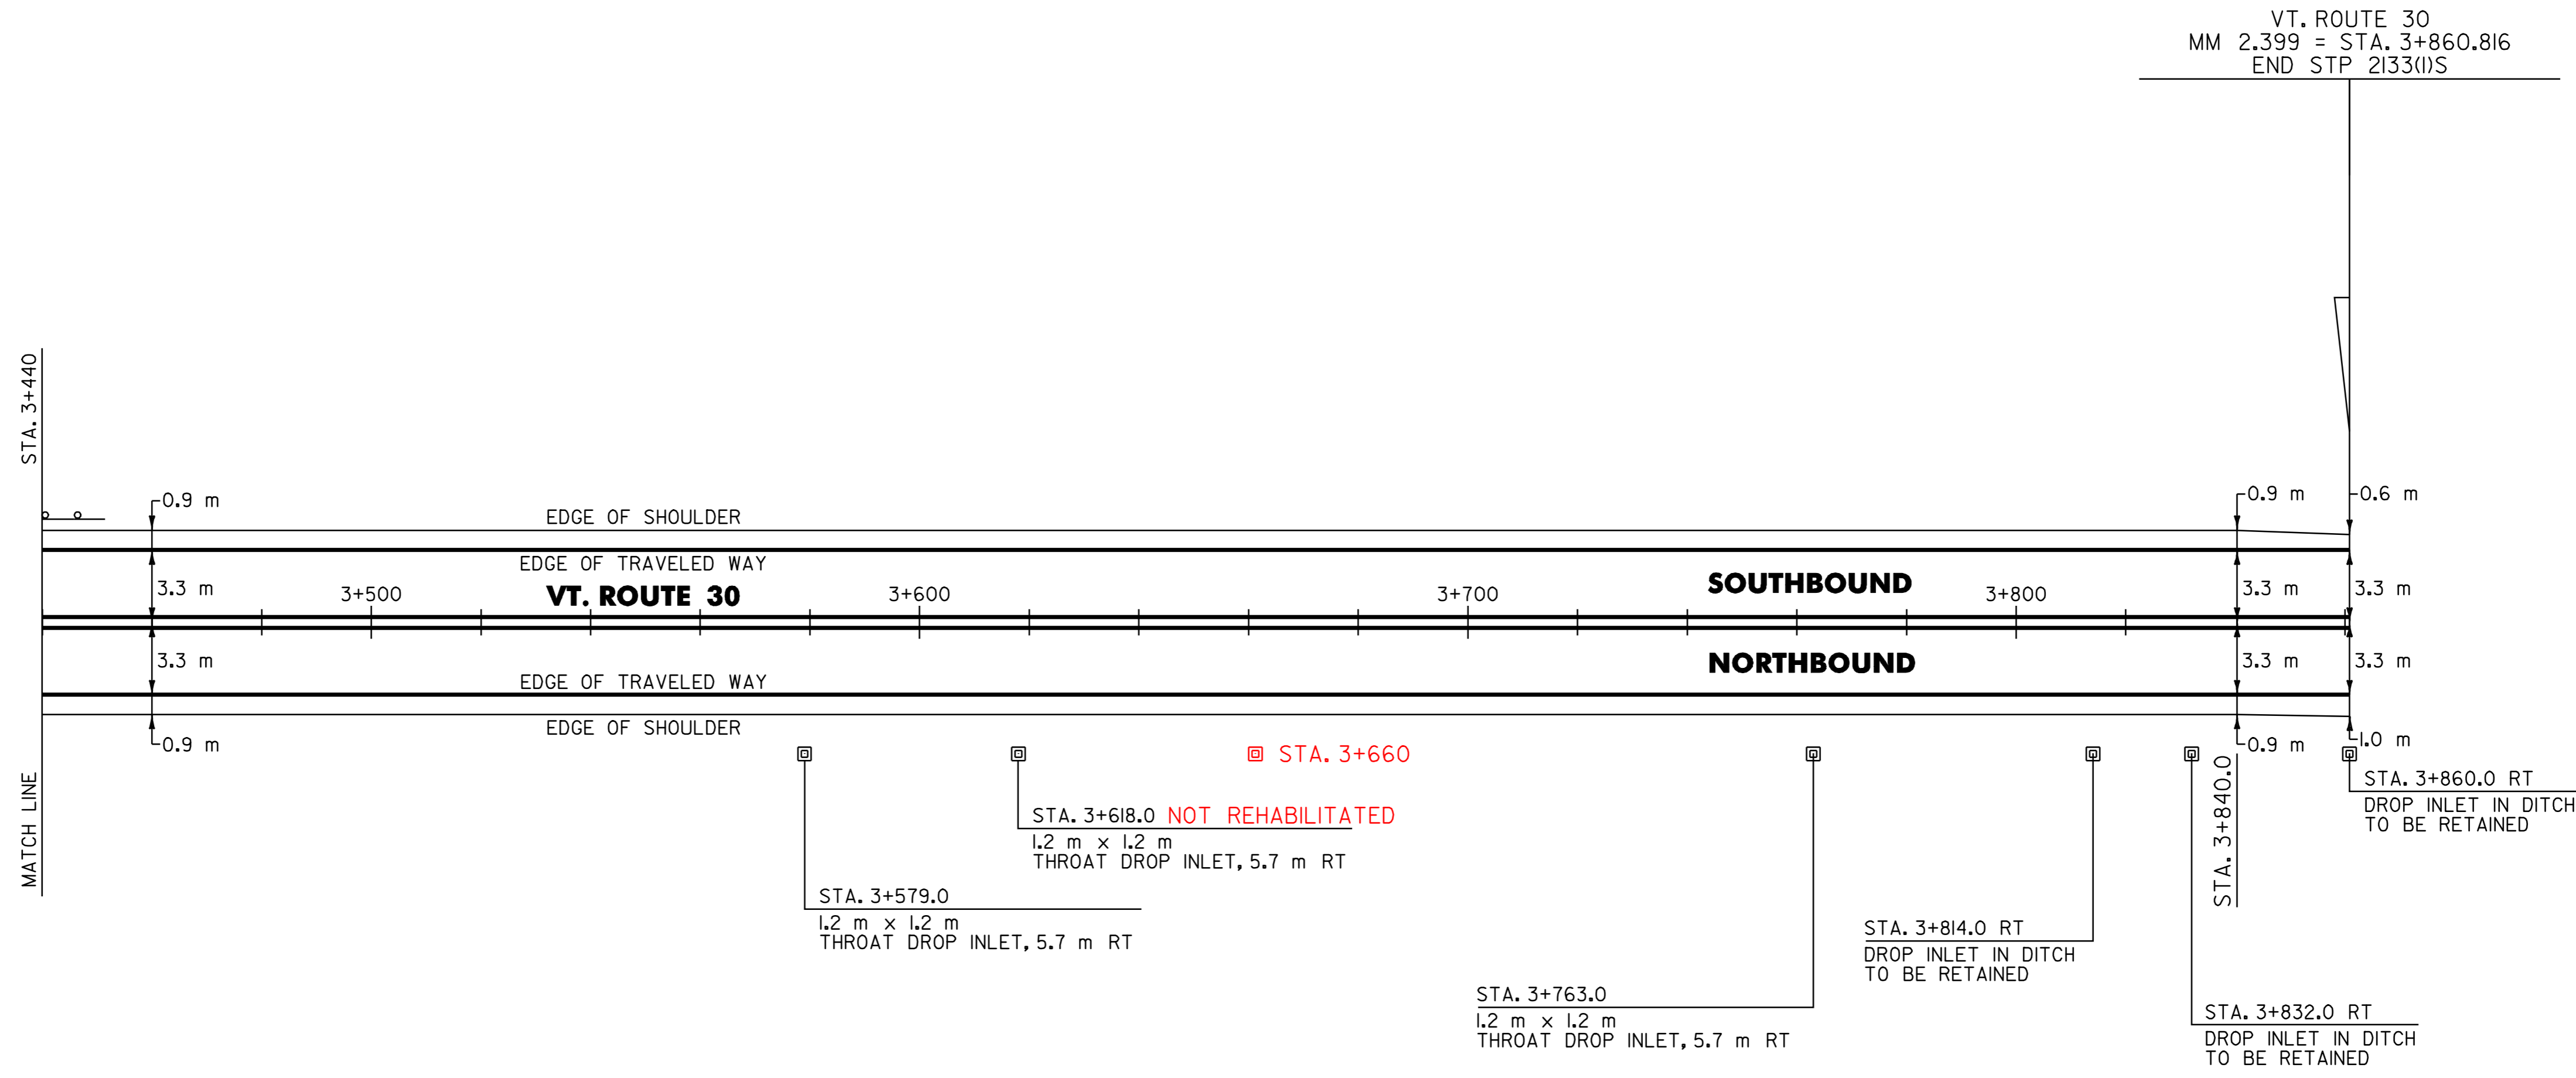

604.412 REHABING DI, CB OR MH, CLASS I
 PAWLET:
 STA. 3+579.0 RT
 STA. 3+618.0 RT 660
 STA. 3+763.0 RT

621.80 REMOVAL AND DISPOSAL OF GUARDRAIL
 PAWLET:
 STA. 3+440.0 - STA. 3+446.0 LT (6.0 m)

DATUM	
VERTICAL	N/A
HORIZONTAL	N/A

<h2>PAVING PROJECT LAYOUT</h2>	SURVEYED BY	N/A	DATE	N/A
	DRAWN BY	C.A.K.	DATE	4/01
	SQUAD LEADER	T.P.K.		
	DESIGN FILE NO.	/pave/00b048/pb048.dgn		
	IPARM FILE	pb048i19.i	DATE PLOTTED	\$DATE\$
	PROJ. NAME	RUPERT - PAWLET		
	PROJ. NO.	STP 2133(I)S		
	SHEET	26	OF	40 SHEETS