


**- TYPICAL SECTION AT GUARD RAIL -**  
(@ EXISTING GRAVEL SHOULDER)

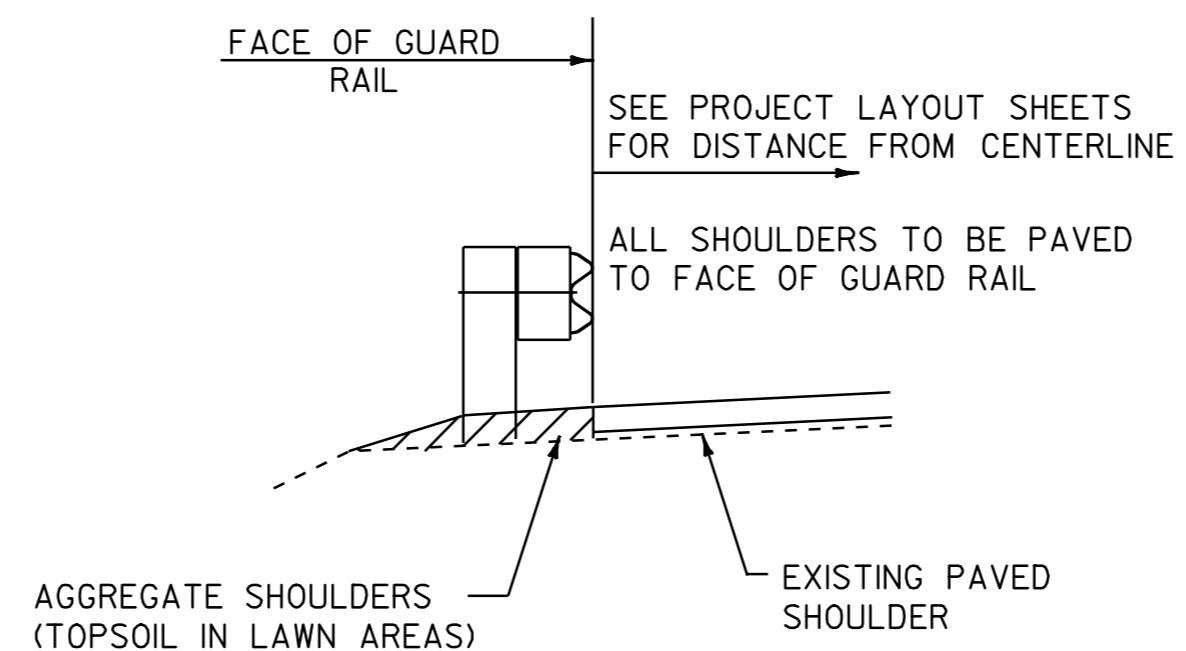

**- TYPICAL SECTION AT GUARD RAIL -**  
(@ EXISTING PAVED SHOULDER)

**CONSERVATION SEED MIX**  
RURAL AREA - SEED MIXTURE

% WT.	Ibs./ACRE	NAME	PUR%	GERM%
37.5	22.5	CREEPING RED FESCUE	98	85
37.5	22.5	TALL FESCUE	95	90
5.0	3	RED TOP	95	90
15.0	9	BIRDSFOOT TREFOIL	98	85
5.0	3	ANNUAL RYEGRASS	95	85
100.0	60			

SEED MIXTURE:  
SHALL NOT HAVE A WEED CONTENT EXCEEDING 0.40% BY WEIGHT AND SHALL BE FREE OF ALL NOXIOUS SEED.

SEED:  
TO BE APPLIED PER SEEDING FORMULAS OR AS DIRECTED BY THE ENGINEER.

FERTILIZER:  
FORMULA 10-20-10, TO BE USED WITH SEED, APPLIED AT THE RATE OF 500 IBS/ACRE. (HYDRO SEEDERS MAY USE 19-19-19 FORMULA)

AGRICULTURAL LIMESTONE:  
TO BE APPLIED AT THE RATE OF 2.0 TONS/ACRE, OR AS DIRECTED BY THE ENGINEER.

HAY MULCH:  
TO BE PLACED ON EARTH SLOPES AT THE RATE OF 2.0 TONS/ACRE, OR AS DIRECTED BY THE ENGINEER.

TOPSOIL:  
TO BE USED AS INDICATED ON THE PLANS, OR AS DIRECTED BY THE ENGINEER.

<b>PROJECT TYPICAL SHEET #2</b>	DESIGNED BY <u>BCE/PJM</u> DATE <u>4-06</u>
	DRAWN BY <u>C.E.A., INC.</u> DATE <u>4-06</u>
	DESIGN FILE NO. <u>p00B056.dgn</u>
	PRF FILE <u>p00B056+yp2.1</u> DATE PLOTTED <u>15-MAY-2008 14</u>
	PROJ. NAME <b>GREENSBORO - GLOVER</b>
PROJ. NO. <b>STP 2226(1)S</b>	
SHEET <b>3</b> OF <b>19</b> SHEETS	