


TEMPORARY AND DURABLE 4 in YELLOW LINE	
STA 226+93 TO 227+57	SOLID LT&RT
STA 227+57 TO 234+43	SOLID LT & DASHED RT
STA 234+43 TO 236+02	DASHED
STA 236+02 TO 243+94	DASHED LT & SOLID RT
STA 243+94 TO 247+10	SOLID LT&RT
STA 247+10 TO 254+50	SOLID LT & DASHED RT
STA 254+50 TO 254+67	DASHED

TEMPORARY AND DURABLE 4 in WHITE LINE	
STA 226+93 TO 254+67	SOLID LT&RT

VT ROUTE 16
 STA 226+93 = MM 4.298
 BEGIN PROJECT STP 2226(1)S

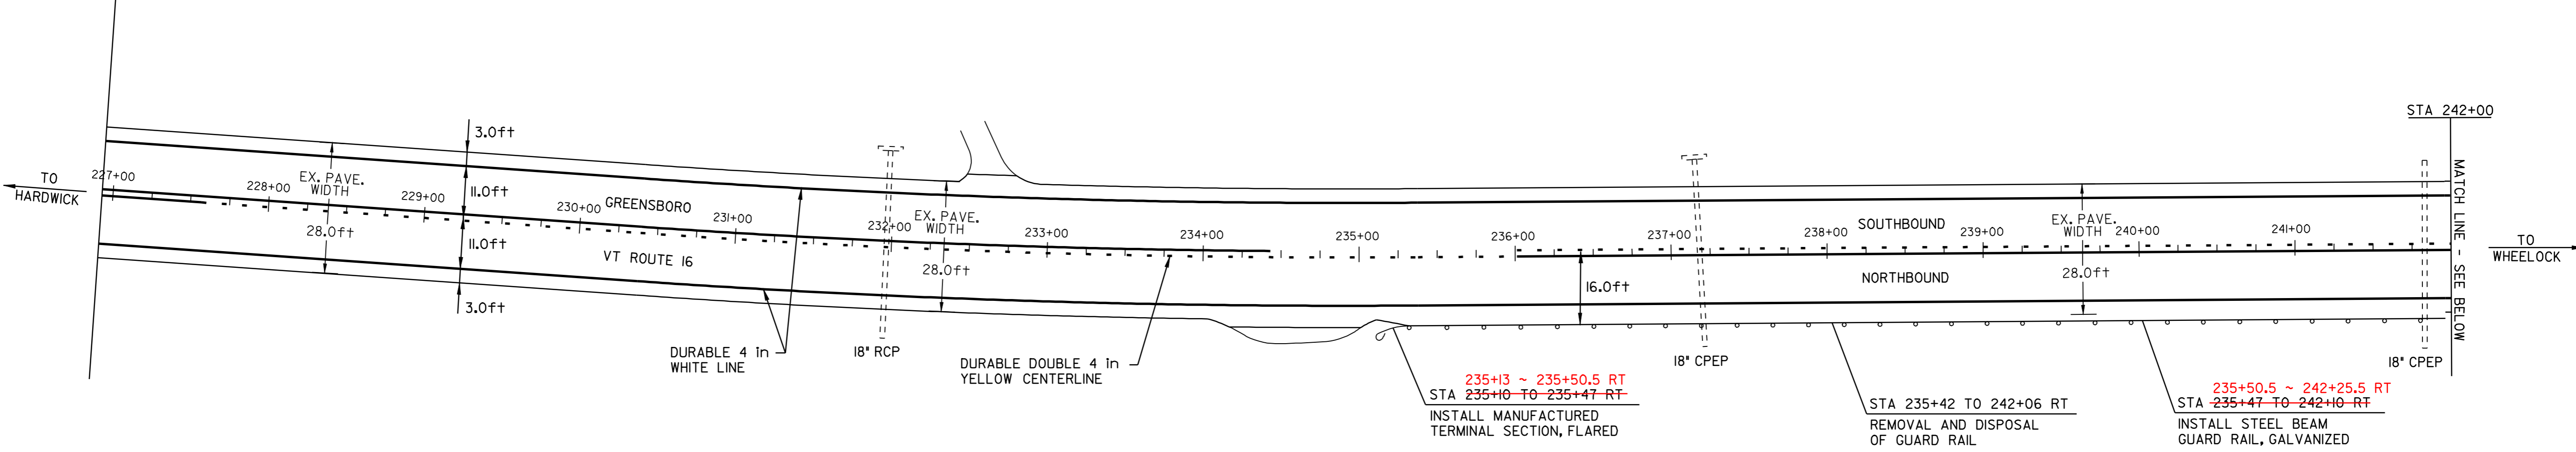


REMOVAL AND DISPOSAL OF GUARD RAIL
 STA 235+42 TO 242+06 RT

MANUFACTURED TERMINAL SECTION, FLARED
 STA 235+10 TO 235+47 RT 235+13 ~ 235+50.5 RT
 STA 242+10 TO 242+47 RT 242+25.5 ~ 242+63 RT

STEEL BEAM GUARD RAIL, GALVANIZED
 STA 235+47 TO 242+10 RT 235+50.5 ~ 242+25.5 RT

TOWN LINE
 GREENSBORO STA 254+67 (MM 4.823)
 WHEELOCK STA 0+00 (MM 0.000)

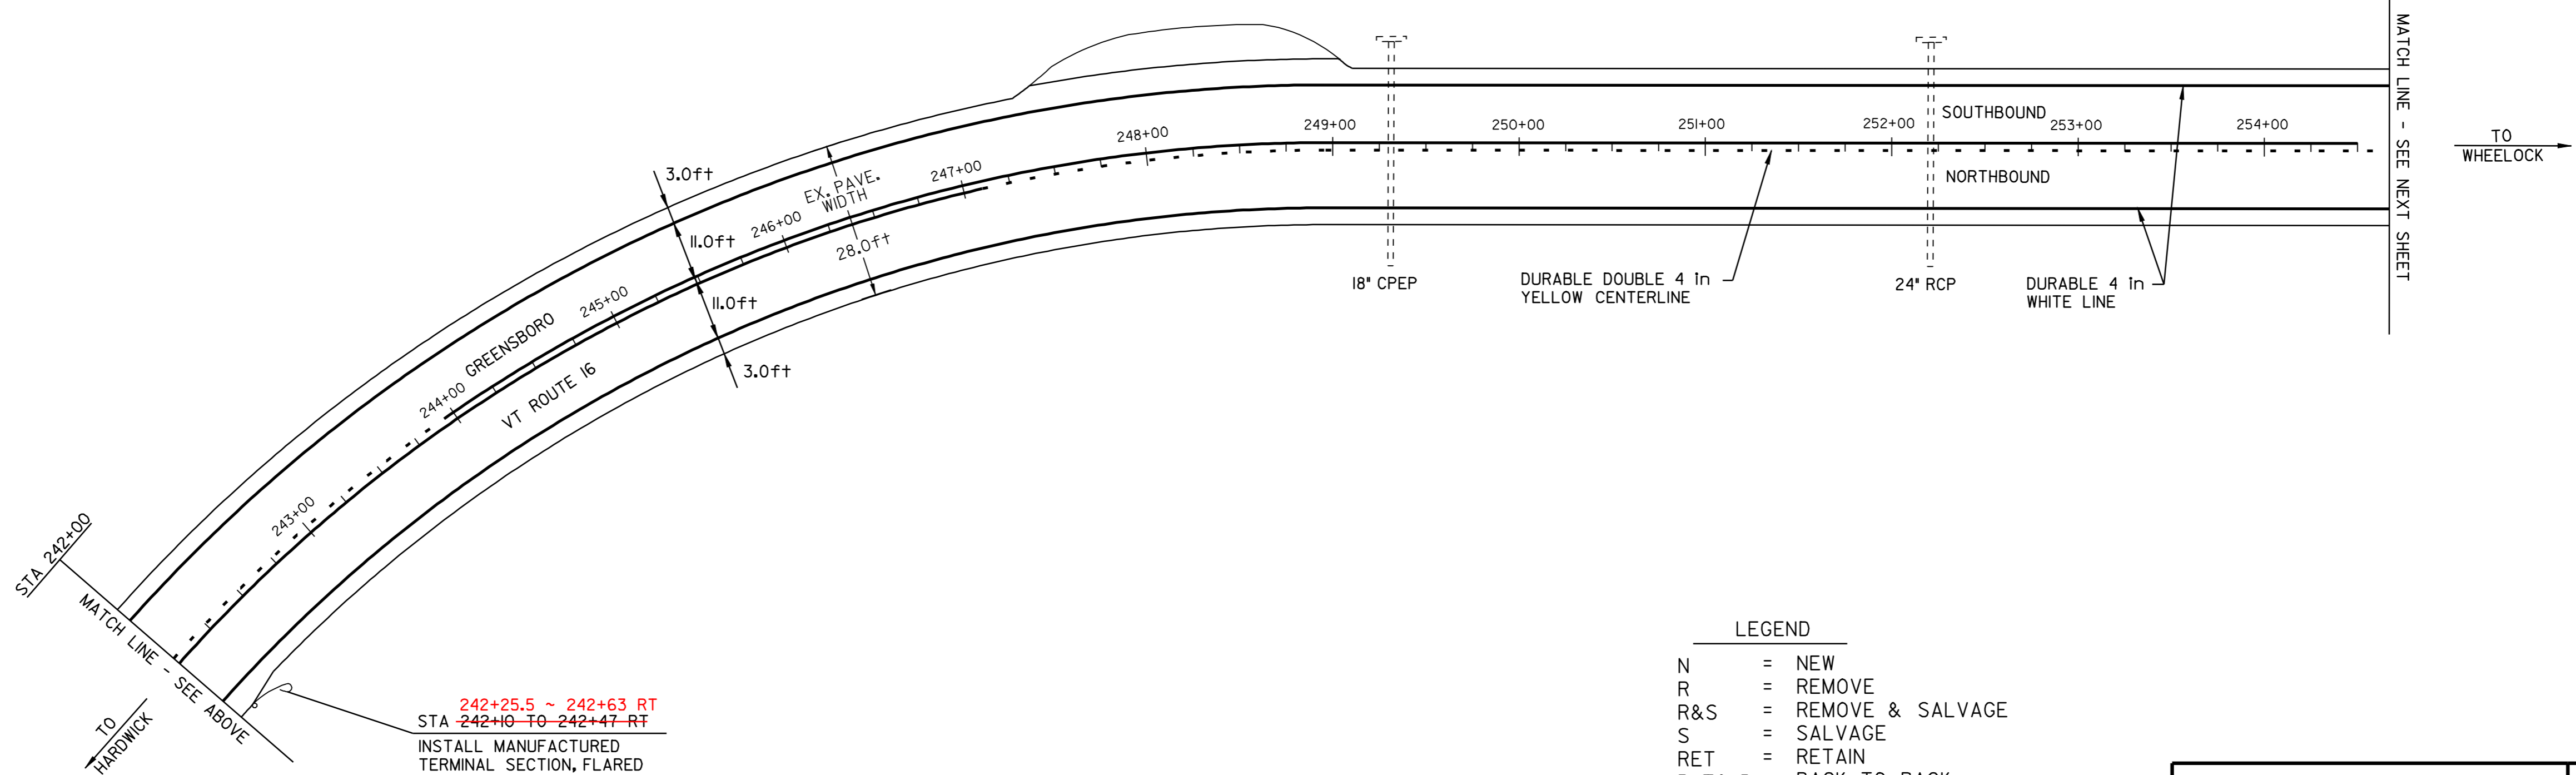

242+25.5 ~ 242+63 RT
 STA 242+10 TO 242+47 RT
 INSTALL MANUFACTURED
 TERMINAL SECTION, FLARED

LEGEND

N	=	NEW
R	=	REMOVE
R&S	=	REMOVE & SALVAGE
S	=	SALVAGE
RET	=	RETAIN
B-TO-B	=	BACK TO BACK
⊕	⊞	CATCH BASIN/DI
⊙	⊞	EXISTING THROAT DI
I		MARKER POST
⊗		UTILITY POLE
⊗/I		UTIL. POLE W/UNDERGROUND UTIL.
⌞		DRIVE

<h1>PAVING PROJECT LAYOUT SHEET #1</h1>	DESIGNED BY	BCE/PJM	DATE	3-06
	DRAWN BY	C.E.A., INC.	DATE	3-06
	DESIGN FILE NO.	p00B056.dgn		
	PRF FILE	p00B056(0).l	DATE PLOTTED	15-MAY-2008 14
	PROJ. NAME	GREENSBORO-GLOVER		
PROJ. NO.	STP 2226(1)S			
SHEET	8	OF	19	SHEETS