


REMOVAL AND DISPOSAL OF GUARD RAIL  
STA 294+64 TO 298+51LT

MANUFACTURED TERMINAL SECTION, FLARED  
STA 294+40 TO 294+77 LT- 294+7.5 ~ 294+55 LT  
STA 298+65 TO 299+02 LT- 298+7.5 ~ 298+55 LT

STEEL BEAM GUARD RAIL, GALVANIZED  
STA 294+77 TO 298+65 LT- 294+55 ~ 298+7.5 LT

STA 294+64 TO 298+51LT  
REMOVAL AND DISPOSAL OF GUARD RAIL  
294+7.5 ~ 294+55 LT  
~~STA 294+40 TO 294+77 LT~~  
INSTALL MANUFACTURED TERMINAL SECTION, FLARED  
294+55 ~ 298+7.5 LT  
~~STA 294+77 TO 298+65 LT~~  
INSTALL STEEL BEAM GUARD RAIL, GALVANIZED  
298+7.5 ~ 298+55 LT  
~~STA 298+65 TO 299+02 LT~~  
INSTALL MANUFACTURED TERMINAL SECTION, FLARED

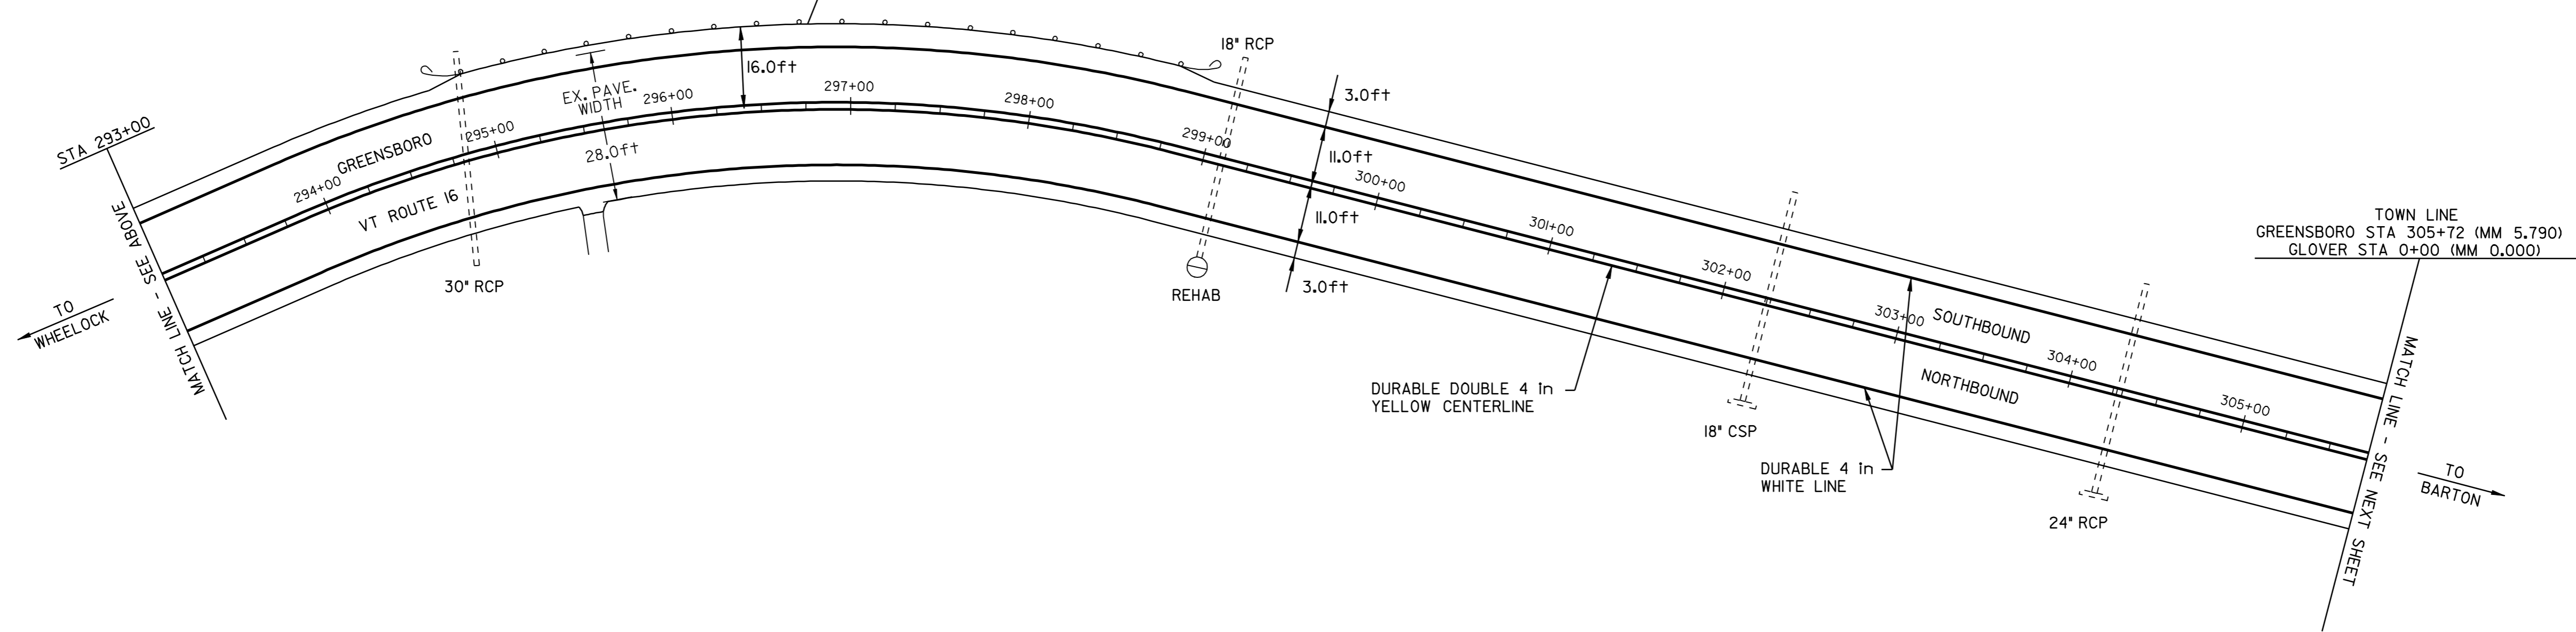

LEGEND

N	=	NEW
R	=	REMOVE
R&S	=	REMOVE & SALVAGE
S	=	SALVAGE
RET	=	RETAIN
B-TO-B	=	BACK TO BACK
⊕	⊞	CATCH BASIN/DI
⊕	⊞	EXISTING THROAT DI
I		MARKER POST
⊗		UTILITY POLE
⊗		UTIL. POLE W/UNDERGROUND UTIL.
⊞		DRIVE

## PAVING PROJECT LAYOUT SHEET #5

DESIGNED BY	BCE/PJM	DATE	3-06
DRAWN BY	C.E.A., INC.	DATE	3-06
DESIGN FILE NO.	p00B056.dgn		
PRF FILE	p00B056105.I	DATE PLOTTED	15-MAY-2008 14
PROJ. NAME	<b>GREENSBORO-GLOVER</b>		
PROJ. NO.	<b>STP 2226(1)S</b>		
SHEET	12	OF	19 SHEETS