


TEMPORARY AND DURABLE 4 in YELLOW LINE
 STA 0+00 TO 5+54 SOLID LT&RT
 STA 5+54 TO 13+46 SOLID LT & DASHED RT
 STA 13+46 TO 14+52 DASHED
 STA 14+52 TO 21+91 DASHED LT & SOLID RT
 STA 21+91 TO 30+00 SOLID LT&RT


TEMPORARY AND DURABLE 4 in WHITE LINE
 STA 0+00 TO 30+00 SOLID LT&RT

DITCHING LOCATIONS (REFER TO SHEET 7 FOR DETAILS)
 RUNAWAY POND REST AREA/PULL OFF

STA 8+07 TO 13+19 LT
 REMOVAL AND DISPOSAL OF GUARD RAIL
~~7+93 LT~~
~~STA 8+07 TO 13+31 LT~~
 INSTALL BURIED END TERMINAL, SEE SHEET 19 FOR DETAIL
~~7+93 ~ 13+43 LT~~
~~STA 8+07 TO 13+31 LT~~
 INSTALL STEEL BEAM GUARD RAIL, GALVANIZED
~~13+43 ~ 13+80.5 LT~~
~~STA 13+31 TO 13+68 LT~~
 INSTALL MANUFACTURED TERMINAL SECTION, FLARED

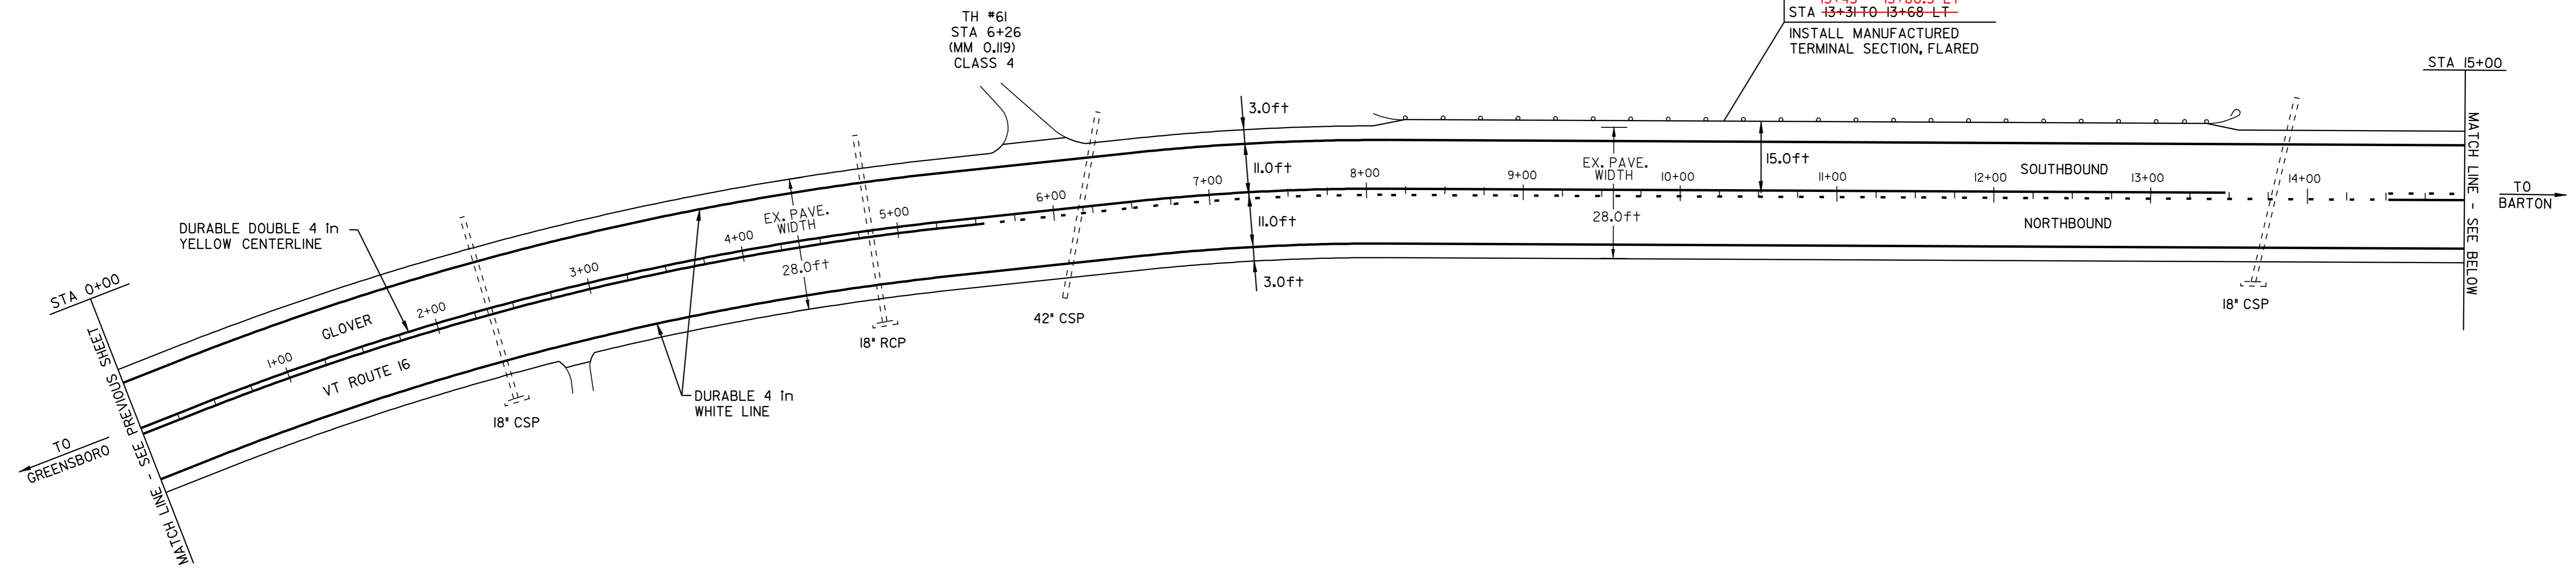

REMOVAL AND DISPOSAL OF GUARD RAIL
 STA 8+07 TO 13+19 LT
 ANCHOR FOR STEEL BEAM RAIL
~~STA 8+07 LT ~ 2~~
~~7+93 LT ~ 2~~
 STEEL BEAM GUARD RAIL, GALVANIZED
~~STA 8+07 TO 13+31 LT~~
~~7+93 ~ 13+43 LT~~
 MANUFACTURED TERMINAL SECTION, FLARED
~~STA 13+31 TO 13+68 LT~~
~~13+43 ~ 13+80.5 LT~~

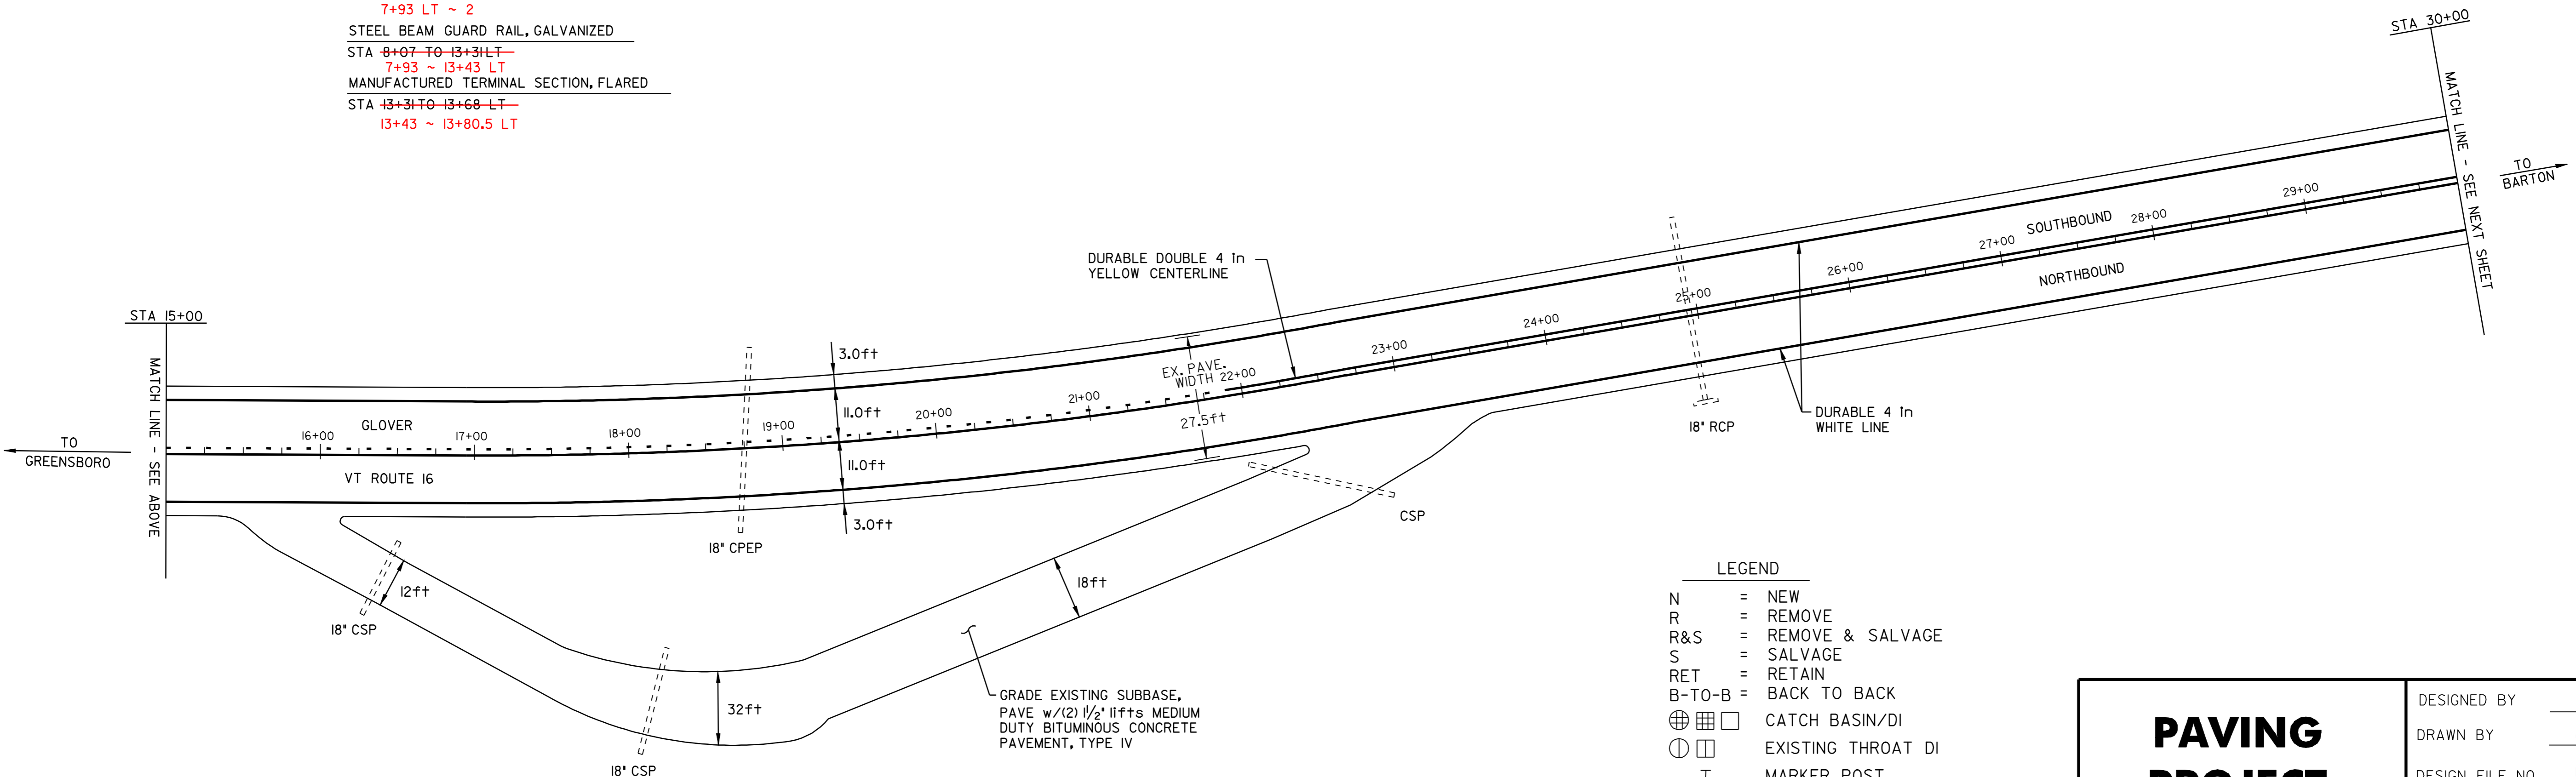

- LEGEND
- N = NEW
 - R = REMOVE
 - R&S = REMOVE & SALVAGE
 - S = SALVAGE
 - RET = RETAIN
 - B-TO-B = BACK TO BACK
 - ⊕ ⊞ ⊠ = CATCH BASIN/DI
 - ⊙ ⊞ = EXISTING THROAT DI
 - I = MARKER POST
 - ⊗ = UTILITY POLE
 - ⊗/I = UTIL. POLE W/UNDERGROUND UTIL.
 - ⌌ = DRIVE

PAVING PROJECT LAYOUT SHEET #6

DESIGNED BY	BCE/PJM	DATE	3-06
DRAWN BY	C.E.A., INC.	DATE	3-06
DESIGN FILE NO.	p00B056.dgn		
PRF FILE	p00B056I06.1	DATE PLOTTED	15-MAY-2008 14
PROJ. NAME	GREENSBORO-GLOVER		
PROJ. NO.	STP 2226(1)S		
SHEET	13	OF	19 SHEETS