


TEMPORARY AND DURABLE 4 in YELLOW LINE  
 STA 30+00 TO 60+00 SOLID LT&RT

TEMPORARY AND DURABLE 4 in WHITE LINE  
 STA 30+00 TO 60+00 SOLID LT&RT

~~YIELDING MARKER POST  
 STA 33+67 LT&RT 2~~

DITCHING LOCATIONS (REFER TO SHEET 7 FOR DETAILS)  
 STA 41+50 TO 43+75 RT  
 STA 52+75 TO 60+00 RT

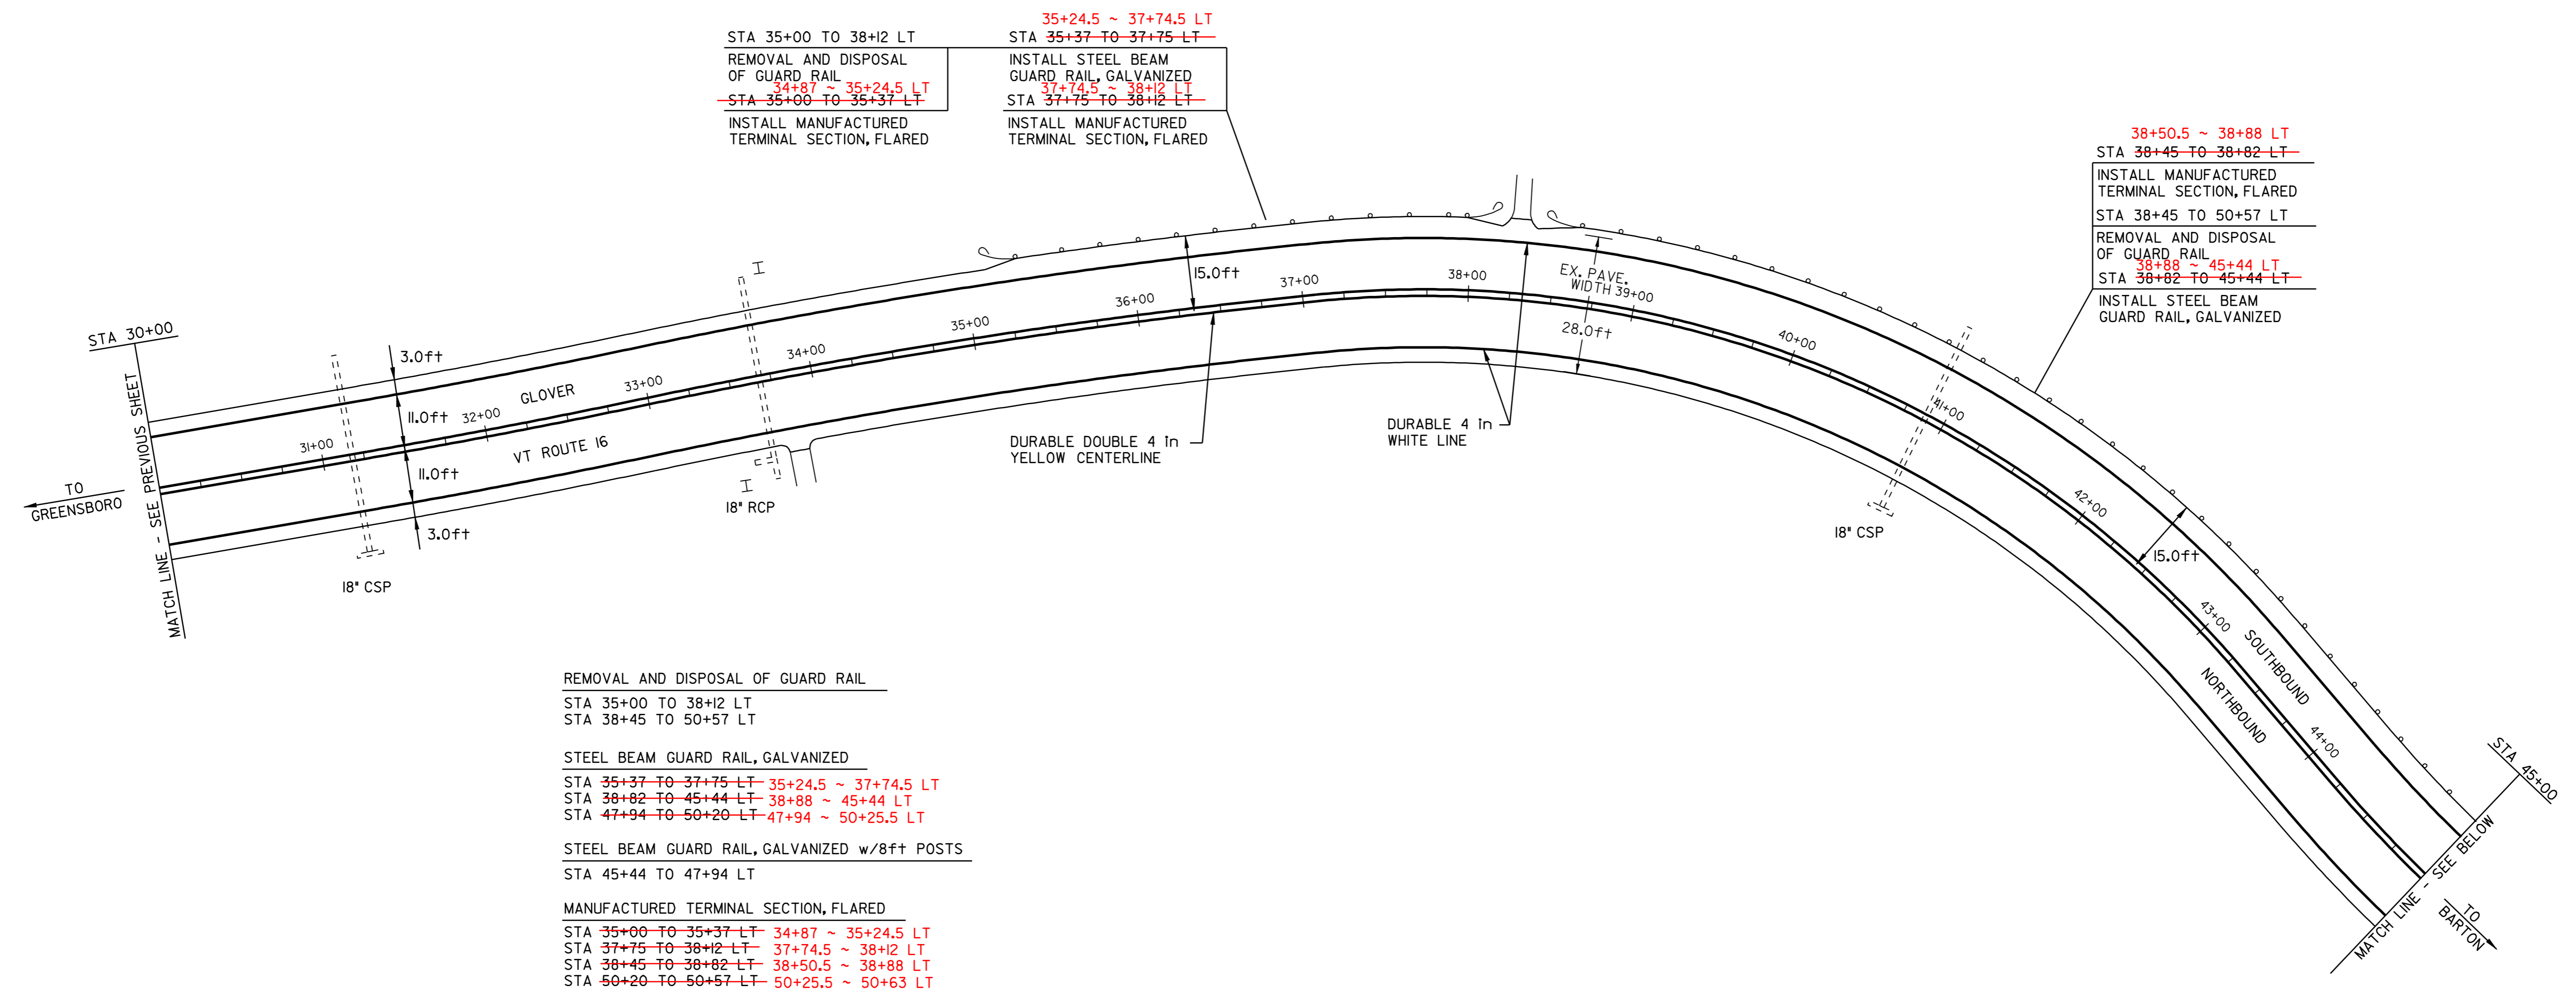

STA 35+00 TO 38+12 LT  
 REMOVAL AND DISPOSAL OF GUARD RAIL  
~~34+87 ~ 35+24.5 LT~~  
~~STA 35+00 TO 35+37 LT~~  
 INSTALL MANUFACTURED TERMINAL SECTION, FLARED

35+24.5 ~ 37+74.5 LT  
~~STA 35+37 TO 37+75 LT~~  
 37+74.5 ~ 38+12 LT  
~~STA 37+75 TO 38+12 LT~~  
 INSTALL STEEL BEAM GUARD RAIL, GALVANIZED  
 INSTALL MANUFACTURED TERMINAL SECTION, FLARED

38+50.5 ~ 38+88 LT  
~~STA 38+45 TO 38+82 LT~~  
 INSTALL MANUFACTURED TERMINAL SECTION, FLARED  
 STA 38+45 TO 50+57 LT  
 REMOVAL AND DISPOSAL OF GUARD RAIL  
 38+88 ~ 45+44 LT  
~~STA 38+82 TO 45+44 LT~~  
 INSTALL STEEL BEAM GUARD RAIL, GALVANIZED


REMOVAL AND DISPOSAL OF GUARD RAIL  
 STA 35+00 TO 38+12 LT  
 STA 38+45 TO 50+57 LT

STEEL BEAM GUARD RAIL, GALVANIZED  
 STA 35+37 TO 37+75 LT 35+24.5 ~ 37+74.5 LT  
 STA 38+82 TO 45+44 LT 38+88 ~ 45+44 LT  
 STA 47+94 TO 50+20 LT 47+94 ~ 50+25.5 LT

STEEL BEAM GUARD RAIL, GALVANIZED w/8ft POSTS  
 STA 45+44 TO 47+94 LT

MANUFACTURED TERMINAL SECTION, FLARED  
 STA 35+00 TO 35+37 LT 34+87 ~ 35+24.5 LT  
 STA 37+75 TO 38+12 LT 37+74.5 ~ 38+12 LT  
 STA 38+45 TO 38+82 LT 38+50.5 ~ 38+88 LT  
 STA 50+20 TO 50+57 LT 50+25.5 ~ 50+63 LT

STA 45+44 TO 47+94 LT  
 INSTALL STEEL BEAM GUARD RAIL, GALVANIZED w/8 ft POSTS  
 47+94 ~ 50+25.5 LT  
~~STA 47+94 TO 50+20 LT~~  
 INSTALL STEEL BEAM GUARD RAIL, GALVANIZED  
 50+25.5 ~ 50+63 LT  
~~STA 50+20 TO 50+57 LT~~  
 INSTALL MANUFACTURED TERMINAL SECTION, FLARED

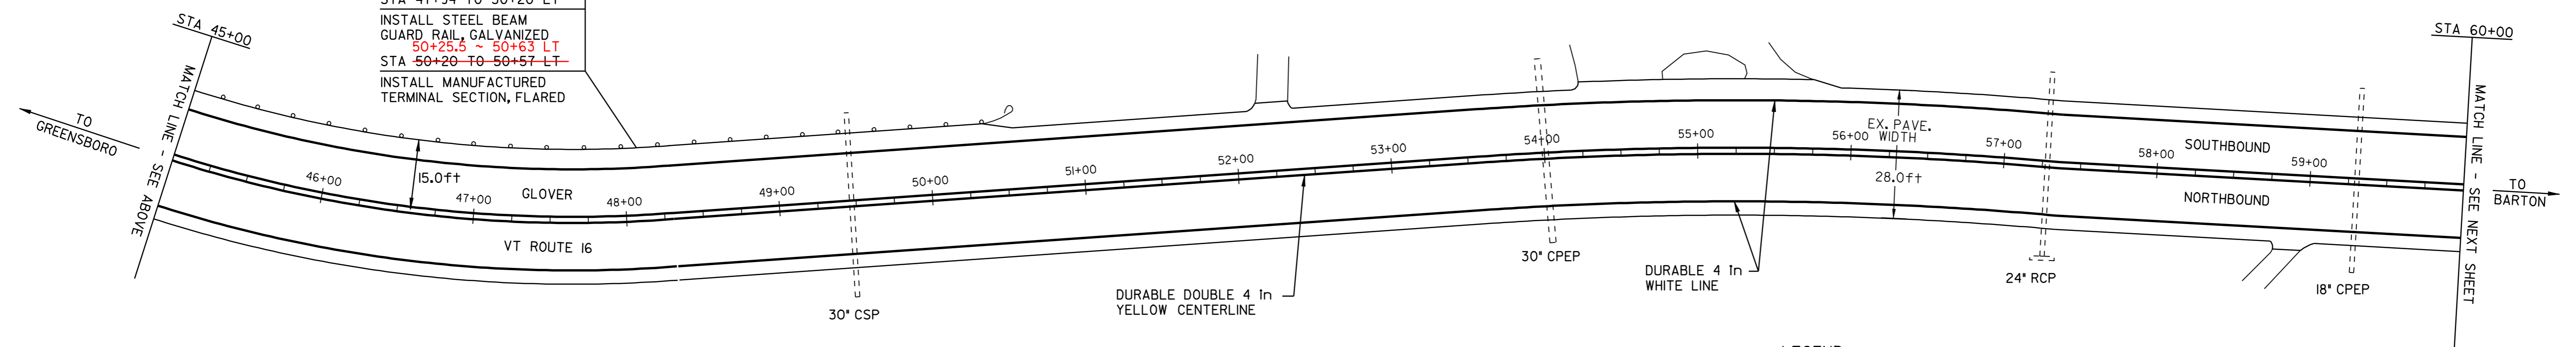

- LEGEND
- N = NEW
  - R = REMOVE
  - R&S = REMOVE & SALVAGE
  - S = SALVAGE
  - RET = RETAIN
  - B-TO-B = BACK TO BACK
  - ⊕ ⊞ ⊠ = CATCH BASIN/DI
  - ⊙ ⊞ = EXISTING THROAT DI
  - I = MARKER POST
  - ⊗ = UTILITY POLE
  - ⊗/⊗ = UTIL. POLE W/UNDERGROUND UTIL.
  - ⊞ = DRIVE

## PAVING PROJECT LAYOUT SHEET #7

DESIGNED BY	BCE/PJM	DATE	3-06
DRAWN BY	C.E.A., INC.	DATE	3-06
DESIGN FILE NO.	p00B056.dgn		
PRF FILE	p00B056107.i	DATE PLOTTED	15-MAY-2008 14
PROJ. NAME	GREENSBORO-GLOVER		
PROJ. NO.	STP 2226(1)S		
SHEET	14	OF	19 SHEETS