



TEMPORARY AND DURABLE 4 in YELLOW LINE  
 STA 60+00 TO 90+00  
 SOLID LT&RT

TEMPORARY AND DURABLE 4 in WHITE LINE  
 STA 60+00 TO 90+00  
 SOLID LT&RT

DITCHING LOCATIONS (REFER TO SHEET 7 FOR DETAILS)  
 STA 60+00 TO 72+20 RT  
 STA 74+75 TO 84+50 RT

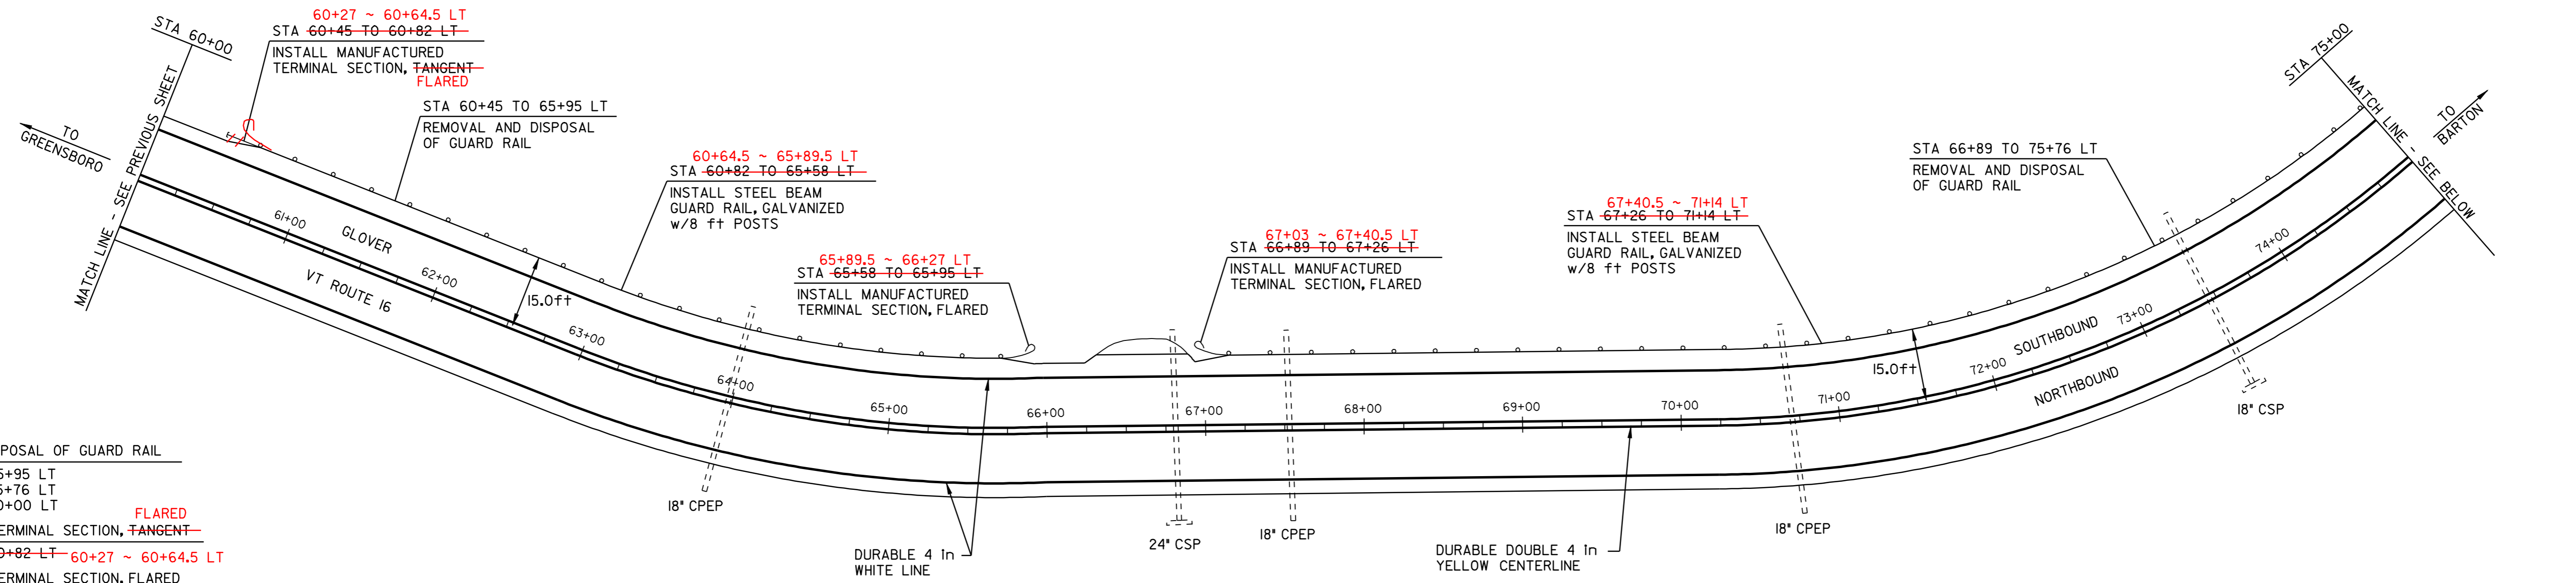

- REMOVAL AND DISPOSAL OF GUARD RAIL
- STA 60+45 TO 65+95 LT
- STA 66+89 TO 75+76 LT
- STA 88+56 TO 90+00 LT
- MANUFACTURED TERMINAL SECTION, TANGENT-FLARED
- STA ~~60+45 TO 60+82 LT~~ 60+27 ~ 60+64.5 LT
- MANUFACTURED TERMINAL SECTION, FLARED
- STA ~~65+58 TO 65+95 LT~~ 65+89.5 ~ 66+27 LT
- STA ~~66+89 TO 67+26 LT~~ 67+03 ~ 67+40.5 LT
- STA ~~75+89 TO 76+26 LT~~ 75+90.5 ~ 76+28 LT
- STA ~~88+56 TO 88+93 LT~~ 88+08 ~ 88+45.5 LT
- STEEL BEAM GUARD RAIL, GALVANIZED
- STA ~~71+14 TO 75+89 LT~~ 71+14 ~ 75+90.5 LT
- STA ~~88+93 TO 90+00 LT~~ 88+45.5 ~ 90+00 LT
- STEEL BEAM GUARD RAIL, GALVANIZED w/8ft POSTS
- STA ~~60+82 TO 65+58 LT~~ 60+64.5 ~ 65+89.5 LT
- STA ~~67+26 TO 71+14 LT~~ 67+40.5 ~ 71+14 LT

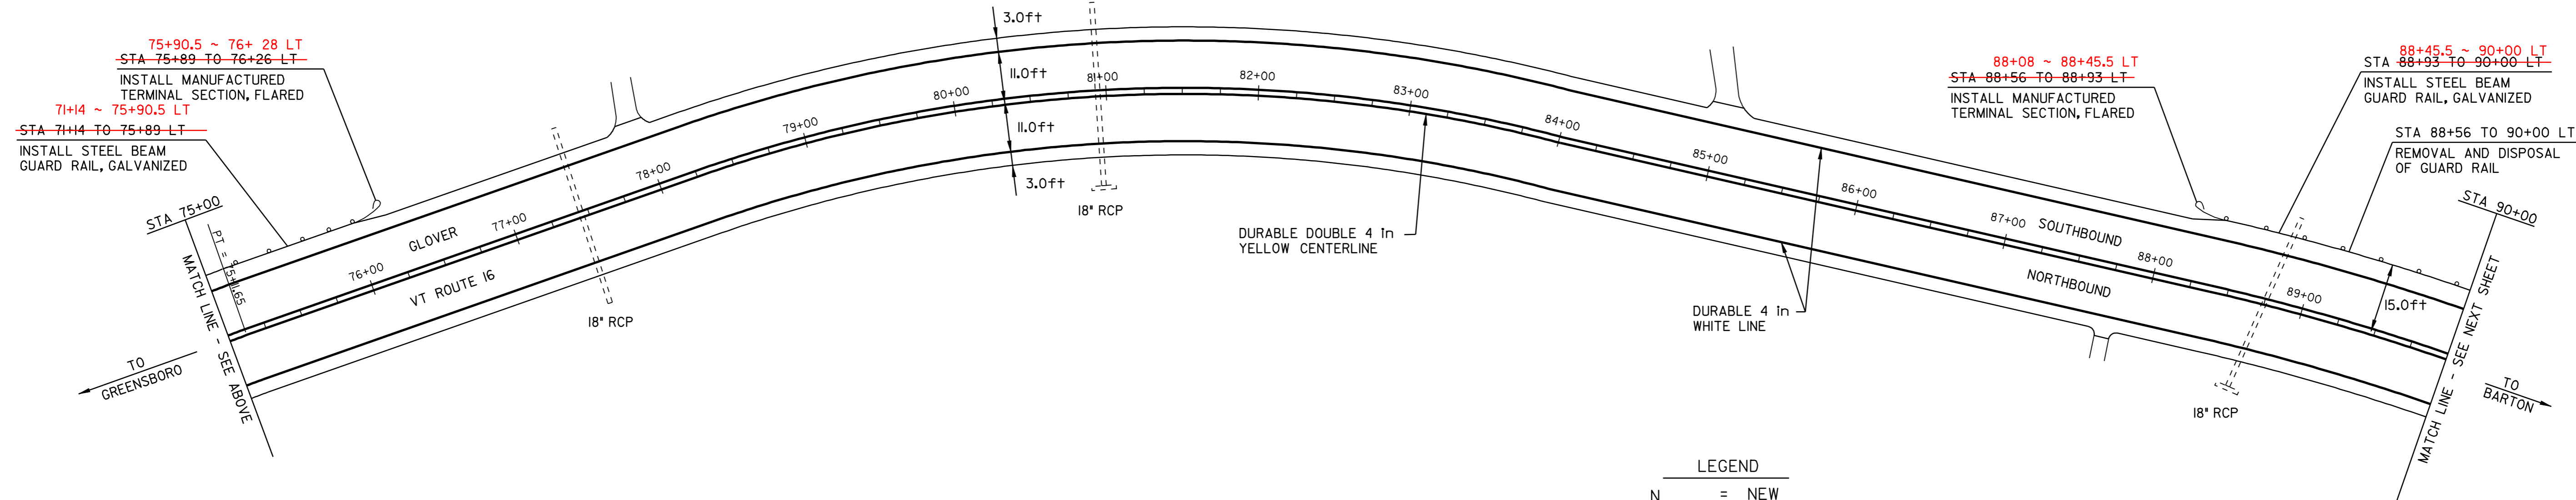

- LEGEND
- N = NEW
  - R = REMOVE
  - R&S = REMOVE & SALVAGE
  - S = SALVAGE
  - RET = RETAIN
  - B-TO-B = BACK TO BACK
  - ⊕ ⊞ □ = CATCH BASIN/DI
  - ⊙ ⊞ = EXISTING THROAT DI
  - I = MARKER POST
  - ⊗ = UTILITY POLE
  - ⊗/I = UTIL. POLE W/UNDERGROUND UTIL.
  - ⌌ = DRIVE

## PAVING PROJECT LAYOUT SHEET #8

DESIGNED BY	BCE/PJM	DATE	3-06
DRAWN BY	C.E.A., INC.	DATE	3-06
DESIGN FILE NO.	p00B056.dgn		
PRF FILE	p00B056I08.1	DATE PLOTTED	15-MAY-2008 14
PROJ. NAME	GREENSBORO-GLOVER		
PROJ. NO.	STP 2226(1)S		
SHEET	15	OF	19 SHEETS