



# INDEX OF SHEETS

<u>COMPOSITE SHEETS</u>	
1	TITLE SHEET
2	INDEX OF SHEETS
3-4	QUANTITY SHEETS
5	CONSTRUCTION APPROACH SIGNING DETAIL SHEET
<u>FAYSTON - WAITSFIELD STP 2406(1)S SHEETS</u>	
6	PROJECT TYPICAL SHEET
7	PAVING DETAILS & PAVEMENT JOINT DETAIL SHEET
8-9	QUANTITY SHEETS
10	ITEM DETAIL SUMMARY SHEET
11	DITCH CLEANING DETAIL SHEET
12-16	VT. ROUTE 17 PAVING PROJECT LAYOUT SHEETS
17-18	TRAFFIC SIGN SUMMARY SHEETS
19-22	BRIDGE DETAIL SHEETS
23	TERMINAL CONNECTOR FOR GUARDRAIL DETAIL SHEET
24	MISCELLANEOUS DETAIL SHEET
<u>WAITSFIELD - MORETOWN STP 2227(1)S SHEETS</u>	
25	PROJECT TYPICAL SHEET
26	PAVING DETAILS & PAVEMENT JOINT DETAIL SHEET
27-28	QUANTITY SHEETS
29	ITEM DETAIL SUMMARY SHEET
30	DITCH CLEANING DETAIL SHEET
31-42	VT. ROUTE 100 PAVING PROJECT LAYOUT SHEETS
43-44	TRAFFIC SIGN SUMMARY SHEETS
45	BRIDGE SUMMARY/DETAIL SHEET
46	BRIDGE # 181 DETAIL SHEET
47	BRIDGE # 186 DETAIL SHEET
48	BRIDGE # 185 DETAIL SHEET
49	MISCELLANEOUS DETAIL SHEET
50-54	SUPERELEVATION DIAGRAM SHEETS

<u>STANDARDS</u>		
B-17M	GUARDRAIL, BRIDGES, REST AREA, TURNOUTS	01/03/00
C-1M	TREATED TIMBER CURB	01/03/00
D-3M	TREATED GUTTERS	06/13/97
D-6M	REINFORCED CONCRETE DI W/ GRATE (DITCHES)	06/13/97
D-15M	PRECAST REINF CONCRETE CB OR MH W/ C I GRATE OR COVER, C I GRATE W/ FRAME, TYPES D & E	06/13/97
E-100	CONSTRUCTION APPROACH SIGNS	01/02/04
E-100A	SIDE ROAD CONSTRUCTION- APPROACH SIGNS	01/02/04
E-101	CONSTRUCTION SIGN DETAILS	05/30/03
E-102	CONSTRUCTION SIGN DETAILS	06/30/03
E-102A	CONSTRUCTION SIGN DETAILS	05/01/04
E-103	MAINLINE TRAFFIC CONTROL DIVIDED HIGHWAY- ONE LANE CLOSURE	03/01/04
E-106	TRAFFIC CONTROL - MISCELLANEOUS DETAILS	03/01/04
E-107	DELINEATION, BARRICADES AND DETOURS FOR U-TURNS ON DIVIDED HIGHWAYS.	06/30/03
E-107A	BREAKAWAY BARRICADE DETAILS	08/08/95
E-108	CONSTRUCTION ZONE LONGITUDINAL DROP-OFFS	08/18/95
E-110	MAJOR MAINTENANCE OPERATION LANE CLOSURE	08/08/95
E-121	STANDARD SIGN PLACEMENT - CONVENTIONAL ROAD	08/08/95
E-138	MILEMARK DETAILS - STATE & TOWN HIGHWAYS	05/30/03
E-141	REGULATORY SIGN DETAILS	09/20/95
E-143	REGULATORY SIGN DETAILS	06/15/04
E-150	WARNING SIGN DETAILS	05/01/04
E-153	WARNING SIGN DETAILS	05/01/04
E-160	FLANGED CHANNEL STEEL SIGN POST DETAIL	05/20/99
E-164	SQUARE STEEL SIGN POSTS	05/20/99
E-191	PAVEMENT MARKING DETAILS	02/01/99
E-193	PAVEMENT MARKING DETAILS	08/18/95
G-1M	STEEL BEAM GUARDRAIL W/ WOOD & STEEL POSTS	01/03/00
G-1BM	BOX BEAM GUARDRAIL	06/13/97
G-1DM	STEEL BEAM GUARDRAIL ANCHORS & TERMINALS	01/03/00
G-4M	YIELDING MARKER POSTS	06/13/97
G-16M	STEEL BEAM GUARD RAIL ATTACHMENTS TO EXISTING BRIDGE	06/13/97
G-19 M	TERMINAL CONNECTOR FOR STEEL BEAM GUARDRAIL GENERIC GRADING PLANS FOR GUARDRAIL END TERM.	11/15/02
J-3M	MAILBOX SUPPORT DETAILS	06/13/97
SB-R6-82M	BRIDGE RAILING HEAVY DUTY STEEL BEAM	07/10/97


DATUM	_____
VERTICAL	_____
HORIZONTAL	_____

## INDEX OF SHEETS

PROJECT: FAYSTON - WAITSFIELD STP 2406(1)S & WAITSFIELD - MORETOWN STP 2227(1)S	
DESIGN FILE NAME: pave/00b058/00b058.dgn	PLOT DATE: 23-MAY-2008
IPARM FILE NAME: 00b058ind.l	SURVEY DATE:
SURVEYED BY:	DRAWN BY: LFW
SQUAD LEADER: LFW	SHEET: 2 OF 54





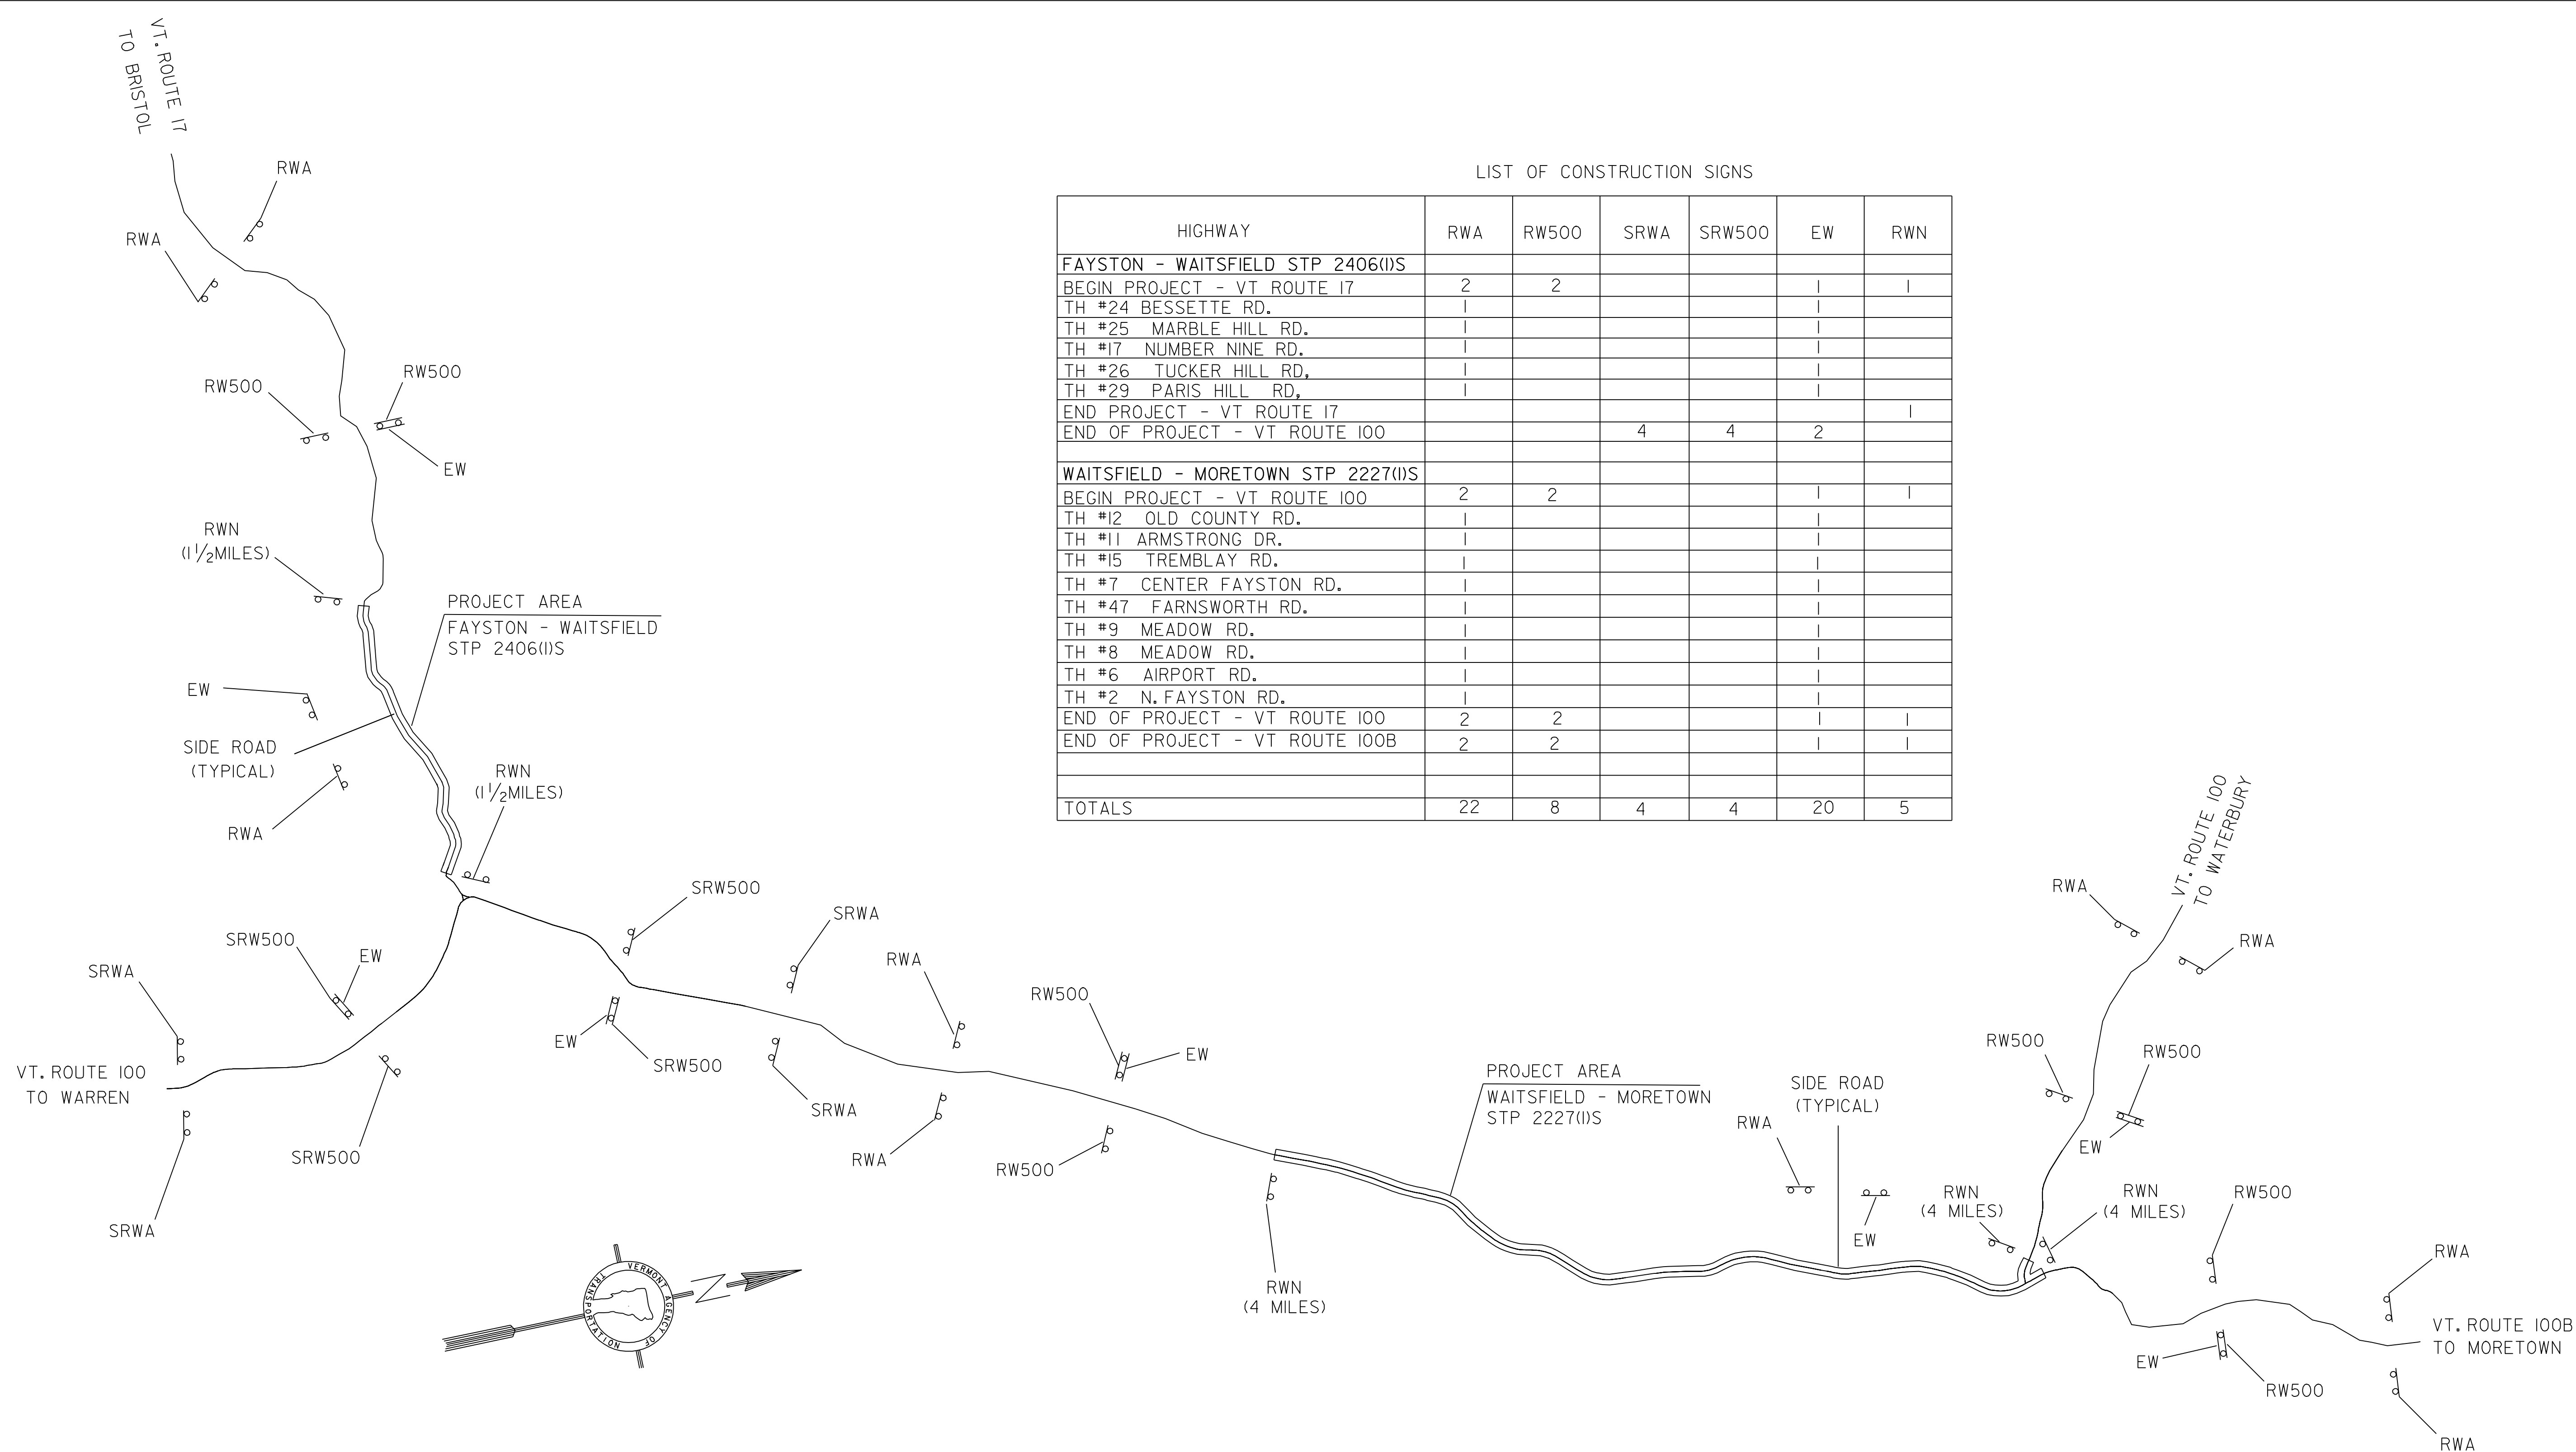

LIST OF CONSTRUCTION SIGNS

HIGHWAY	RWA	RW500	SRWA	SRW500	EW	RWN
<b>FAYSTON - WAITSFIELD STP 2406(1)S</b>						
BEGIN PROJECT - VT ROUTE 17	2	2				
TH #24 BESSETTE RD.						
TH #25 MARBLE HILL RD.						
TH #17 NUMBER NINE RD.						
TH #26 TUCKER HILL RD.						
TH #29 PARIS HILL RD.						
END PROJECT - VT ROUTE 17						
END OF PROJECT - VT ROUTE 100			4	4	2	
<b>WAITSFIELD - MORETOWN STP 2227(1)S</b>						
BEGIN PROJECT - VT ROUTE 100	2	2				
TH #12 OLD COUNTY RD.						
TH #11 ARMSTRONG DR.						
TH #15 TREMBLAY RD.						
TH #7 CENTER FAYSTON RD.						
TH #47 FARNSWORTH RD.						
TH #9 MEADOW RD.						
TH #8 MEADOW RD.						
TH #6 AIRPORT RD.						
TH #2 N. FAYSTON RD.						
END OF PROJECT - VT ROUTE 100	2	2				
END OF PROJECT - VT ROUTE 100B	2	2				
TOTALS	22	8	4	4	20	5

CONSTRUCTION APPROACH SIGNING


- LEGEND**
- RWA = ROAD WORK AHEAD
  - RW500 = ROAD WORK 500 FEET
  - EW = END WORK
  - RWN = ROAD WORK NEXT 4 MILES (VT 100 PROJECT)  
ROAD WORK NEXT 1/2 MILES (VT 17 PROJECT)
  - SRWA = SIDE ROAD WORK AHEAD
  - SRW500 = SIDE ROAD WORK 500 FEET

1. SEE STD. E-100 AND E-103 FOR SIGN PLACEMENT
2. ALL CONSTRUCTION SIGNING SHALL BE PAID UNDER ITEM 641.10, TRAFFIC CONTROL.
3. THE CONTRACTOR SHALL INCLUDE A CONSTRUCTION SIGN APPROACH PACKAGE FOR EXPECTED LANE CLOSURES AND WORKZONE SPEED REDUCTIONS IN COMPLIANCE WITH STANDARD E-103. PAYMENT FOR PROVIDING THIS PACKAGE SHALL BE INCIDENTAL TO ITEM 641.10, TRAFFIC CONTROL.
4. THE RESIDENT ENGINEER, AT HIS OR HER DISCRETION, MAY ELIMINATE CONSTRUCTION APPROACH SIGNING AT DEAD END LOCATIONS.

NOT TO SCALE

CONSTRUCTION APPROACH  
SIGNING DETAIL SHEET

DESIGNED BY	J. REDMOND	DATE	7/05
DRAWN BY	J. REDMOND	DATE	7/05
DESIGN FILE NO.	pave/00b058/00b058.dgn		
PRF FILE	00b058cas.i	DATE PLOTTED	23-MAY-2008 12
<b>FAYSTON - WAITSFIELD STP 2406(1)S AND WAITSFIELD - MORETOWN STP 2227(1)S</b>			
SHEET <b>5</b> OF <b>54</b> SHEETS			

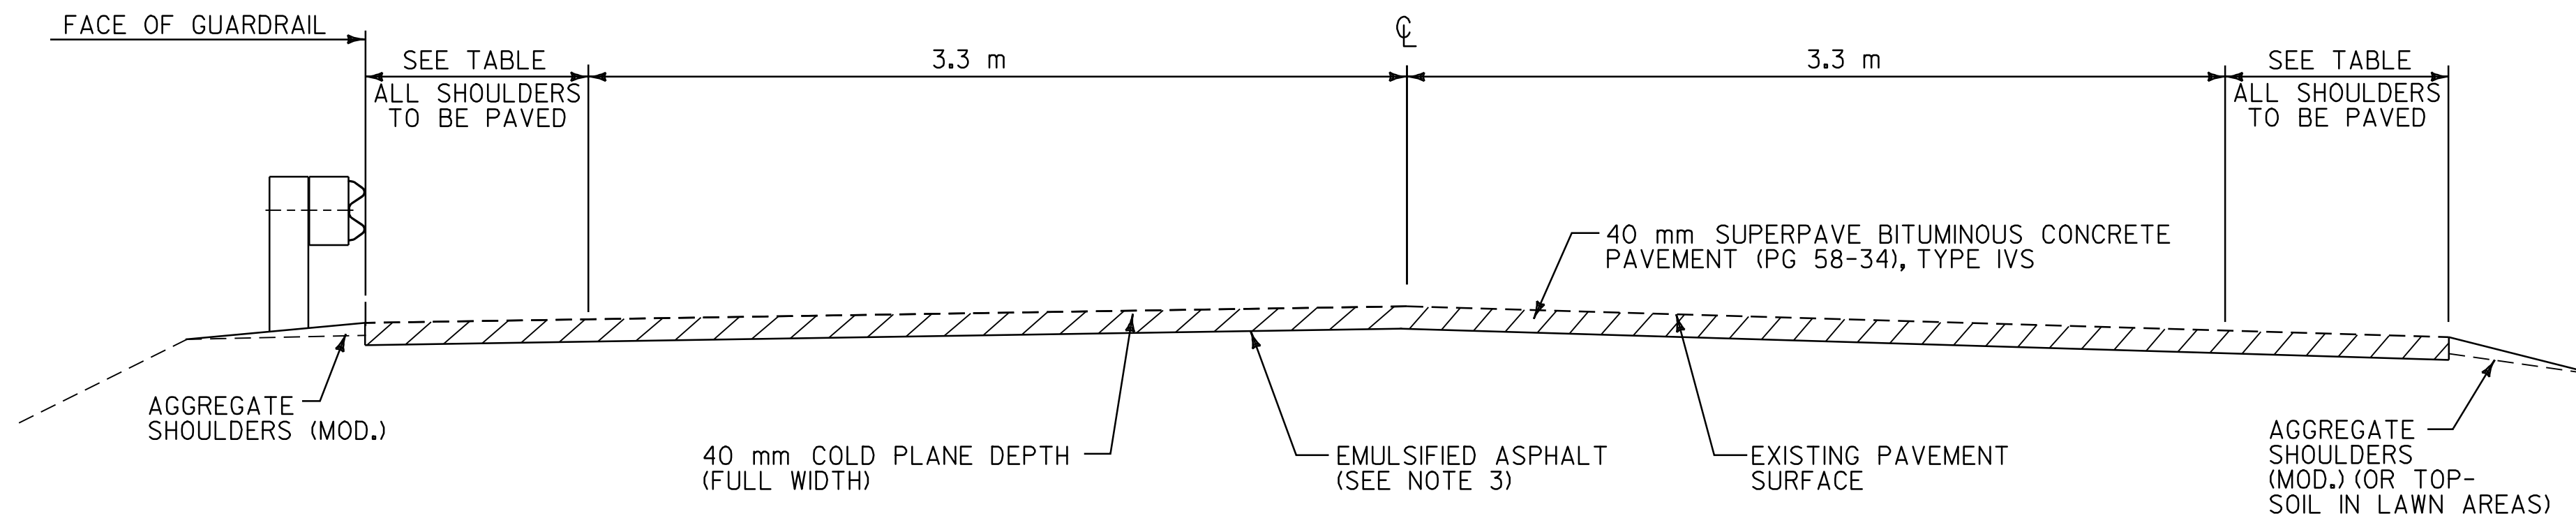

**COLD PLANE TYPICAL SECTION**

VT. ROUTE 17 FAYSTON STA. 7+229.00 TO STA. 7+756.00  
 VT. ROUTE 17 FAYSTON STA. 7+781.00 TO STA. 9+372.60  
 VT. ROUTE 17 WAITSFIELD STA. 0+000.00 TO STA. 0+091.73

**PROJECT PAVING LIMITS**

TOWN & ROUTE	BEGIN STATION	END STATION	LANE TYPICAL	WEARING DEPTH	NOTES
FAYSTON VT. ROUTE 17	7+229	7+300	0.7 m - 3.3 m - 3.3 m - 0.7 m	40 mm	COLD PLANE 40 mm & PAVE WITH 40 mm TYPE IVS
FAYSTON VT. ROUTE 17	7+300	7+400	VARIES - 3.3 m - 3.3 m - VARIES	40 mm	COLD PLANE 40 mm & PAVE WITH 40 mm TYPE IVS
FAYSTON VT. ROUTE 17	7+400	7+756	0.9 m - 3.3 m - 3.3 m - 0.9 m	40 mm	COLD PLANE 40 mm & PAVE WITH 40 mm TYPE IVS
FAYSTON VT. ROUTE 17	7+756	7+781			BR*36-DO NOT PAVE-SEE BR. APPR. DETAIL ON SHT. 7.
FAYSTON VT. ROUTE 17	7+781	8+056	0.9 m - 3.3 m - 3.3 m - 0.9 m	40 mm	COLD PLANE 40 mm & PAVE WITH 40 mm TYPE IVS
FAYSTON VT. ROUTE 17	8+056	8+072	VARIES - 3.3 m - 3.3 m - VARIES	40 mm	COLD PLANE 40 mm & PAVE WITH 40 mm TYPE IVS
FAYSTON VT. ROUTE 17	8+072	8+107	1.5 m - 3.3 m - 3.3 m - 1.5 m	30 mm	BR*37 MILL 30 mm & PAVE WITH 30 mm TYPE IVS SEE BR*37 TRANSITION DETAIL ON SHEET 7.
FAYSTON VT. ROUTE 17	8+107	8+150	VARIES - 3.3 m - 3.3 m - VARIES	40 mm	COLD PLANE 40 mm & PAVE WITH 40 mm TYPE IVS
FAYSTON VT. ROUTE 17	8+150	9+372.60	0.9 m - 3.3 m - 3.3 m - 0.9 m	40 mm	COLD PLANE 40 mm & PAVE WITH 40 mm TYPE IVS
WAITSFIELD VT. ROUTE 17	0+000.00	0+070	0.9 m - 3.3 m - 3.3 m - 0.9 m	40 mm	COLD PLANE 40 mm & PAVE WITH 40 mm TYPE IVS
WAITSFIELD VT. ROUTE 17	0+070.00	0+091.73	VARIES - 3.3 m - 3.3 m - VARIES	40 mm	COLD PLANE 40 mm & PAVE WITH 40 mm TYPE IVS

**NOTES**

1. THE WEARING COURSE SHALL BE TYPE IVS SUPERPAVE BITUMINOUS CONCRETE PAVEMENT. ALL ASPHALT CEMENT USED IN THE SUPERPAVE BITUMINOUS CONCRETE PAVEMENT SHALL BE PG 58-34.
2. EXISTING SHOULDER MATERIAL DEEMED UNSUITABLE BY THE RESIDENT ENGINEER SHALL BE EXCAVATED TO A DEPTH OF 75 mm OR AS DIRECTED BY THE RESIDENT ENGINEER. EXCAVATED MATERIAL SHALL BE SPREAD ON THE ADJACENT SLOPES OR REMOVED FROM THE PROJECT AS DIRECTED BY THE RESIDENT ENGINEER. EXCAVATION WILL BE PAID FOR AS ALL-PURPOSE EXCAVATION OR GRADER RENTAL. MATERIAL REMOVED SHALL BE REPLACED WITH SUBBASE OF CRUSHED GRAVEL (FINE GRADED) (MOD.).
3. EMULSIFIED ASPHALT SHALL BE APPLIED ON ALL EXISTING PAVEMENT SURFACES, ON ALL COLD PLANE SURFACES AND BETWEEN ALL COURSES OF PAVEMENT AT THE RATE OF 0.12 L/m<sup>2</sup> OR AS DIRECTED BY THE RESIDENT ENGINEER.
4. BITUMINOUS CONCRETE PAVEMENT TOLERANCE = ± 5 mm (TOTAL PAVEMENT THICKNESS EXCLUDING LEVELING).
5. ALL DRIVEWAYS, MAILBOX TURNOUTS AND GRAVEL PULLOUTS SHALL RECEIVE A PAVED APRON AS DIRECTED BY THE RESIDENT ENGINEER. ALL MAILBOX TURNOUTS SHALL HAVE THE EXISTING EDGE OF PAVEMENT BACKED-UP WITH COLD PLANE GRINDINGS PRIOR TO THE PLACEMENT OF THE PAVED APRON. ALL GRAVEL PULLOUTS SHALL HAVE 100 mm OF COLD PLANE GRINDINGS PLACED ON THE EXISTING SURFACE AND COMPACTED.
6. EARTH BORROW SHALL BE USED FOR THE CONSTRUCTION OF GUARDRAIL TERMINAL FLARES WHICH SHALL BE CAPPED WITH AN ESTIMATED 75 mm DEPTH OF AGGREGATE SHOULDERS (MOD.) UNLESS OTHERWISE DIRECTED BY THE RESIDENT ENGINEER. THE QUANTITIES INCLUDED REFLECT 20 m<sup>3</sup> OF EARTH BORROW AND 5 TONS OF AGGREGATE SHOULDERS (MOD.) FOR EACH GUARDRAIL TERMINAL.
7. THE PROPOSED BOX BEAM GUARDRAIL SHALL BE INSTALLED IN A LOCATION THAT MAXIMIZES THE DISTANCE FROM THE CENTER OF THE ROAD TO THE FACE OF GUARDRAIL. 1.0 m OF BACKING IS REQUIRED BEHIND THE FACE OF GUARDRAIL WITH 1.6 m POSTS. IF THIS CANNOT BE OBTAINED, THEN 2.1m POSTS SHALL BE USED FOR BOX BEAM RAIL.
8. ITEM 616.47 BITUMINOUS CONCRETE GUTTERS AND TRAFFIC ISLANDS SHALL ONLY BE PAID WHERE INDICATED IN THE PLANS. ALL PAVING, WHICH COULD INVOLVE SOME HAND-WORK (SUCH AS DRIVEWAYS, AROUND DROP INLETS, ETC.) SHALL BE PAID AS ITEM 490.30 SUPERPAVE BITUMINOUS CONCRETE PAVEMENT (PG 58-34).
9. THE CONTRACTOR SHALL COLD PLANE AND PAVE IN A MANNER THAT MAINTAINS THE EXISTING ROADWAY CROSS SECTION AND DOES NOT ALTER THE LOCATION OF THE CENTERLINE JOINT.

**CONSERVATION SEED MIX**

RURAL AREA - SEED MIXTURE				
% WT.	kg/ha.	NAME	PUR. %	GERM. %
37.14	26.0	CREEPING RED FESCUE	98	85
37.14	26.0	TALL FESCUE	95	90
5.71	4.0	RED TOP	95	90
14.30	10.0	BIRDSFOOT TREFLOIL	98	85
5.71	4.0	ANNUAL RYEGRASS	95	85
100.0	70.0			

SEED MIXTURE:  
 SHALL NOT HAVE A WEED CONTENT EXCEEDING 0.40% BY WEIGHT AND SHALL BE FREE OF ALL NOXIOUS WEED SEED.

SEED:  
 TO BE APPLIED PER SEEDING FORMULA DIRECTED BY THE RESIDENT ENGINEER

FERTILIZER:  
 FORMULA 10-20-10 TO BE USED WITH SEED, APPLIED AT THE RATE OF 560 kg/ha (HYDRO SEEDERS MAY USE 19-19-19 FORMULA)

AGRICULTURAL LIMESTONE:  
 TO BE APPLIED AT THE RATE OF 4500 kg/ha OR AS DIRECTED BY THE RESIDENT ENGINEER.


HAY MULCH:  
 TO BE APPLIED ON EARTH SLOPES AT THE RATE OF 4500 kg/ha, OR AS DIRECTED BY THE RESIDENT ENGINEER.

TOPSOIL:  
 TO BE USED WITH SEED AS INDICATED ON THE PLANS, OR AS DIRECTED BY THE RESIDENT ENGINEER.

<b>PROJECT TYPICAL SHEET</b>	SURVEYED BY <u>J. REDMOND</u> DATE <u>7/05</u>
	DRAWN BY <u>J. REDMOND</u> DATE <u>7/05</u>
	SQUAD LEADER <u>J. REDMOND</u>
	DESIGN FILE NO. <u>pave/00b058/00b058.dgn</u>
	IPARM FILE <u>00b058+tyl.i</u> DATE <u>23-MAY-2008</u> 12:54
	PROJ. NAME <u>FAYSTON - WAITSFIELD</u>
	PROJ. NO. <u>STP 2406(1)S</u>
	SHEET <u>6</u> OF <u>54</u>


**NOT TO SCALE**



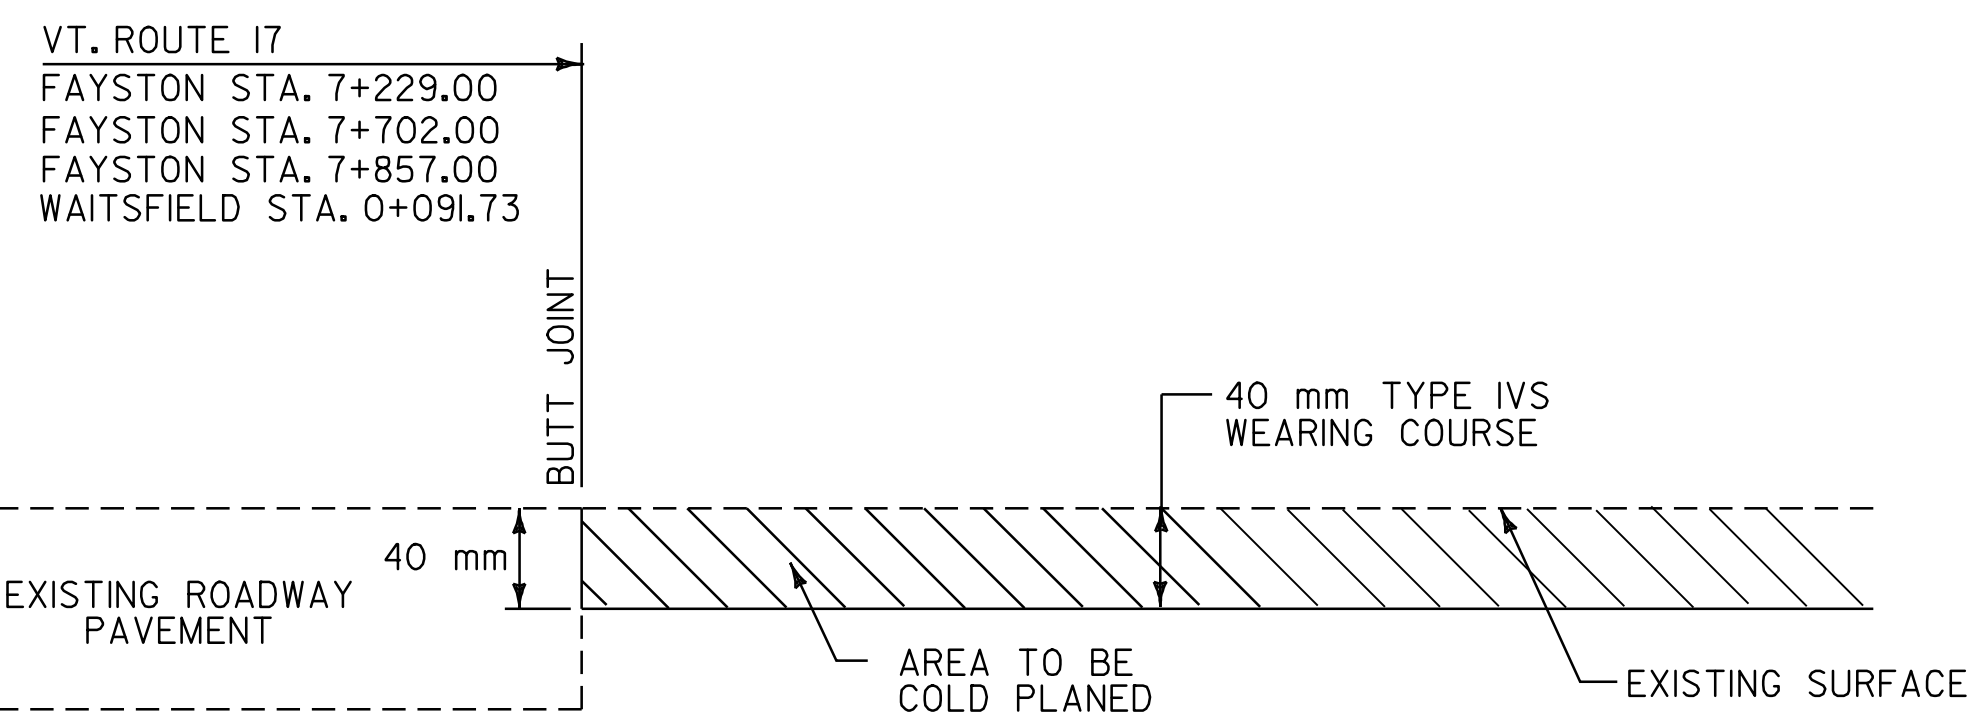

**APPROACH AREA DETAIL**


VT. ROUTE 17 FAYSTON STA. 7+229.0 (BEGIN PROJECT)  
 VT. ROUTE 17 WAITSFIELD STA. 0+091.73 (END PROJECT)

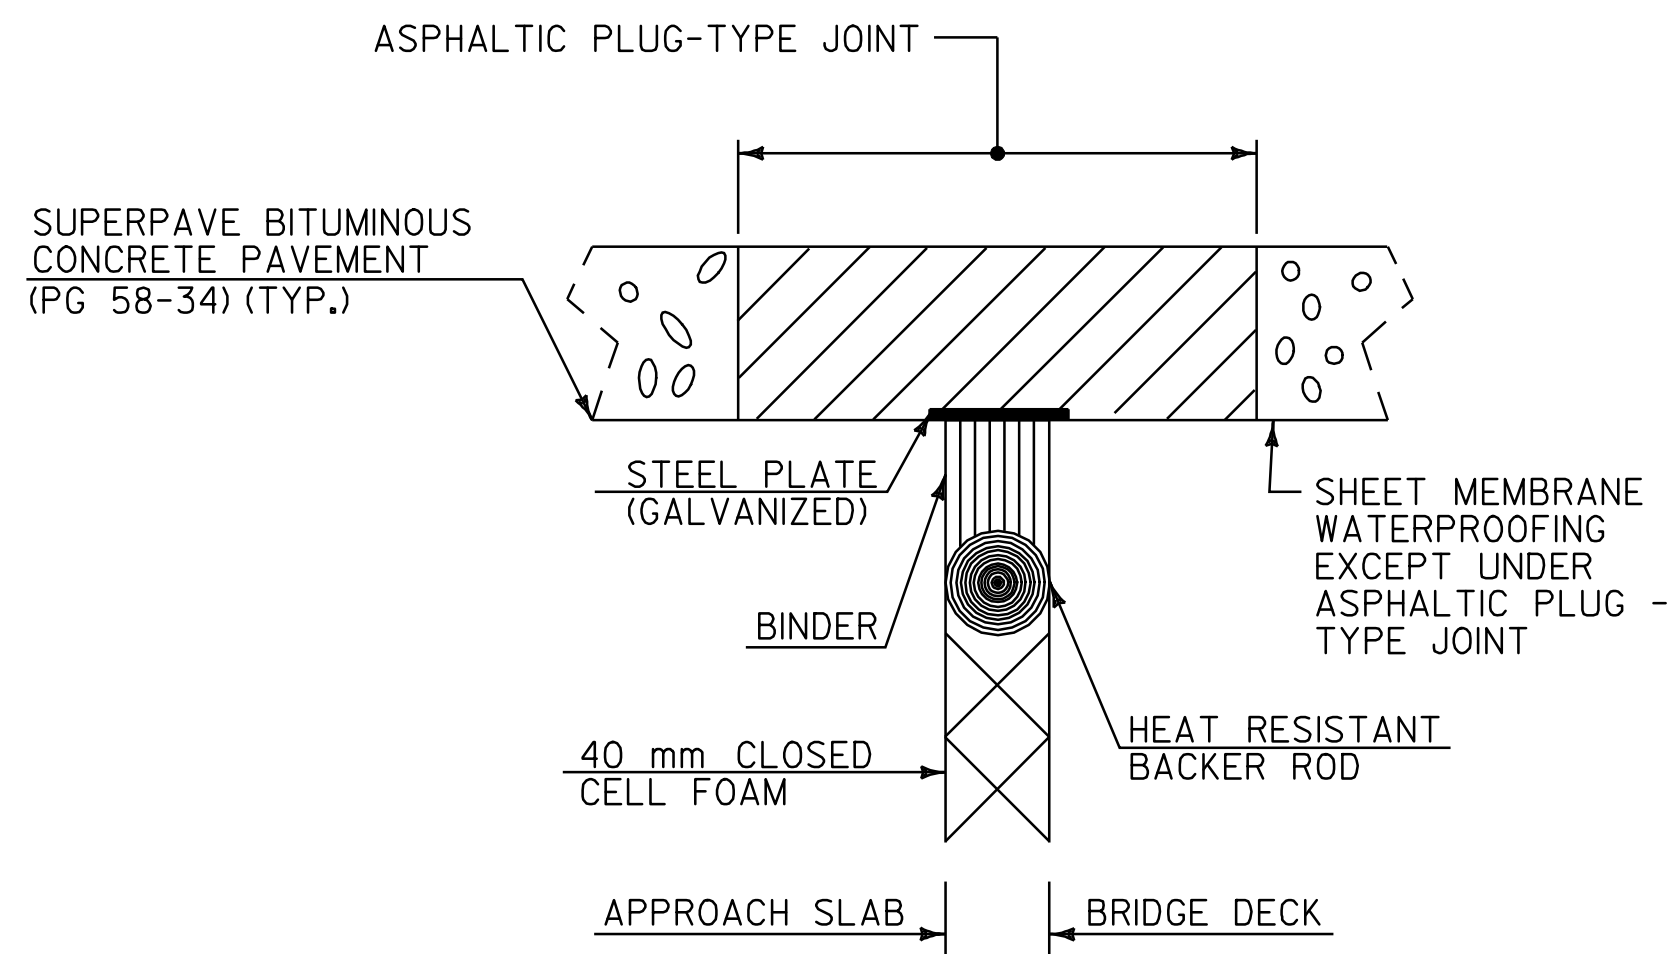

**ASPHALTIC PLUG-TYPE JOINT DETAIL**


VT. ROUTE 17 FAYSTON - BRIDGE 37 - STA. 8+080 (17.6 m)  
 VT. ROUTE 17 FAYSTON - BRIDGE 37 - STA. 8+099 (17.6 m)

NOTE: THE STEEL PLATE IN THE ASPHALTIC PLUG JOINT MAY BE OMITTED ONLY IF THE SURFACE IS SO IRREGULAR IT WILL CAUSE VERTICAL MOVEMENT AND IS DIRECTED BY THE RESIDENT ENGINEER.

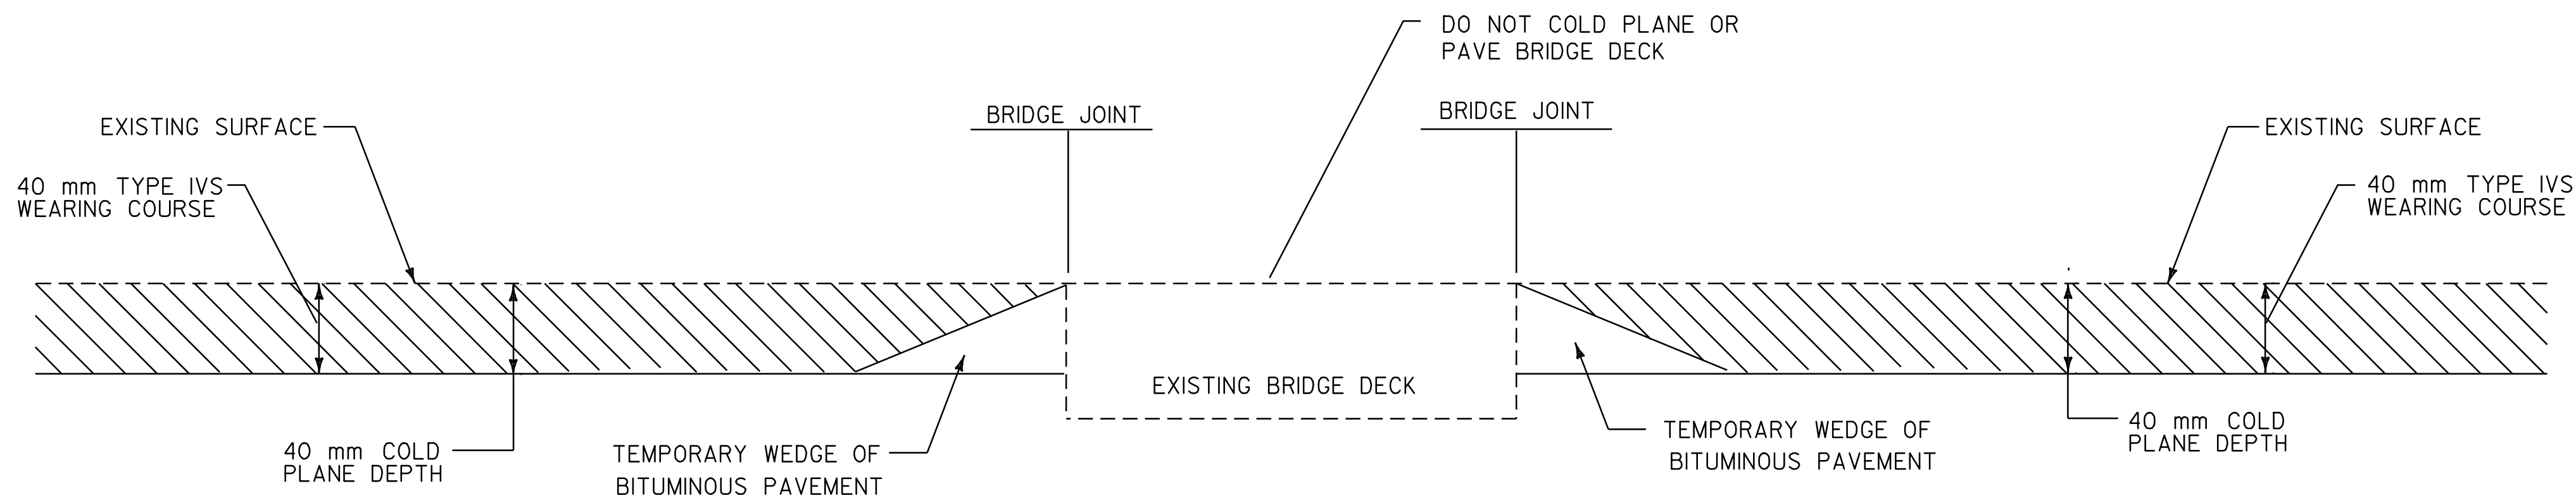

**BRIDGE APPROACH DETAIL**

BR 36 VT. ROUTE 17 FAYSTON STA. 7+756 TO STA. 7+781

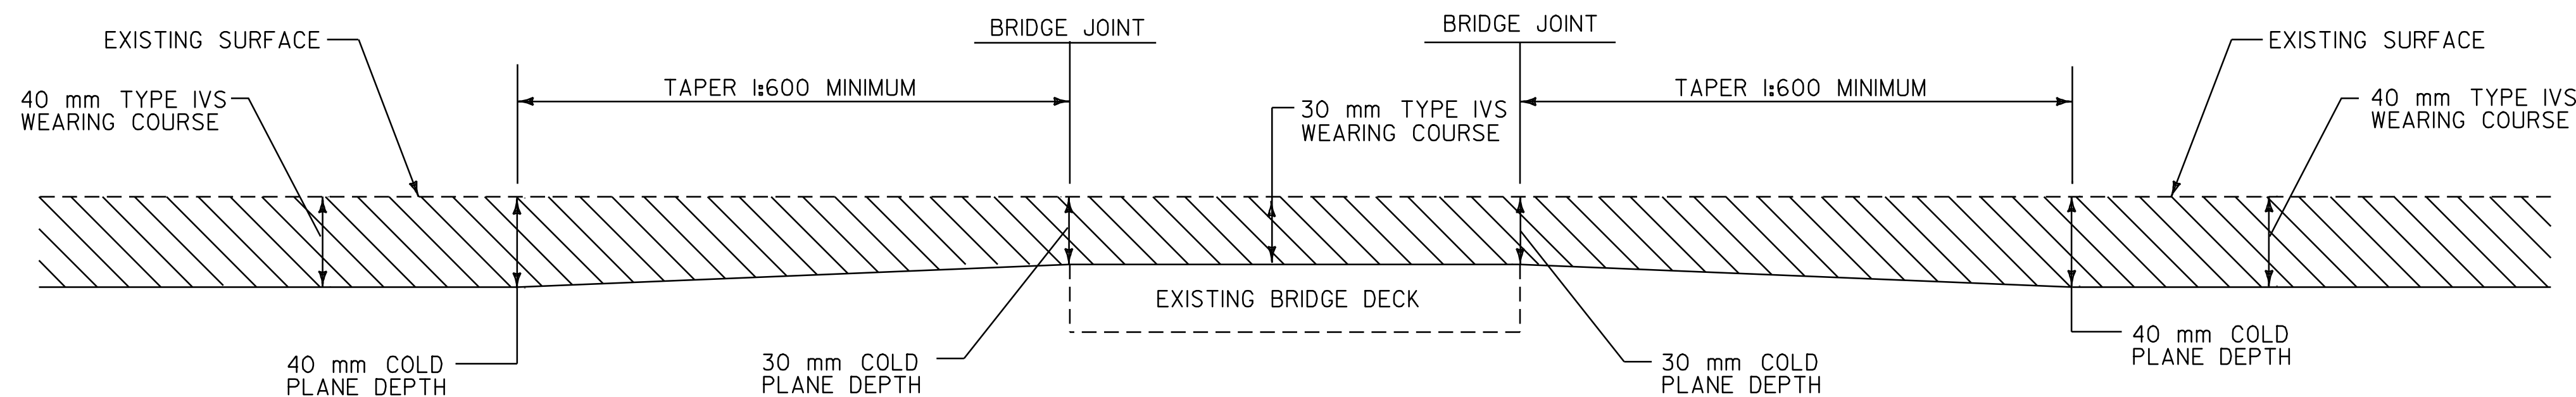

**BRIDGE TRANSITION AREA DETAIL**

BR 37 VT. ROUTE 17 FAYSTON STA. 8+080 TO STA. 8+099

NOTE: THE CONTRACTOR MUST USE CARE WHEN COLD PLANING BRIDGE 37 AS NOT TO DAMAGE THE BRIDGE MEMBRANE. IF DAMAGE TO THIS MEMBRANE SHOULD OCCUR DURING THE COLD PLANING, THE CONTRACTOR SHALL REPLACE THE MEMBRANE AT NO COST TO THE STATE.

THE CONTRACTOR SHALL TAKE PRECAUTIONS TO AVOID THE ACCUMULATION OF DEBRIS IN THE DRAINAGE STRUCTURES LOCATED AT CURB LINE AND IN THE EXPANSION JOINTS. THE CONTRACTOR SHALL EXAMINE THESE BRIDGE FEATURES ON A REGULAR BASIS TO ENSURE THAT DEBRIS HAS NOT ACCUMULATED. ANY DEBRIS WHICH IS PRESENT SHALL BE REMOVED BY THE CONTRACTOR AT NO COST TO THE STATE.

**NOT TO SCALE**

<b>PAVING DETAILS AND PAVEMENT JOINT DETAIL SHEET</b>	SURVEYED BY <u>J. REDMOND</u> DATE <u>7/05</u>
	DRAWN BY <u>J. REDMOND</u> DATE <u>7/05</u>
	SQUAD LEADER <u>J. REDMOND</u>
	DESIGN FILE NO. <u>pave/00b058/00b058.dgn</u>
	IPARM <u>00b058+y2.1</u> DATE <u>23-MAY-2008</u> 12:54
	FILE <u>00b058+y2.1</u> PLOTTED <u>23-MAY-2008</u> 12:54
	PROJ. NAME <u>FAYSTON - WAITSFIELD</u>
PROJ. NO. <u>STP 2406(1)S</u>	
SHEET <u>7</u> OF <u>54</u>	





# ITEM DETAIL SUMMARY SHEET



LOCATION			GUARDRAIL											REMARKS
STATION	STATION	POS.	604.412	621.20	601.0010	601.6010	601.0015	621.30	621.505	621.53	621.60	621.80	676.10	
			REHAB DROP INLET EA	STEEL BEAM GUARD RAIL (GALV.) m	375mm CSP	375mm CSPEs	450mm CSP	BOX BEAM G. R. (GALV.) (2.1m POSTS) m	MANUF. TERM. SECTION (FLARED) EA	TERMINAL CONNECTOR FOR S. B. G. R. EA	ANCHOR FOR STEEL BEAM GUARD RAIL EA	REMOVE & DISP. G. R. m	DELINEATORS W/STEEL POSTS EA	
FAYSTON:														
7+229.0	7+293.6	LT		69.2 <del>64.6</del>							1	<del>65</del> 68.44	1	ATTACH TO EXISTING RAIL AT 7+229 LT
7+231		RT	1		8.1	2								REHAB EXISTING DROP INLET (THROATED) ADDED 2 SECTIONS OF 375mm PIPE W/ CSPEs 4.6M + 3.5M
7+506		RT	+											REHAB EXISTING DROP INLET NOT CHANGED
8+700		RT												EXTEND INLET EXISTING 600mm CSP W/ 2.0m CSP PAID FOR WITH 4m OF 450MM CSP
7+996		LT	+											REHAB EXISTING DROP INLET (THROATED) NOT CHANGED
8+045.3	8+072.0	RT		7.6 27.3 <del>7.6</del>					1	1		26.7 <del>27</del>	1	ATTACH TO CONCRETE BRIDGE RAIL AT 8+072.0 RT; REFER TO SHEET 23 FOR MANUFACTURED TERMINAL SECTION DETAILS. (SEE PAGE 21 OF 54)
8+062.3	8+089.0	LT		8.23 <del>7.6</del>					+	0	1	19.1 <del>27</del>	1	ATTACH TO CONCRETE BRIDGE RAIL AT 8+089.0 LT; REFER TO SHEET 23 FOR MANUFACTURED TERMINAL SECTION DETAILS. (SEE PAGE 21 OF 54)
8+090.0	8+105.2	RT		7.6 <del>7.6</del>						1	1	15.2 <del>15</del>	1	ATTACH TO CONCRETE BRIDGE RAIL AT 8+090.0 RT; REFER TO SHEET 23 FOR MANUFACTURED TERMINAL SECTION DETAILS. (SEE PAGE 21 OF 54)
8+107.0	8+441.5	LT		322.33 <del>315.4</del>					1	1		334.5 <del>335</del>	1	ATTACH TO CONCRETE BRIDGE RAIL AT 8+107.0 LT; REFER TO SHT. 23 FOR MANUF. TERM. SECTION DETAILS; TIGHTEN POST SPACING AT 8+199 LT
8+905	9+021.0	LT						114.3 65.8					2 +	TYPE 11 END ASSEMBLY AT EACH END; REFER TO STANDARD G-1BM FOR DETAILS. 9/15/06
9+032.0	9+178.0	LT						146.3					2 +	TYPE 11 END ASSEMBLY AT EACH END; REFER TO STANDARD G-1BM FOR DETAILS. 9/15/06
WAITSFIELD:														
0+053.7	0+091.73	LT		32.19 <del>38.0</del>								35.05 <del>38</del>	1	(SEE PAGE 22 OF 54) ATTACH TO EXISTING BRIDGE RAIL AT 0+091.73 LT
SHEET SUBTOTAL			1 <del>3</del>	466.85 <del>440.8</del>	8.1	2	4	260.6 <del>212.1</del>	2 <del>3</del>	4	4 <del>3</del>	499 <del>507</del>	10 <del>8</del>	
ROUNDING			-	9.2				7.9	-	-	-	13	-	
TOTAL			3	450.0				220.0	3	4	3	520	8	

DATUM  
VERTICAL N/A  
HORIZONTAL N/A

**ITEM  
DETAIL  
SUMMARY  
SHEET**

SURVEYED BY J. REDMOND DATE 7/05  
 DRAWN BY J. REDMOND DATE 7/05  
 SQUAD LEADER J. REDMOND  
 DESIGN FILE NO. pave/00b058/00b058.dgn  
 IPARM FILE 00b058tdsl.t DATE PLOTTED 23-MAY-2008 12:54  
 PROJ. NAME FAYSTON - WAITSFIELD  
 PROJ. NO. STP 2406(IIS)  
 SHEET 10 OF 54



REMOVING SIGNS  
5 AS SHOWN

646.40 DURABLE 100 mm WHITE LINE (THERMOPLASTIC)  
(ALL LINES WILL INCLUDE EDGE LINE BREAKS AND RADIUS FOR TOWN HIGHWAYS)

FAYSTON:  
STA. 7+229 - STA. 7+600 LT & RT

646.60 TEMPORARY 100 mm WHITE LINE (PAINT)  
(ALL LINES WILL INCLUDE EDGE LINE BREAKS AND RADIUS FOR TOWN HIGHWAYS)

FAYSTON:  
STA. 7+229 - STA. 7+600 LT & RT

646.41 DURABLE 100 mm YELLOW LINE (THERMOPLASTIC)  
(ALL LINES WILL INCLUDE C/L BREAKS FOR TOWN HIGHWAYS) S=SOLID, D=DASHED

FAYSTON:  
STA. 7+229 - STA. 7+600  
STA. 7+458 DOUBLE SOLID RT, T-24  
STA. 7+519 DOUBLE SOLID RT, T-25

646.61 TEMPORARY 100 mm YELLOW LINE (PAINT)  
(ALL LINES WILL INCLUDE C/L BREAKS FOR TOWN HIGHWAYS) S=SOLID, D=DASHED

FAYSTON:  
STA. 7+229 - STA. 7+600  
STA. 7+458 DOUBLE SOLID RT, T-24  
STA. 7+519 DOUBLE SOLID RT, T-25

646.46 DURABLE 600 mm STOP BAR (THERMOPLASTIC)

FAYSTON:  
STA. 7+458 RT, T-24  
STA. 7+519 RT, T-25

646.66 TEMPORARY 600 mm STOP BAR (PAINT)

FAYSTON:  
STA. 7+458 RT, T-24  
STA. 7+519 RT, T-25

646.50 DURABLE LETTER OR SYMBOL (THERMOPLASTIC)

FAYSTON:  
STA. 7+458 RT, T-24, "S,T,O,P" (4 EA)  
STA. 7+519 RT, T-25, "S,T,O,P" (4 EA)

646.70 TEMPORARY LETTER OR SYMBOL (PAINT)

FAYSTON:  
STA. 7+458 RT, T-24, "S,T,O,P" (4 EA)  
STA. 7+519 RT, T-25, "S,T,O,P" (4 EA)

604.412 REHABILITATION OF DI, CB OR MH


FAYSTON:  
STA. 7+231RT (THROATED)  
STA. 7+506 RT **NOT CHANGED**

619.17 YIELDING MARKER POSTS

FAYSTON:  
STA. 7+231RT & LT (2)  
STA. 7+438 RT & LT (2)  
STA. 7+463 RT (1)  
STA. 7+466 LT (1)  
STA. 7+506 RT & LT (2)  
STA. 7+530 RT & LT (2)

DITCHING LOCATION

FAYSTON:  
STA. 7+231 - 7+250 RT 7+235 - 7+251 LT  
STA. 7+466 - 7+506 RT  
**463**

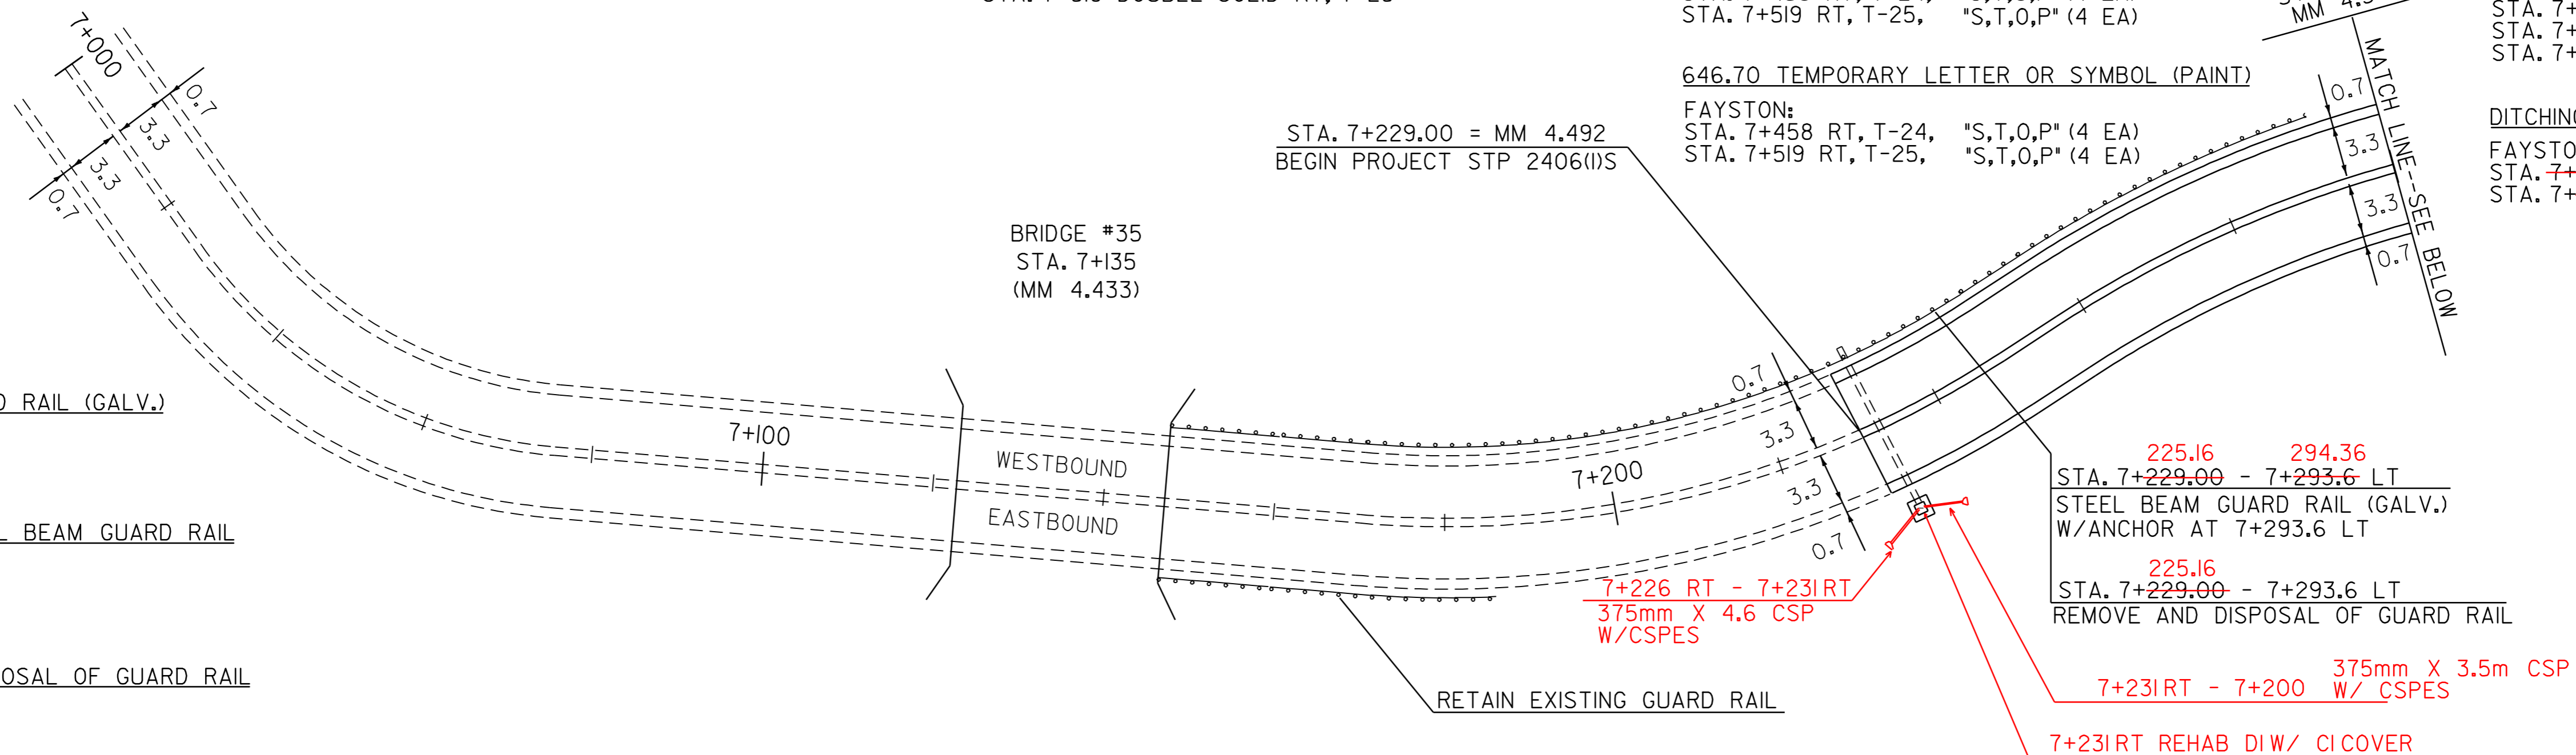

621.20 STEEL BEAM GUARD RAIL (GALV.)


FAYSTON:  
STA. 7+229 - 7+293.6 LT

621.60 ANCHOR FOR STEEL BEAM GUARD RAIL

FAYSTON:  
STA. 7+293.6 LT

621.80 REMOVAL AND DISPOSAL OF GUARD RAIL

FAYSTON:  
STA. 7+229 - 7+293.6 LT

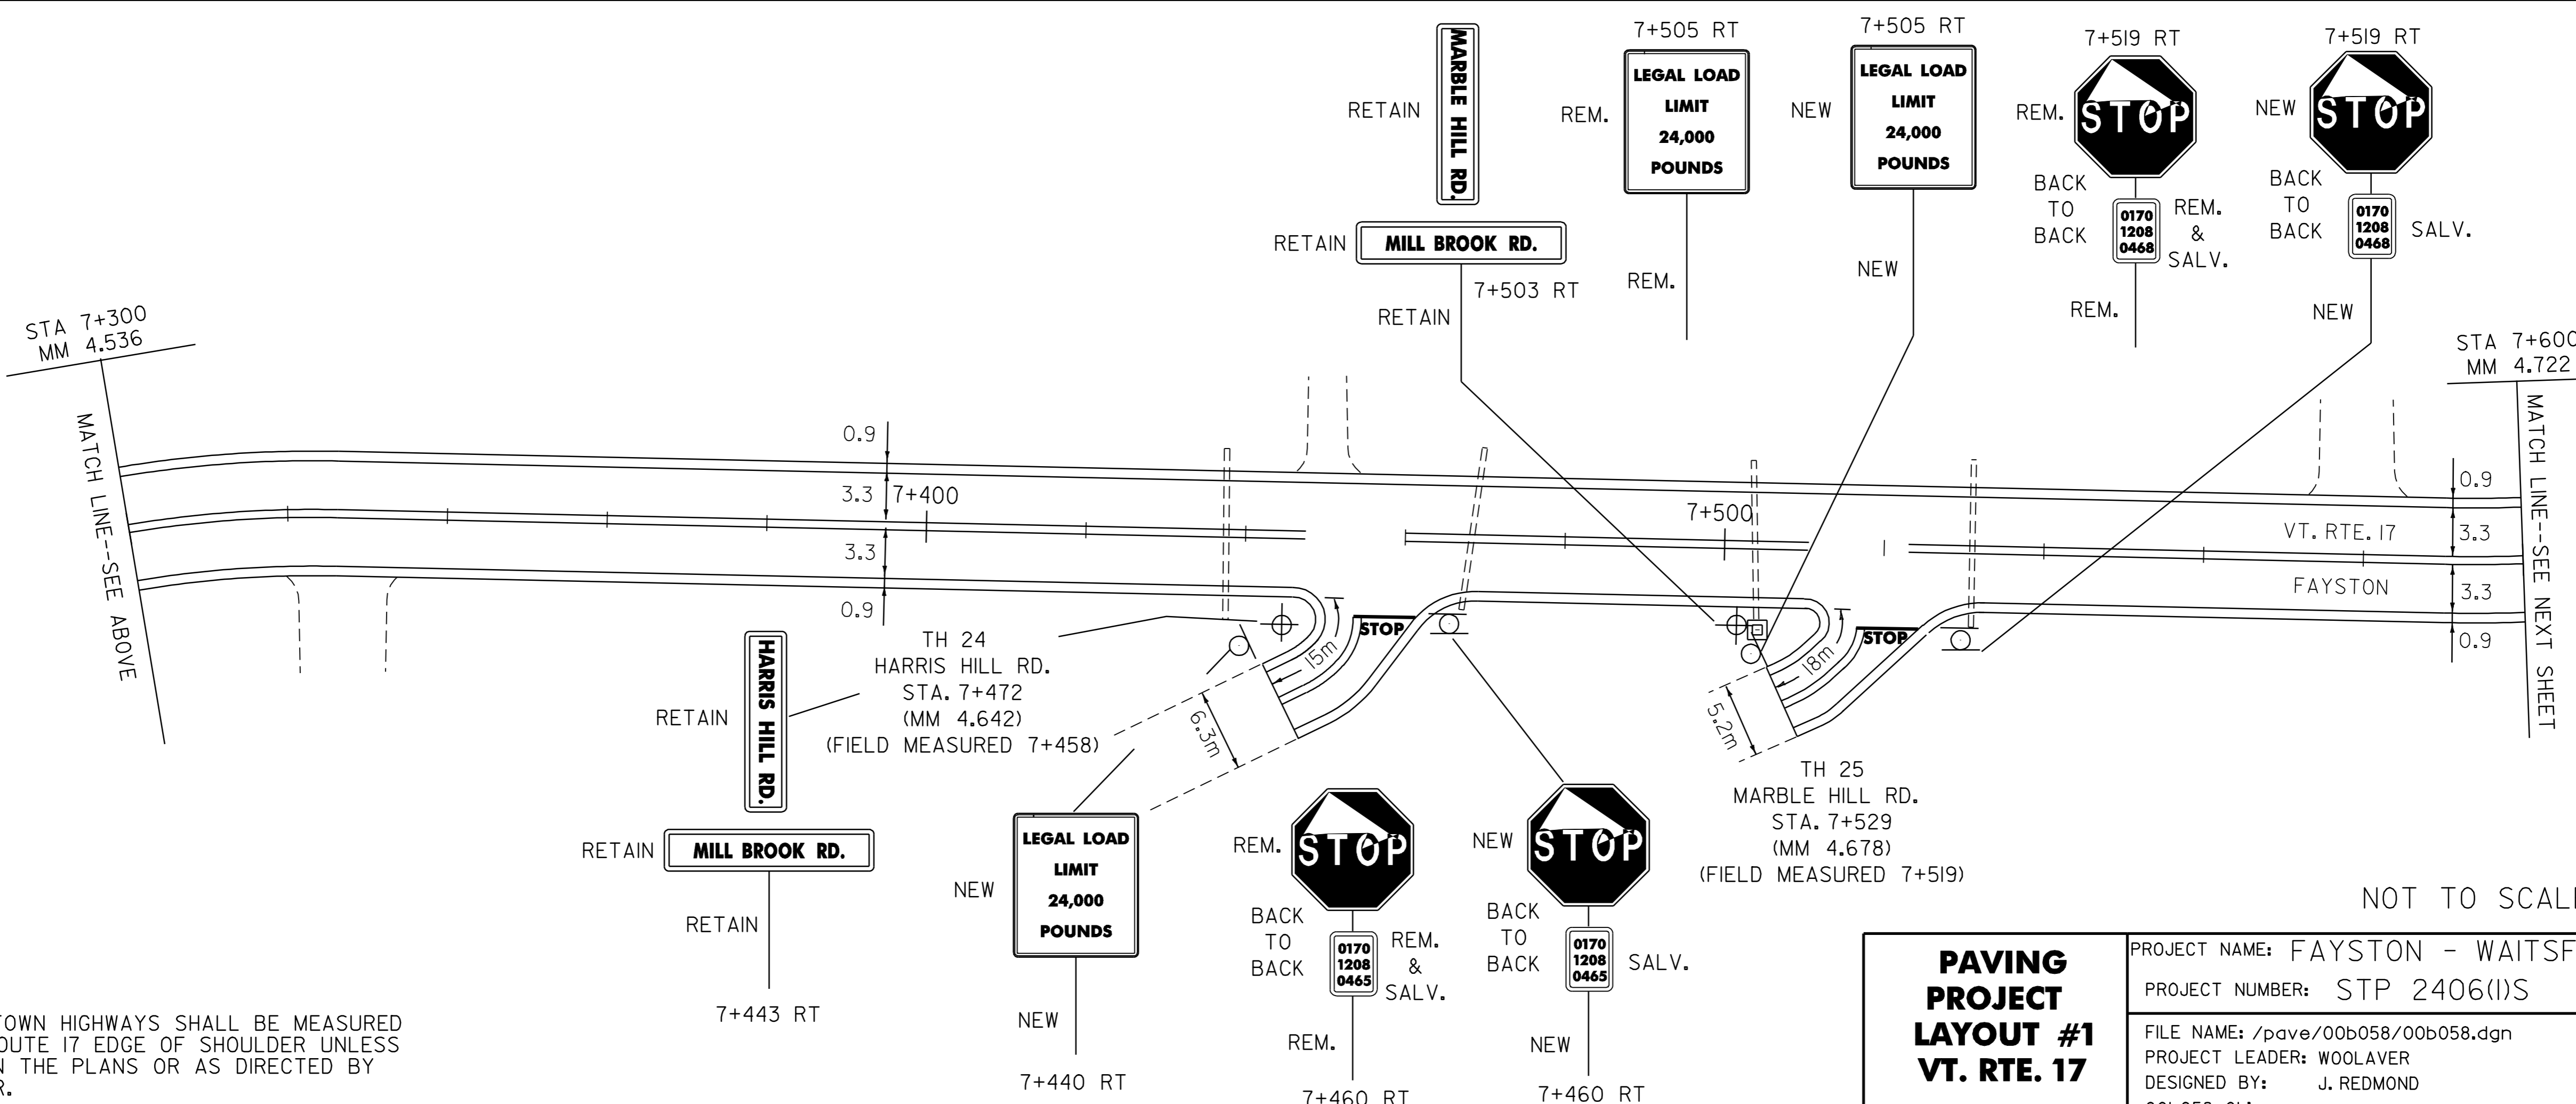

NOT TO SCALE

**PAVING  
PROJECT  
LAYOUT #1  
VT. RTE. 17**

PROJECT NAME: FAYSTON - WAITSFIELD  
PROJECT NUMBER: STP 2406(I)S

FILE NAME: /pave/00b058/00b058.dgn  
PROJECT LEADER: WOOLLAVER  
DESIGNED BY: J. REDMOND  
00b058p01.I

PLOT DATE: 23-MAY-2008 12:30  
DRAWN BY: J. REDMOND  
CHECKED BY: J. REDMOND  
SHEET 12 OF 54

NOTE:

1. PAVING LIMIT ON ALL TOWN HIGHWAYS SHALL BE MEASURED 8 m BACK FROM VT. ROUTE 17 EDGE OF SHOULDER UNLESS DENOTED OTHERWISE ON THE PLANS OR AS DIRECTED BY THE RESIDENT ENGINEER.

646.40 DURABLE 100 mm WHITE LINE (THERMOPLASTIC)  
 (ALL LINES WILL INCLUDE EDGE LINE BREAKS AND RADIUS FOR TOWN HIGHWAYS)  
 FAYSTON:  
 STA. 7+600 - STA. 8+200 LT & RT

646.41 DURABLE 100 mm YELLOW LINE (THERMOPLASTIC)  
 (ALL LINES WILL INCLUDE C/L BREAKS FOR TOWN HIGHWAYS) S=SOLID, D=DASHED  
 FAYSTON:  
 STA. 7+600 - STA. 8+200 LT S CL RT S  
 STA. 8+076 DOUBLE SOLID LT, T-17


646.46 DURABLE 600 mm STOP BAR (THERMOPLASTIC)  
 FAYSTON:  
 STA. 8+076 LT, T-17  
 646.66 TEMPORARY 600 mm STOP BAR (PAINT)  
 FAYSTON:  
 STA. 8+076 LT, T-17

646.50 DURABLE LETTER OR SYMBOL (THERMOPLASTIC)  
 FAYSTON:  
 STA. 8+076 LT, T-17, "S,T,O,P" (4 EA)  
 646.70 TEMPORARY LETTER OR SYMBOL (PAINT)  
 FAYSTON:  
 STA. 8+076 LT, T-17, "S,T,O,P" (4 EA)

646.60 TEMPORARY 100 mm WHITE LINE (PAINT)  
 (ALL LINES WILL INCLUDE EDGE LINE BREAKS AND RADIUS FOR TOWN HIGHWAYS)  
 FAYSTON:  
 STA. 7+600 - STA. 8+200 LT & RT

646.61 TEMPORARY 100 mm YELLOW LINE (PAINT)  
 (ALL LINES WILL INCLUDE C/L BREAKS FOR TOWN HIGHWAYS) S=SOLID, D=DASHED  
 FAYSTON:  
 STA. 7+600 - STA. 8+200 LT S CL RT S  
 STA. 8+076 DOUBLE SOLID LT, T-17

REMOVING SIGNS  
 3 AS SHOWN

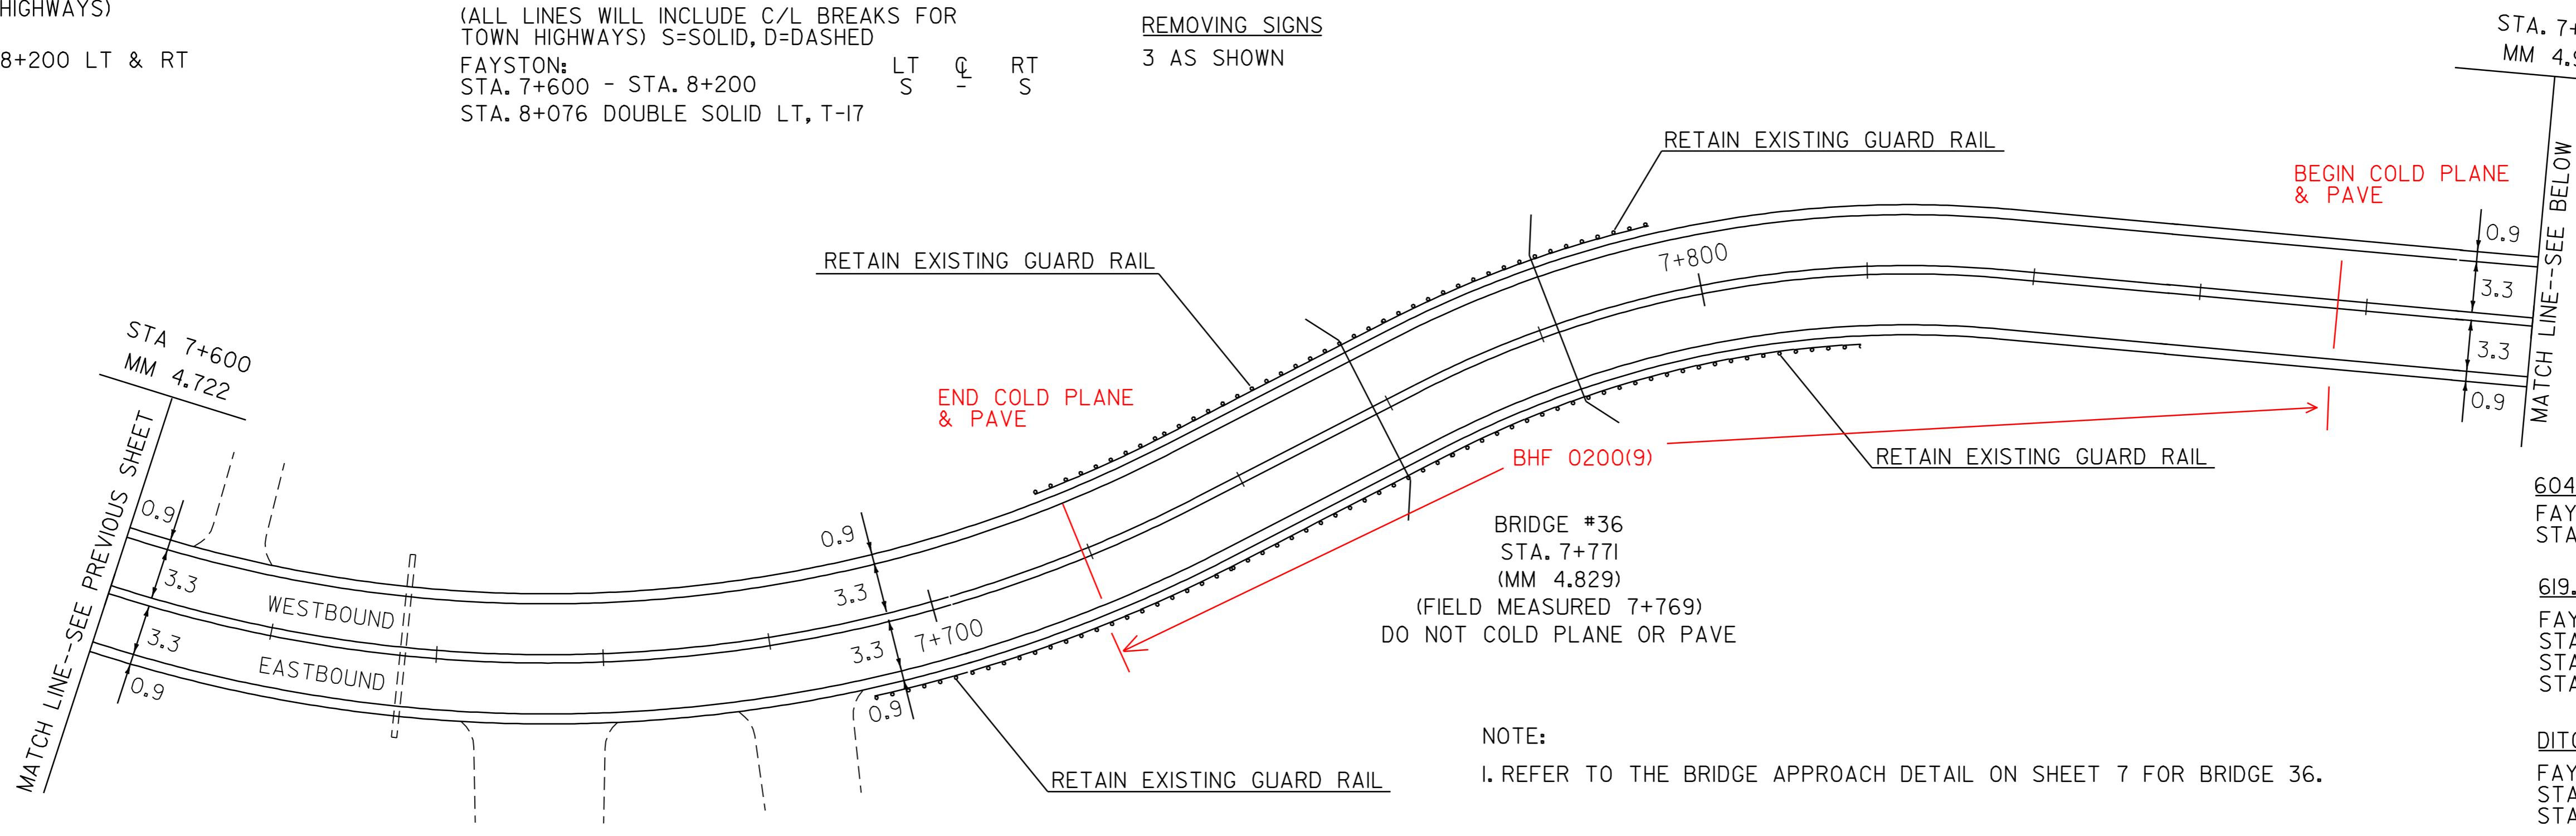


STA. 7+900  
 MM 4.909  
 MATCH LINE--SEE BELOW  
 604.412 REHABILITATION OF DI, CB OR MH  
 FAYSTON:  
 STA. 7+996 LT  
 619.17 YIELDING MARKER POSTS  
 FAYSTON:  
 STA. 7+636 RT & LT (2)  
 STA. 7+996 RT & LT (2)  
 STA. 8+165 RT & LT (2)  
 DITCHING LOCATION  
 FAYSTON:  
 STA. 7+849 - 7+930 LT  
 STA. 7+947 - 8+046 LT

NOTE:  
 I. REFER TO THE BRIDGE APPROACH DETAIL ON SHEET 7 FOR BRIDGE 36.

NOTES:

- PAVING LIMIT ON ALL TOWN HIGHWAYS SHALL BE MEASURED 8 m BACK FROM VT. ROUTE 17 EDGE OF SHOULDER UNLESS DENOTED OTHERWISE ON THE PLANS OR AS DIRECTED BY THE RESIDENT ENGINEER.
- BRIDGE 37 HAS THREE DRAINAGE STRUCTURES AT CURB LINE ON EACH SIDE. NO ADJUSTMENT IN HEIGHT WILL BE NECESSARY. REFER TO THE NOTES AND COLD PLANE DETAIL ON SHEET 7 FOR BRIDGE 37.
- REFER TO SHEET 23 FOR DETAILS OF THE TERMINAL CONNECTOR FOR STEEL BEAM GUARD RAIL.
- REFER TO SHEET 24 FOR DETAILS OF GUARD RAIL POST SPACING AT NON-YIELDING OBJECTS.

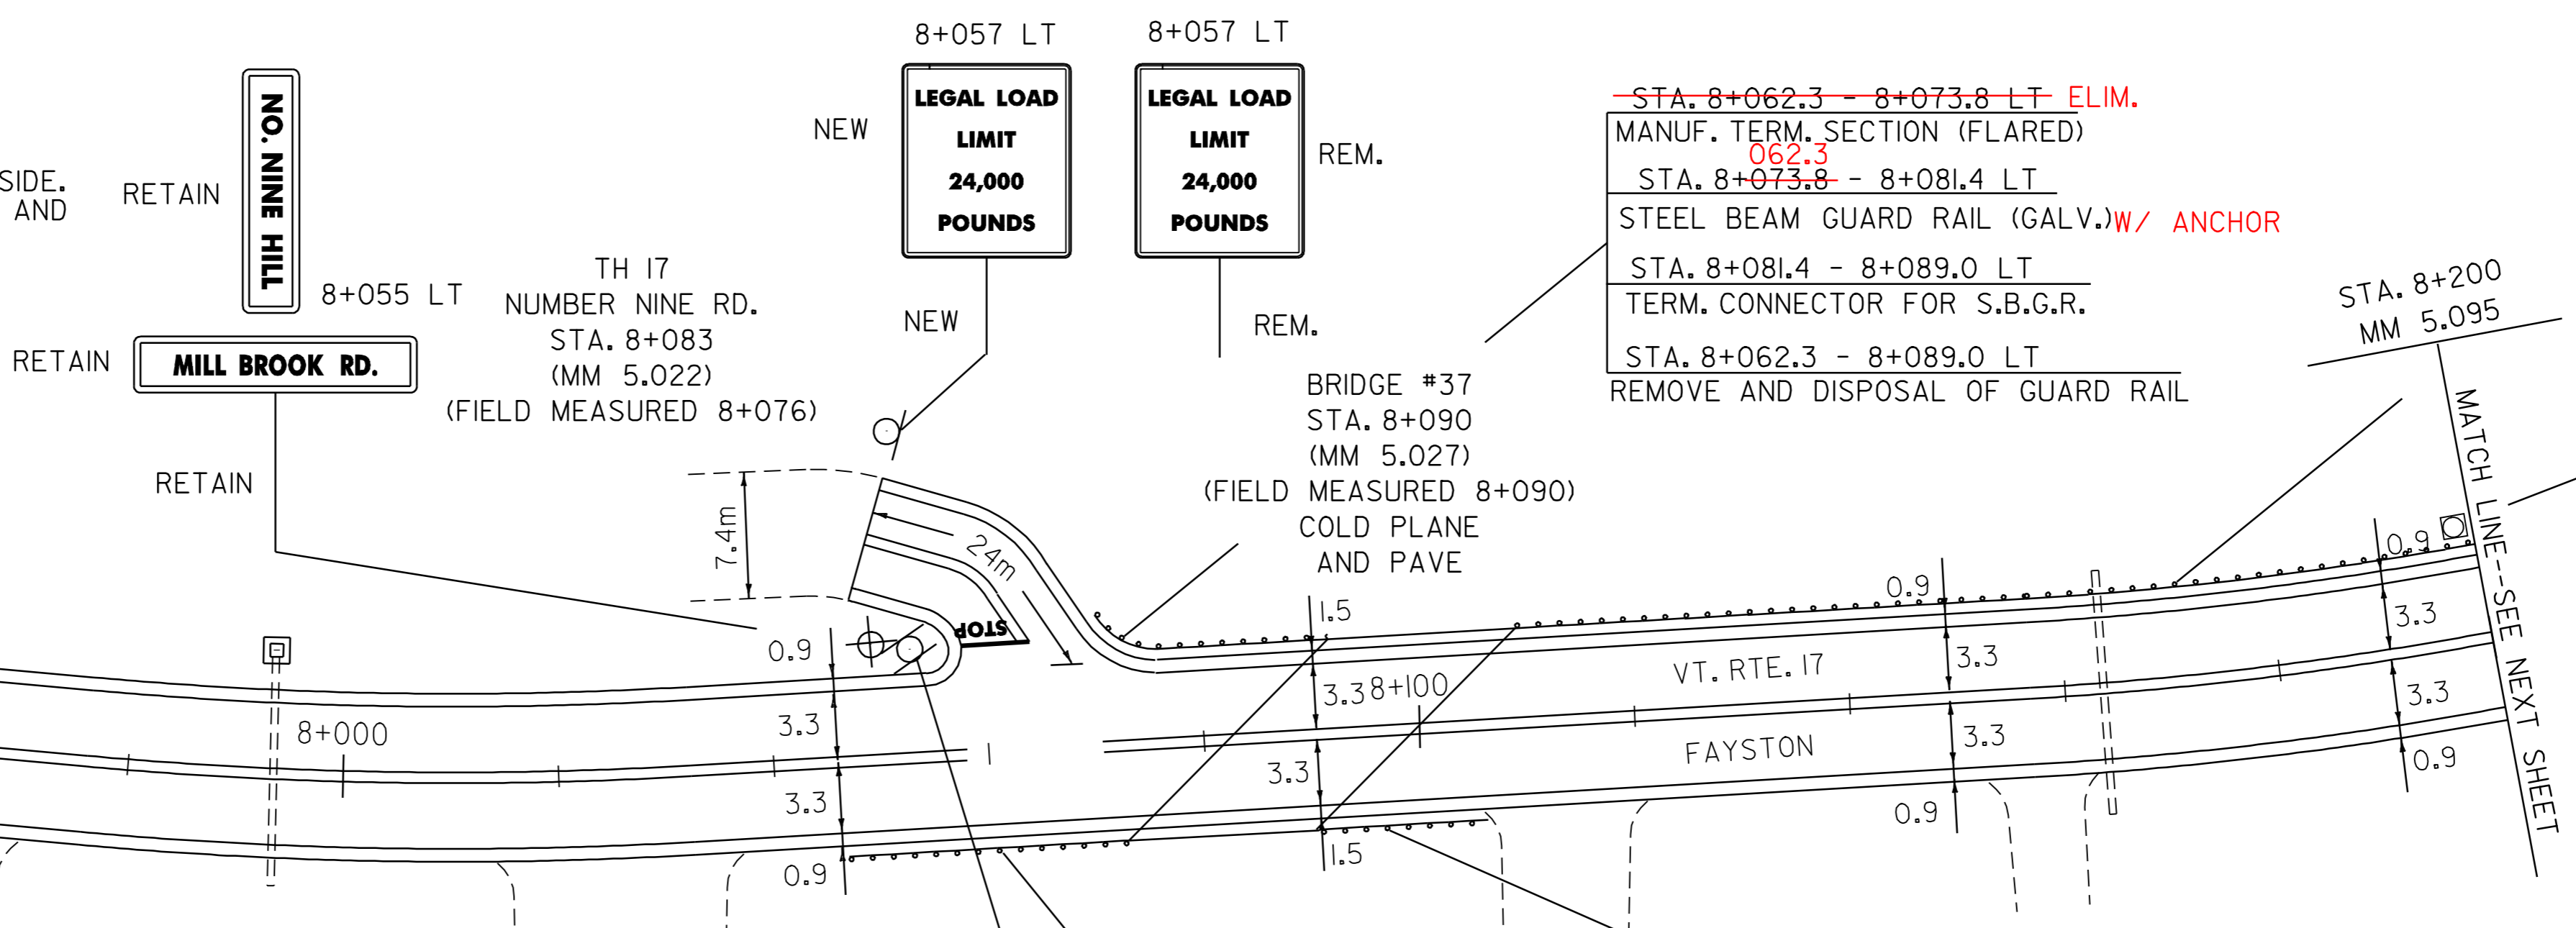


STA. 8+107.0 - 8+114.6 LT  
 TERM. CONNECTOR FOR S.B.G.R.  
 STA. 8+114.6 - 8+200.0 LT  
 STEEL BEAM GUARD RAIL (GALV.)  
 STA. 8+107.0 - 8+200.0 LT  
 REMOVE AND DISPOSAL OF GUARD RAIL  
 STA. 8+199 LT (POWER POLE)  
 TIGHTEN POST SPACING  
 SEE SHEET 24 FOR DETAILS

621.20 STEEL BEAM GUARD RAIL (GALV.)  
 FAYSTON:  
 STA. 8+056.8 - 8+064.4 RT  
 STA. 8+073.8 - 8+081.4 LT  
 STA. 8+097.6 - 8+105.2 RT  
 STA. 8+114.6 - 8+200.0 LT

621.505 MANUFACTURED TERMINAL SECTION (FLARED)  
 FAYSTON:  
 STA. 8+045.3 - 8+056.8 RT  
 STA. 8+062.3 - 8+073.8 LT

621.60 ANCHOR FOR STEEL BEAM GUARD RAIL  
 FAYSTON:  
 STA. 8+105.2 RT

621.80 REMOVAL AND DISPOSAL OF GUARD RAIL  
 FAYSTON:  
 STA. 8+045.3 - 8+072.0 RT  
 STA. 8+062.3 - 8+089.0 LT  
 STA. 8+090.0 - 8+105.2 RT  
 STA. 8+107.0 - 8+200.0 LT

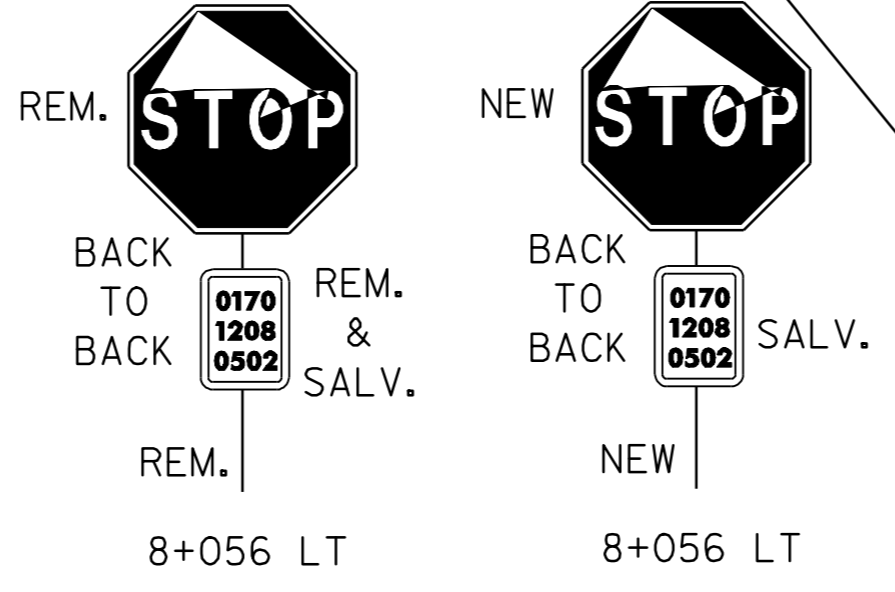

STA. 8+045.3 - 8+056.8 RT  
 MANUF. TERM. SECTION (FLARED)  
 STA. 8+056.8 - 8+064.4 RT  
 STEEL BEAM GUARD RAIL (GALV.)  
 STA. 8+064.4 - 8+072.0 RT  
 TERM. CONNECTOR FOR S.B.G.R.  
 STA. 8+045.3 - 8+072.0 RT  
 REMOVE AND DISPOSAL OF GUARD RAIL

STA. 8+090.0 - 8+097.6 RT  
 TERM. CONNECTOR FOR S.B.G.R.  
 STA. 8+097.6 - 8+105.2 RT  
 STEEL BEAM GUARD RAIL (GALV.) W/ANCHOR AT 8+105.2 RT  
 STA. 8+090.0 - 8+105.2 RT  
 REMOVE AND DISPOSAL OF GUARD RAIL

**PAVING PROJECT LAYOUT #2 VT. RTE. 17**

PROJECT NAME: FAYSTON - WAITSFIELD	FILE NAME: /pave/00b058/00b058.dgn	PLOT DATE: 23-MAY-2008 12:30
PROJECT NUMBER: STP 2406(I)S	PROJECT LEADER: WOOLAVER	DRAWN BY: J. REDMOND
	DESIGNED BY: J. REDMOND	CHECKED BY: J. REDMOND
	00b058p02.1	SHEET 13 OF 54

NOT TO SCALE

REMOVING SIGNS  
3 AS SHOWN

646.40 DURABLE 100 mm WHITE LINE (THERMOPLASTIC)  
(ALL LINES WILL INCLUDE EDGE LINE BREAKS AND RADIUS FOR TOWN HIGHWAYS)

FAYSTON:  
STA. 8+200 - STA. 8+800 LT & RT

646.60 TEMPORARY 100 mm WHITE LINE (PAINT)  
(ALL LINES WILL INCLUDE EDGE LINE BREAKS AND RADIUS FOR TOWN HIGHWAYS)

FAYSTON:  
STA. 8+200 - STA. 8+800 LT & RT

646.41 DURABLE 100 mm YELLOW LINE (THERMOPLASTIC)  
(ALL LINES WILL INCLUDE C/L BREAKS FOR TOWN HIGHWAYS) S=SOLID, D=DASHED

FAYSTON:  
STA. 8+200 - STA. 8+800 LT S - RT S  
STA. 8+715 DOUBLE SOLID RT, T-26

646.61 TEMPORARY 100 mm YELLOW LINE (PAINT)  
(ALL LINES WILL INCLUDE C/L BREAKS FOR TOWN HIGHWAYS) S=SOLID, D=DASHED

FAYSTON:  
STA. 8+200 - STA. 8+800 LT S - RT S  
STA. 8+715 DOUBLE SOLID RT, T-26

646.46 DURABLE 600 mm STOP BAR (THERMOPLASTIC)

FAYSTON:  
STA. 8+715 RT, T-26

646.66 TEMPORARY 600 mm STOP BAR (PAINT)

FAYSTON:  
STA. 8+715 RT, T-26

646.50 DURABLE LETTER OR SYMBOL (THERMOPLASTIC)

FAYSTON:  
STA. 8+715 RT, T-26, "S,T,O,P" (4 EA)

646.70 TEMPORARY LETTER OR SYMBOL (PAINT)


FAYSTON:  
STA. 8+715 RT, T-26, "S,T,O,P" (4 EA)

619.17 YIELDING MARKER POSTS

FAYSTON:  
STA. 8+300 RT & LT (2)  
STA. 8+414 RT & LT (2)  
STA. 8+499 RT & LT (2)  
STA. 8+699 RT (1)  
STA. 8+702 LT (1)

DITCHING LOCATION


FAYSTON:  
~~STA. 8+730 - 8+800 RT ELIM.~~

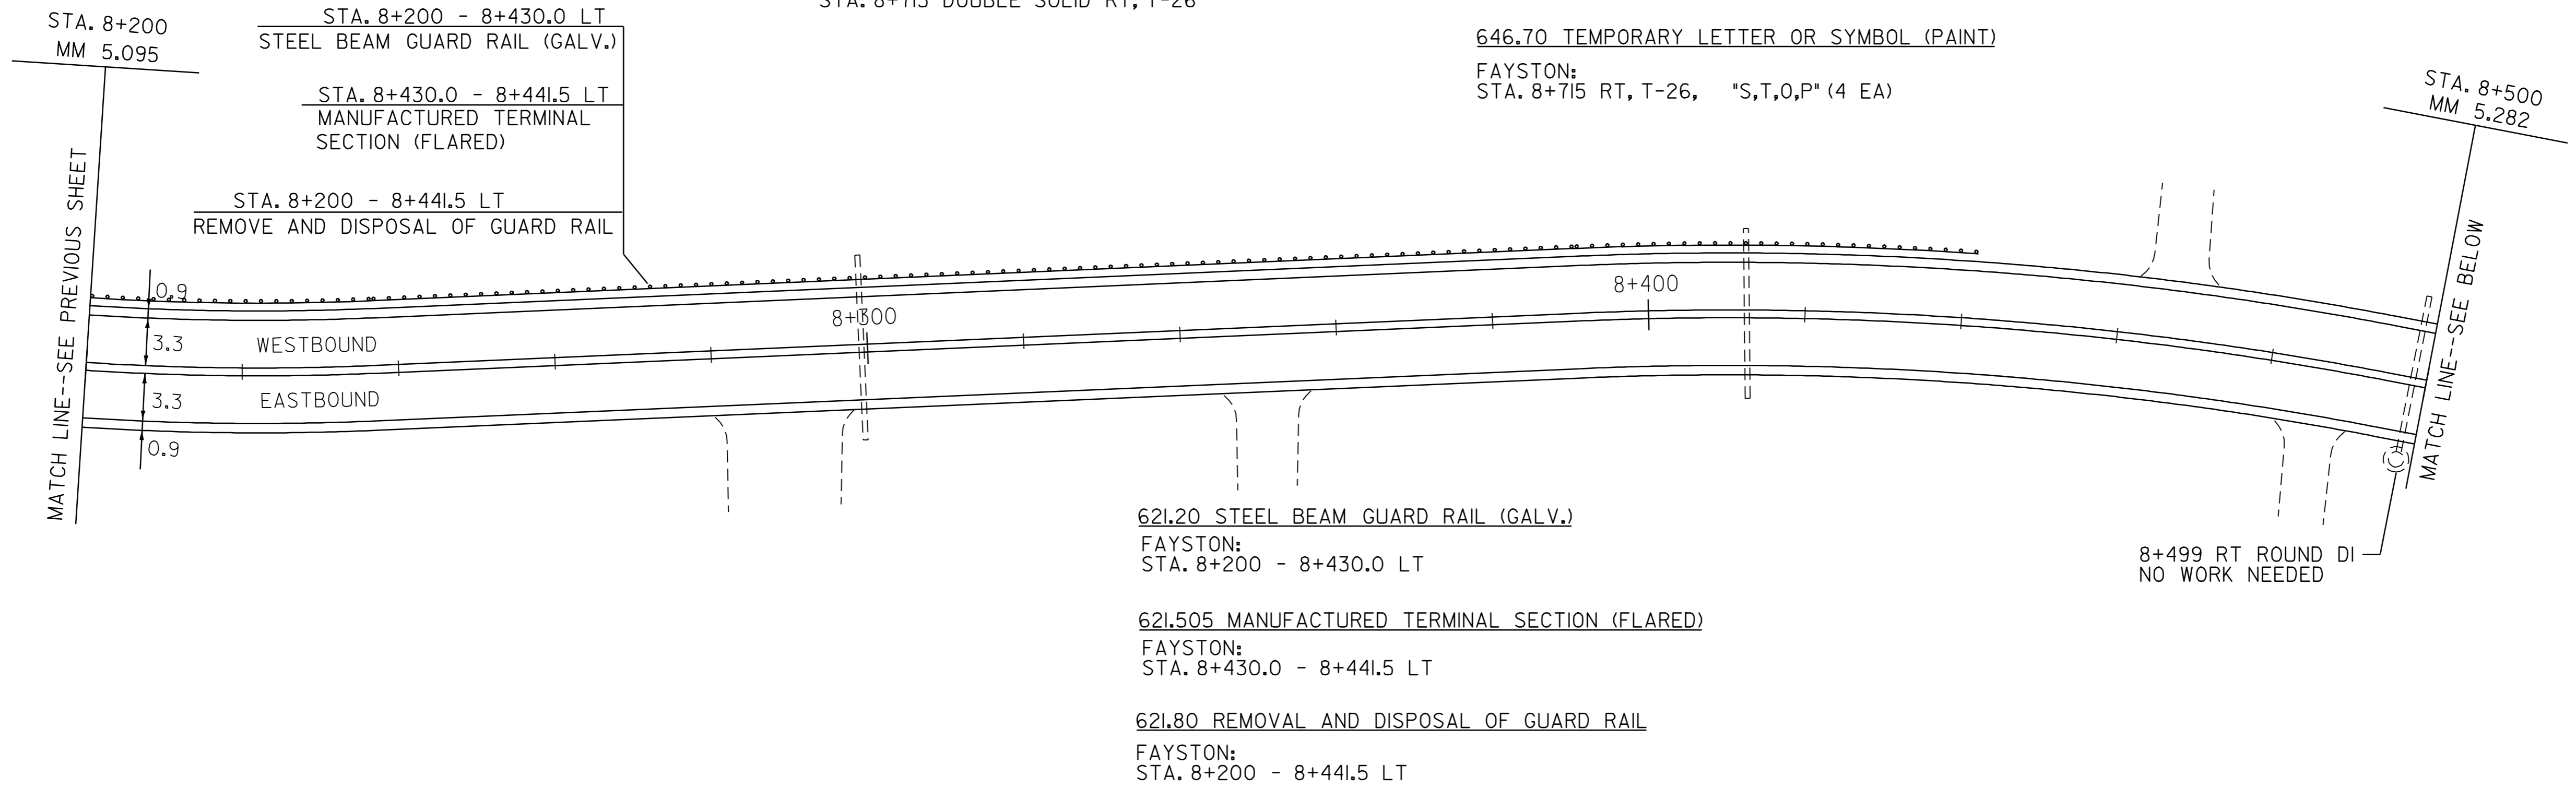

621.20 STEEL BEAM GUARD RAIL (GALV.)  
FAYSTON:  
STA. 8+200 - 8+430.0 LT

621.505 MANUFACTURED TERMINAL SECTION (FLARED)  
FAYSTON:  
STA. 8+430.0 - 8+441.5 LT

621.80 REMOVAL AND DISPOSAL OF GUARD RAIL  
FAYSTON:  
STA. 8+200 - 8+441.5 LT

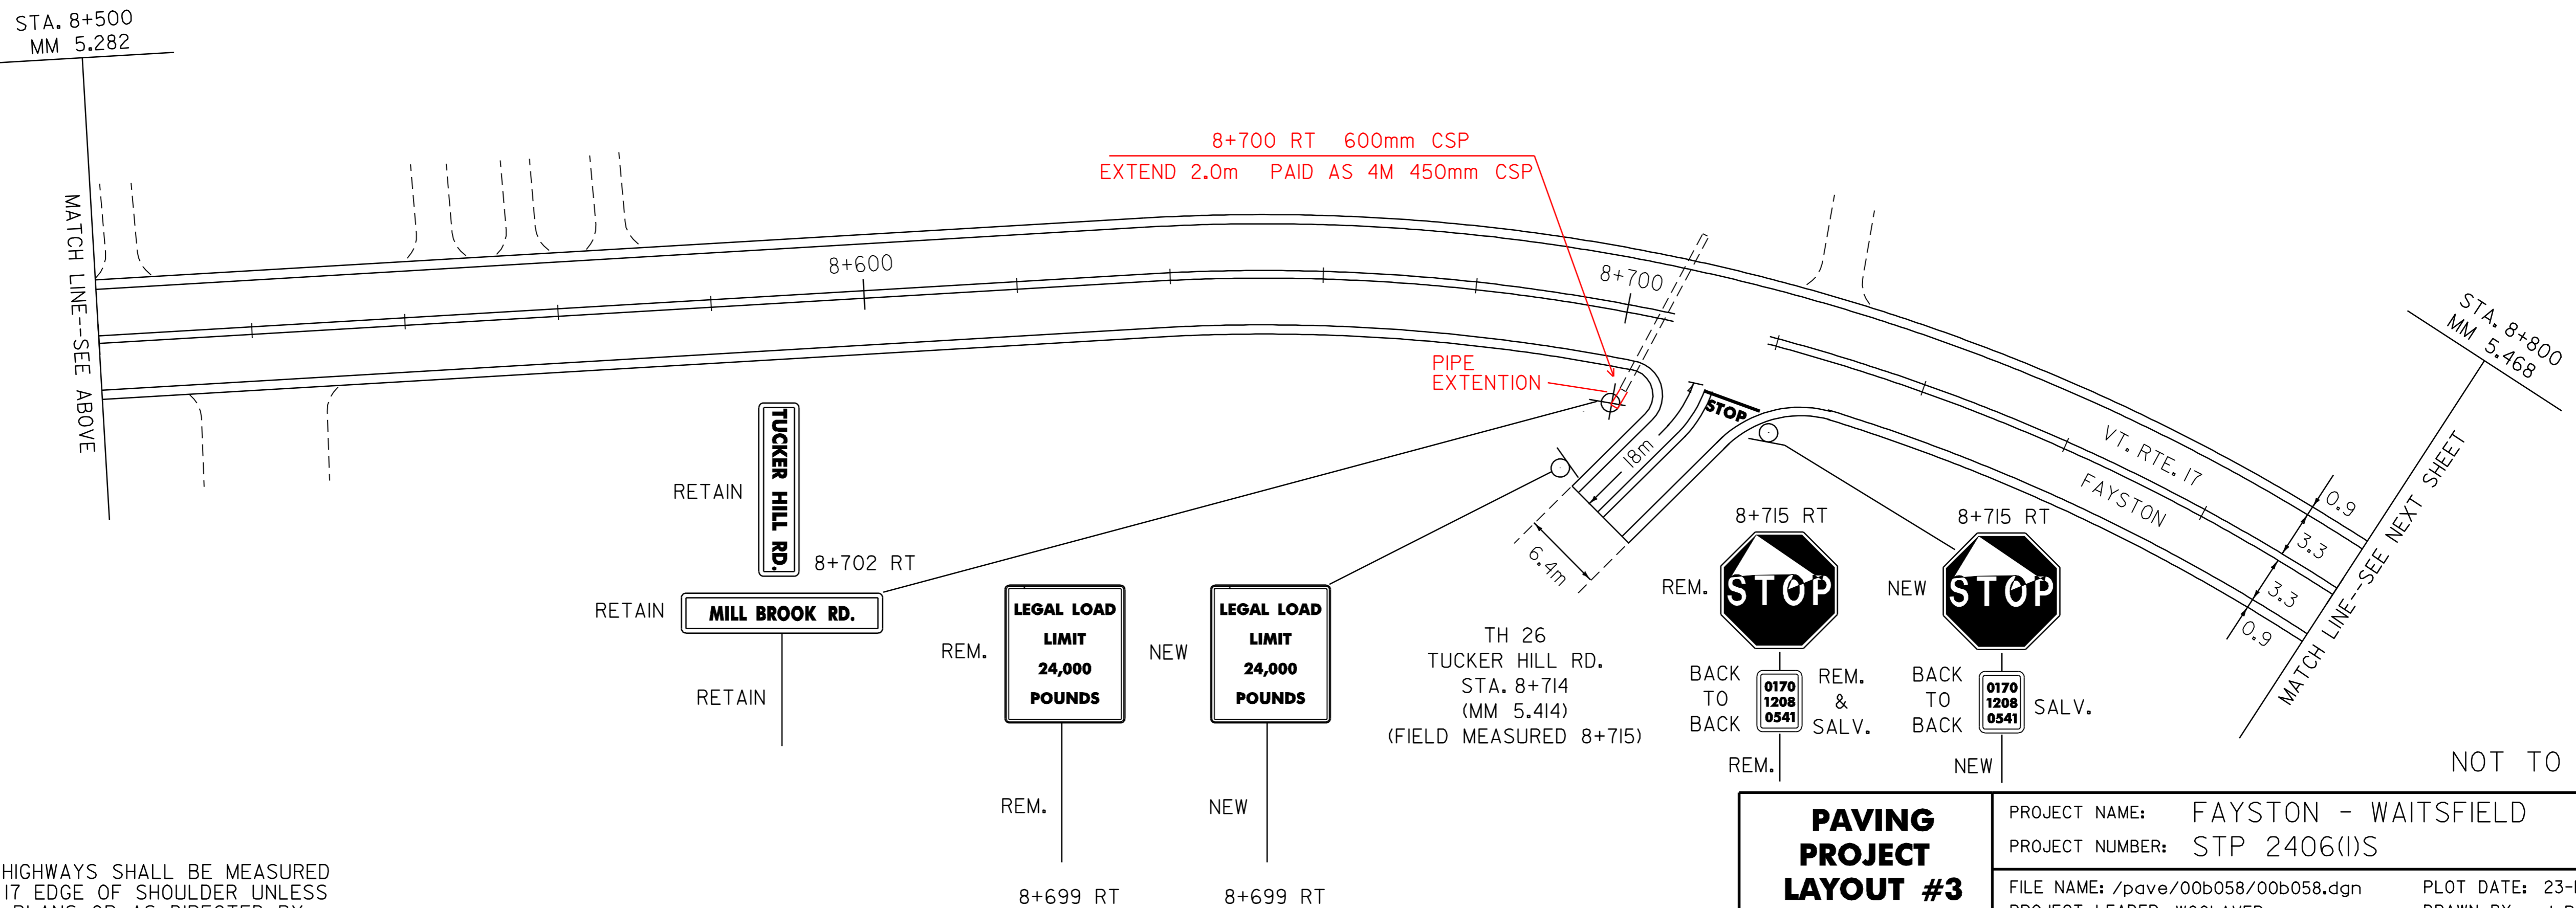

NOT TO SCALE

NOTE:  
1. PAVING LIMIT ON ALL TOWN HIGHWAYS SHALL BE MEASURED 8 m BACK FROM VT. ROUTE 17 EDGE OF SHOULDER UNLESS DENOTED OTHERWISE ON THE PLANS OR AS DIRECTED BY THE RESIDENT ENGINEER.

<b>PAVING PROJECT LAYOUT #3 VT. RTE. 17</b>	PROJECT NAME: FAYSTON - WAITSFIELD
	PROJECT NUMBER: STP 2406(I)S
	FILE NAME: /pave/00b058/00b058.dgn
	PLOT DATE: 23-MAY-2008 12:30
DESIGNED BY: J. REDMOND	DRAWN BY: J. REDMOND
00b058p03.1	CHECKED BY: J. REDMOND
	SHEET 14 OF 54

646.40 DURABLE 100 mm WHITE LINE (THERMOPLASTIC)  
 (ALL LINES WILL INCLUDE EDGE LINE BREAKS AND RADIUS FOR TOWN HIGHWAYS)

FAYSTON:  
 STA. 8+800 - STA. 9+372.6 LT & RT

646.60 TEMPORARY 100 mm WHITE LINE (PAINT)  
 (ALL LINES WILL INCLUDE EDGE LINE BREAKS AND RADIUS FOR TOWN HIGHWAYS)

FAYSTON:  
 STA. 8+800 - STA. 9+372.6 LT & RT

646.41 DURABLE 100 mm YELLOW LINE (THERMOPLASTIC)  
 (ALL LINES WILL INCLUDE C/L BREAKS FOR TOWN HIGHWAYS) S=SOLID, D=DASHED

FAYSTON:  
 STA. 8+800 - STA. 9+372.6 LT C RT  
 S - S

646.61 TEMPORARY 100 mm YELLOW LINE (PAINT)  
 (ALL LINES WILL INCLUDE C/L BREAKS FOR TOWN HIGHWAYS) S=SOLID, D=DASHED


FAYSTON:  
 STA. 8+800 - STA. 9+372.6 LT C RT  
 S - S

619.17 YIELDING MARKER POSTS


FAYSTON:  
 STA. 8+915 RT & LT (2)  
 STA. 9+042 RT (1)  
 STA. 9+046 LT (1)  
 STA. 9+123 RT & LT (2)  
 STA. 9+322 RT & LT (2)  
 STA. 9+369 RT & LT (2)

DITCHING LOCATION

FAYSTON:  
~~STA. 8+800 - 8+958 RT~~ 8+923 ~ 8+954 RT  
~~STA. 9+281 - 9+322 RT~~ 8+966 ~ 9+040 RT  
~~STA. 9+369 - 9+373 RT~~ ELIM.

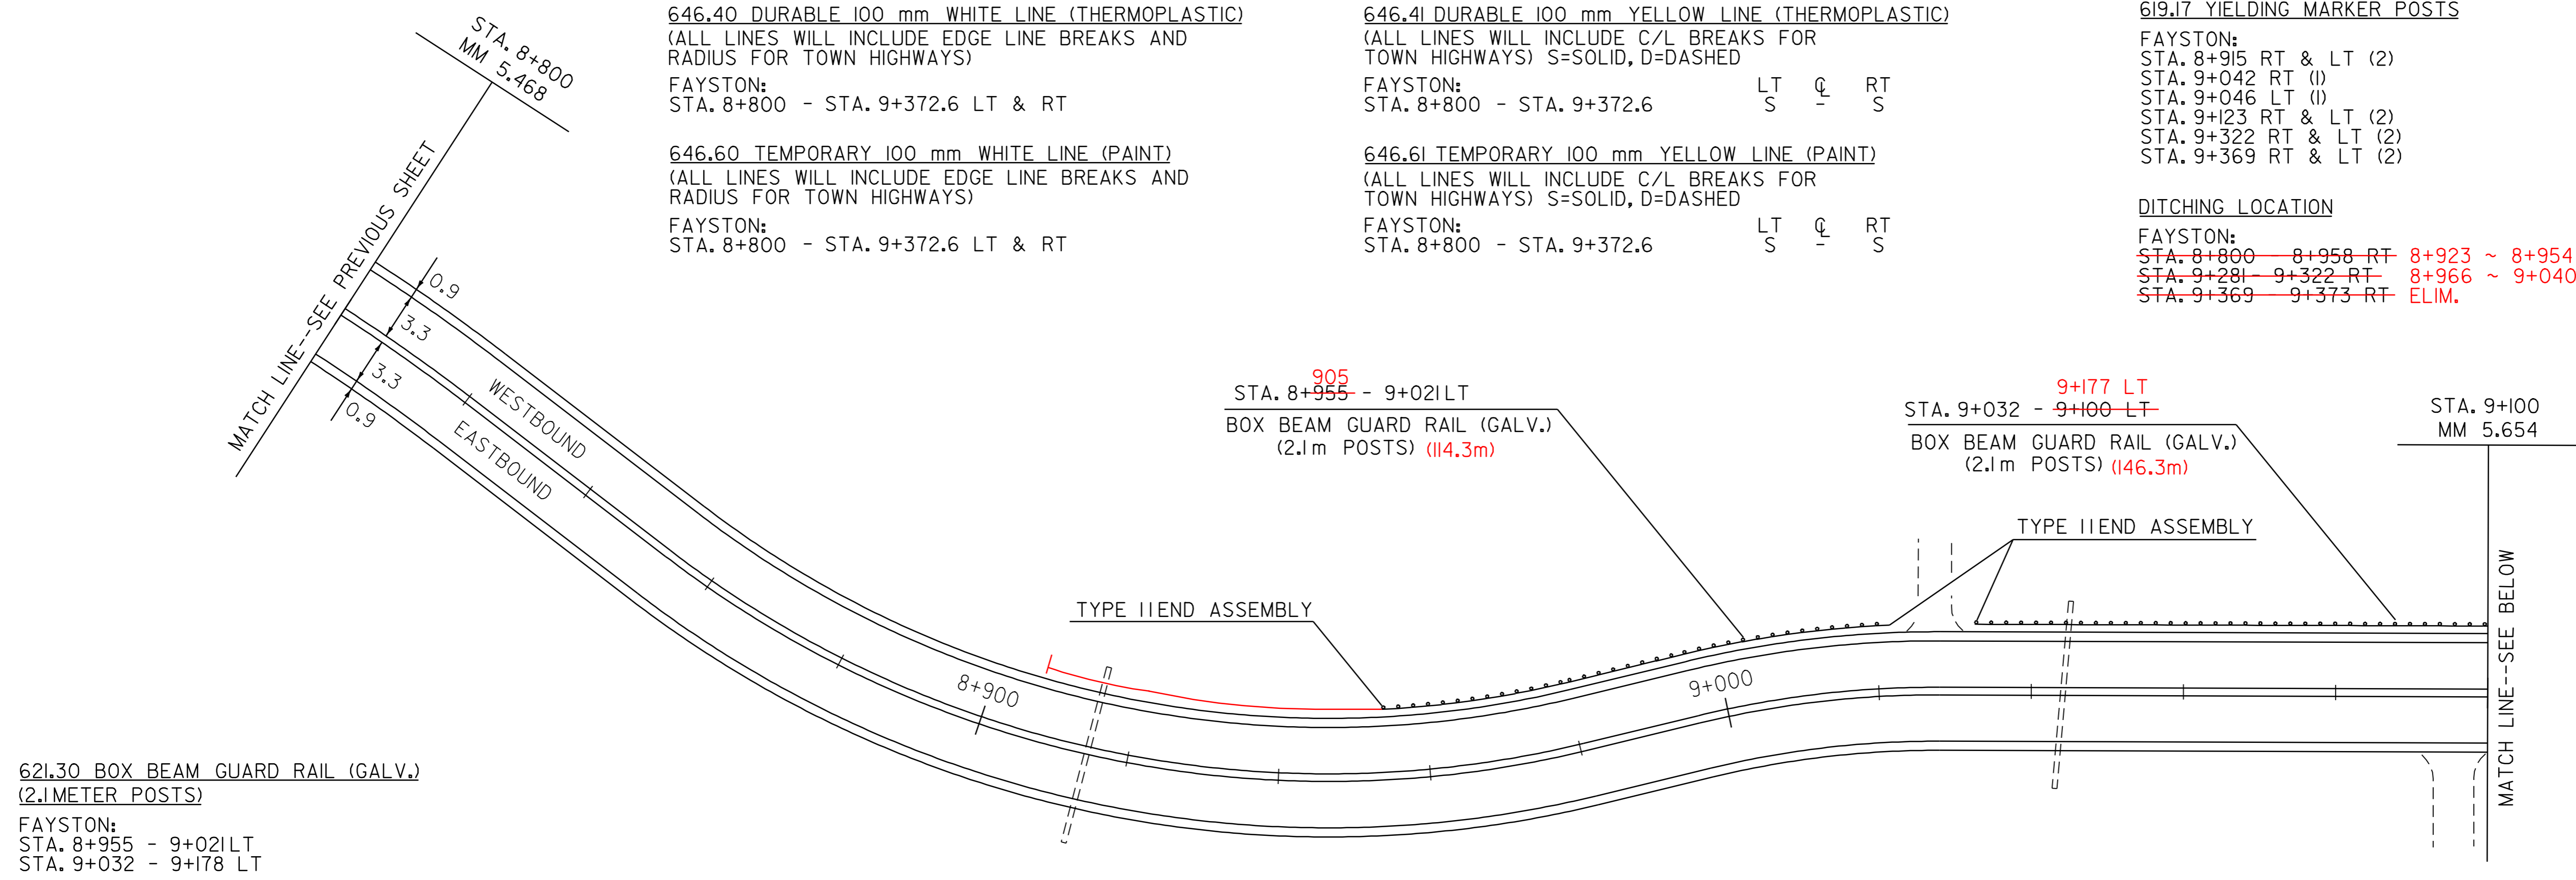

621.30 BOX BEAM GUARD RAIL (GALV.)  
 (2.1METER POSTS)  
 FAYSTON:  
 STA. 8+955 - 9+021 LT  
 STA. 9+032 - 9+178 LT

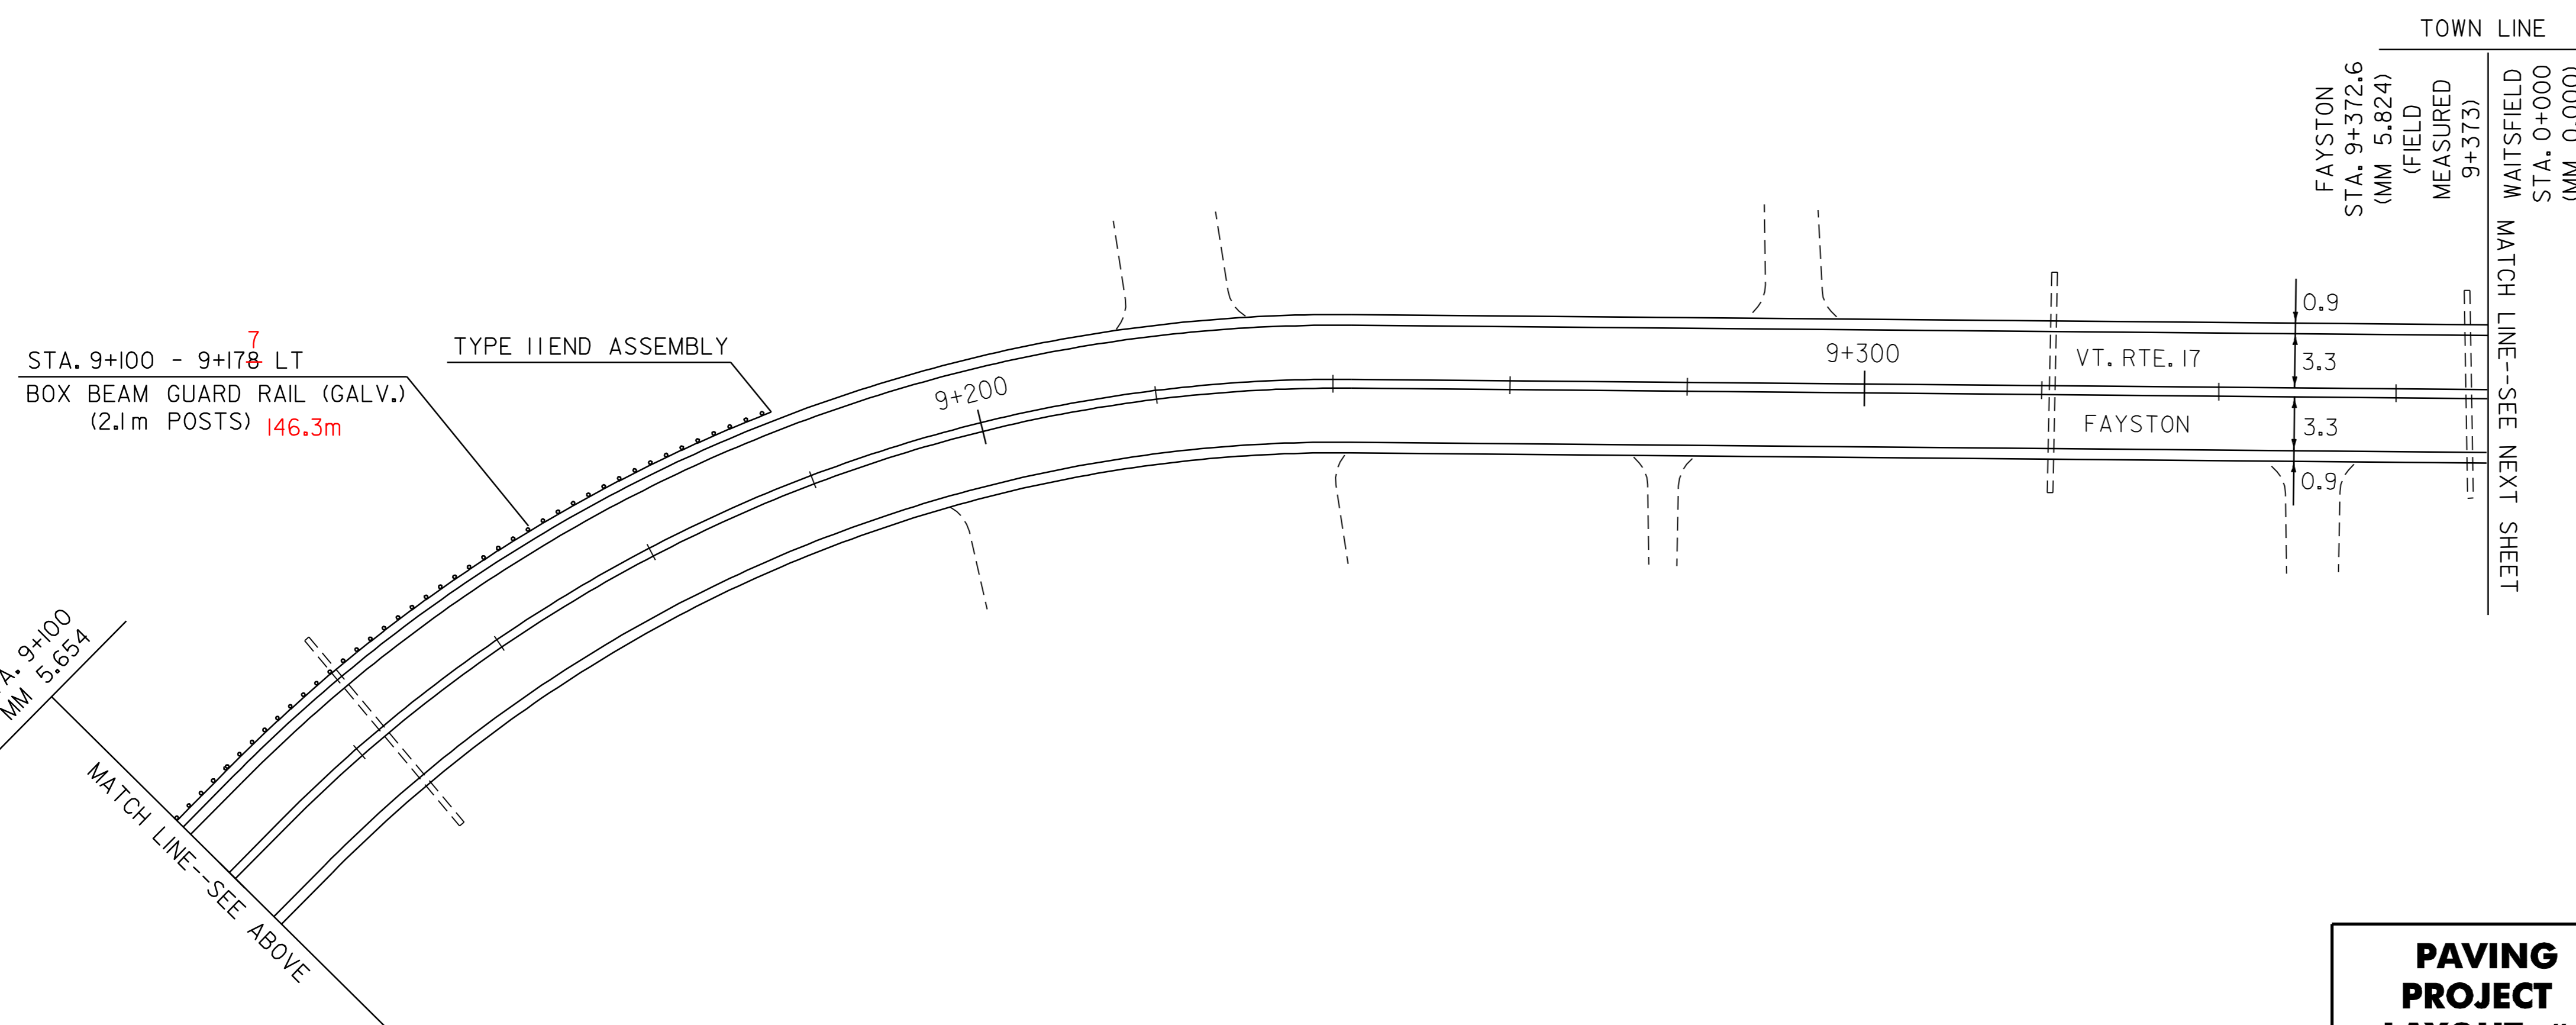

STA. 9+100 - 9+178 LT  
 BOX BEAM GUARD RAIL (GALV.)  
 (2.1m POSTS) 146.3m

TOWN LINE	
FAYSTON STA. 9+372.6 (MM 5.824) (FIELD MEASURED 9+373)	WAITSFIELD STA. 0+000 (MM 0.000)

NOT TO SCALE

<b>PAVING PROJECT LAYOUT #4 VT. RTE. 17</b>	PROJECT NAME: FAYSTON - WAITSFIELD
	PROJECT NUMBER: STP 2406(I)S
	FILE NAME: /pave/00b058/00b058.dgn
	DESIGNED BY: J. REDMOND
	PLOT DATE: 23-MAY-2008 12:5
	DRAWN BY: J. REDMOND
	CHECKED BY: J. REDMOND
	SHEET 15 OF 54

REMOVING SIGNS  
3 AS SHOWN

**646.40 DURABLE 100 mm WHITE LINE (THERMOPLASTIC)**  
(ALL LINES WILL INCLUDE EDGE LINE BREAKS AND RADIUS FOR TOWN HIGHWAYS)  
WAITSFIELD:  
STA. 0+000 - STA. 0+092 LT & RT

**646.60 TEMPORARY 100 mm WHITE LINE (PAINT)**  
(ALL LINES WILL INCLUDE EDGE LINE BREAKS AND RADIUS FOR TOWN HIGHWAYS)  
WAITSFIELD:  
STA. 0+000 - STA. 0+092 LT & RT

**646.41 DURABLE 100 mm YELLOW LINE (THERMOPLASTIC)**  
(ALL LINES WILL INCLUDE C/L BREAKS FOR TOWN HIGHWAYS) S=SOLID, D=DASHED  
WAITSFIELD:  
STA. 0+000 - STA. 0+092 LT S - RT S  
STA. 0+087 DOUBLE SOLID RT, T-29

**646.61 TEMPORARY 100 mm YELLOW LINE (PAINT)**  
(ALL LINES WILL INCLUDE C/L BREAKS FOR TOWN HIGHWAYS) S=SOLID, D=DASHED  
WAITSFIELD:  
STA. 0+000 - STA. 0+092 LT S - RT S  
STA. 0+087 DOUBLE SOLID RT, T-29

**646.46 DURABLE 600 mm STOP BAR (THERMOPLASTIC)**  
WAITSFIELD:  
STA. 0+087 RT, T-29


**646.66 TEMPORARY 600 mm STOP BAR (PAINT)**  
WAITSFIELD:  
STA. 0+087 RT, T-29

**646.50 DURABLE LETTER OR SYMBOL (THERMOPLASTIC)**  
WAITSFIELD:  
STA. 0+087 RT, T-29, "S,T,O,P" (4 EA)

**646.70 TEMPORARY LETTER OR SYMBOL (PAINT)**  
WAITSFIELD:  
STA. 0+087 RT, T-29, "S,T,O,P" (4 EA)

**619.17 YIELDING MARKER POSTS**  
WAITSFIELD:  
STA. 0+025 RT (I)  
STA. 0+034 LT (I)  
STA. 0+067 RT (I)  
STA. 0+071 LT (I)

**DITCHING LOCATION**  
WAITSFIELD:  
~~STA. 0+000 - 0+067 RT ELIM.~~

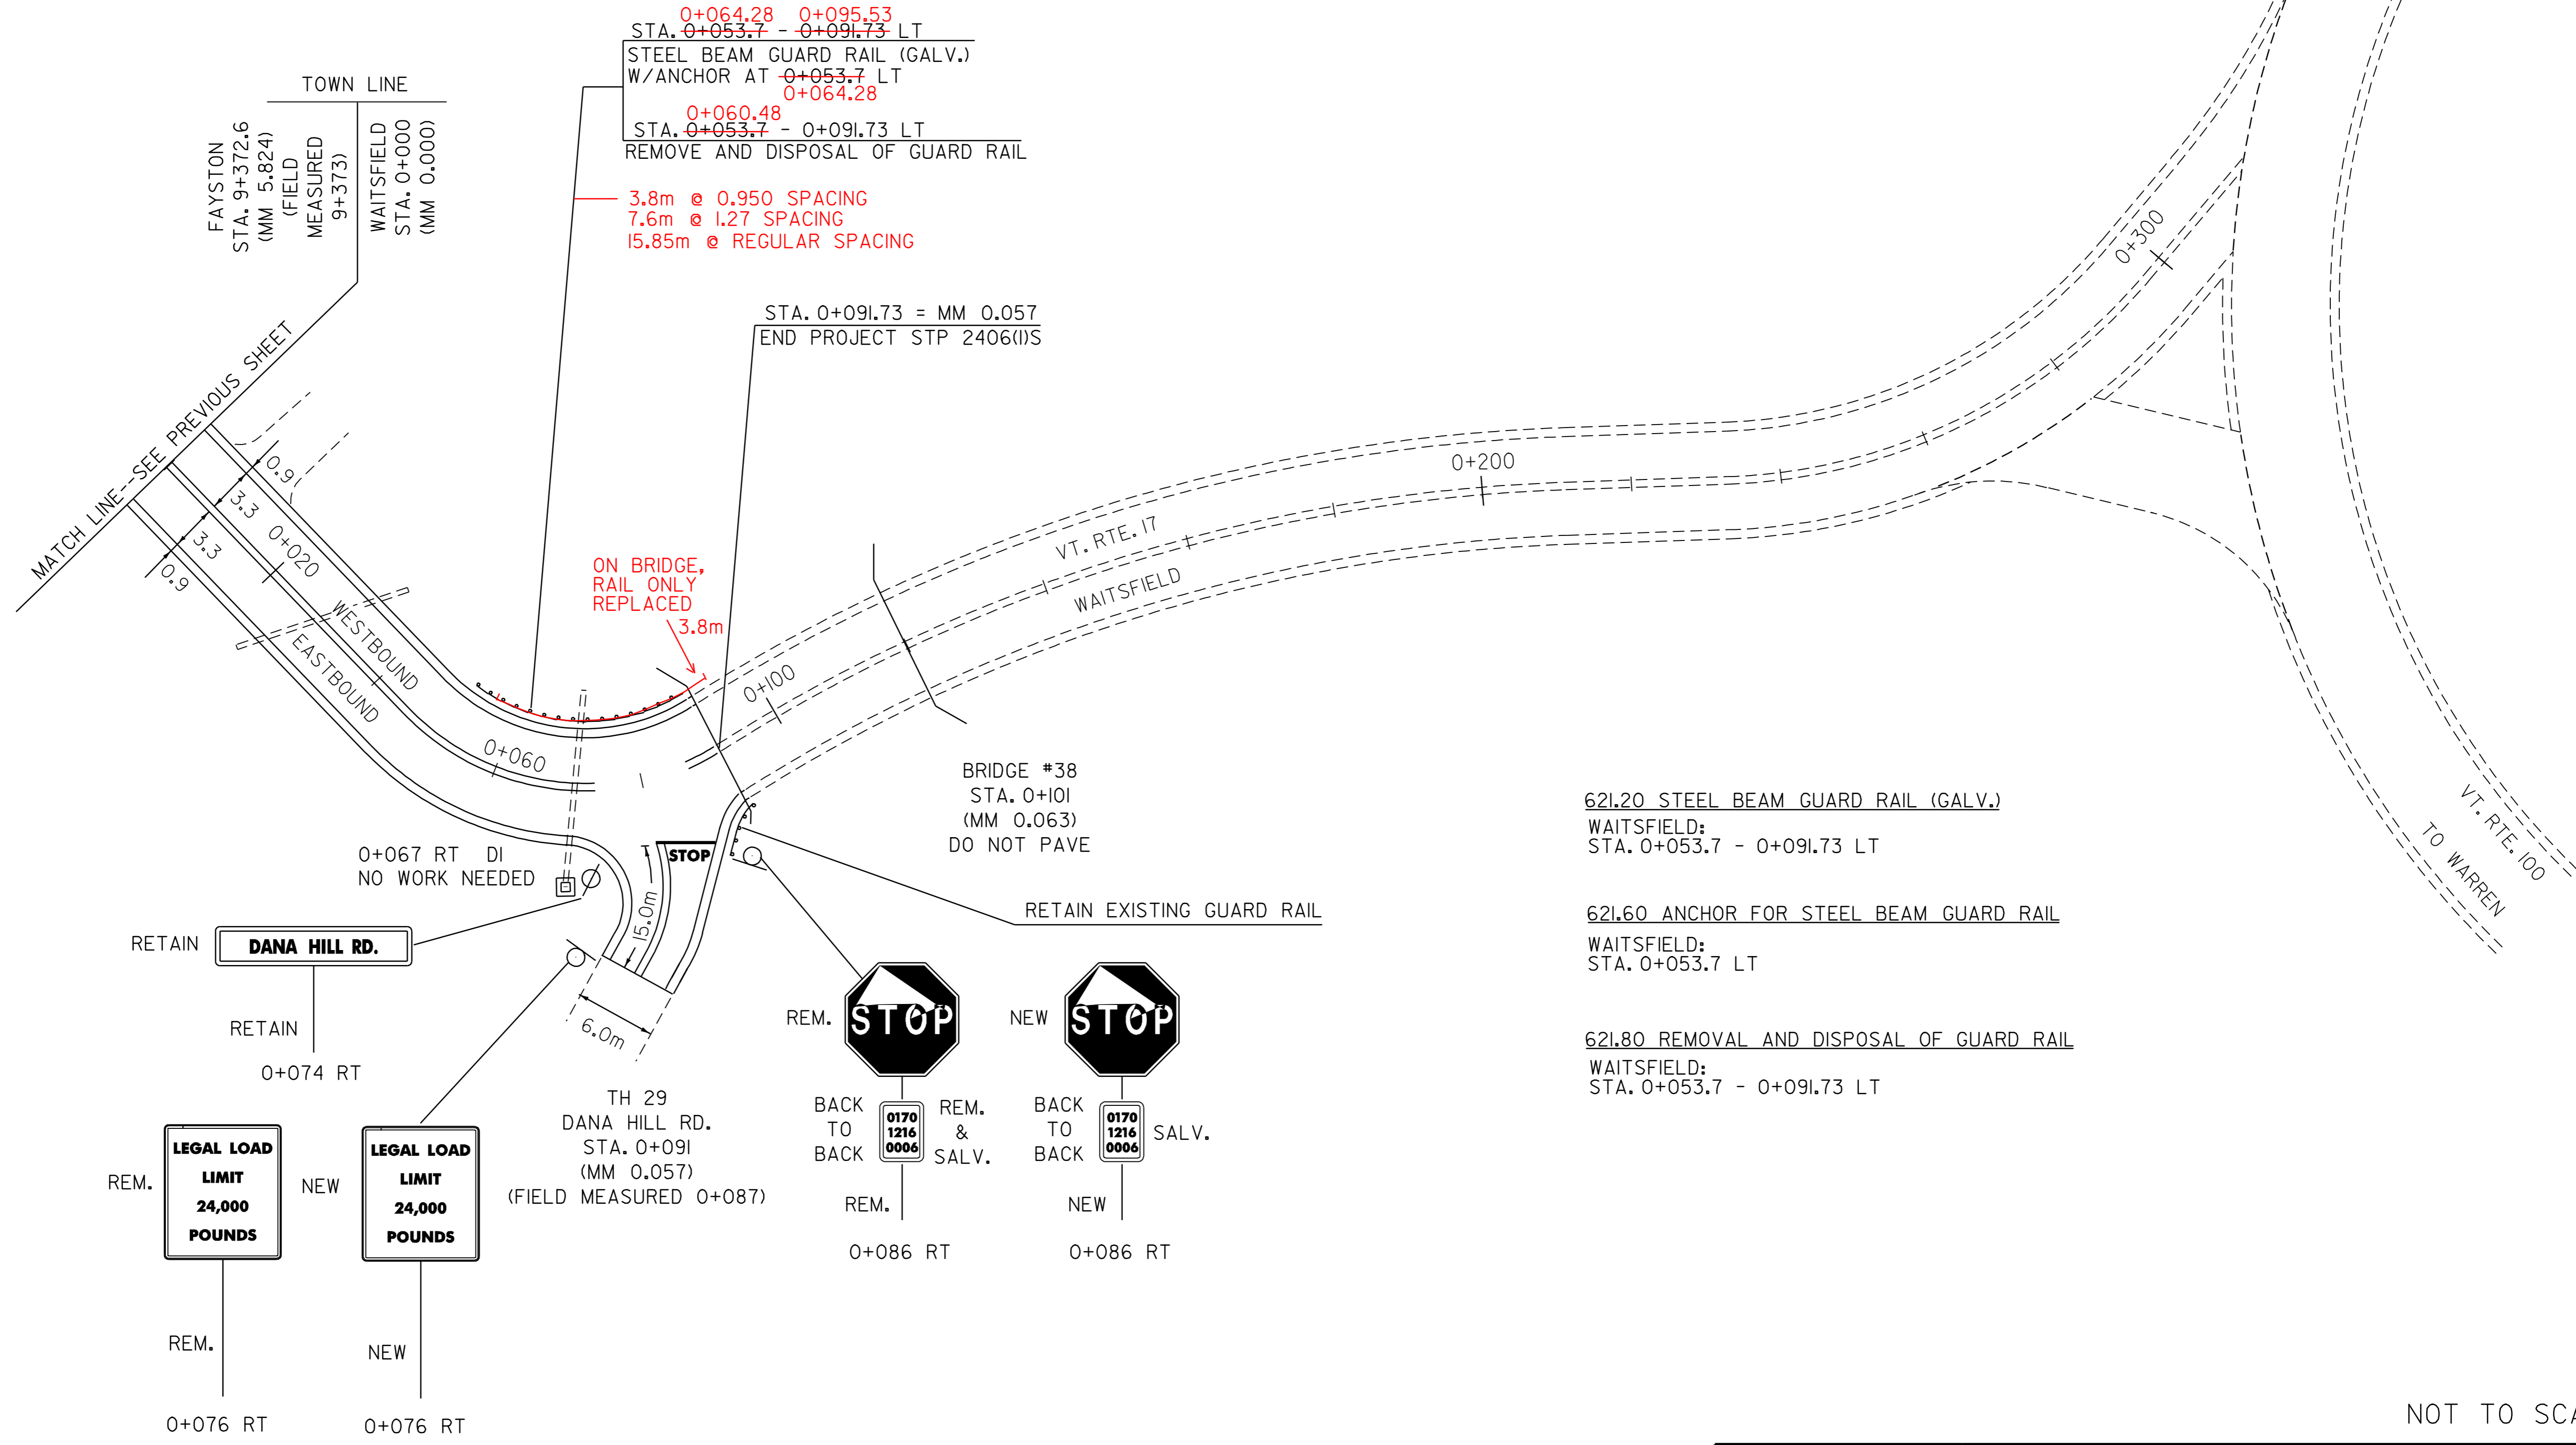

**621.20 STEEL BEAM GUARD RAIL (GALV.)**  
WAITSFIELD:  
STA. 0+053.7 - 0+091.73 LT

**621.60 ANCHOR FOR STEEL BEAM GUARD RAIL**  
WAITSFIELD:  
STA. 0+053.7 LT

**621.80 REMOVAL AND DISPOSAL OF GUARD RAIL**  
WAITSFIELD:  
STA. 0+053.7 - 0+091.73 LT

NOT TO SCALE


NOTE:  
1. PAVING LIMIT ON ALL TOWN HIGHWAYS SHALL BE MEASURED 8 m BACK FROM VT. ROUTE 17 EDGE OF SHOULDER UNLESS DENOTED OTHERWISE ON THE PLANS OR AS DIRECTED BY THE RESIDENT ENGINEER.

<b>PAVING PROJECT LAYOUT #5 VT. RTE. 17</b>	PROJECT NAME: FAYSTON - WAITSFIELD
	PROJECT NUMBER: STP 2406(I)S
	FILE NAME: /pave/00b058/00b058.dgn
	PLOT DATE: 23-MAY-2008 12:30
	PROJECT LEADER: WOOLAVER
	DRAWN BY: J. REDMOND
	DESIGNED BY: J. REDMOND
	CHECKED BY: J. REDMOND
	00b058p05.1
	SHEET 16 OF 54








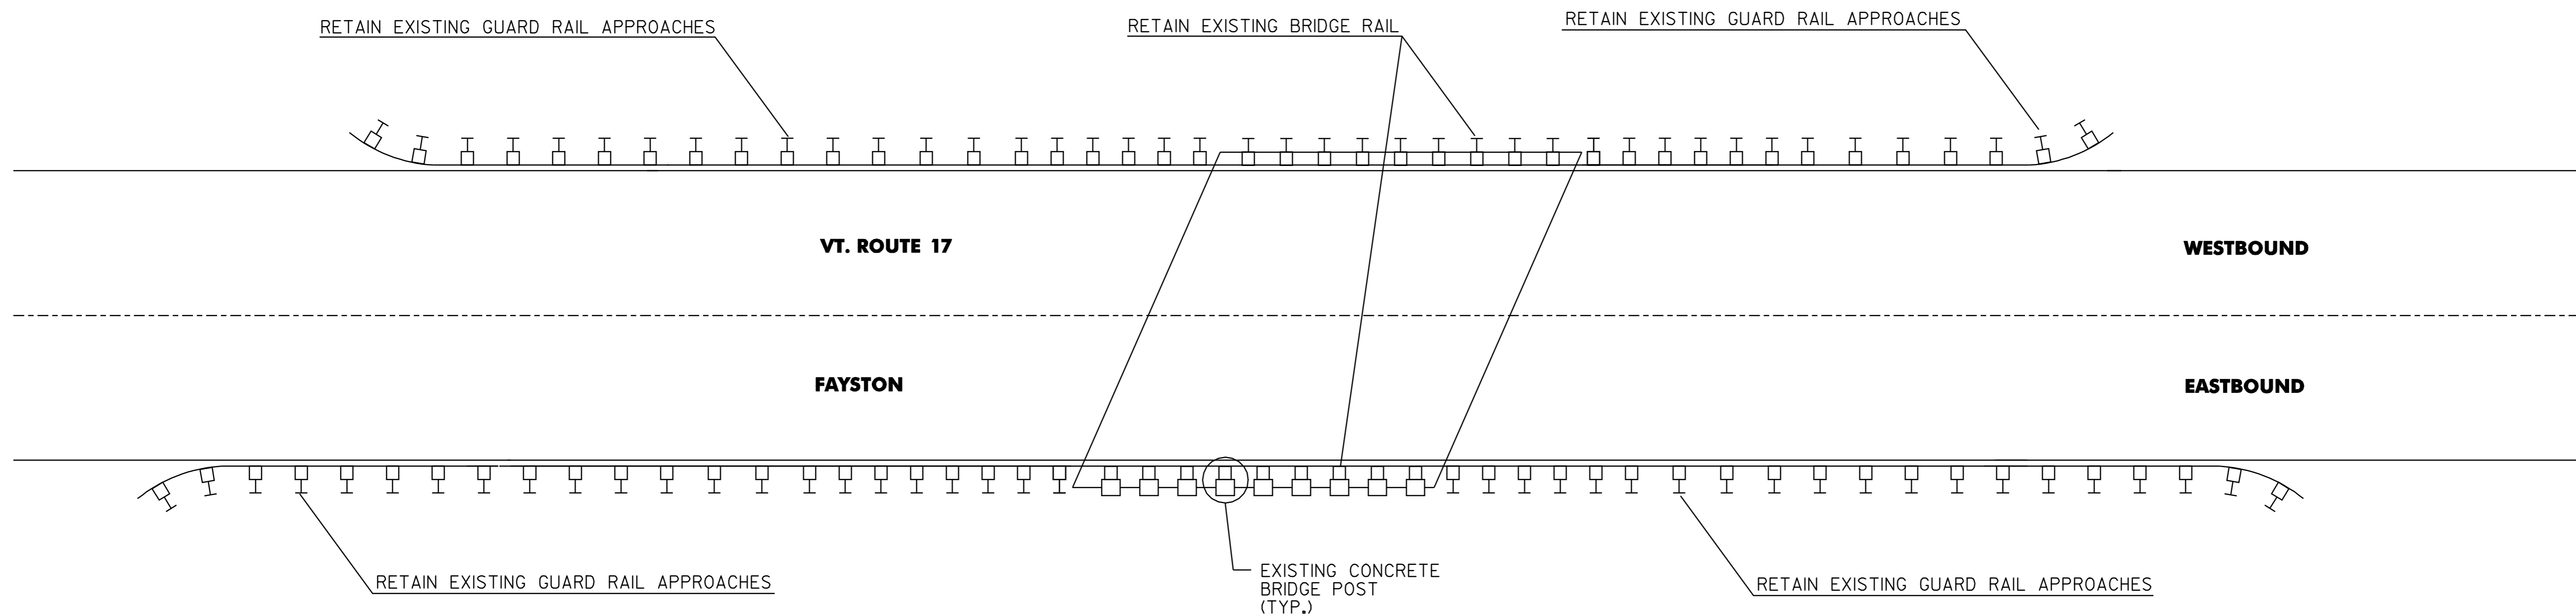

**FAYSTON VT. ROUTE 17  
BR #36 @ STA 7+771  
(MM 4.829)**

NOT TO SCALE

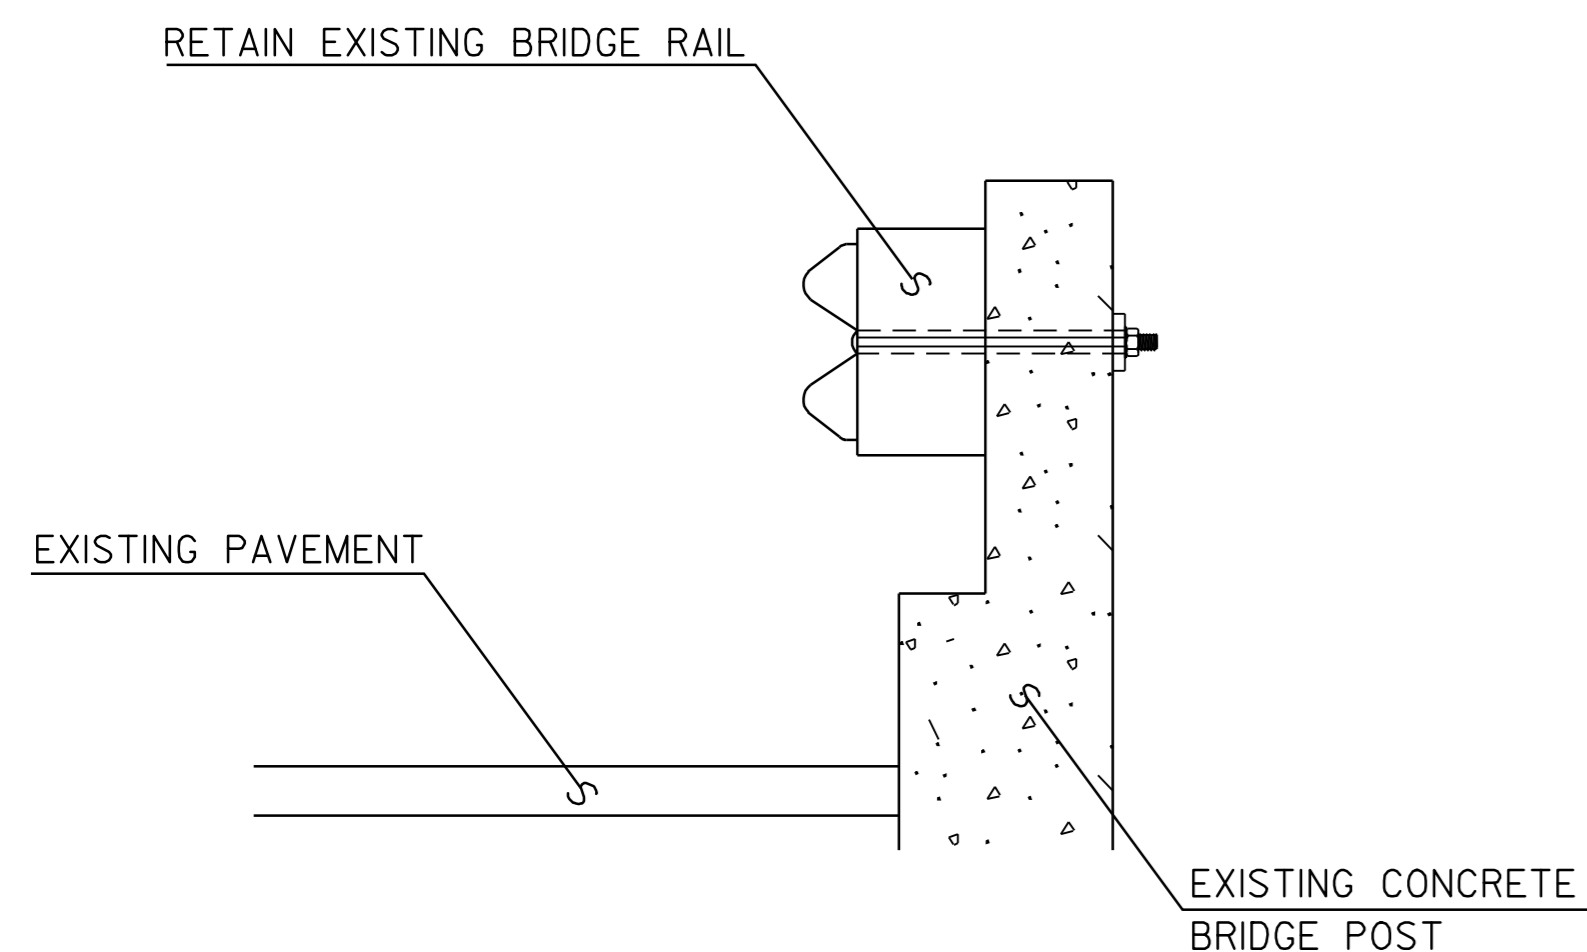

**BR 36 BRIDGE POST DETAIL**  
NOT TO SCALE


1. REFER TO SHEET 7 FOR DETAILS OF COLD PLANING AND PAVING LIMITS AT THE BRIDGE JOINTS.
2. BRIDGE 36 REPAIRS AND PAVING ARE NOT INCLUDED WITH THE PROJECT. BRIDGE WORK WILL BE DONE UNDER PROJECT FAYSTON BHF 0200(9).
3. BRIDGE 36 REPAIRS ARE NOT EXPECTED TO BEGIN UNTIL AFTER THE PAVING PROJECT IS COMPLETED.

NOTE: ALL DIMENSIONS IN MILLIMETERS EXCEPT AS INDICATED

**BRIDGE  
DETAIL  
SHEET #2**

PROJECT :	FAYSTON - WAITSFIELD	PROJECT NO. :	STP 2406(I) S
DESIGN FILE NAME:	pave/00b058/00b058.dgn	PLOT DATE:	23-MAY-2008 12
IPARM FILE NAME:	_00b058br2.i	SURVEY DATE:	7/05
SURVEYED BY:	LFW	DRAWN BY:	7/05
SQUAD LEADER:	LFW	SHEET:	20 OF 54

SECTION	FIELD MEAS. (m)	PAY FACTOR	PAY MEAS. (m)	
(A)	27.3	1.0	27.3	8+062 - 8+089 LT
(B)	72.39	1.0	72.39	322.33 8+107 - 8+441.5 LT
(C)	15.24	1.4	21.34	
(D)	228.60	1.0	228.60	
(E)	7.6	1.0	7.6	8+045 - 8+072 RT
(F)	8.23	1.0	8.23	8+090 - 8+107 RT
			345.17m	ITEM 621.20 S.B.G.R.

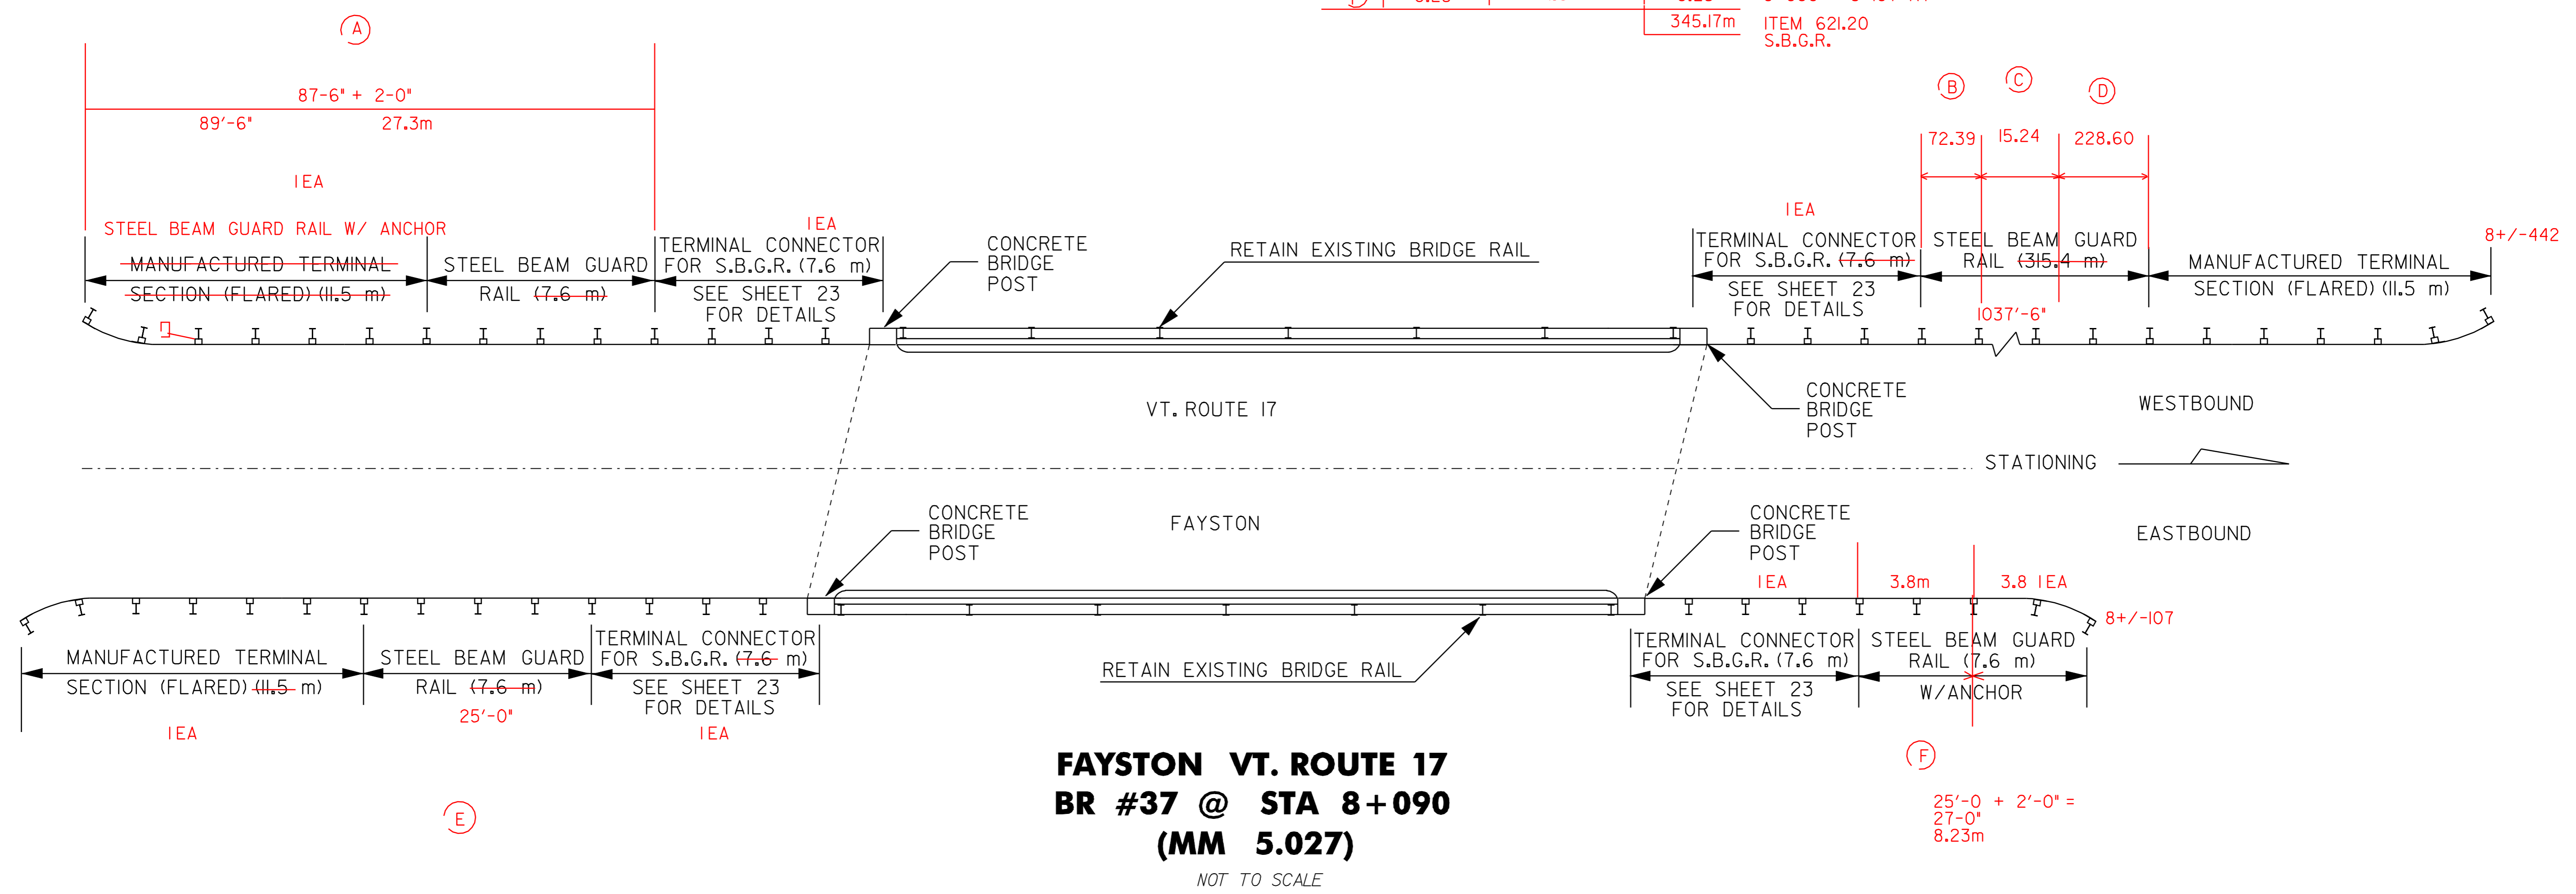

I. REFER TO SHEET 7 FOR BRIDGE 37 COLD PLANE TRANSITION AND ASPHALTIC PLUG JOINT DETAILS.

NOTE: ALL DIMENSIONS IN MILLIMETERS EXCEPT AS INDICATED


DATUM \_\_\_\_\_  
VERTICAL \_\_\_\_\_  
HORIZONTAL \_\_\_\_\_

<b>BRIDGE DETAIL SHEET #3</b>	PROJECT : FAYSTON - WAITSFIELD	PROJECT NO. : STP_2406(I) S
	DESIGN FILE NAME: <u>pave/00b058/00b058.dgn</u>	
	IPARM FILE NAME: <u>00b058br3.i</u>	PLOT DATE: <u>23-MAY-2008 12:00</u>
	SURVEYED BY: <u>LFW</u>	SURVEY DATE: <u>7/05</u>
SQUAD LEADER: <u>LFW</u>	DRAWN BY: <u>7/05</u>	SHEET: <u>21</u> OF <u>54</u>

SECTION	(m) FIELD MEAS.	PAY FACTOR	(m) PAY MEAS.
(A)	15.85	1.0	15.85
(B)	7.6	1.2	9.12
(C)	3.8	1.4	5.32
(D)	3.8	0.5	1.90
			32.19m

REMOVE AND DISPOSE S.B.G.R.  
0+/-060.5 - 0+/-095.5  
35.05m ITEM 621.80

ITEM 621.20  
S.B.G.R.

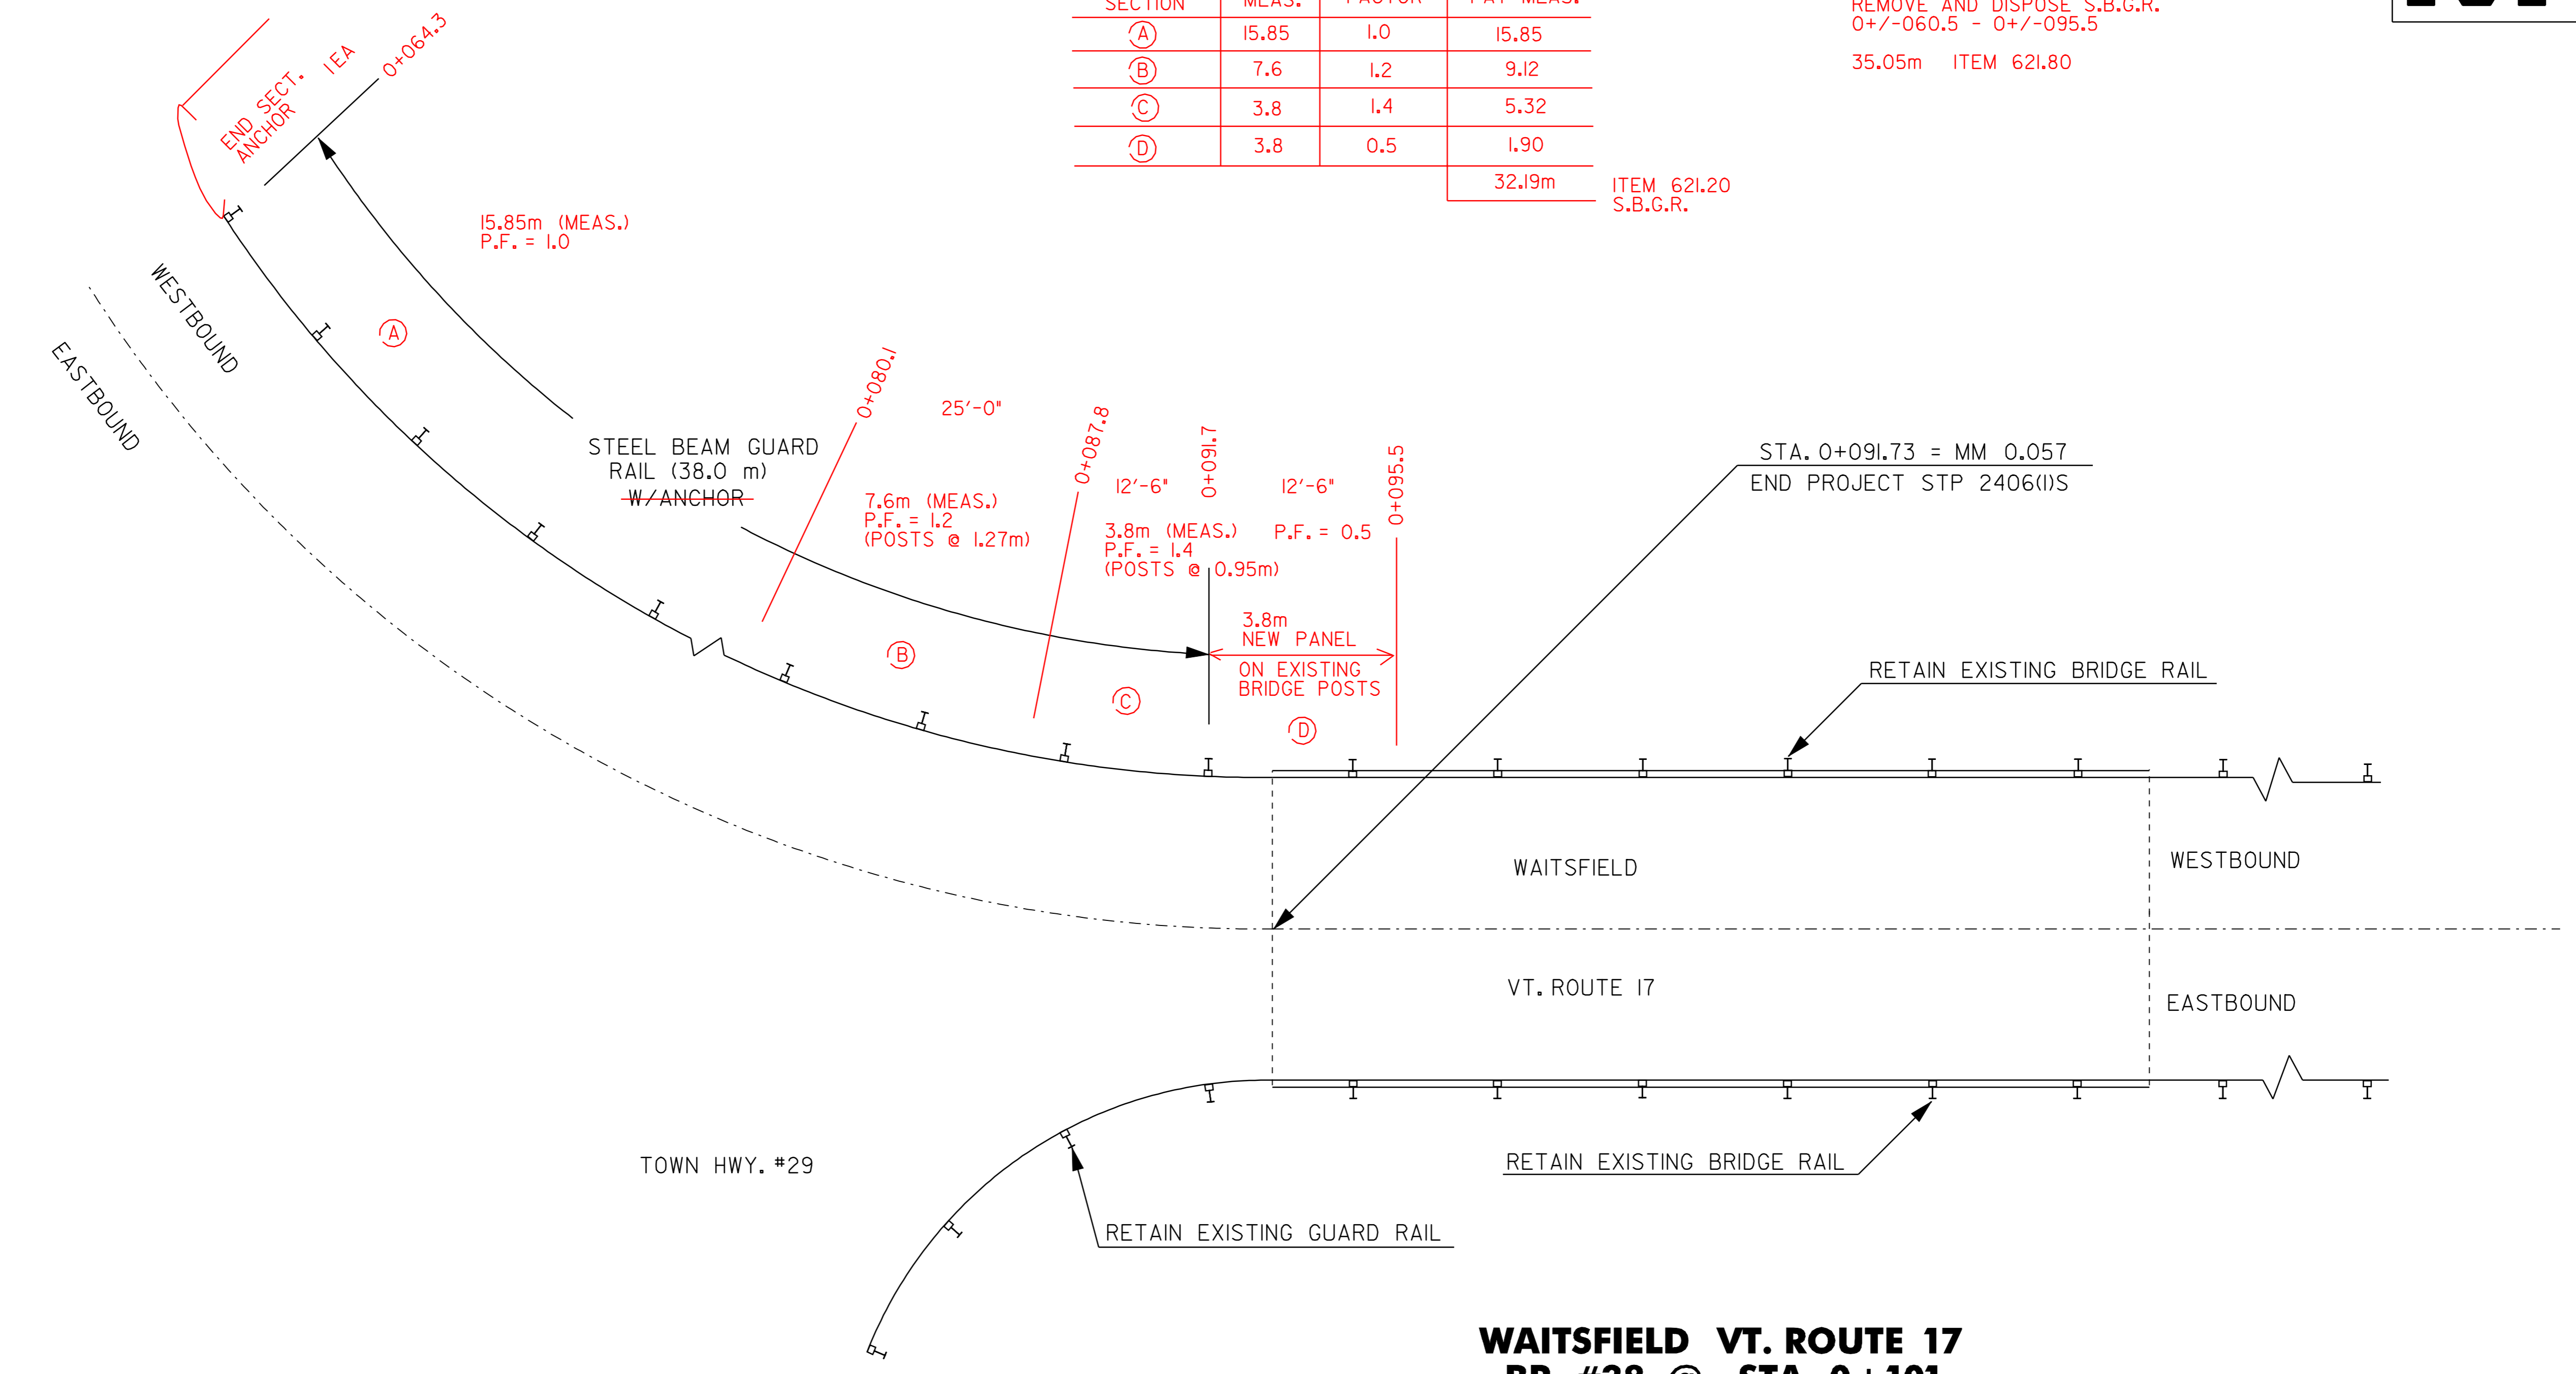

**WAITSFIELD VT. ROUTE 17  
BR #38 @ STA 0+101  
(MM 0.063)**


NOT TO SCALE

I. BRIDGE 38 REPAIRS AND PAVING ARE NOT INCLUDED WITH THIS PROJECT.

NOTE: ALL DIMENSIONS IN MILLIMETERS EXCEPT AS INDICATED


DATUM	_____
VERTICAL	_____
HORIZONTAL	_____

<b>BRIDGE DETAIL SHEET #4</b>	PROJECT :	FAYSTON - WAITSFIELD	PROJECT NO. :	STP 2406(I) S
	DESIGN FILE NAME:	pave/00b058/00b058.dgn	PLOT DATE:	23-MAY-2008
	IPARM FILE NAME:	00b058br4.i	SURVEY DATE:	7/05
	SURVEYED BY:	LFW	DRAWN BY:	7/05
	SQUAD LEADER:	LFW	SHEET:	22 OF 54

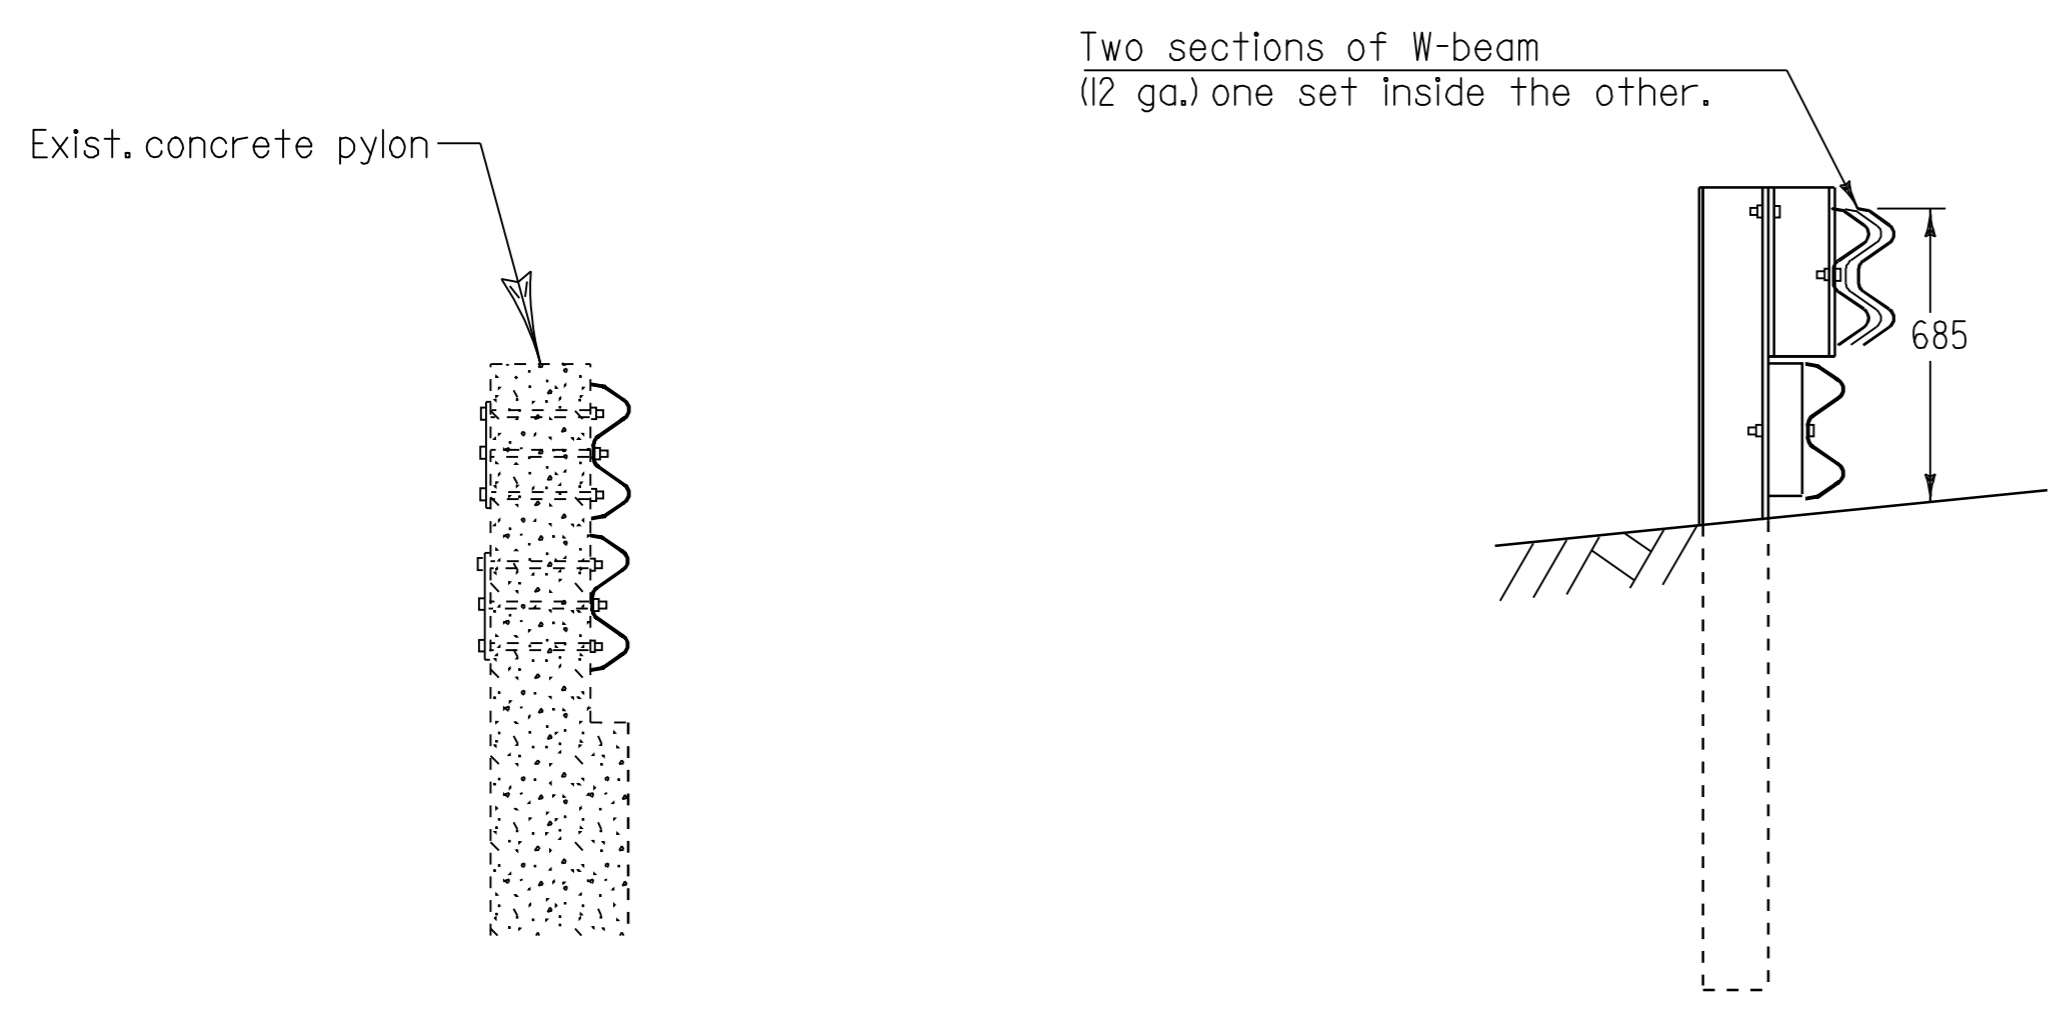


**SECTION A-A**

**SECTION B-B**

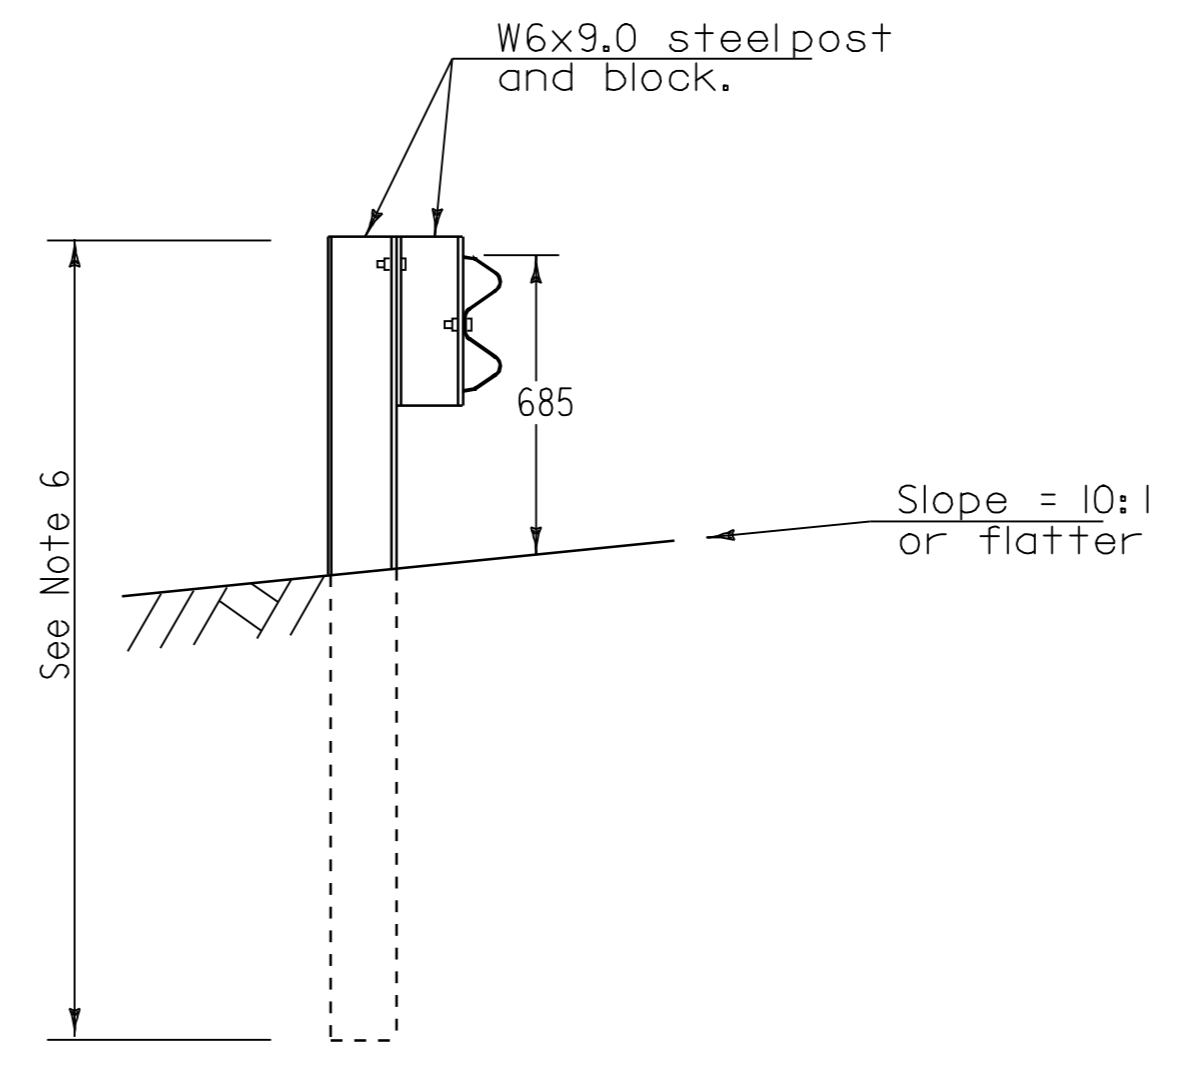

**SECTION C-C**


1. This guardrail transition is for connection to a vertical concrete bridge rail and should not be connected directly to a concrete safety shape.
2. Bottom beam blocks are offset drilled to sit squarely on the post flange. Blocks are attached with 15 mm carriage bolts.
3. The rubrail may be shop bent in the last 1 meter to facilitate installation.
4. Posts 1,2,3,4 and 6 require an additional hole to attach lower blocks and or lower beam.
5. At post 7, back-up plate bolted to block only.
6. Posts will be either 1.8 meters or 2.4 meters steel posts, as directed by the Resident Engineer.

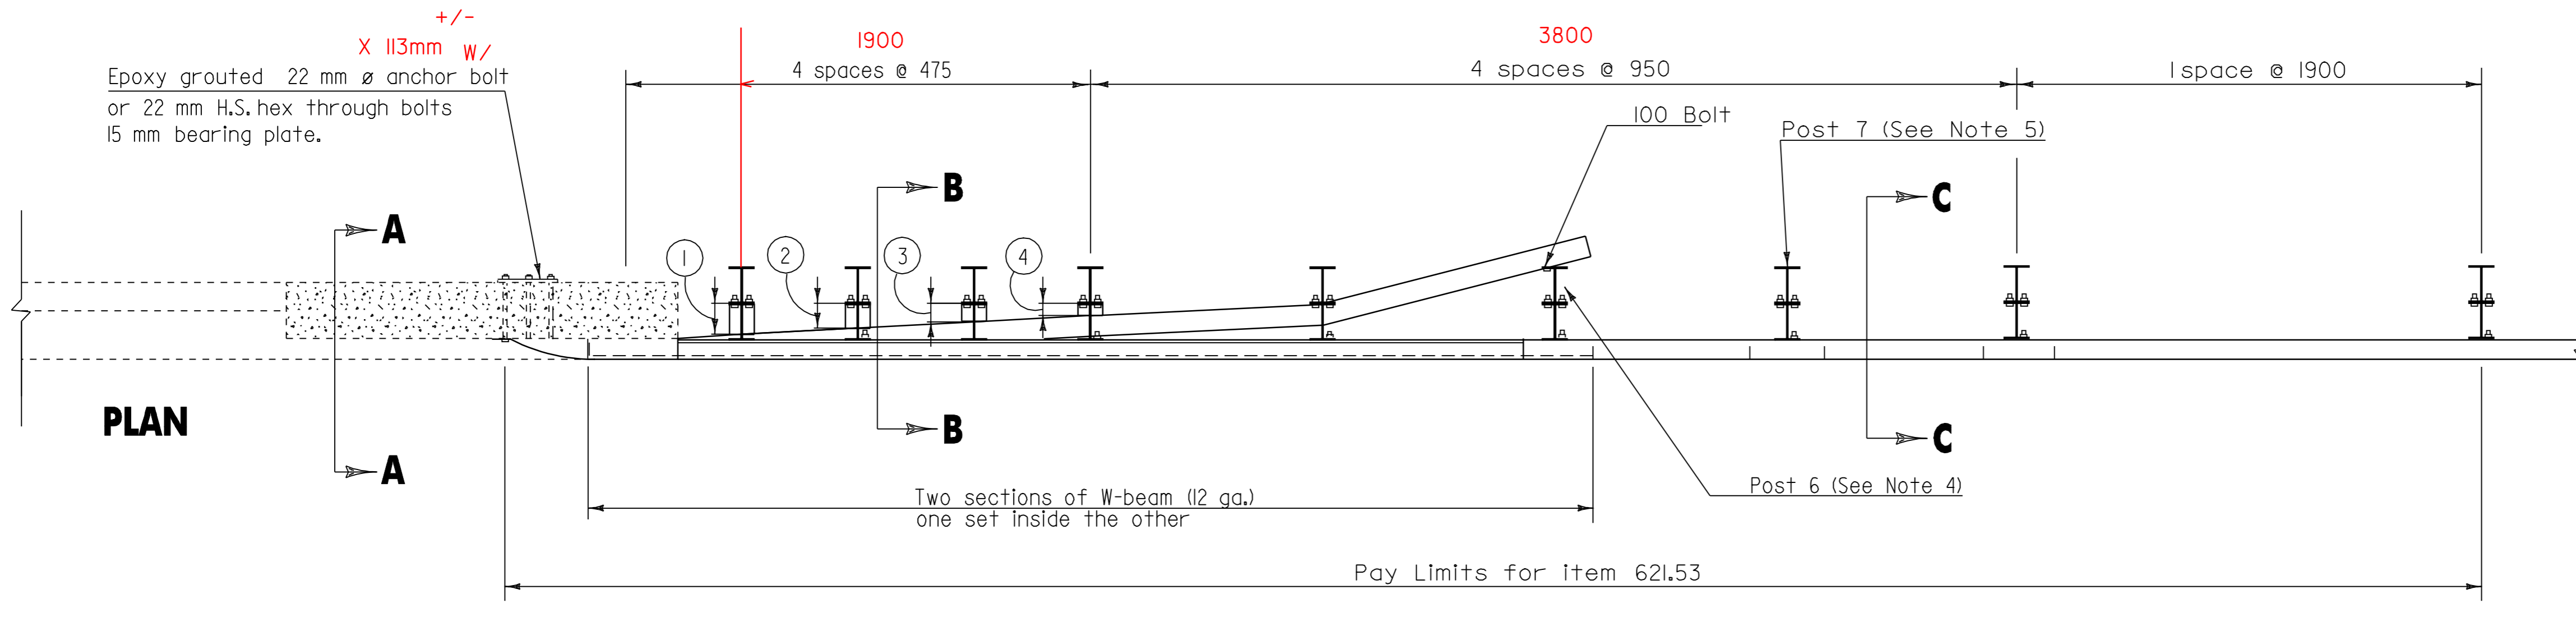

**PLAN**

**BOTTOM BEAM WOOD BLOCKS 310 mm X 115 mm**

POST#	THICKNESS (mm)
①	125
②	100
③	75
④	50

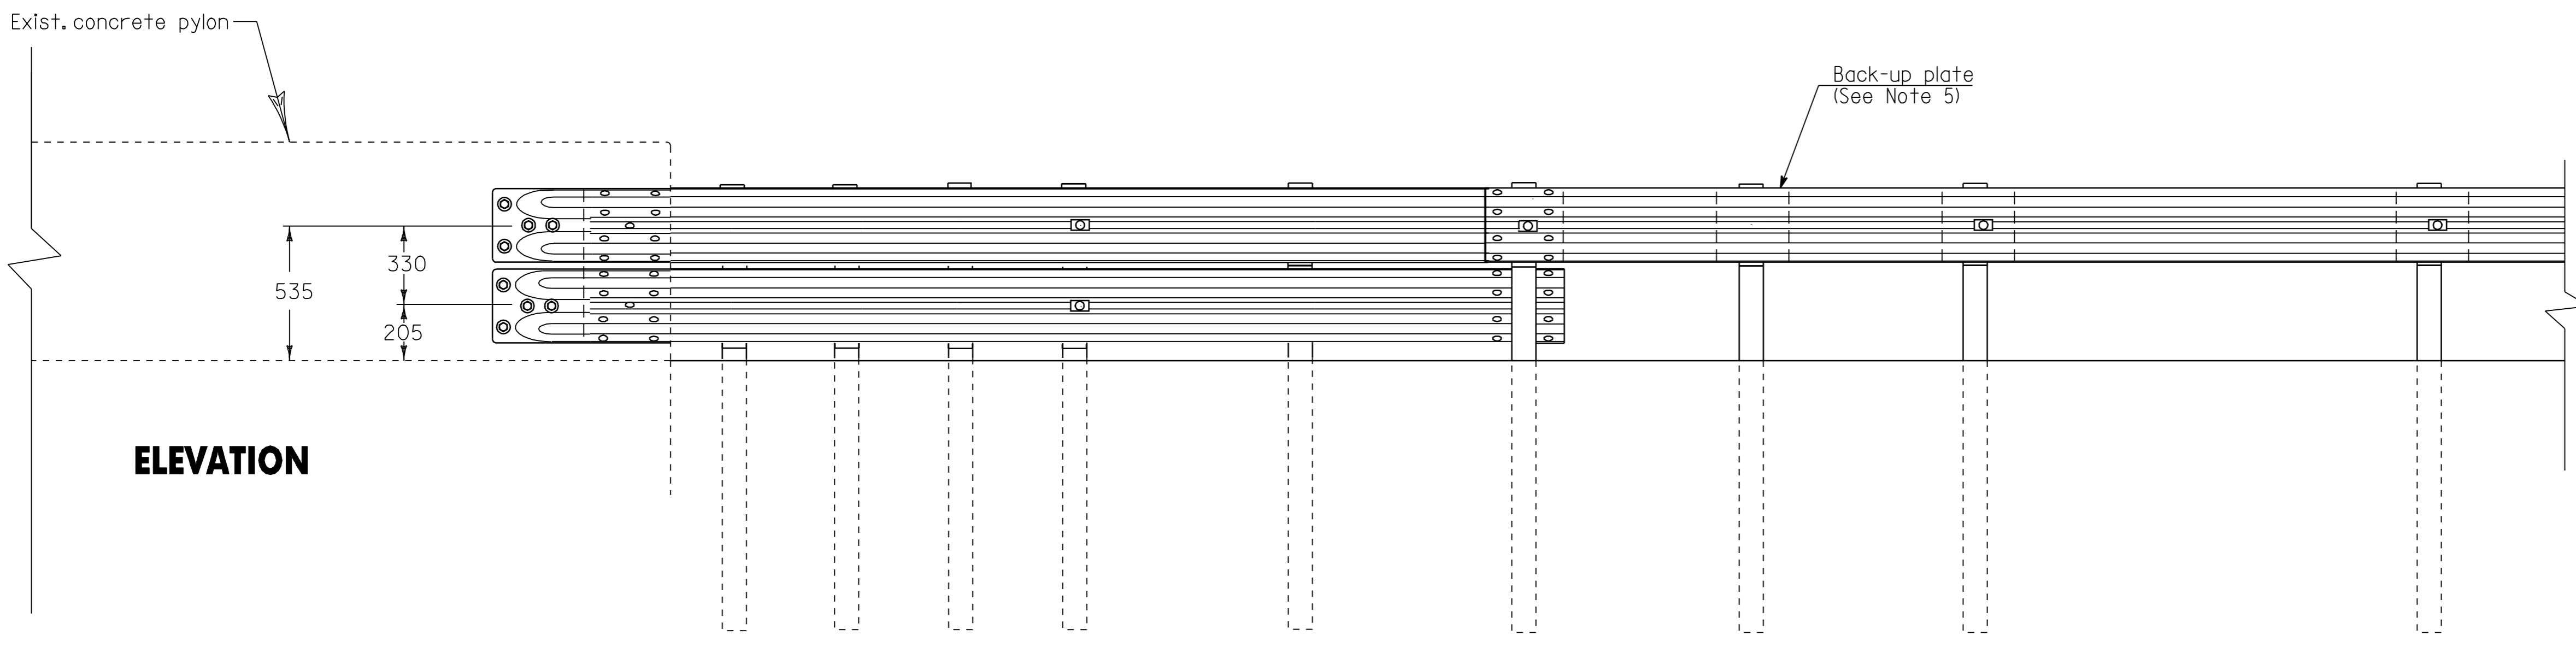



**ELEVATION**

Not To Scale

NOTE: ALL DIMENSIONS IN MILLIMETERS EXCEPT AS INDICATED


DATUM	_____
VERTICAL	_____
HORIZONTAL	_____

<b>TERMINAL CONNECTOR FOR STEEL BEAM G.R. W/STEEL POSTS</b>	PROJECT : <u>FAYSTON - WAITSFIELD</u>	PROJECT NO. : <u>STP_2406(1) S</u>
	DESIGN FILE NAME: <u>pave/00b058/00b058.dgn</u>	
	IPARM FILE NAME: <u>00b058br5.i</u>	PLOT DATE: <u>23-MAY-2008 1</u>
	SURVEYED BY: <u>LFW</u>	SURVEY DATE: <u>7/05</u>
	SQUAD LEADER: <u>LFW</u>	DRAWN BY: <u>7/05</u>
		SHEET: <u>23</u> OF <u>54</u>

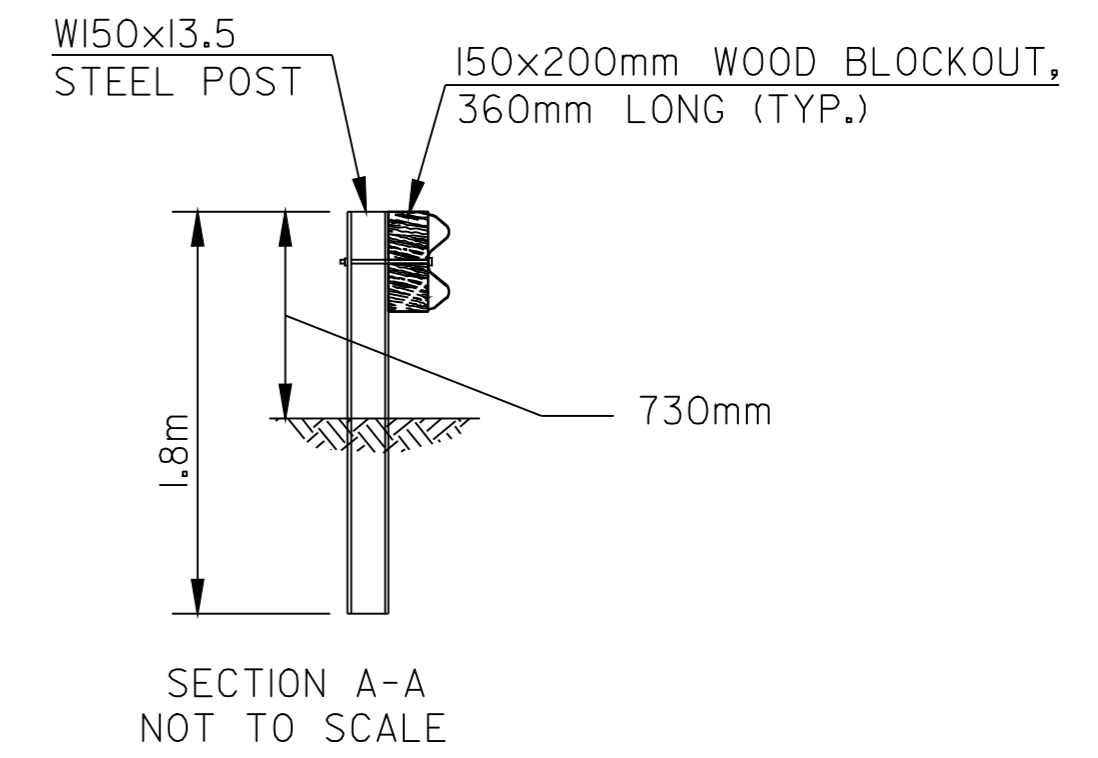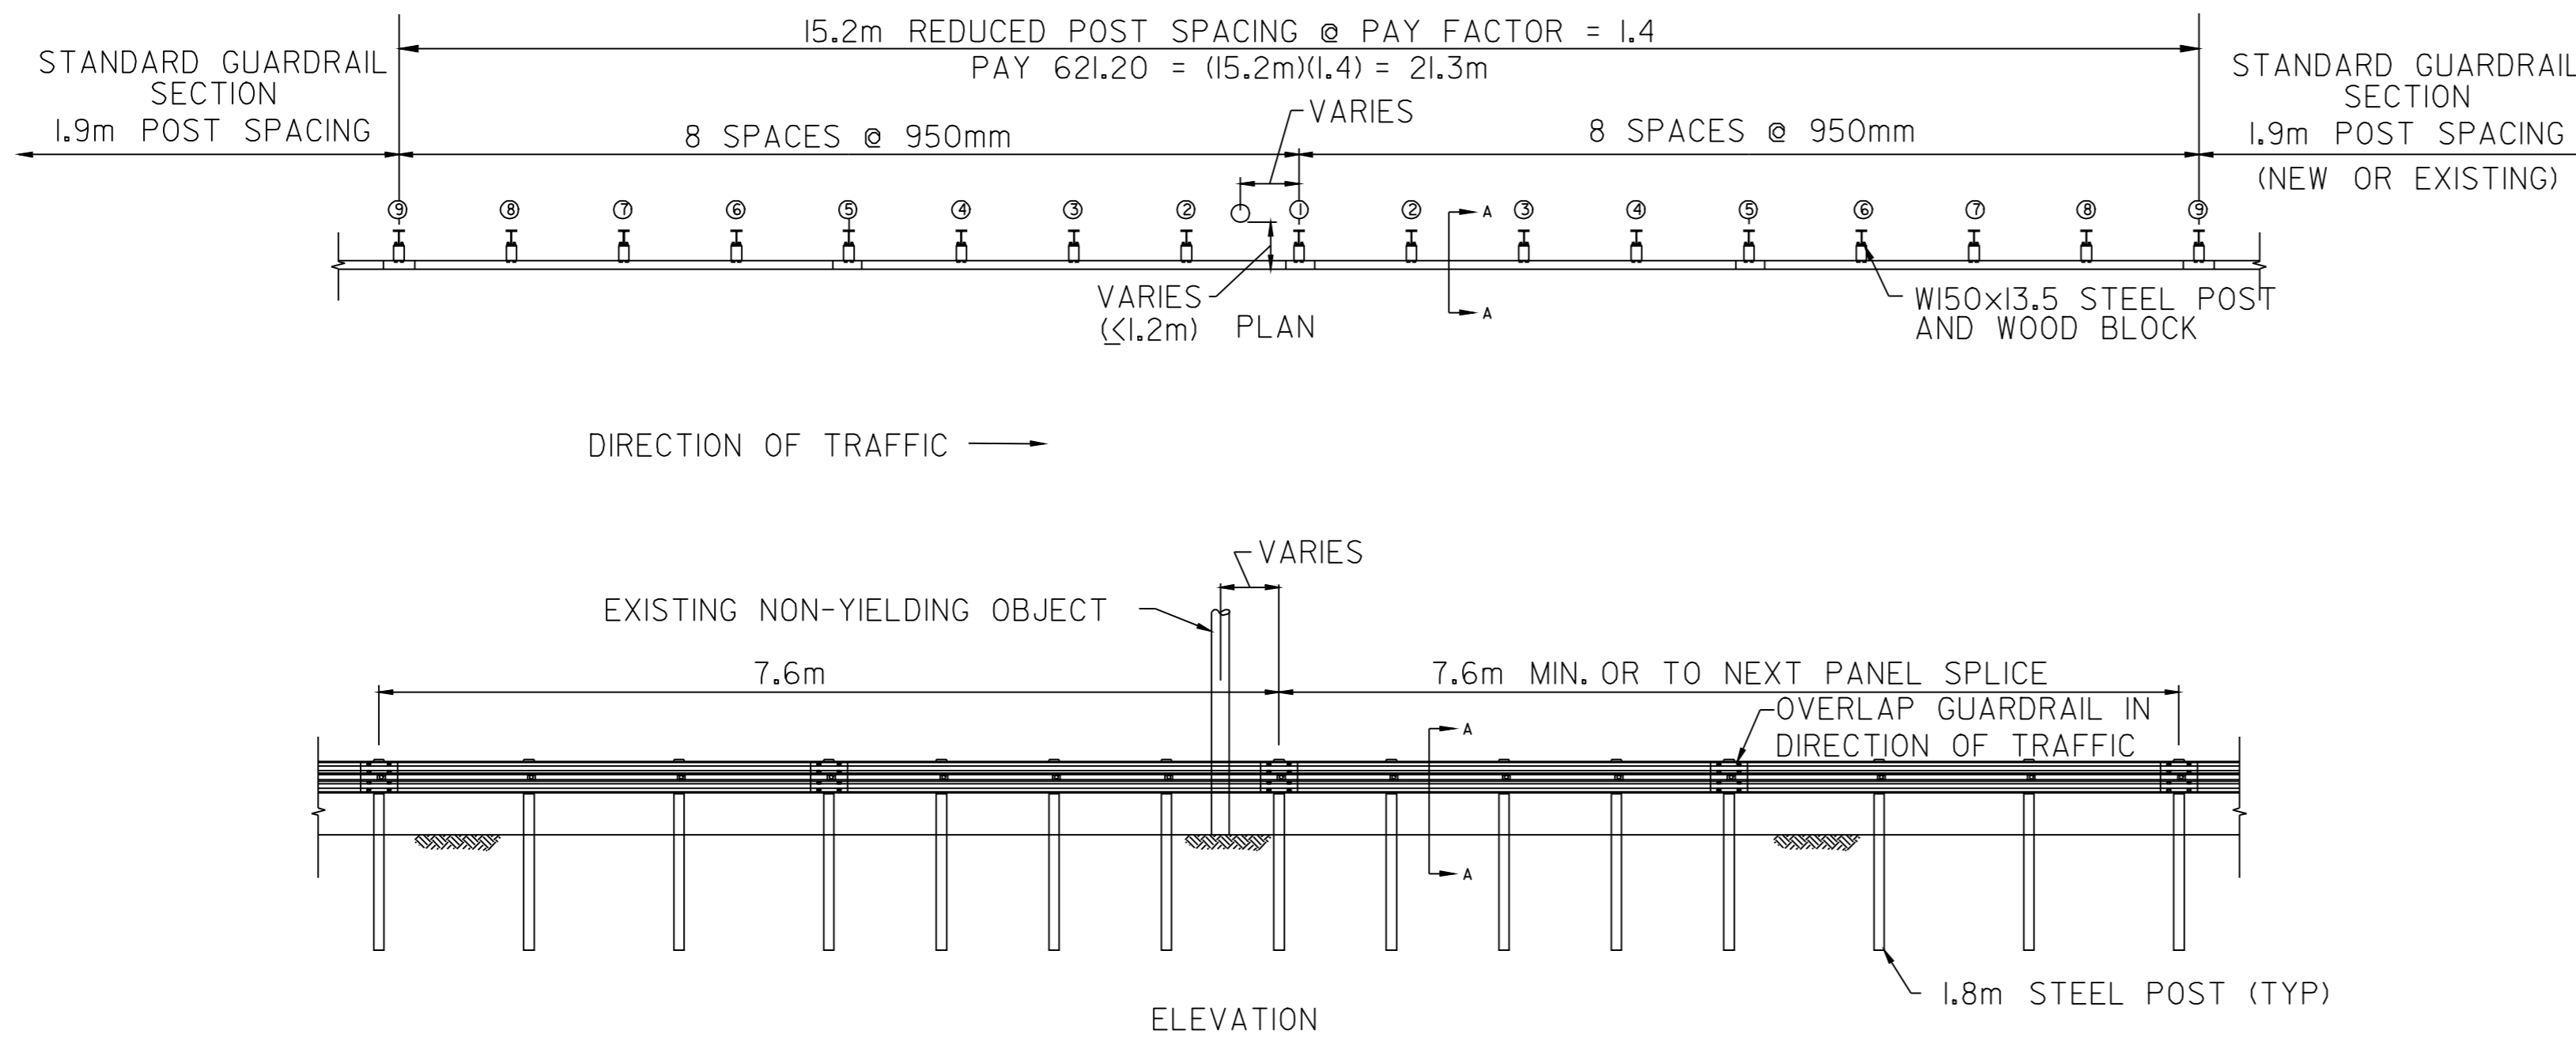

**NON-YIELDING OBJECT APPROACH DETAIL**

**FAYSTON  
STA 8+199 LT  
NOT TO SCALE**

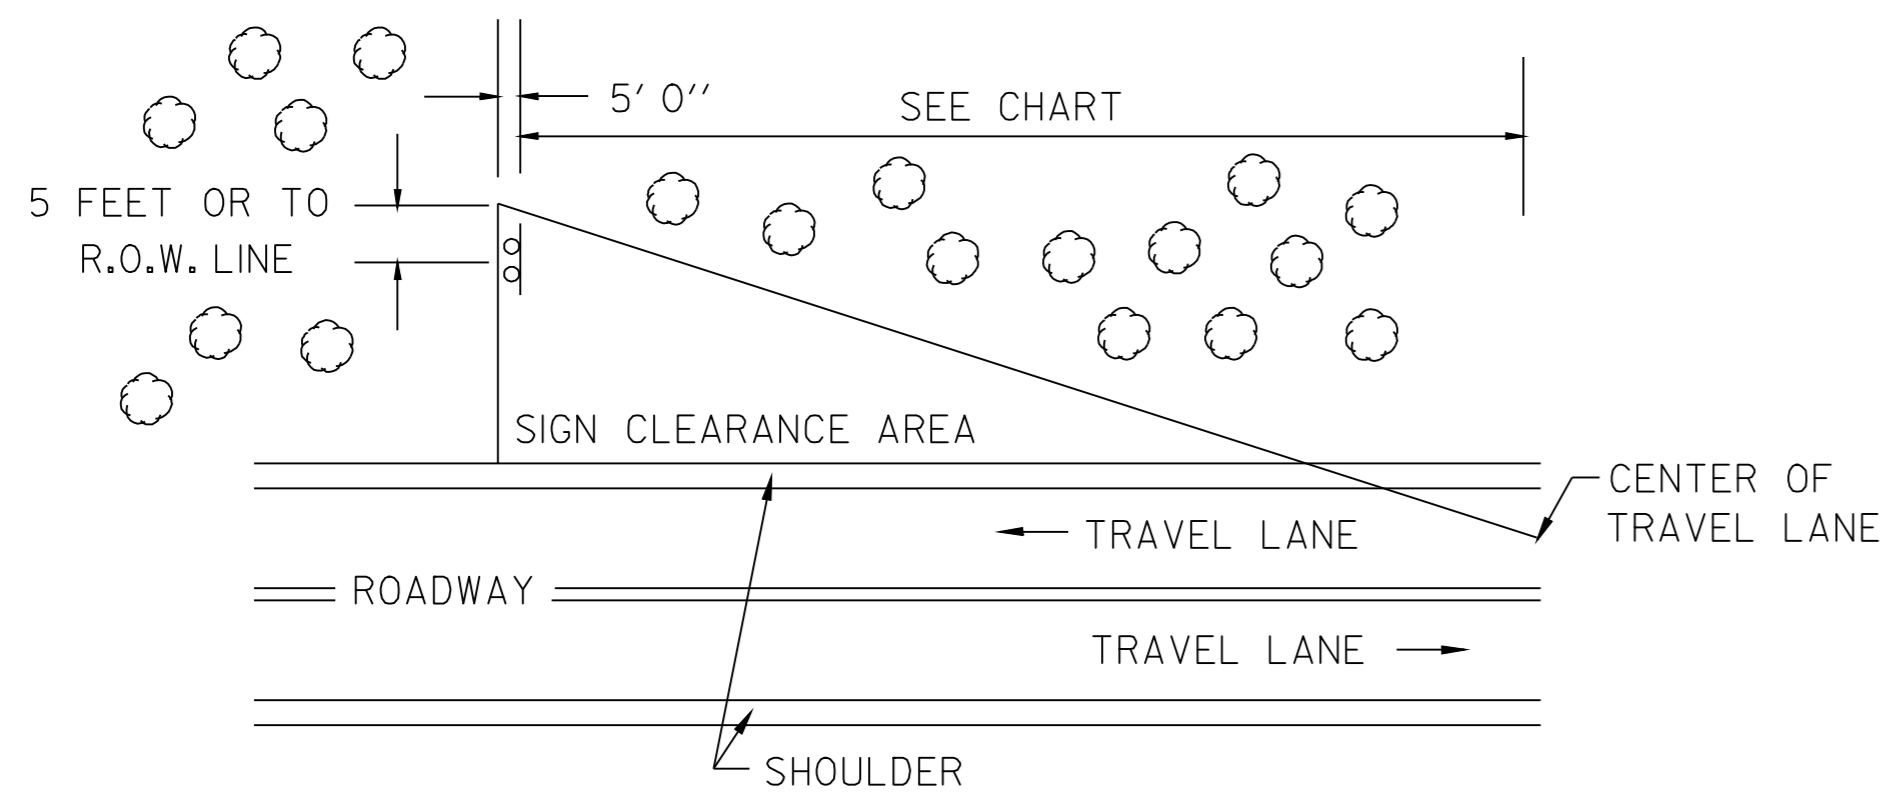

MINIMUM SIGN SIGHT DISTANCE CHART

APPROACH SPEED (mph)	SIGHT DISTANCE	
	(meters)	(feet)
30 OR LESS	90	300
35	105	350
40	120	400
45	135	450
50	150	500
55	165	550

THE CONTRACTOR SHALL REMOVE ALL WOODY STEMMED GROWTH INCLUDING BRUSH, SAPLINGS TREE LIMBS GROWING WITHIN OR PROJECTING INTO THE CLEARANCE AREA AND DOWN TO GROUND LEVEL. PAYMENT WILL BE FOR THINNING AND TRIMMING (FOR SIGNS) ITEM 201.31, AND PAID FOR PER EACH. (NO CHEMICALS, POISONS, OR DEFOLIANTS ALLOWED).

**CLEARING LIMITS FOR SIGNS ON CONVENTIONAL ROADS**

**NOT TO SCALE**


**MISCELLANEOUS DETAIL SHEET  
(CLEARING LIMITS FOR SIGNS)  
(GUARD RAIL AT NON-YIELDING OBJECT DETAILS)**

DESIGNED BY     LFW     DATE     7/05      
 DRAWN BY     LFW     DATE     7/05      
 DESIGN FILE NO.     /pave/00b058/00b058.dgn      
 PRF FILE     00b058gr1.i     DATE PLOTTED     23-MAY-2008      
 PROJ. NAME: **FAYSTON - WAITSFIELD**  
 PROJ. NO.: **STP 2406(1)S**  
 SHEET **24** OF **54** SHEETS

DATUM  
 VERTICAL     N/A      
 HORIZONTAL     N/A

**NOTES**

- THE PAVEMENT WEARING COURSE SHALL BE TYPE IIIS. THE PAVEMENT BASE COURSE SHALL BE TYPE IS. AN ESTIMATED QUANTITY OF LEVELING (TYPE IVS) HAS ALSO BEEN INCLUDED FOR THE RECLAIMED SEGMENTS OF THE PROJECT TO ELIMINATE ANY IRREGULARITIES PRIOR TO PLACEMENT OF THE WEARING COURSE. A 15mm LIFT HAS BEEN INCLUDED FOR AN ESTIMATED 25% OF THE RECLAIMED SURFACE AREA. ALL ASPHALT CEMENT USED IN THE BITUMINOUS PAVEMENT SHALL BE PG 58-34.
- EMULSIFIED ASPHALT SHALL BE APPLIED ON EXISTING PAVEMENT SURFACES, (NOT INCLUDING RECLAIMING SURFACES) BETWEEN ALL COURSES OF PAVEMENT AND ON COLD PLANED SURFACES AT THE RATE OF 0.12 L/SM, OR AS DIRECTED BY THE RESIDENT ENGINEER.
- BITUMINOUS CONCRETE PAVEMENT TOLERANCE = +/- 5 mm (TOTAL THICKNESS EXCLUDING LEVELING).
- PRIOR TO RECLAIMING, ANY EXISTING SHOULDER MATERIAL DEEMED UNSUITABLE BY THE RESIDENT ENGINEER WILL BE EXCAVATED TO A DEPTH OF 75 mm +/- OR AS DIRECTED BY THE RESIDENT ENGINEER. EXCAVATED MATERIAL WILL BE SPREAD ON THE ADJACENT SLOPES OR REMOVED FROM THE PROJECT, AS DIRECTED BY THE RESIDENT ENGINEER. THIS WORK WILL BE PAID UNDER THE APPROPRIATE RENTAL ITEMS SUCH AS ALL PURPOSE EXCAVATOR RENTAL TYPE I, GRADER RENTAL, TRUCK RENTAL AND POWER BROOM RENTAL. THE METHOD OF REMOVAL AND THE USE OF RENTAL ITEMS SHALL BE APPROVED BY THE RESIDENT ENGINEER PRIOR TO ANY WORK BEING DONE. MATERIAL BEING REMOVED SHALL BE REPLACED WITH SUBBASE OF CRUSHED GRAVEL (FINE GRADED) (MOD.). AN ADDITIONAL QUANTITY OF SUBBASE OF CRUSHED GRAVEL (FINE GRADED) (MOD.) HAS BEEN INCLUDED TO CORRECT SUPERELEVATION AND GRADATION DEFICIENCIES WITHIN THE RECLAIMED SECTIONS. AN ESTIMATED THICKNESS OF 50mm HAS BEEN INCLUDED FOR THE ENTIRE RECLAIMED SURFACE AREA.
- ONE METER OF BACKING IS REQUIRED BEHIND THE FACE OF BOX BEAM GUARDRAIL WITH 1.6 m POSTS. IF THIS CAN NOT BE OBTAINED THEN 2.1m POSTS SHALL BE USED.
- ALL EDGES OF PAVEMENT AND TREATED TIMBER CURB SHALL BE BACKED UP FULL HEIGHT WITH COLD PLANE GRINDINGS AS DIRECTED BY THE RESIDENT ENGINEER AND WILL BE PAID FOR UNDER ITEM 402.12, AGGREGATE SHOULDERS (MOD.).
- PIPE INLET AND OUTLET AREAS, AND GENERAL DITCH CLEANING SHALL BE PERFORMED AT THE LOCATIONS INDICATED ON THE DITCH CLEANING DETAIL SHEET AND AS DIRECTED BY THE RESIDENT ENGINEER. PAYMENT WILL BE MADE UNDER THE APPLICABLE EQUIPMENT RENTALS ITEM(S).
- ALL DRIVES SHALL RECEIVE A PAVED APRON AS DIRECTED BY THE RESIDENT ENGINEER. ANY REQUIRED EXCAVATION IN DRIVE AREAS SHALL BE AS DIRECTED AND WILL BE PAID UNDER THE APPLICABLE RENTAL ITEMS. IF REQUIRED, A NEW DRIVEWAY SUBBASE SHALL BE CONSTRUCTED AND WILL BE PAID UNDER ITEM 301.28, SUBBASE OF CRUSHED GRAVEL (FINE GRADED) (MOD.). A NEW BITUMINOUS SURFACE SHALL BE CONSTRUCTED AS DIRECTED AND WILL BE PAID FOR UNDER ITEM 490.30. QUANTITIES OF THE ABOVE ITEMS HAVE BEEN INCLUDED TO PAY FOR THIS WORK.
- ESTIMATED QUANTITIES OF ITEM 608.25, EXCAVATOR RENTAL, TYPE I AND 608.37, TRUCK RENTAL HAVE BEEN INCLUDED FOR THE PROVISION OF CONSTRUCTING GUARDRAIL FLARES WITH EARTH BORROW. THE GUARDRAIL FLARES SHALL BE CAPPED WITH AN ESTIMATED 75mm DEPTH OF AGGREGATE SHOULDERS (MOD.) UNLESS OTHERWISE DIRECTED BY THE RESIDENT ENGINEER. THE QUANTITIES INCLUDED REFLECT 20m<sup>3</sup> OF EARTH BORROW AND 5 TONS OF AGGREGATE SHOULDERS (MOD) FOR EACH GUARD RAIL TERMINAL.
- ITEM 616.47, BITUMINOUS CONCRETE GUTTERS AND TRAFFIC ISLANDS WILL BE PAID ONLY WHERE SPECIFIED IN THE PLANS. ALL OTHER BITUMINOUS CONCRETE PAVEMENT WORK, WHICH COULD INVOLVE SOME HAND-WORK (SUCH AS DRIVE AND SIDE ROAD APPROACHES AND AROUND DRAINAGE/UTILITY STRUCTURES), SHALL BE PAID FOR AT THE CONTRACT UNIT PRICE FOR ITEM 490.30, SUPERPAVE BITUMINOUS CONCRETE PAVEMENT.
- COMPACTION, GRADING, AND CLEAN UP OF ITEM 301.28, SUBBASE OF CRUSHED GRAVEL (FINE GRADED) (MOD), ITEM 402.12, AGGREGATE SHOULDERS (MOD), AND ITEM 651.35, TOPSOIL IS TO BE INCLUDED IN THE CONTRACT UNIT PRICE OF EACH ITEM.
- STABILIZING AGENT FOR THE RECLAIMED STABILIZED BASE WILL BE WATER. PAYMENT SHALL BE CONSIDERED INCIDENTAL TO ITEM 310.20.

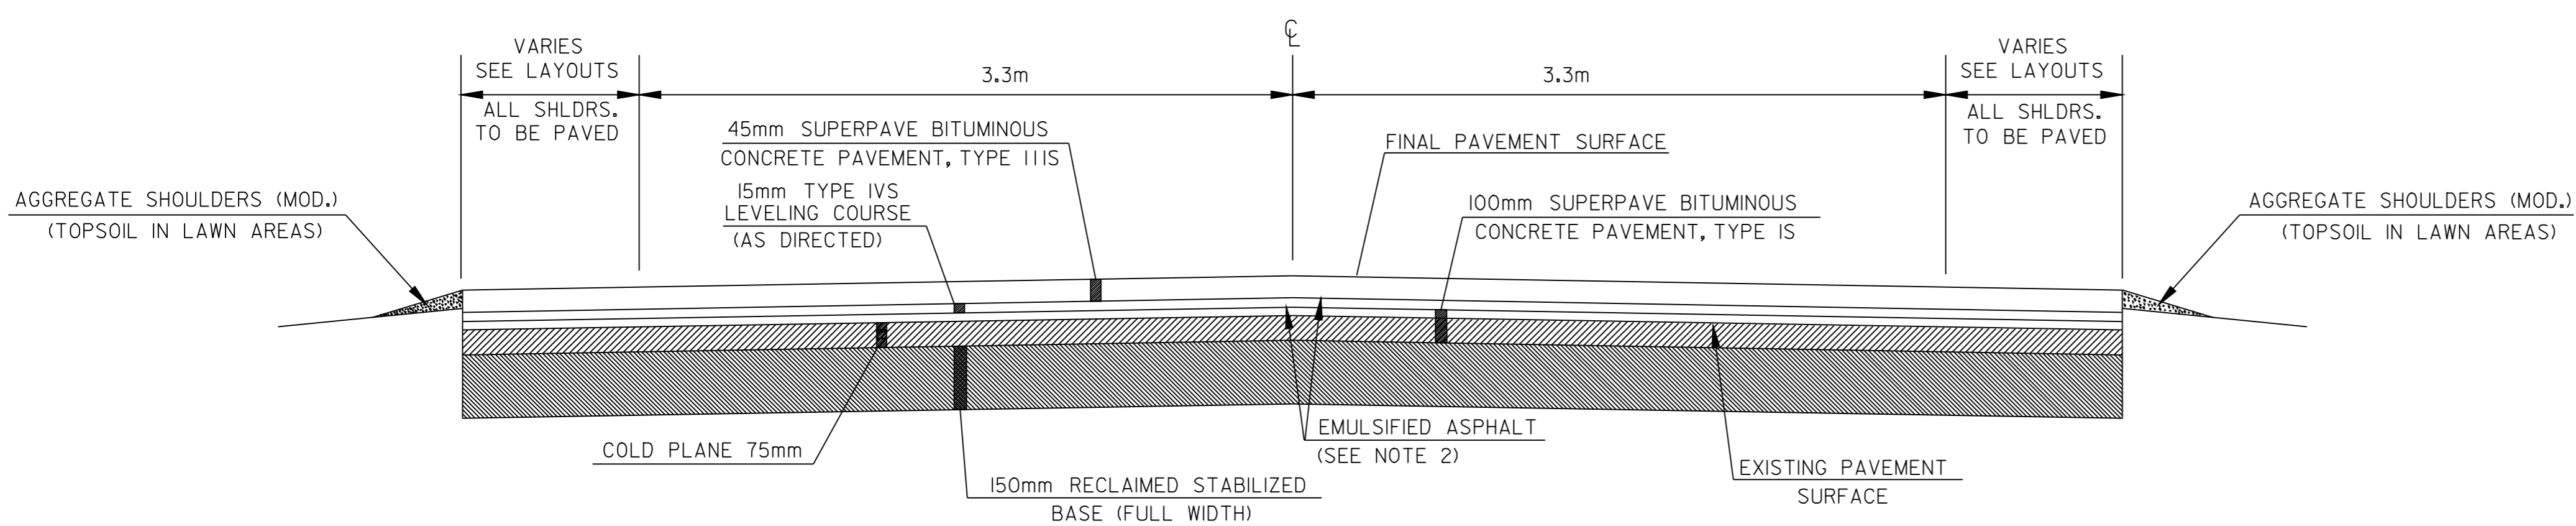

**RECLAIMED STABILIZED BASE TYPICAL SECTION**


**WAITSFIELD**

**STA 6+671.00 TO 10+245.00**

**STA 11+185.00 TO 12+198.40**

**MORETOWN**

**STA 0+000.00 TO 0+760.00**

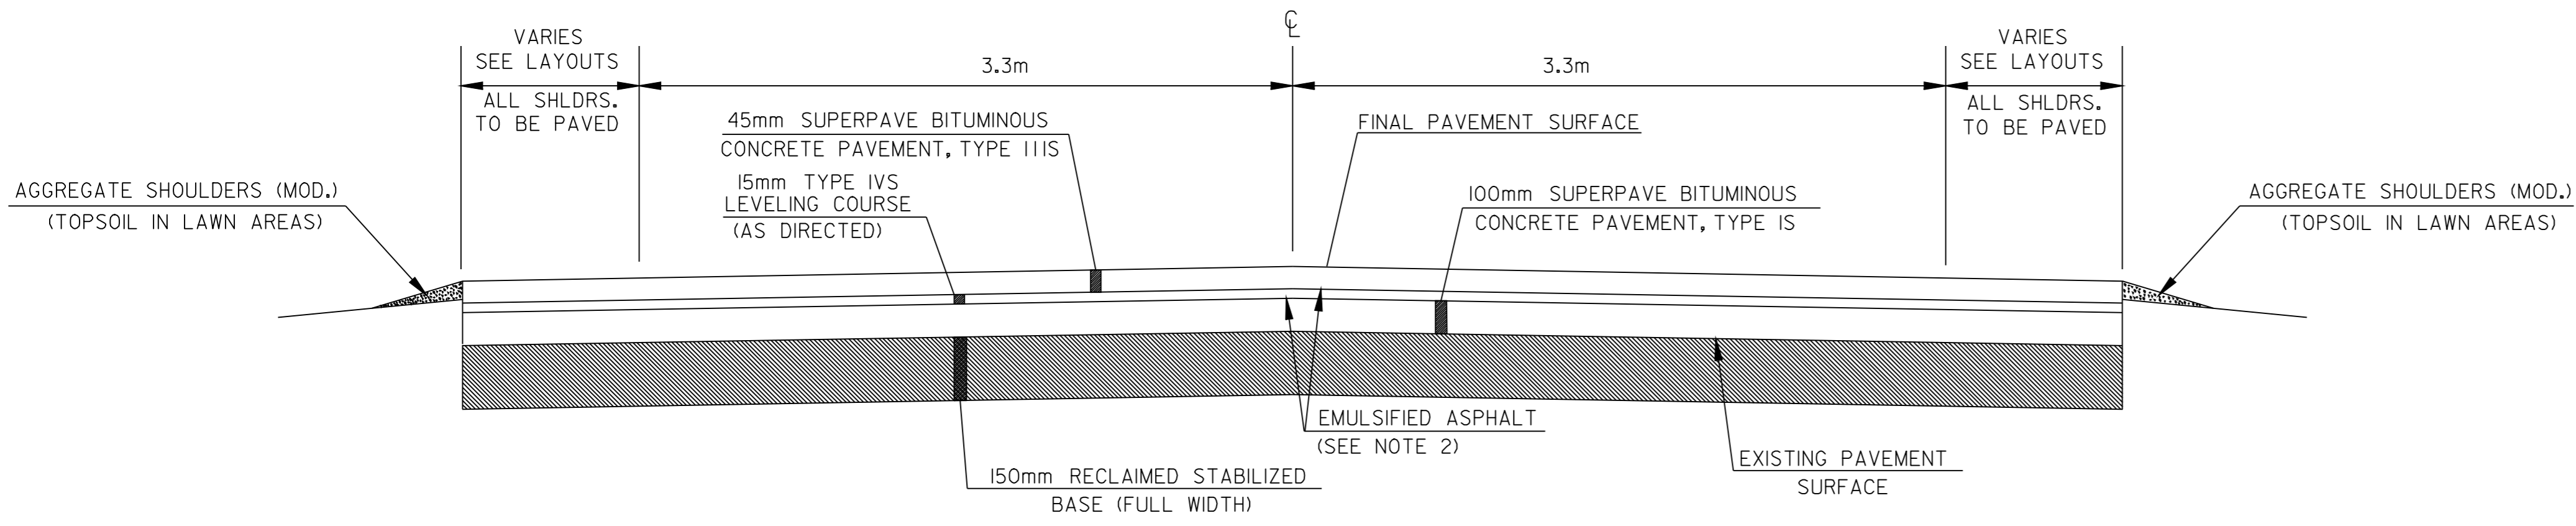

**RECLAIMED STABILIZED BASE TYPICAL SECTION**

**WAITSFIELD**

**STA 10+245.00 TO 11+185.00**

**PROJECT PAVING LIMITS  
(REFER TO TRANSITION DETAILS ON SHEET 26)**


TOWN & ROUTE	BEGIN STATION	END STATION	LANE TYPICAL (SEE LAYOUTS)	WEARING DEPTH	LEVELING Tons	NOTES
WAITSFIELD - VT. ROUTE 100	6+671	7+876	VARIES - 3.3m - 3.3m - VARIES	45mm	99	COLD PLANE 75mm, RECLAIM 150mm, 100mm TYPE IS, LEVEL (IF NECESSARY) & PAVE w/45mm TYPE IIIS.
WAITSFIELD - VT. ROUTE 100	7+876	7+926	VARIES - 3.3m - 3.3m - VARIES	30mm	30	BRIDGE 181 - COLD PLANE 30mm & PAVE w/30mm TYPE IVS.
WAITSFIELD - VT. ROUTE 100	7+926	10+245	VARIES - 3.3m - 3.3m - VARIES	45mm	170	COLD PLANE 75mm, RECLAIM 150mm, 100mm TYPE IS, LEVEL (IF NECESSARY) & PAVE w/45mm TYPE IIIS.
WAITSFIELD - VT. ROUTE 100	10+245	11+185	VARIES - 3.3m - 3.3m - VARIES	45mm	93	RECLAIM 150mm, 100mm TYPE IS, LEVEL (IF NECESSARY) & PAVE w/45mm TYPE IIIS.
WAITSFIELD - VT. ROUTE 100	11+185	11+466	VARIES - 3.3m - 3.3m - VARIES	45mm	23	COLD PLANE 75mm, RECLAIM 150mm, 100mm TYPE IS, LEVEL (IF NECESSARY) & PAVE w/45mm TYPE IIIS.
WAITSFIELD - VT. ROUTE 100	11+466	11+492	VARIES - 3.3m - 3.3m - VARIES	30mm	15	BRIDGE 186 - COLD PLANE 30mm & PAVE w/30mm TYPE IVS.
WAITSFIELD - VT. ROUTE 100	11+492	12+198.4	VARIES - 3.3m - 3.3m - VARIES	45mm	48	COLD PLANE 75mm, RECLAIM 150mm, 100mm TYPE IS, LEVEL (IF NECESSARY) & PAVE w/45mm TYPE IIIS.
MORETOWN - VT. ROUTE 100	0+000	0+760	VARIES - 3.3m - 3.3m - VARIES	45mm	54	COLD PLANE 75mm, RECLAIM 150mm, 100mm TYPE IS, LEVEL (IF NECESSARY) & PAVE w/45mm TYPE IIIS.

**NOT TO SCALE**

**PROJECT  
TYPICAL  
SHEET**


DRAWN BY LFW DATE 7-05  
 DESIGN FILE NO. /pave/00b058/00b058.dgn  
 PRF FILE 00b058+yp1.i DATE PLOTTED 23-MAY-2008  
 PROJ. NAME: **WAITSFIELD - MORETOWN**  
 PROJ. NO.: **STP 2227(1)S**  
 SHEET **25** OF **54** SHEETS



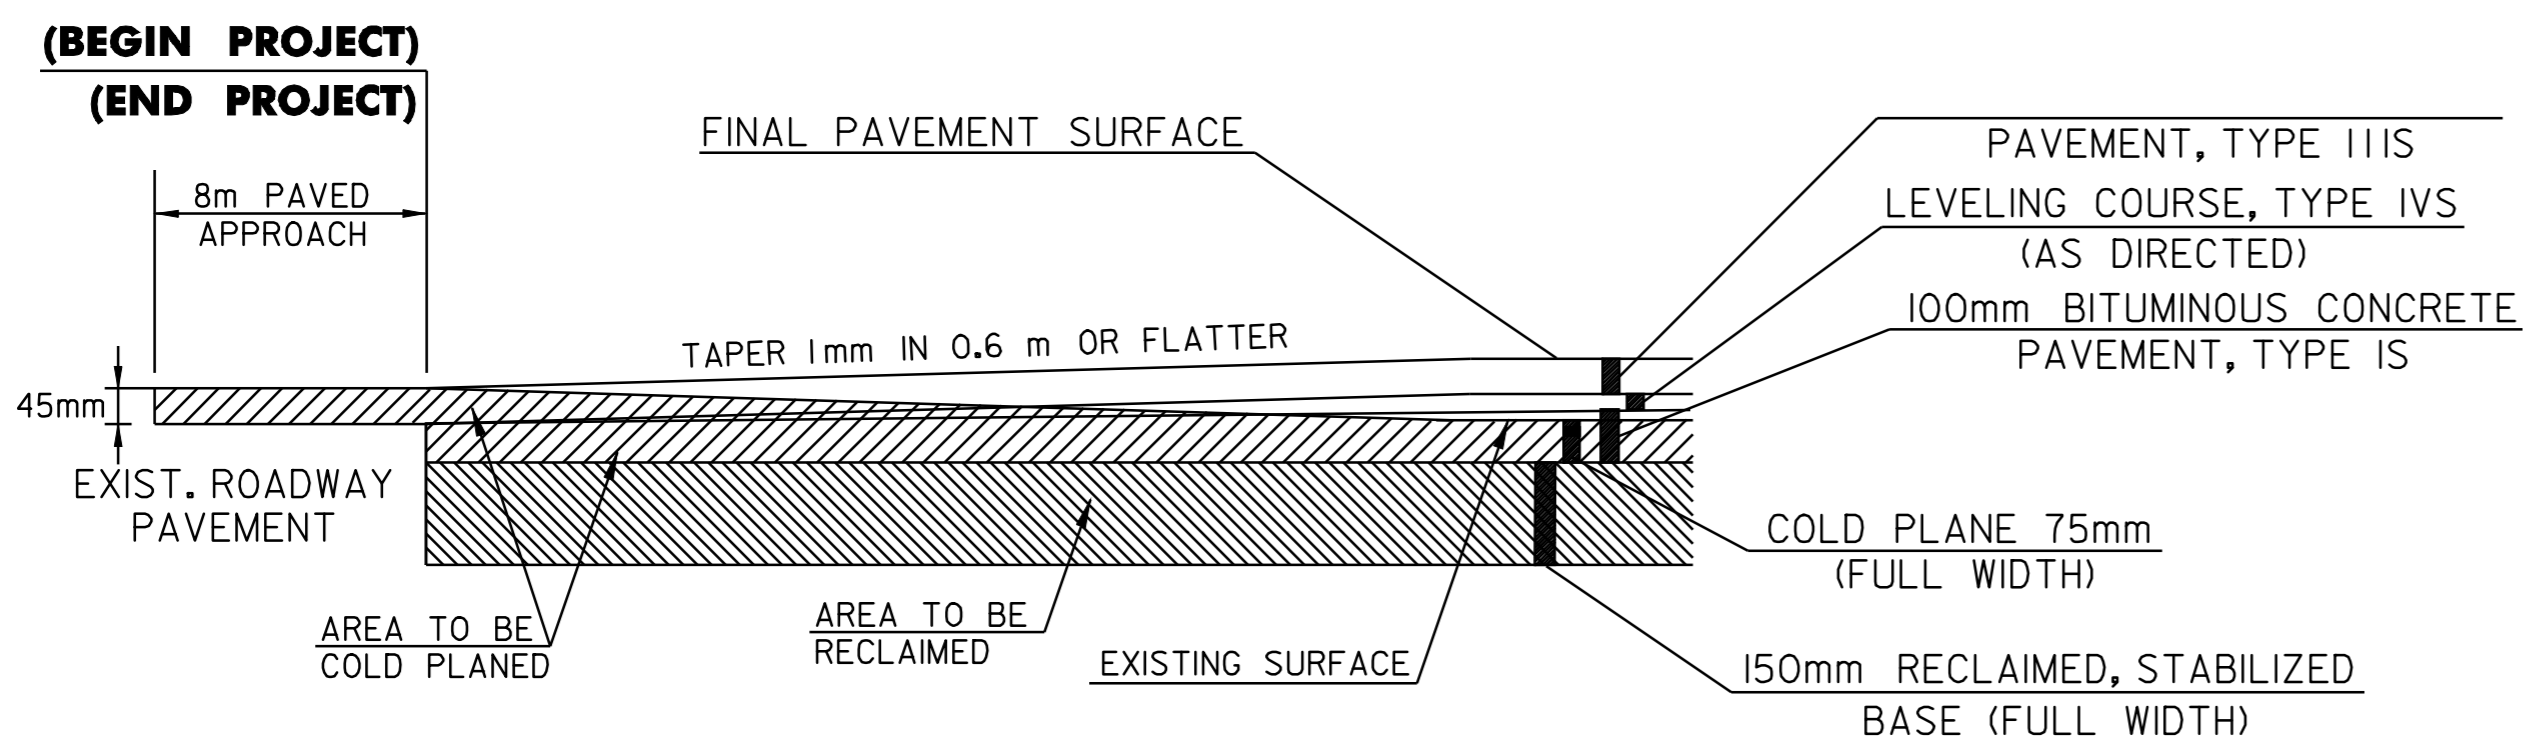

**- APPROACH AREA DETAIL -**


**WAITSFIELD**  
**STA 6+671.00 (BEGIN PROJECT)**  
**MORETOWN**  
**STA 0+760.00 (END PROJECT)**

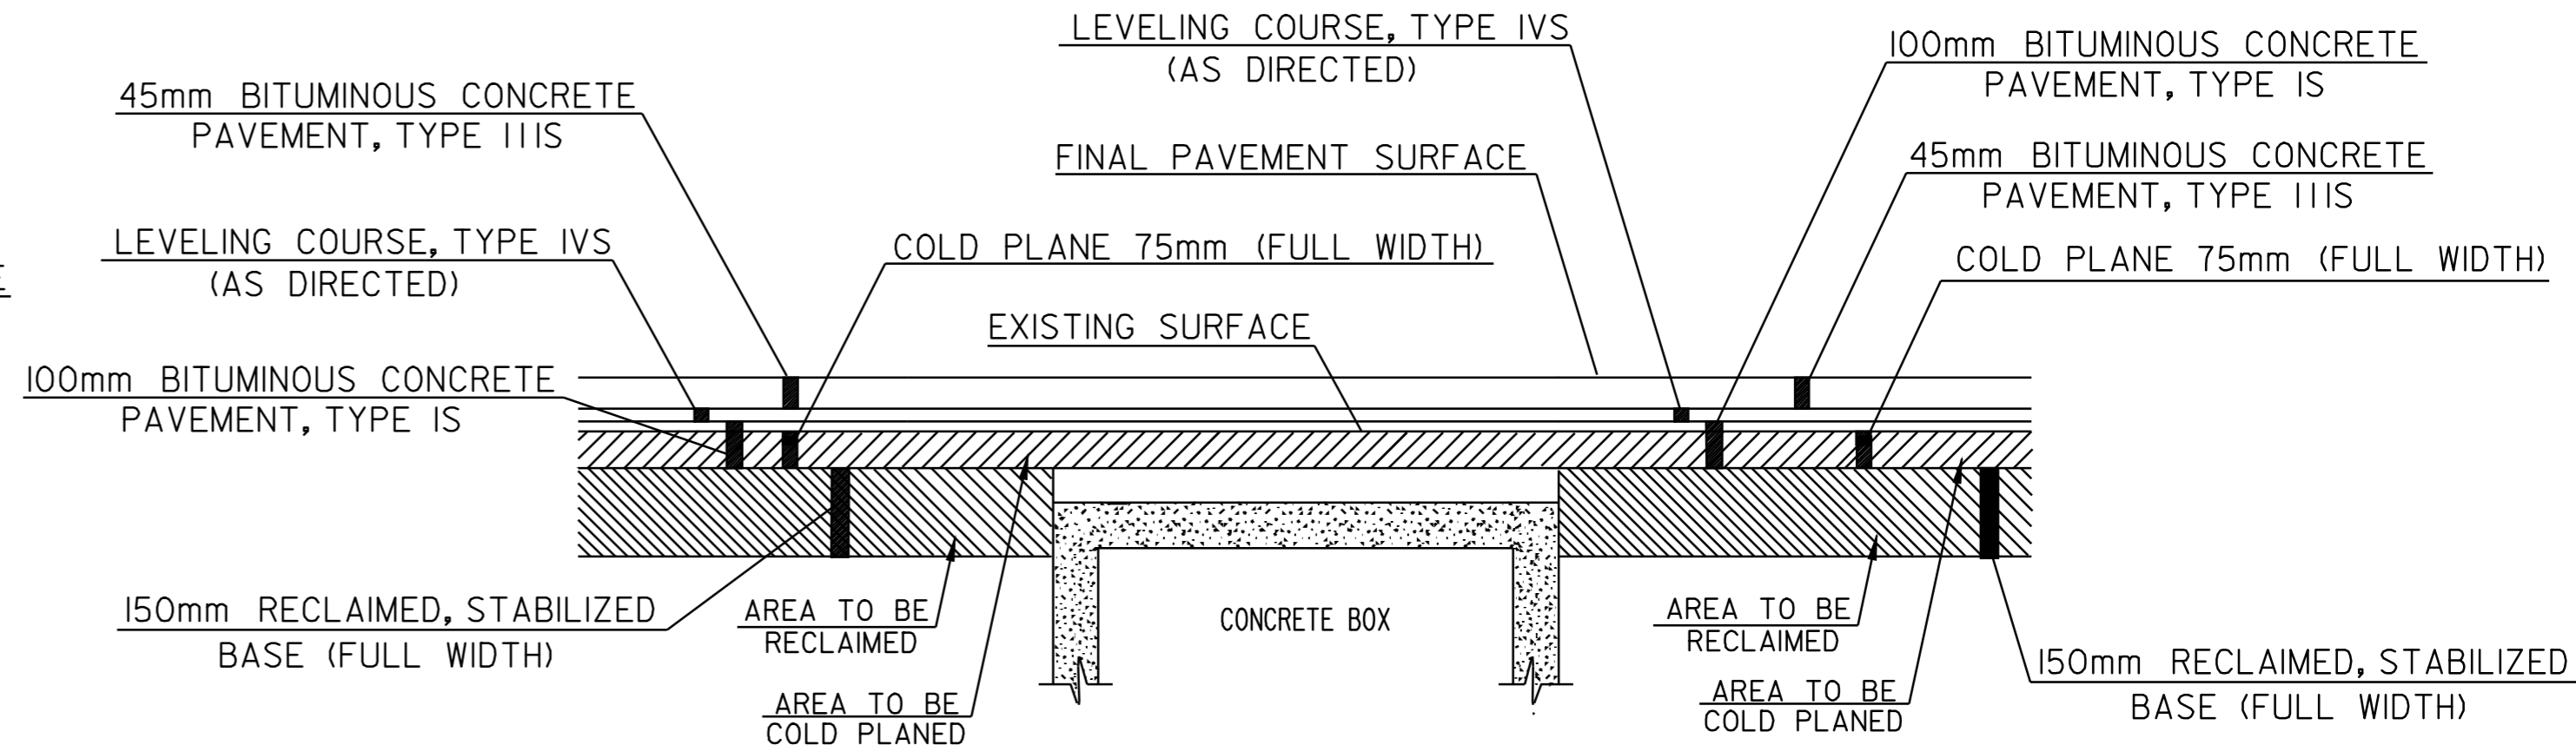

**- COLD PLANING DETAIL @ CONCRETE BOXES -**


LOCATION	FIELD STATION
WAITSFIELD UNNUMBERED 3' x 3' BOX	STA 7+299
WAITSFIELD BRIDGE #180	STA 7+646
WAITSFIELD BRIDGE #184	STA 8+735
WAITSFIELD BRIDGE #185	STA 9+353

**NOTE: THESE PARTICULAR CONCRETE BOX CULVERTS DO NOT APPEAR TO HAVE SUFFICIENT COVER TO ACCOMMODATE THE DESIGNED RECLAIM DEPTH.**

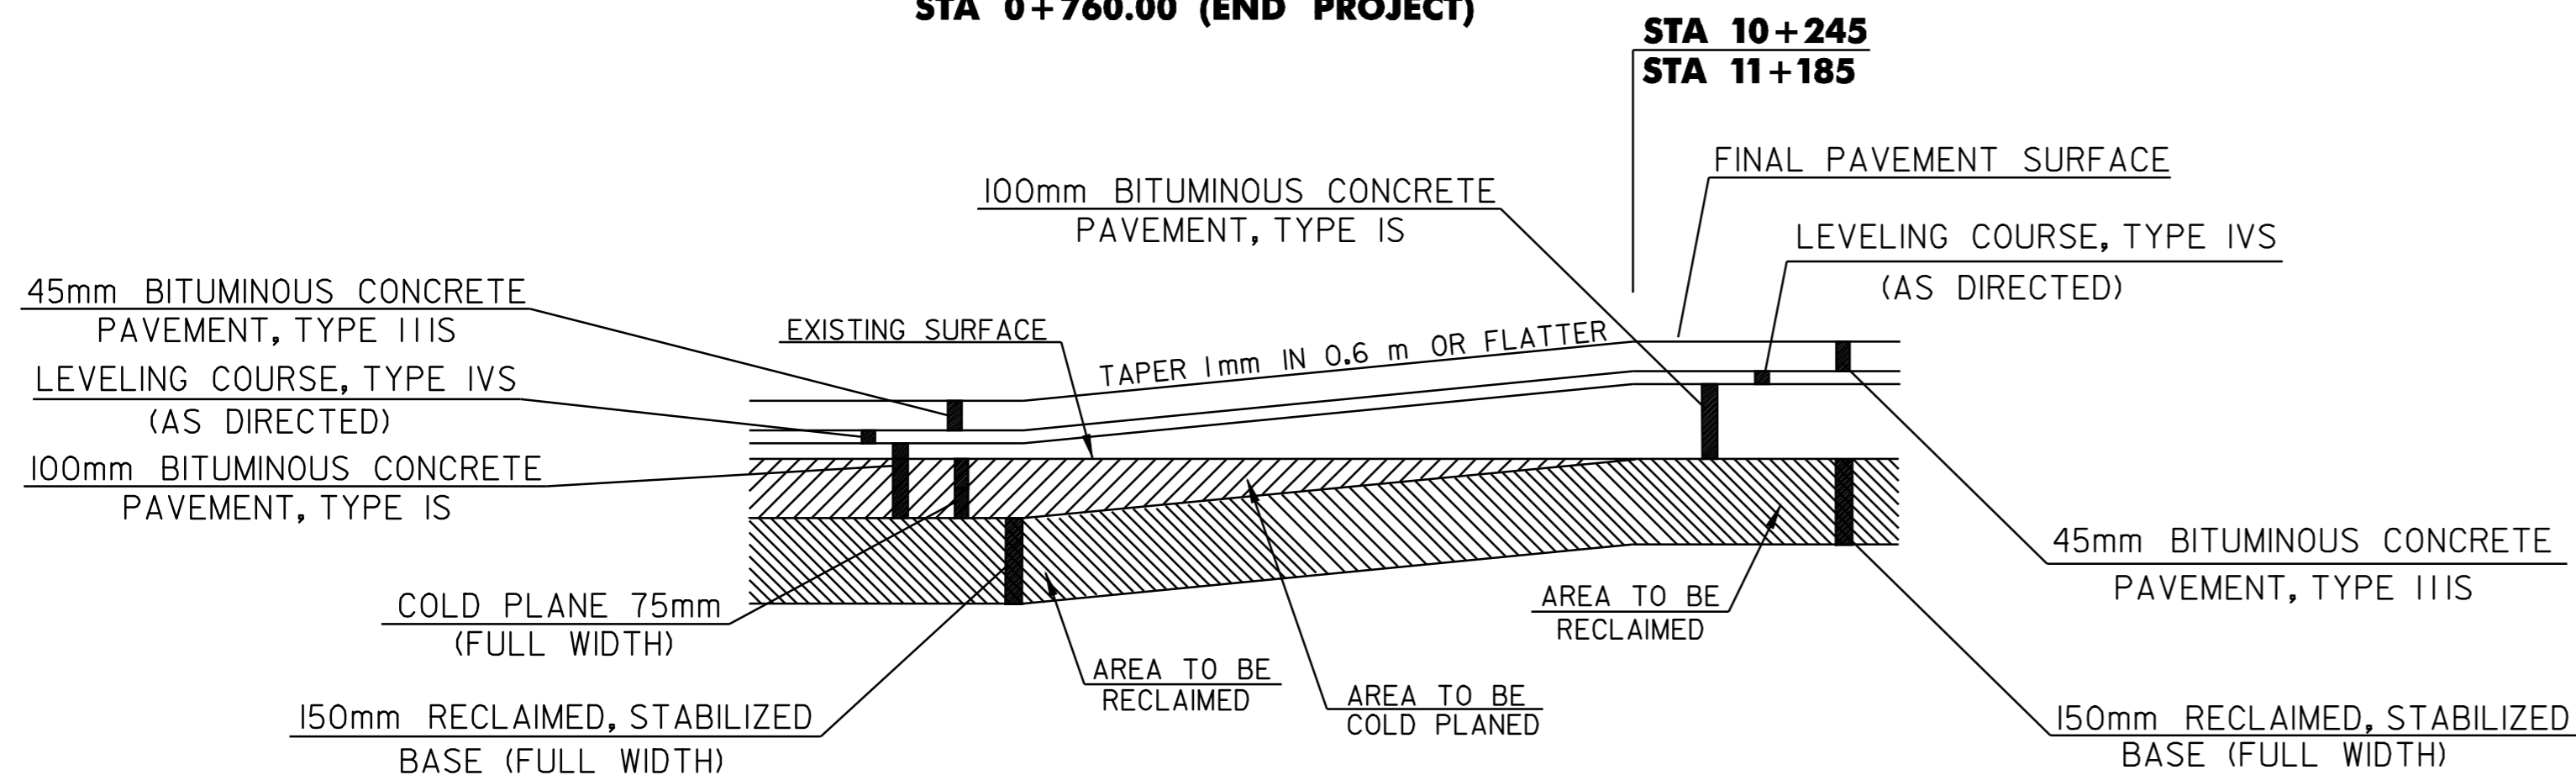

**- TRANSITION AREA DETAIL -**

**WAITSFIELD**  
**STA 10+245 (RECLAIMING/END COLD PLANING)**  
**STA 11+185 (BEGIN COLD PLANING/RECLAIMING)**

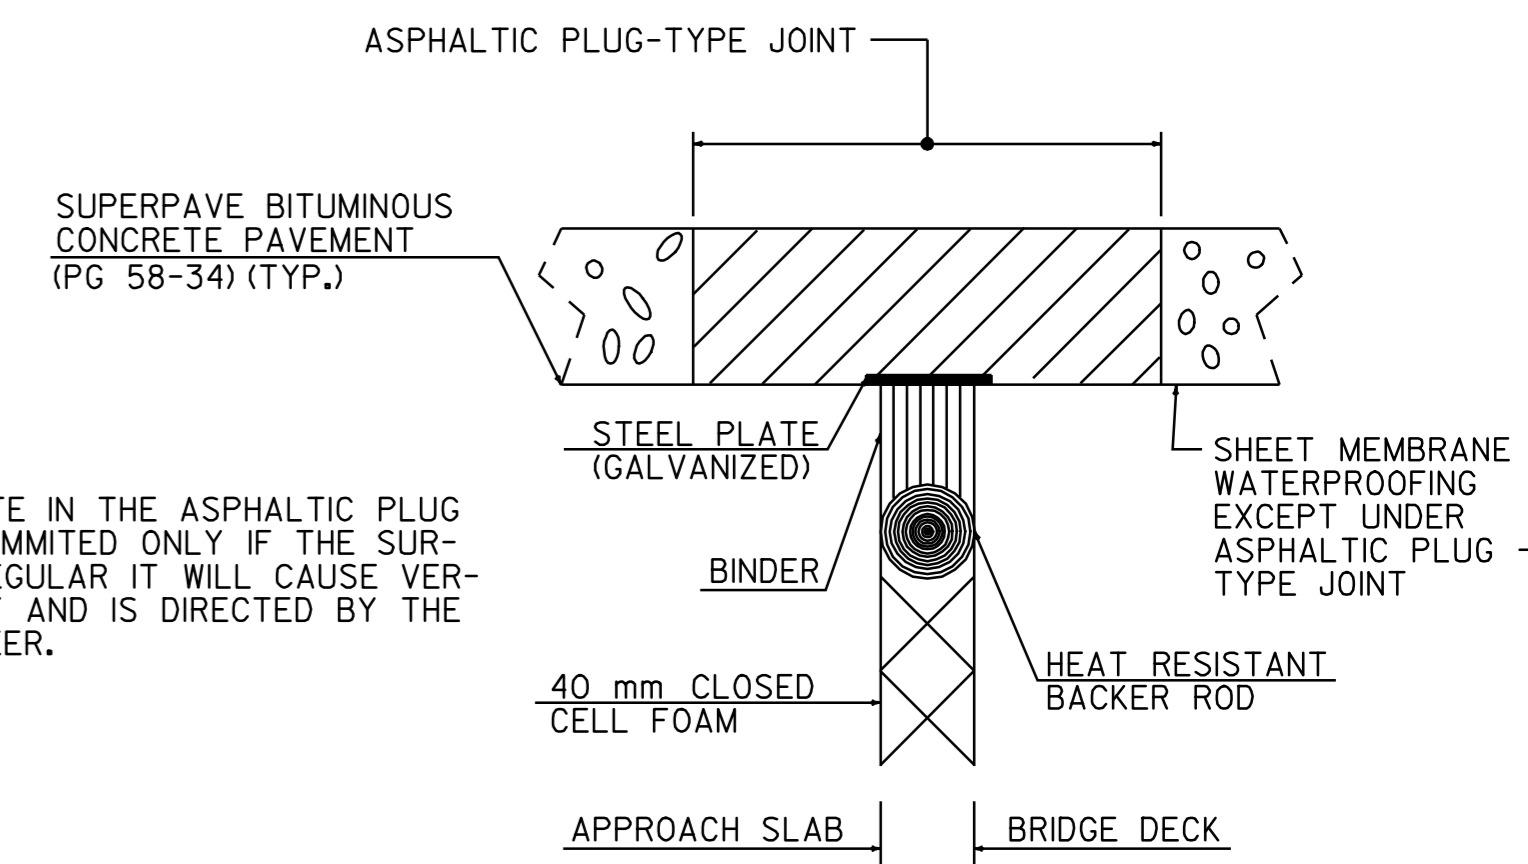

**NOTE: THE STEEL PLATE IN THE ASPHALTIC PLUG JOINT MAY BE OMITTED ONLY IF THE SURFACE IS SO IRREGULAR IT WILL CAUSE VERTICAL MOVEMENT AND IS DIRECTED BY THE RESIDENT ENGINEER.**

**ASPHALTIC PLUG-TYPE JOINT DETAIL**

FIELD STA.	LENGTH
VT. ROUTE 100 WAITSFIELD - BRIDGE 186 - STA. 11+466	(8.7 m)
VT. ROUTE 100 WAITSFIELD - BRIDGE 186 - STA. 11+492	(8.7 m)

**CONSERVATION SEED MIX**

RURAL AREA - SEED MIXTURE				
% WT.	kg/ha.	NAME	PUR. %	GERM. %
37.14	26.0	CREeping RED FESCUE	98	85
37.14	26.0	TALL FESCUE	95	90
5.71	4.0	RED TOP	95	90
14.30	10.0	BIRDSFOOT TREFoil	98	85
5.71	4.0	ANNUAL RYEGRASS	95	85
100.0	70.0			

**SEED MIXTURE:**  
 SHALL NOT HAVE A WEED CONTENT EXCEEDING 0.40% BY WEIGHT AND SHALL BE FREE OF ALL NOXIOUS WEED SEED.


**SEED:**  
 TO BE APPLIED PER SEEDING FORMULA DIRECTED BY THE RESIDENT ENGINEER

**FERTILIZER:**  
 FORMULA 10-20-10 TO BE USED WITH SEED, APPLIED AT THE RATE OF 560 kg/ha (HYDRO SEEDERS MAY USE 19-19-19 FORMULA)

**AGRICULTURAL LIMESTONE:**  
 TO BE APPLIED AT THE RATE OF 4500 kg/ha OR AS DIRECTED BY THE RESIDENT ENGINEER.

**HAY MULCH:**  
 TO BE APPLIED ON EARTH SLOPES AT THE RATE OF 4500 kg/ha, OR AS DIRECTED BY THE RESIDENT ENGINEER.

**TOPSOIL:**  
 TO BE USED WITH SEED AS INDICATED ON THE PLANS, OR AS DIRECTED BY THE RESIDENT ENGINEER.

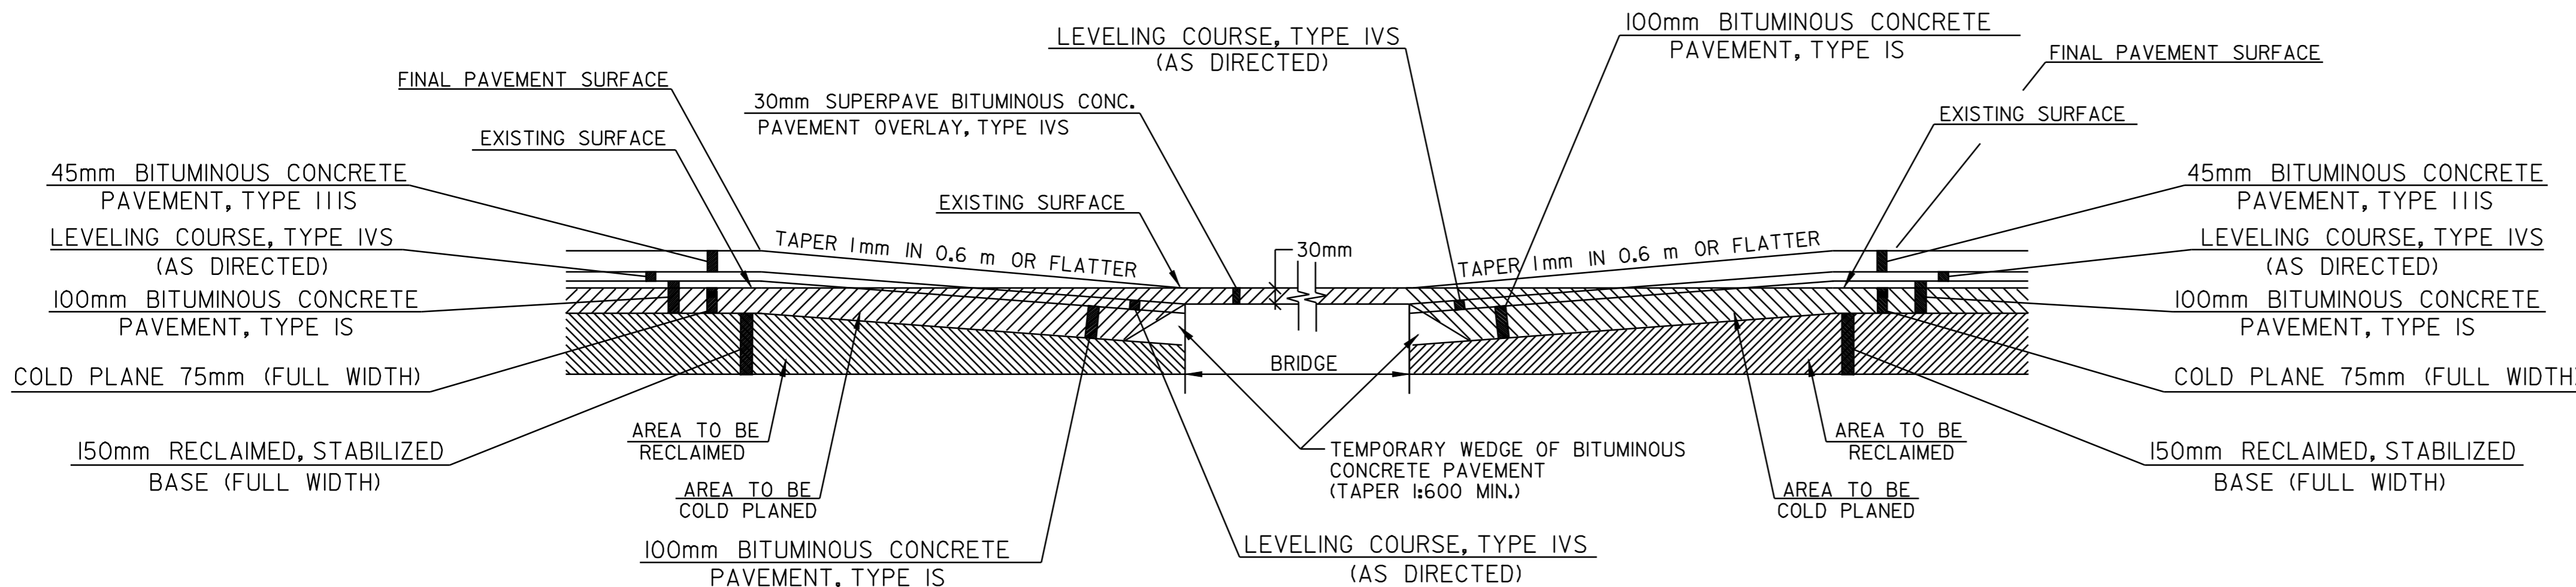

**- COLD PLANING DETAIL @ BRIDGES -**

LOCATION	FIELD STATION
WAITSFIELD BRIDGE #181	STA 7+907
WAITSFIELD BRIDGE #186	STA 11+479

**NOTE: THE CONTRACTOR MUST USE CARE WHEN COLD PLANING BRIDGE 186 AS NOT TO DAMAGE THE BRIDGE MEMBRANE. IF DAMAGE TO THIS MEMBRANE SHOULD OCCUR DURING THE COLD PLANING, THE CONTRACTOR SHALL REPLACE THE BRIDGE MEMBRANE AT NO COST TO THE STATE.**

THE CONTACTOR SHALL TAKE PRECAUTIONS TO AVOID THE ACCUMULATION OF DEBRIS IN THE DRAINAGE STRUCTURES LOCATED AT CURB LINE AND IN THE EXPANSION JOINTS. THE CONTRACTOR SHALL EXAMINE THESE BRIDGE FEATURES ON A REGULAR BASIS TO ENSURE THAT DEBRIS HAS NOT ACCUMULATED. ANY DEBRIS WHICH IS PRESENT SHALL BE REMOVED BY THE CONTRACTOR AT NO COST TO THE STATE.

**NOT TO SCALE**



**PAVING DETAILS AND PAVEMENT JOINT DETAIL SHEET**

DESIGNED BY	LFW	DATE	7-05
DRAWN BY	LFW	DATE	7-05
DESIGN FILE NO.	/pave/00b058/00b058.dgn		
PRF FILE	00b058+yp2.i	DATE PLOTTED	23-MAY-2008
PROJ. NAME:	WAITSFIELD - MORETOWN		
PROJ. NO.:	STP 2227(1)S		
SHEET	26	OF	54 SHEETS





# ITEM DETAIL SUMMARY SHEET



LOCATION			DRAINAGE ITEMS/MISC. ITEMS											GUARDRAIL					REMARKS
			NEW CULVERT/END SECTIONS			604.412	605.10	613.10	616.47	617.10	617.12	619.17	621.30	621.30	621.80	621.81	676.10		
FIELD STATION	FIELD STATION	POS.	DIA.	TYPE	LENGTH/TH	REHAB DROP INLET	150mm UNDERDRAIN	STONE FILL TYPE I	BIT. CONC. GUTTERS & TRF. ISLAND	RELOCATE MAILBOX - SINGLE	RELOCATE MAILBOX - MULTIPLE	YIELDING MARKER POSTS	BOX BEAM GUARDRAIL (GALV.)	BOX BEAM G.R. (GALV.) (2.1m POSTS)	REMOVAL & DISP. G.R.	REMOVAL & DISP. G.P.	DEL.INE. W/STEEL POSTS		
			mm	--	m /mm	EA	m	m <sup>3</sup>	TON	EA	EA	EA	m	m	m	EA	EA		
WAITSFIELD: 6+671	MORETOWN: 0+760		375	CSP	50/1.63		100		10										
			450	CSP	50/1.63														
			450	CPEP	100/ --														
			375	CSPES	3 EA./1.63														
			450	CSPES	3 EA./1.63														
			450	CPEPES	5 EA./ --														
WAITSFIELD: 6+671	MORETOWN: 0+760					8		15		+ 0	+ 0	35							
	7+297	7+234	LT										27.4		-		2		
ESTIMATED QUANTITIES FOR USE AS DIRECTED BY THE RESIDENT ENGINEER.																			
WAITSFIELD: 7+618.0	7+681.0	LT											62.20		63		2		
9/15/06																			
7+618.0	7+779.0	RT											160.90		161		2		
													27.43						
7+872.2	7+930.0	LT											<del>31.09</del>		35		2		
SEE SHEETS 45 AND 46 FOR BRIDGE QUANTITIES. 66'-0" + 24'-0" = 27.43m																			
7+885.0	7+928.2	RT											<del>12.80</del>		35		2		
SEE SHEETS 45 AND 46 FOR BRIDGE QUANTITIES. 24'-0" + 18'-0" = 12.80m																			
8+165.0	8+304.0	RT											139.00		138		2		
8+167.0	8+249.0	LT											82.30		82		2		
8+339.0	8+500.0	RT												160.93	161		2		
8+472.0	8+495.0	LT											23.77		23		2		
	+718.6																		
8+729.5	8+746.0	LT													<del>16.46</del>		2		
RAIL EXTENDED TO 90 FEET. 2.1POSTS																			
9+170.3	9+238.0	RT													67.67		2		
9+323.0	9+429.0	RT											106.07		106		2		
9+336.0	9+359.0	LT															2		
SEE SHEETS 45 AND 48 FOR BRIDGE QUANTITIES. 18'-0" 5.5m ON EACH END = 11.0m																			
9+438.0	9+495.0	RT											56.69		57		2		
	+710																		
9+526.0	9+720.0	RT											<del>188.73</del>		<del>183</del>		2		
	9+540	9+620	LT										<del>193.85</del>		<del>194</del>		2		
600 FT INSTALLED + 48 FT x 0.4 FACTOR = 188.73																			
9+802.0	9+921.0	RT												80.5			2		
264 FT OF BOX BEAM ADDED TO PROTECT STEEP BANK																			
10+140.0	10+284.0	RT												118.87	119		2		
	TH 9																		
10+316.0	0+066	RT													144	144	2		
REPLACE GUARDRAIL ALONG TH #9. 216 FEET BOX BEAM INSTALLED																			
10+328.0	10+459.0	RT											<del>128.02</del>	126.2	125	2	2		
414 FEET INSTALLED 2.1 INSTALLED TO PROTECT STEEP BANK																			
10+488.0	10+074	RT												74.07	75		1		
														<del>74.98</del>					
REPLACE GUARDRAIL ALONG TH #8 USING 2.1m POSTS. 243 FEET INSTALLED																			
10+488.0	10+641.6	RT											154.53		154		1		
													<del>153.62</del>	<del>150</del>			1		
AT STA. 10+488.0 RT, END BOX BEAM WITH 2.1m POSTS/BEGIN NORMAL LENGTH POSTS.																			
10+686.0	10+900.0	RT											213.97		209	2	2		
	10+694	10+763	LT											69.5	68	2	2		
EXISTING 2 CABLE RAIL NOT ON PLANS 228 FT OF BOX BEAM INSTALLED																			
11+023.0	11+160.2	RT											137.16		<del>135</del> <del>132</del>	2	2		
11+456.0	11+502.0	RT											5.5		20		2		
SEE SHEETS 45 AND 47 FOR BRIDGE QUANTITIES. 18'-0" BOX BEAM 5.5m																			
11+458.0	11+505.0	LT											5.5		21		2		
SEE SHEETS 45 AND 47 FOR BRIDGE QUANTITIES. 18'-0" BOX BEAM 5.5m																			
MORETOWN: 0+363.0	0+513.0	RT													<del>54.86</del>	149.96	2		
															<del>95.10</del>				
USE BOX BEAM WITH 2.1m POSTS FROM STA. 0+363.0 TO 0+458.1 RT. FOR WHOLE RUN																			
0+416.0	0+456.2	LT													60.35	40.23	2		
198 FEET OF BOX BEAM INSTALLED																			
SHEET SUBTOTAL						8	100	15	10	1	1	35	<del>1414.95</del>	<del>1445.77</del>	2347	9	56		
ROUNDING													<del>1,559.96</del>	<del>780.9</del>	<del>2,283</del>	<del>7</del>	<del>50</del>		
TOTAL						8	100	15	10	1	1	35	1,600.00	800.00	2,325	10	50		
			375	CSP	50/1.63														
			450	CSP	50/1.63														
			450	CPEP	100/ --														
			375	CSPES	3 EA./1.63														
			450	CSPES	3 EA./1.63														
			450	CPEPES	5 EA./ --														

**ITEM DETAIL SUMMARY SHEET**

SURVEYED BY J. REDMOND DATE 7/05  
 DRAWN BY J. REDMOND DATE 7/05  
 SQUAD LEADER J. REDMOND  
 DESIGN FILE NO. pave/00b058/00b058.dgn  
 IPARM FILE 00b058id1 DATE PLOTTED 23-MAY-2008 12:56  
 PROJ. NAME WAITSFIELD - MORETOWN  
 PROJ. NO. STP 2227(I)S  
 SHEET 29 OF 54



646.40 DURABLE 100 mm WHITE LINE (THERMOPLASTIC)  
 (ALL LINES WILL INCLUDE EDGE LINE BREAKS AND RADIUS FOR TOWN HIGHWAYS)

WAITSFIELD:  
 STA. 6+671 - STA. 6+800 LT & RT

646.60 TEMPORARY 100 mm WHITE LINE (PAINT)  
 (ALL LINES WILL INCLUDE EDGE LINE BREAKS AND RADIUS FOR TOWN HIGHWAYS)

WAITSFIELD:  
 STA. 6+671 - STA. 6+800 LT & RT

646.41 DURABLE 100 mm YELLOW LINE (THERMOPLASTIC)  
 (ALL LINES WILL INCLUDE C/L BREAKS FOR TOWN HIGHWAYS) S=SOLID, D=DASHED

WAITSFIELD: LT CL RT  
 STA. 6+671 - STA. 6+800 S - S

646.61 TEMPORARY 100 mm YELLOW LINE (PAINT)  
 (ALL LINES WILL INCLUDE C/L BREAKS FOR TOWN HIGHWAYS) S=SOLID, D=DASHED


WAITSFIELD: LT CL RT  
 STA. 6+671 - STA. 6+800 S - S

646.50 DURABLE LETTER OR SYMBOL (THERMOPLASTIC)

WAITSFIELD:  
 STA. 6+783 LT, "S,C,H,O,O,L" (6 EA)

646.70 TEMPORARY LETTER OR SYMBOL (PAINT)

WAITSFIELD:  
 STA. 6+783 LT, "S,C,H,O,O,L" (6 EA)

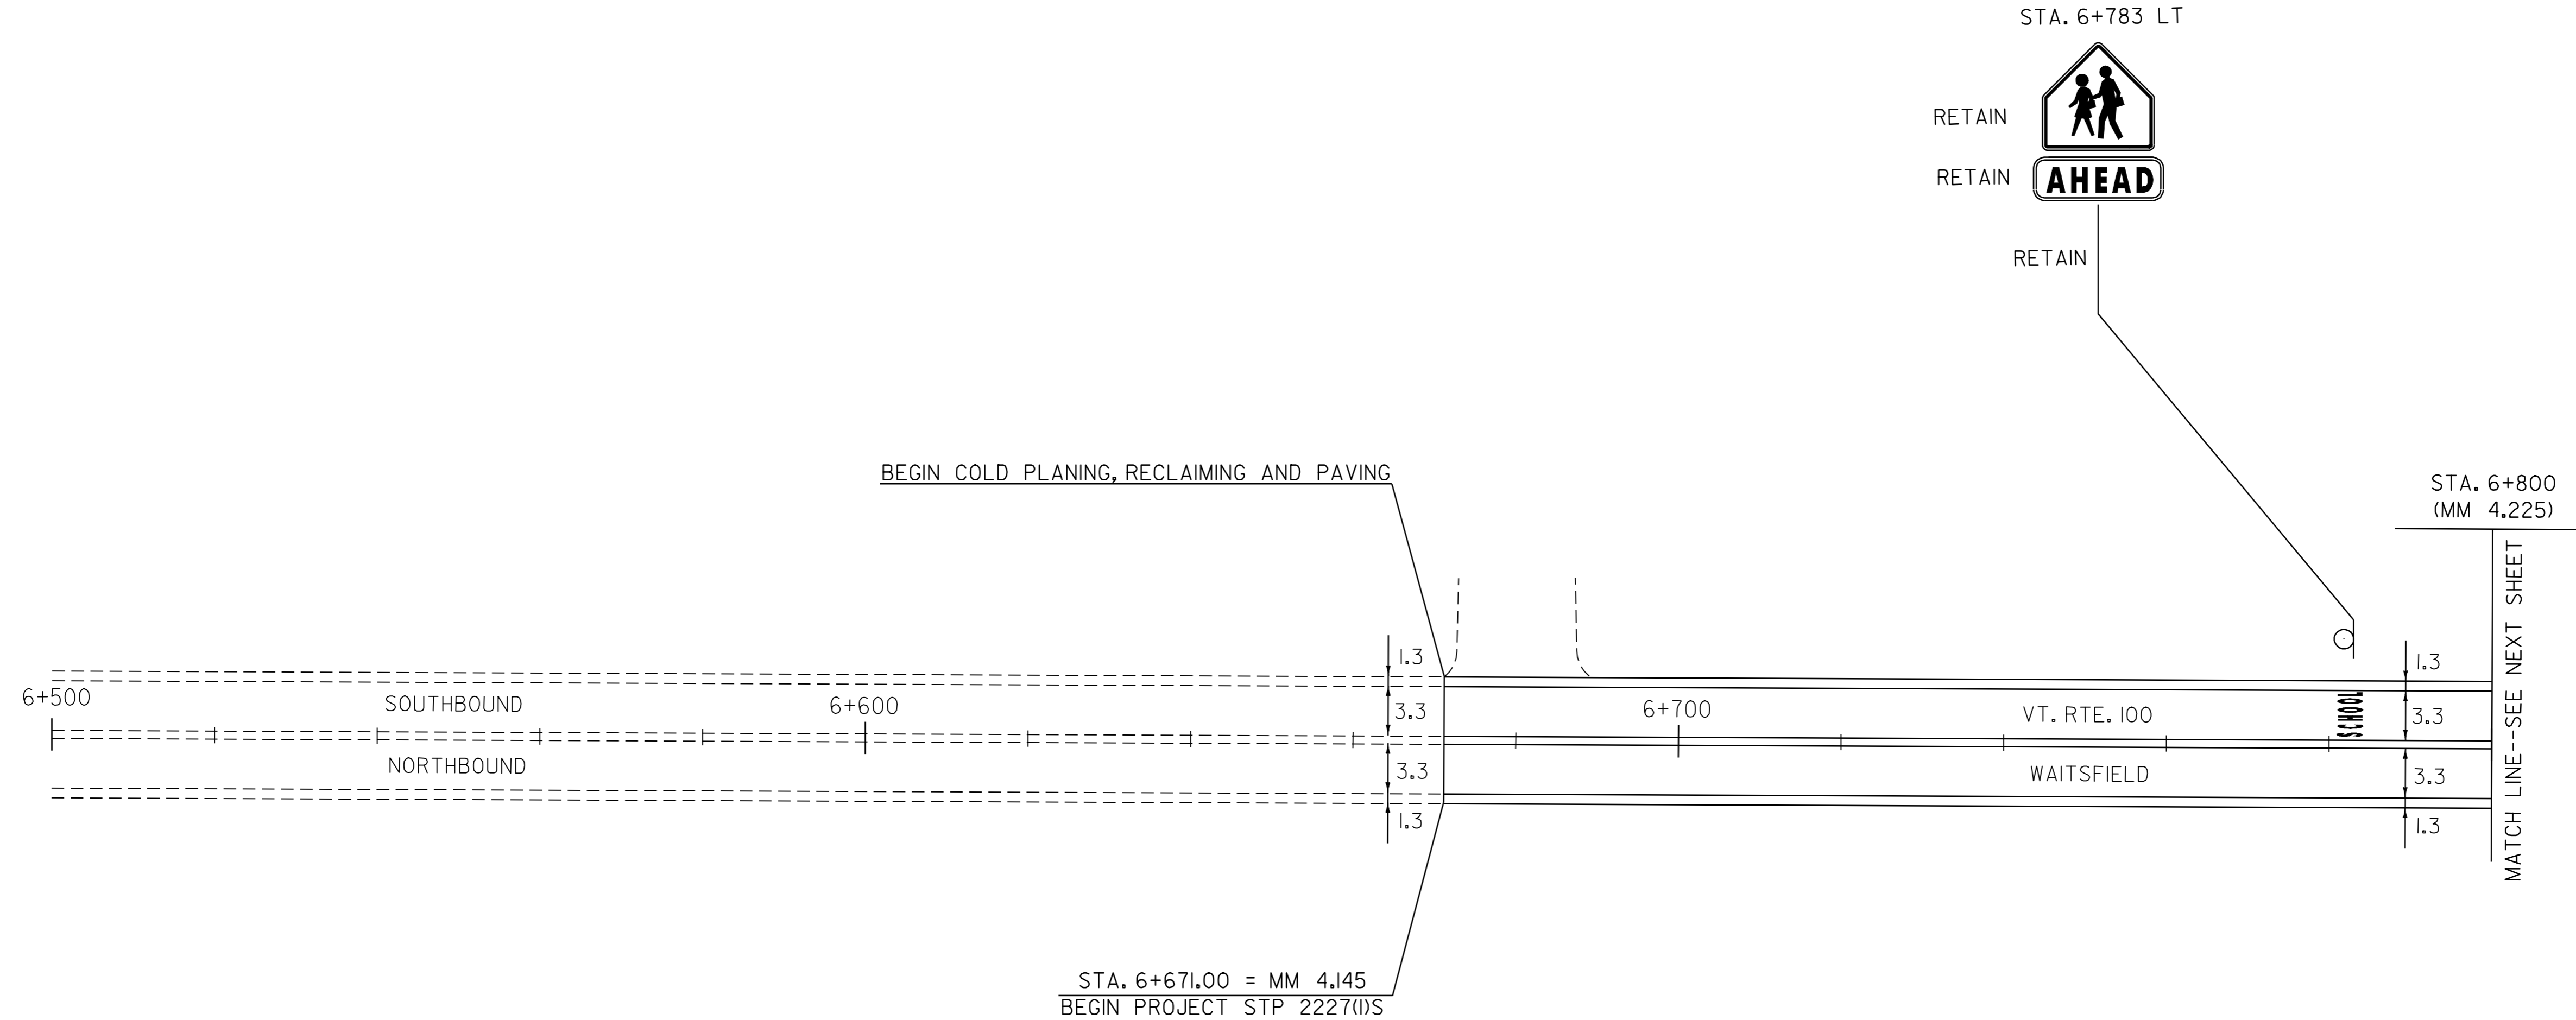

NOT TO SCALE

<b>PAVING PROJECT LAYOUT #1 VT. RTE. 100</b>	PROJECT NAME: WAITSFIELD-MORETOWN	
	PROJECT NUMBER: STP 2227(I)S	
	FILE NAME: /pave/00b058/00b058.dgn	PLOT DATE: 23-MAY-2008 12:5
	PROJECT LEADER: WOOLAVER	DRAWN BY: J. REDMOND
DESIGNED BY: J. REDMOND	CHECKED BY: J. REDMOND	
00b058101.i	SHEET 31 OF 54	

646.40 DURABLE 100 mm WHITE LINE (THERMOPLASTIC)  
 (ALL LINES WILL INCLUDE EDGE LINE BREAKS AND RADIUS FOR TOWN HIGHWAYS)

WAITSFIELD:  
 STA. 6+800 - STA. 7+400 LT & RT

646.60 TEMPORARY 100 mm WHITE LINE (PAINT)  
 (ALL LINES WILL INCLUDE EDGE LINE BREAKS AND RADIUS FOR TOWN HIGHWAYS)

WAITSFIELD:  
 STA. 6+800 - STA. 7+400 LT & RT

646.41 DURABLE 100 mm YELLOW LINE (THERMOPLASTIC)  
 (ALL LINES WILL INCLUDE C/L BREAKS FOR TOWN HIGHWAYS) S=SOLID, D=DASHED

WAITSFIELD:  
 STA. 6+800 - STA. 7+400 LT S C RT S

646.61 TEMPORARY 100 mm YELLOW LINE (PAINT)  
 (ALL LINES WILL INCLUDE C/L BREAKS FOR TOWN HIGHWAYS) S=SOLID, D=DASHED


WAITSFIELD:  
 STA. 6+800 - STA. 7+400 LT S C RT S

619.17 YIELDING MARKER POSTS


WAITSFIELD:  
 STA. 7+155 LT & RT (2)  
 STA. 7+296 RT (1)  
 STA. 7+303 LT (1)

DITCHING LOCATION

WAITSFIELD:  
 STA. 7+176 - 7+240 RT  
 STA. 7+176 - 7+279 LT  
 STA. 7+303 - 7+400 LT

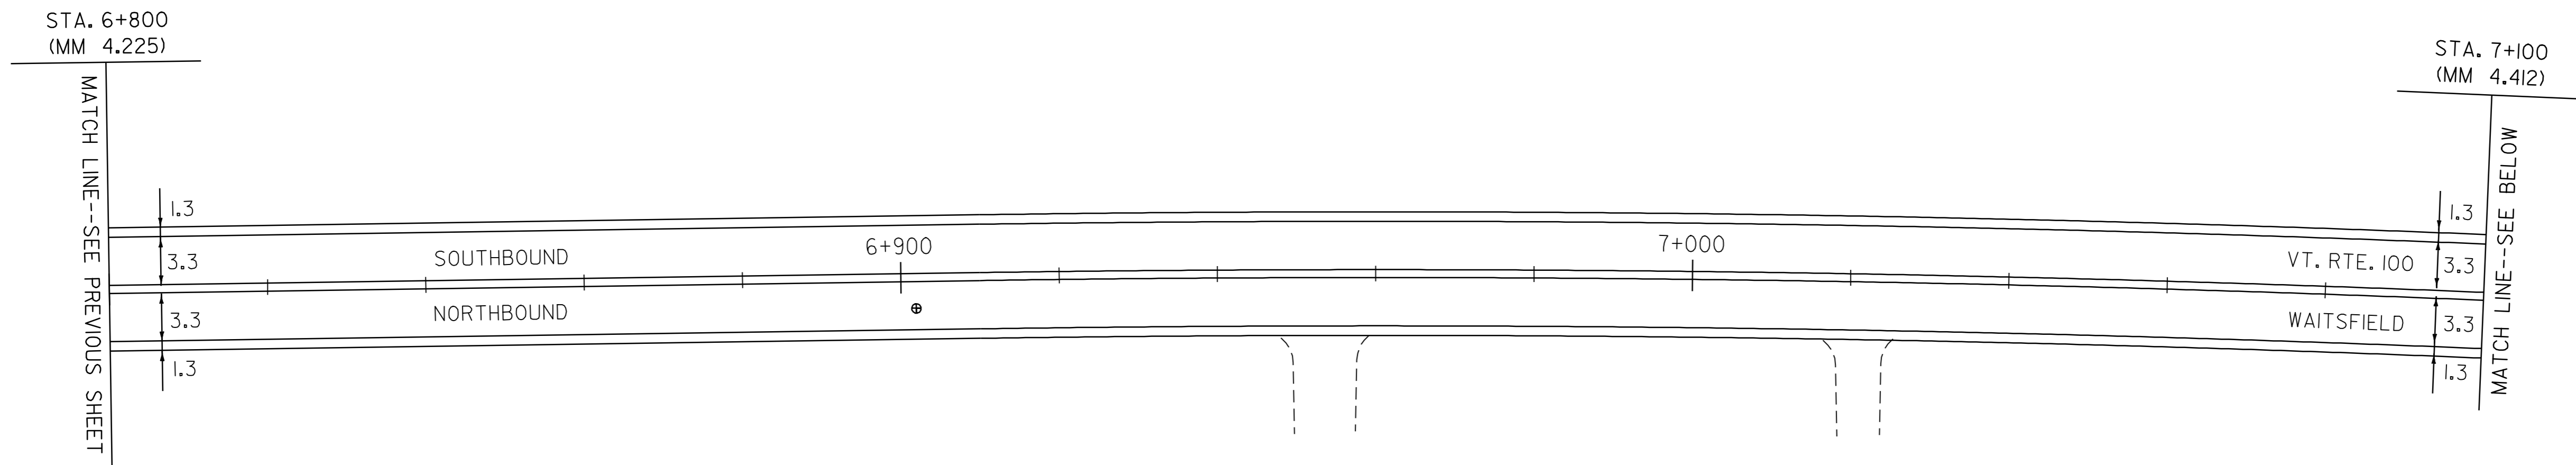

**CURVE #1**  
 PC FIELD STA. 7+135  
 PT FIELD STA. 7+485  
 8°30' RT  
 T=175m  
 R=2355m  
 SUPERELEVATION=NC  
 RUNOFF=N/A  
 RUNOUT=N/A  
 V=80km/hr (50 m.p.h.)  
 SEE SHEET 50 FOR BANKING DETAIL

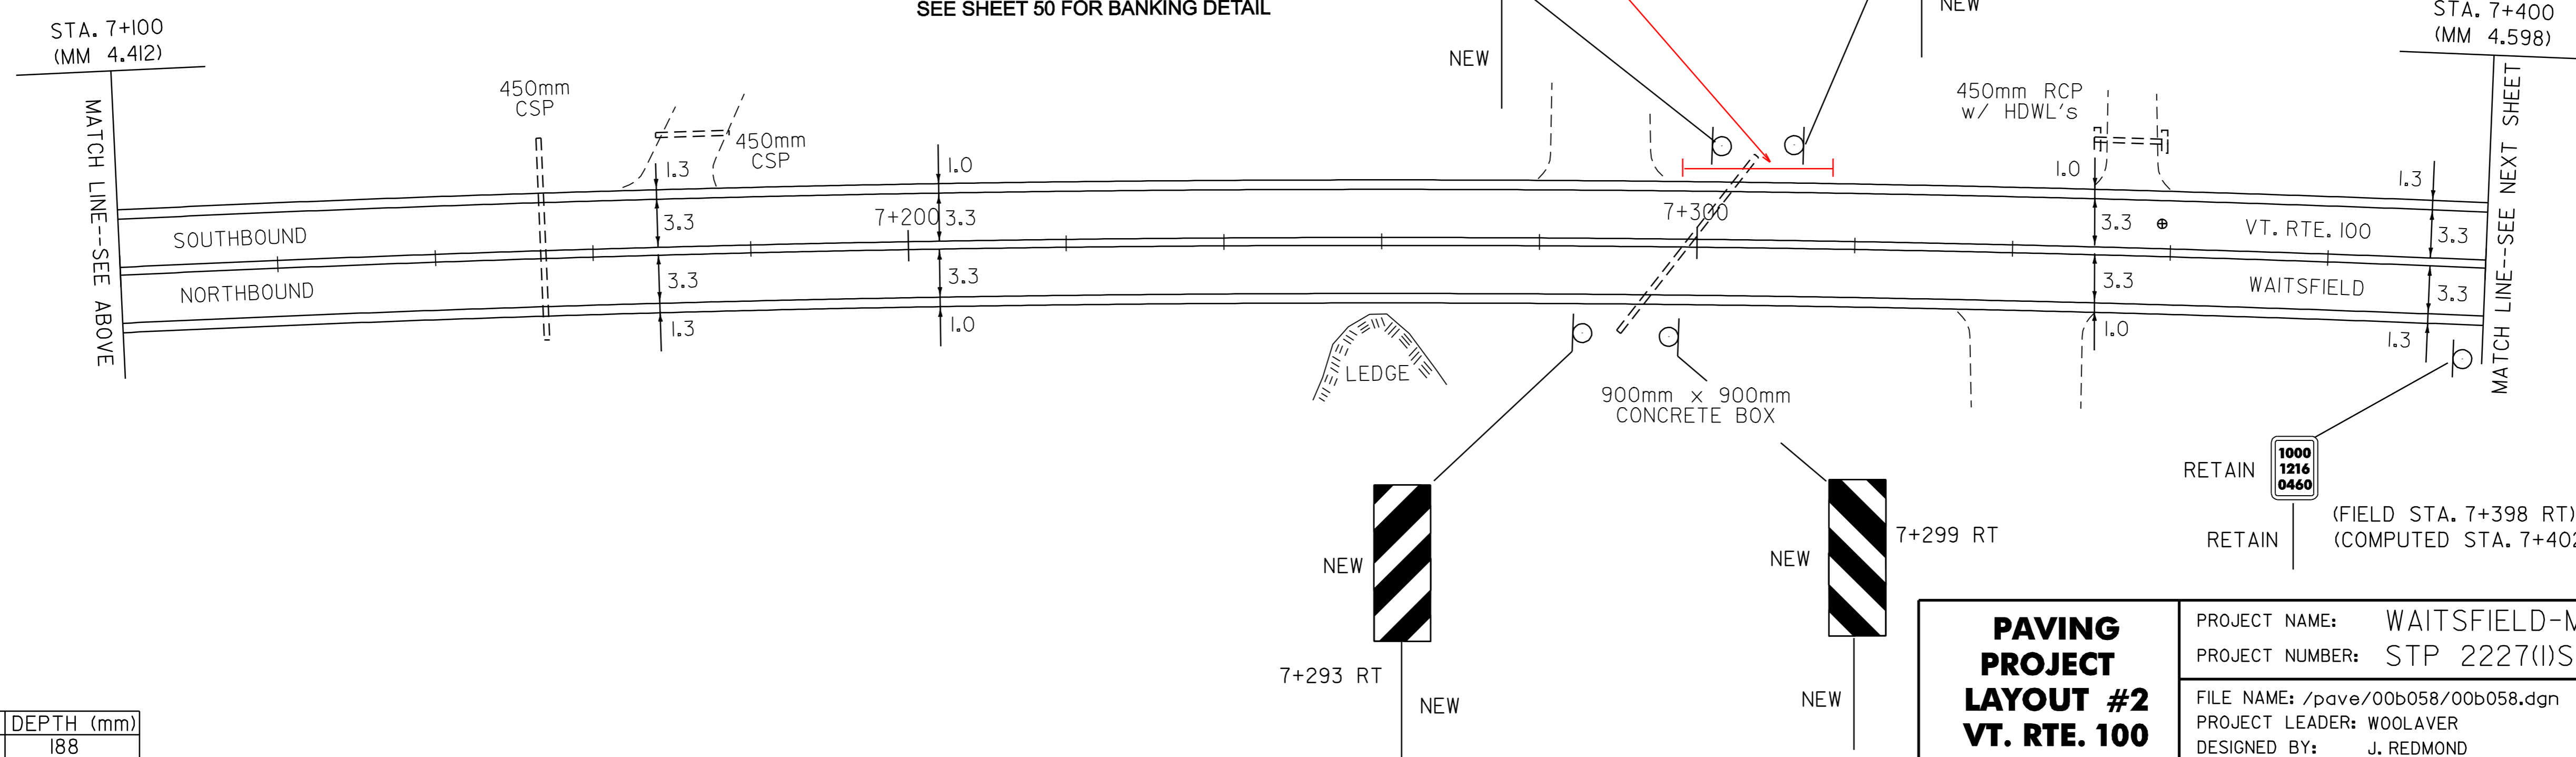

CORE NO.	LOCATION	DEPTH (mm)
1	6+902 RT	188
6	7+358 LT	175

**PAVING PROJECT LAYOUT #2 VT. RTE. 100**

PROJECT NAME: WAITSFIELD-MORETOWN  
 PROJECT NUMBER: STP 2227(1)S  
 FILE NAME: /pave/00b058/00b058.dgn  
 PROJECT LEADER: WOOLLAVER  
 DESIGNED BY: J. REDMOND  
 00b058102.1  
 PLOT DATE: 23-MAY-2008 12:5  
 DRAWN BY: J. REDMOND  
 CHECKED BY: J. REDMOND  
 SHEET 32 OF 54

NOT TO SCALE

**646.40 DURABLE 100 mm WHITE LINE (THERMOPLASTIC)**  
 (ALL LINES WILL INCLUDE EDGE LINE BREAKS AND RADIUS FOR TOWN HIGHWAYS)  
 WAITSFIELD:  
 STA. 7+400 - STA. 8+000 LT & RT

**646.46 DURABLE 600 mm STOP BAR (THERMOPLASTIC)**  
 WAITSFIELD:  
 STA. 7+557 LT, T-12  
 STA. 7+955 RT, T-15

**646.41 DURABLE 100 mm YELLOW LINE (THERMOPLASTIC)**  
 (ALL LINES WILL INCLUDE C/L BREAKS FOR TOWN HIGHWAYS) S=SOLID, D=DASHED  
 WAITSFIELD:  
 STA. 7+400 - STA. 8+000 LT S - RT S  
 STA. 7+557 DOUBLE SOLID LT, T-12  
 STA. 7+955 DOUBLE SOLID RT, T-15

**646.50 DURABLE LETTER OR SYMBOL (THERMOPLASTIC)**  
 WAITSFIELD:  
 STA. 7+557 LT, T-12, "S,T,O,P" (4 EA)  
 STA. 7+955 RT, T-15, "S,T,O,P" (4 EA)

**619.17 YIELDING MARKER POSTS**  
 WAITSFIELD:  
 STA. 7+822 LT & RT (2)  
**DITCHING LOCATION**  
 WAITSFIELD:  
 STA. 7+400 - 7+480 LT  
 STA. 7+537 - 7+549 RT  
 STA. 7+537 - 7+549 LT  
 STA. 7+572 - 7+592 LT


**646.60 TEMPORARY 100 mm WHITE LINE (PAINT)**  
 (ALL LINES WILL INCLUDE EDGE LINE BREAKS AND RADIUS FOR TOWN HIGHWAYS)  
 WAITSFIELD:  
 STA. 7+400 - STA. 8+000 LT & RT

**646.66 TEMPORARY 600 mm STOP BAR (PAINT)**  
 WAITSFIELD:  
 STA. 7+557 LT, T-12  
 STA. 7+955 RT, T-15

**646.61 TEMPORARY 100 mm YELLOW LINE (PAINT)**  
 (ALL LINES WILL INCLUDE C/L BREAKS FOR TOWN HIGHWAYS) S=SOLID, D=DASHED  
 WAITSFIELD:  
 STA. 7+400 - STA. 8+000 LT S - RT S  
 STA. 7+557 DOUBLE SOLID LT, T-12  
 STA. 7+955 DOUBLE SOLID RT, T-15

**646.70 TEMPORARY LETTER OR SYMBOL (PAINT)**  
 WAITSFIELD:  
 STA. 7+557 LT, T-12, "S,T,O,P" (4 EA)  
 STA. 7+955 RT, T-15, "S,T,O,P" (4 EA)

**REMOVING SIGNS**  
 9 AS SHOWN

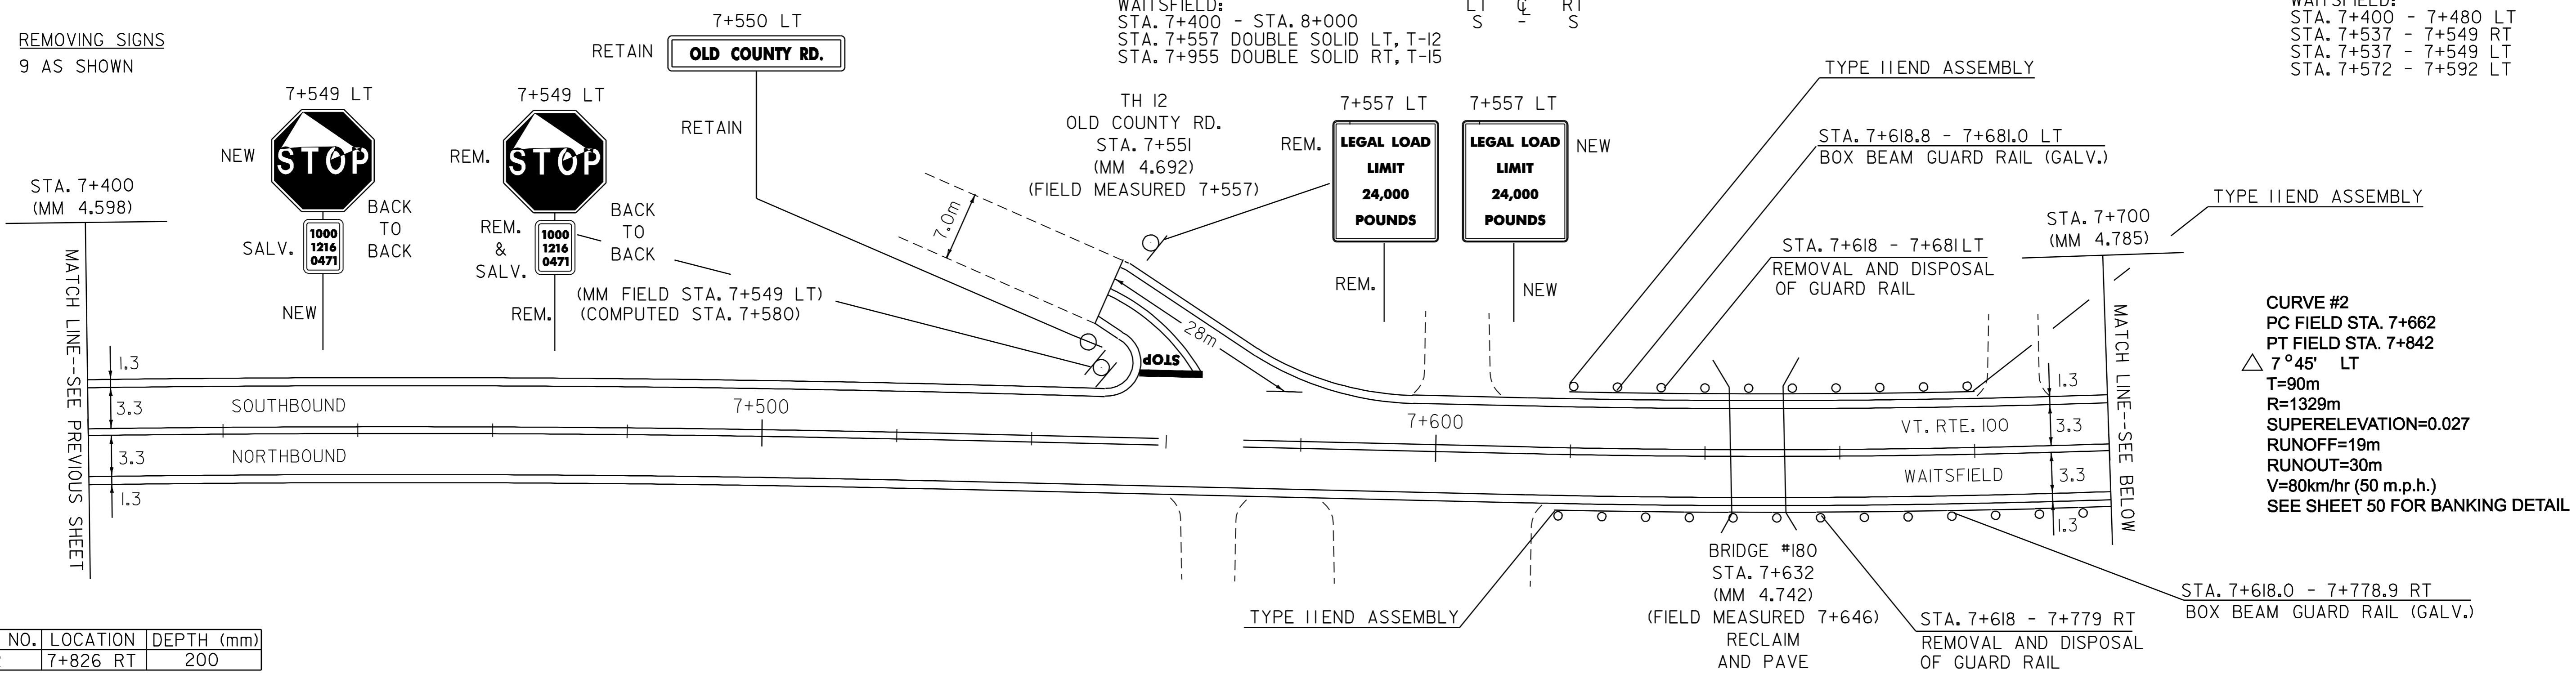

CORE NO.	LOCATION	DEPTH (mm)
2	7+826 RT	200

**CURVE #2**  
 PC FIELD STA. 7+662  
 PT FIELD STA. 7+842  
 Δ 7°45' LT  
 T=90m  
 R=1329m  
 SUPERELEVATION=0.027  
 RUNOFF=19m  
 RUNOUT=30m  
 V=80km/hr (50 m.p.h.)  
 SEE SHEET 50 FOR BANKING DETAIL

**525.10 REMOVAL OF EXISTING RAIL**  
 WAITSFIELD:  
 STA. 7+904 - 7+911 LT (7m)  
 STA. 7+904 - 7+911 RT (7m)

**621.30 BOX BEAM GUARD RAIL (GALV.)**  
 WAITSFIELD:  
 STA. 7+618.8 - 7+681.0 LT (62.2m)  
 STA. 7+618.0 - 7+778.9 RT (160.9m)  
 STA. 7+872.2 - 7+894.14 LT (21.95m)  
 STA. 7+885.0 - 7+894.14 RT (9.14m)  
 STA. 7+920.87 - 7+930.0 LT (9.14m)  
 STA. 7+920.87 - 7+928.2 RT (7.32m)

STA. 7+873 - 7+904 LT & STA. 7+911 - 7+915 LT  
 REMOVAL AND DISPOSAL OF GUARD RAIL


**621.80 REMOVAL AND DISP. OF GUARD RAIL**  
 WAITSFIELD:  
 STA. 7+618 - 7+681 LT (63m)  
 STA. 7+618 - 7+779 RT (161m)  
 STA. 7+873 - 7+904 LT (31m)  
 STA. 7+884 - 7+904 RT (20m)  
 STA. 7+911 - 7+915 LT (4m)  
 STA. 7+911 - 7+926 RT (15m)

**621.30 BOX BEAM GUARD RAIL (GALV.) (MOD. 3)**  
 WAITSFIELD:  
 STA. 7+894.14 - 7+920.87 LT (26.73m)  
 STA. 7+894.14 - 7+920.87 RT (26.73m)

STA. 7+904 - 7+911 LT  
 REMOVAL OF EXISTING RAIL

STA. 7+872.2 - 7+894.14 LT & STA. 7+920.87 - 7+930.0 LT  
 BOX BEAM GUARD RAIL (GALV.)

STA. 7+894.14 - STA. 7+920.87 LT  
 BOX BEAM GUARD RAIL (GALV.) (MOD. 3)

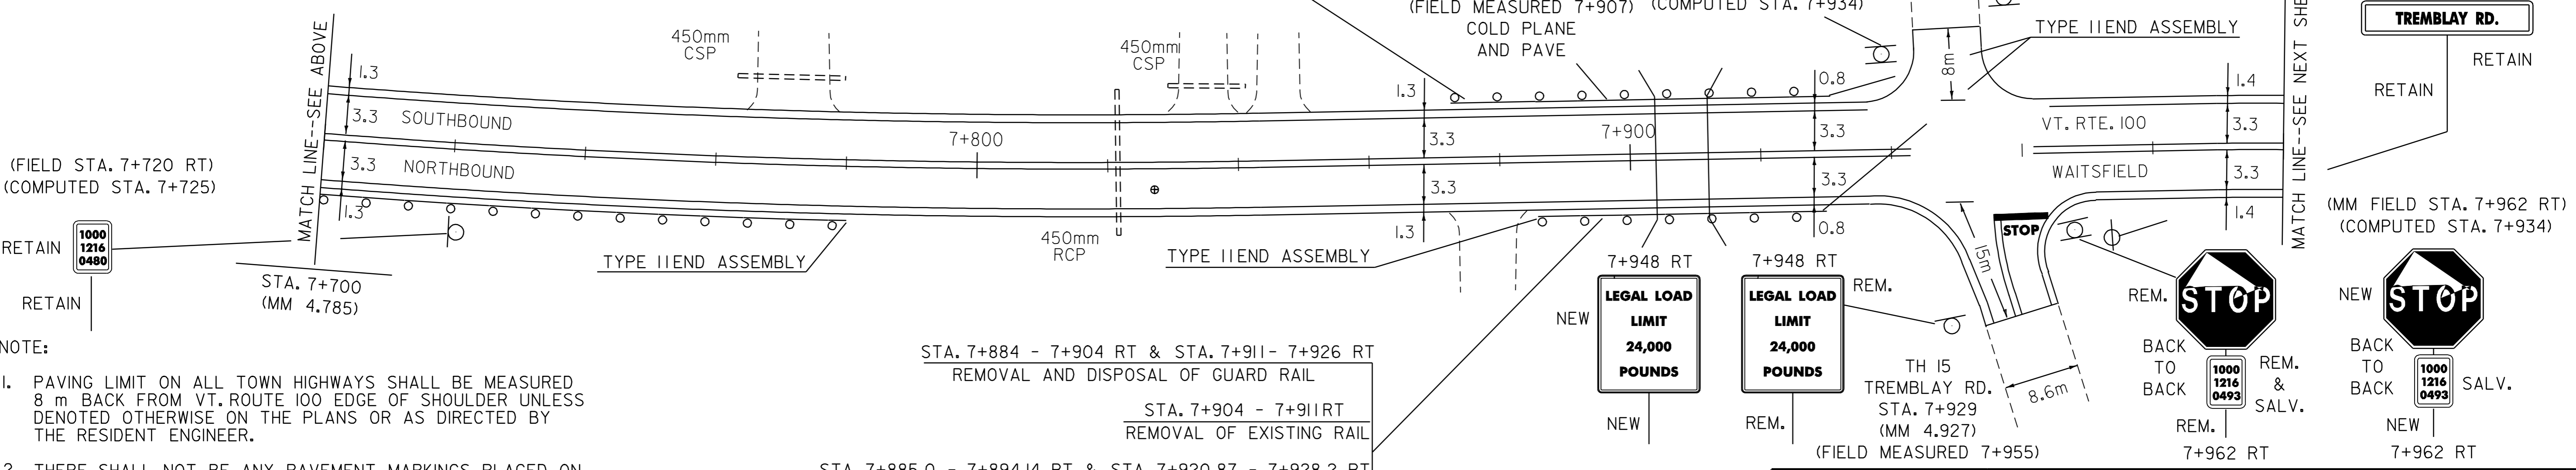

**NOTE:**  
 1. PAVING LIMIT ON ALL TOWN HIGHWAYS SHALL BE MEASURED 8 m BACK FROM VT. ROUTE 100 EDGE OF SHOULDER UNLESS DENOTED OTHERWISE ON THE PLANS OR AS DIRECTED BY THE RESIDENT ENGINEER.  
 2. THERE SHALL NOT BE ANY PAVEMENT MARKINGS PLACED ON TH II. THE MAINLINE EDGELINE AND CENTERLINE SHALL HAVE A GAP FOR THE INTERSECTION.  
 3. REFER TO SHEETS 45 AND 46 FOR DETAILS OF BOX BEAM GUARDRAIL (GALVANIZED) (MOD. 3) ON BRIDGE # 181.  
 4. REFER TO SHEET 49 FOR DETAILS OF BOX BEAM GUARDRAIL SPANNING SMALL BRIDGES (BRIDGE # 180).

STA. 7+884 - 7+904 RT & STA. 7+911 - 7+926 RT  
 REMOVAL AND DISPOSAL OF GUARD RAIL

STA. 7+904 - 7+911 RT  
 REMOVAL OF EXISTING RAIL

STA. 7+885.0 - 7+894.14 RT & STA. 7+920.87 - 7+928.2 RT  
 BOX BEAM GUARD RAIL (GALV.)

STA. 7+894.14 - STA. 7+920.87 RT  
 BOX BEAM GUARD RAIL (GALV.) (MOD. 3)

**PAVING PROJECT LAYOUT #3 VT. RTE. 100**

PROJECT NAME: WAITSFIELD-MORETOWN  
 PROJECT NUMBER: STP 2227(1)S  
 FILE NAME: /pave/00b058/00b058.dgn  
 PROJECT LEADER: WOOLAVER  
 DESIGNED BY: J. REDMOND  
 00b058103.1  
 PLOT DATE: 23-MAY-2008 12:59  
 DRAWN BY: J. REDMOND  
 CHECKED BY: J. REDMOND  
 SHEET 33 OF 54

NOT TO SCALE

**646.40 DURABLE 100 mm WHITE LINE (THERMOPLASTIC)**  
 (ALL LINES WILL INCLUDE EDGE LINE BREAKS AND RADIUS FOR TOWN HIGHWAYS)  
 WAITSFIELD:  
 STA. 8+000 - STA. 8+600 LT & RT

**646.41 DURABLE 100 mm YELLOW LINE (THERMOPLASTIC)**  
 (ALL LINES WILL INCLUDE C/L BREAKS FOR TOWN HIGHWAYS) S=SOLID, D=DASHED  
 WAITSFIELD:  
 STA. 8+000 - STA. 8+600 LT S C RT S  
 STA. 8+450 DOUBLE SOLID LT, T-7

**646.46 DURABLE 600 mm STOP BAR (THERMOPLASTIC)**  
 WAITSFIELD:  
 STA. 8+450 LT, T-7

**646.66 TEMPORARY 600 mm STOP BAR (PAINT)**  
 WAITSFIELD:  
 STA. 8+450 LT, T-7

**604.412 REHABILITATION OF DI, CB OR MH**  
 WAITSFIELD:  
 STA. 8+280 LT (THROATED)  
 STA. 8+378 LT (THROATED)  
 STA. 8+598 LT (THROATED)

**619.17 YIELDING MARKER POSTS**  
 WAITSFIELD:  
 STA. 8+280 LT & RT (2)  
 STA. 8+378 LT & RT (2)  
 STA. 8+598 LT (1)

**646.60 TEMPORARY 100 mm WHITE LINE (PAINT)**  
 (ALL LINES WILL INCLUDE EDGE LINE BREAKS AND RADIUS FOR TOWN HIGHWAYS)  
 WAITSFIELD:  
 STA. 8+000 - STA. 8+600 LT & RT



**646.61 TEMPORARY 100 mm YELLOW LINE (PAINT)**  
 (ALL LINES WILL INCLUDE C/L BREAKS FOR TOWN HIGHWAYS) S=SOLID, D=DASHED  
 WAITSFIELD:  
 STA. 8+000 - STA. 8+600 LT S C RT S  
 STA. 8+450 DOUBLE SOLID LT, T-7

**646.50 DURABLE LETTER OR SYMBOL (THERMOPLASTIC)**  
 WAITSFIELD:  
 STA. 8+450 LT, T-7, "S,T,O,P" (4 EA)

**DITCHING LOCATION**  
 WAITSFIELD:  
 STA. 8+222 - 8+438 LT  
 STA. 8+580 - 8+600 LT

**646.70 TEMPORARY LETTER OR SYMBOL (PAINT)**  
 WAITSFIELD:  
 STA. 8+450 LT, T-7, "S,T,O,P" (4 EA)

**REMOVING SIGNS**  
 3 AS SHOWN

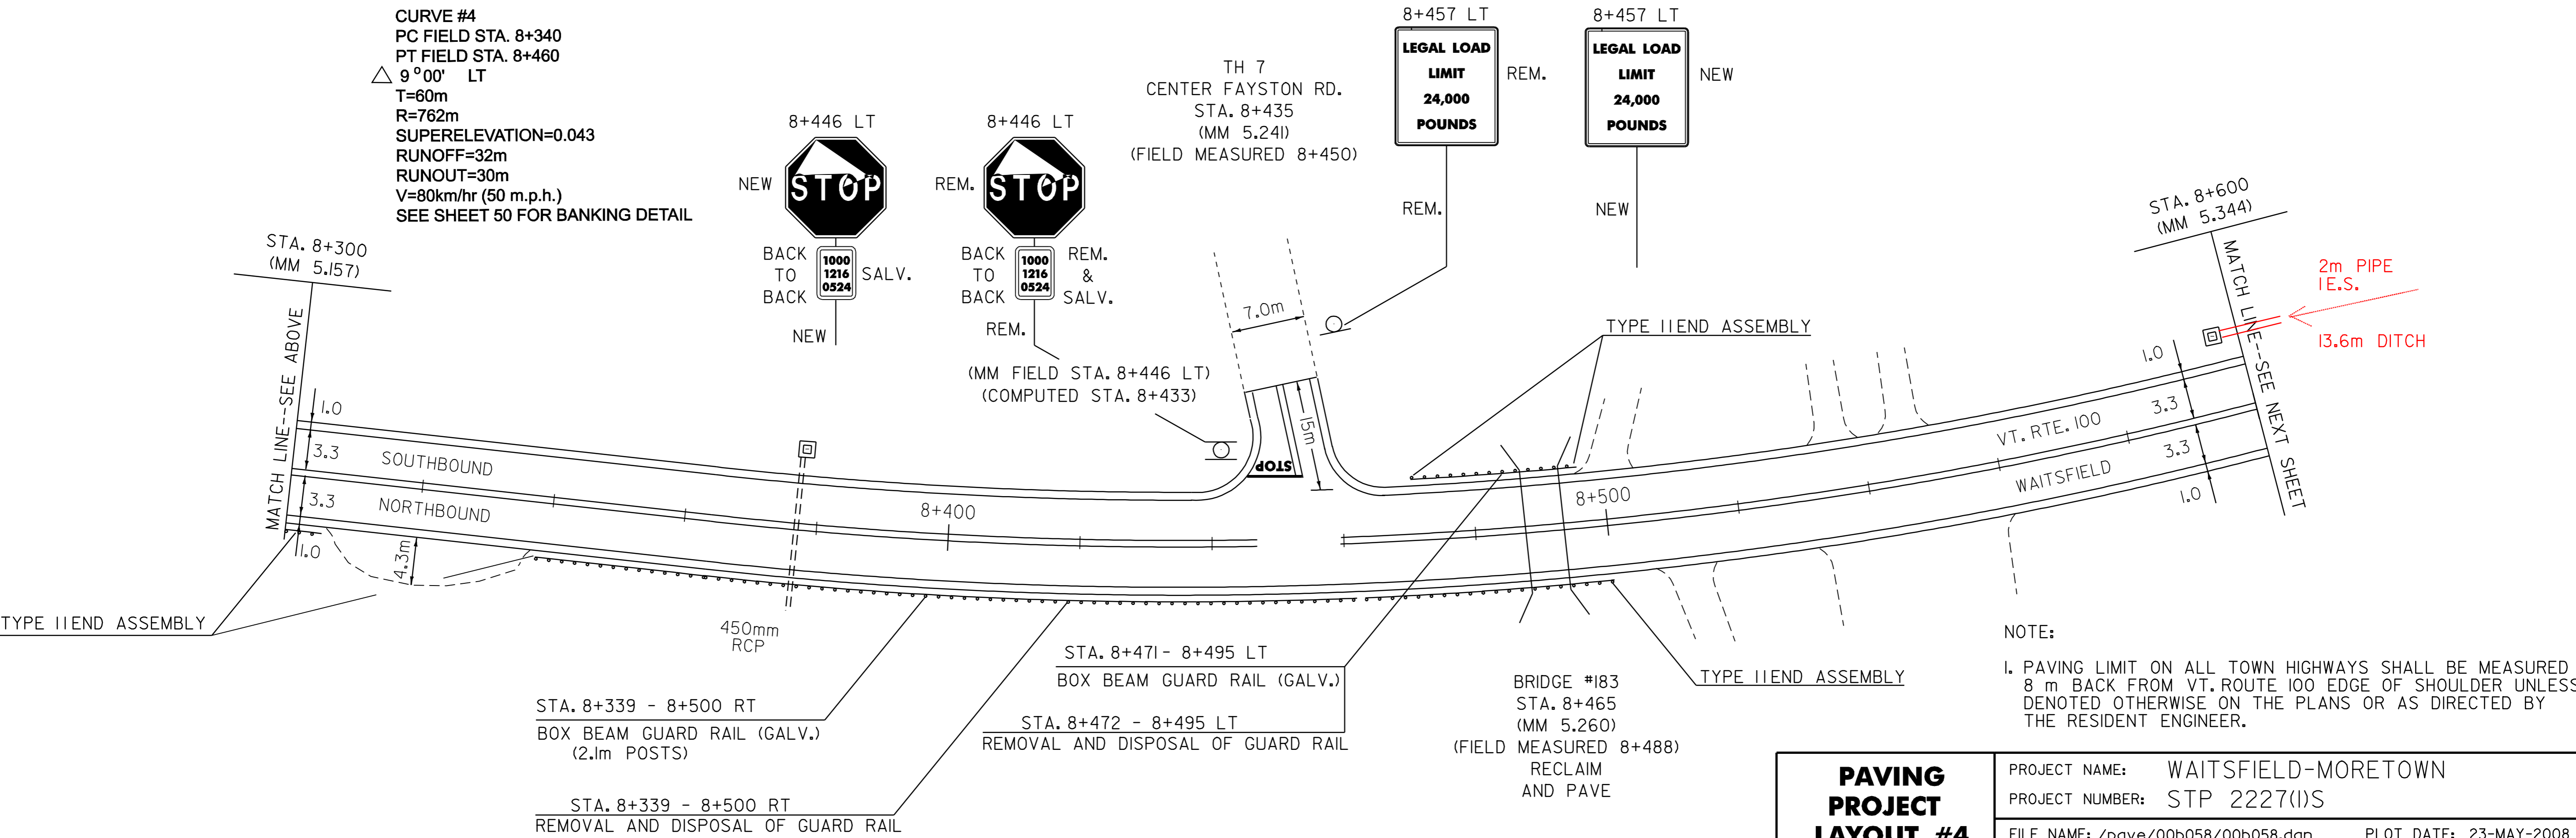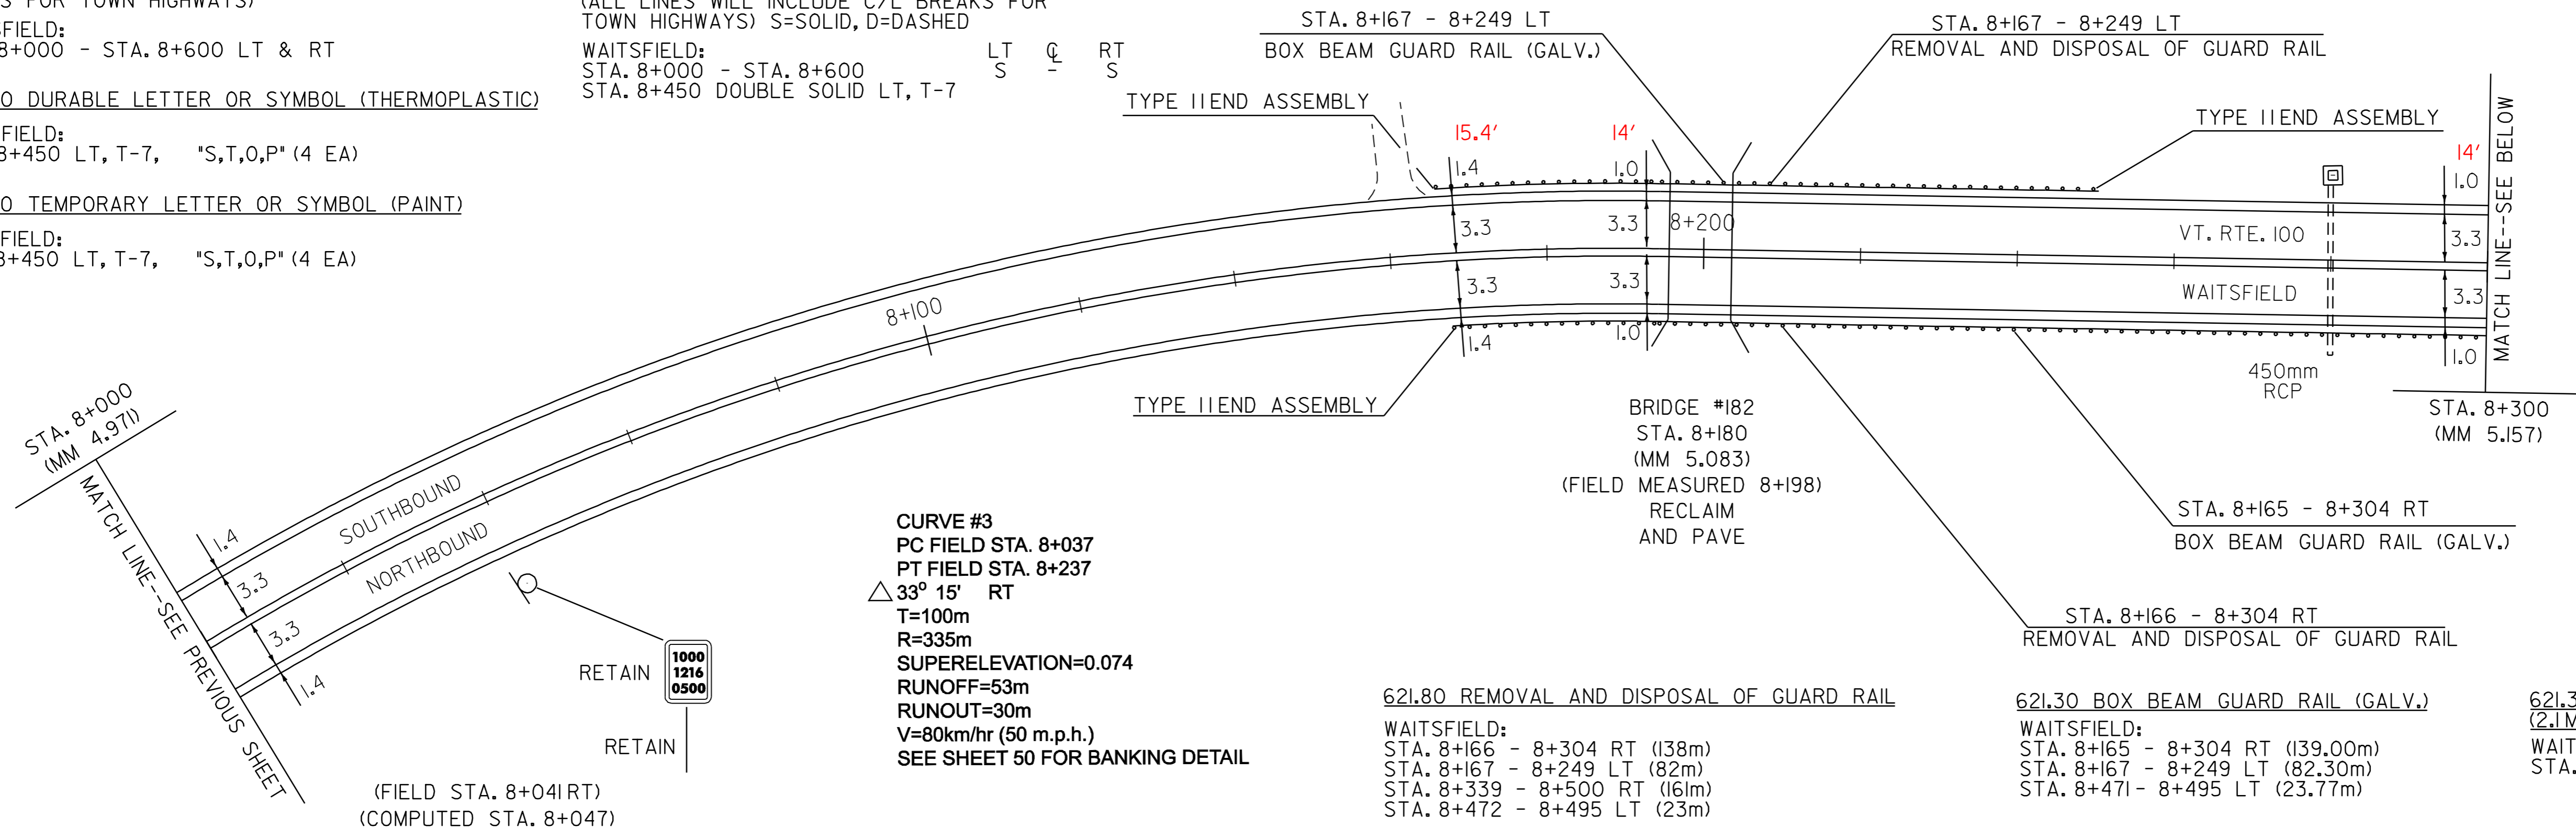

<b>PAVING PROJECT LAYOUT #4 VT. RTE. 100</b>	PROJECT NAME: WAITSFIELD-MORETOWN	PLOT DATE: 23-MAY-2008 12:30
	PROJECT NUMBER: STP 2227(1)S	DRAWN BY: J. REDMOND
	FILE NAME: /pave/00b058/00b058.dgn	DESIGNED BY: J. REDMOND
	00b058104.1	CHECKED BY: J. REDMOND
		SHEET 34 OF 54

NOT TO SCALE

**646.40 DURABLE 100 mm WHITE LINE (THERMOPLASTIC)**  
 (ALL LINES WILL INCLUDE EDGE LINE BREAKS AND RADIUS FOR TOWN HIGHWAYS)  
 WAITSFIELD:  
 STA. 8+600 - STA. 9+200 LT & RT

**646.4I DURABLE 100 mm YELLOW LINE (THERMOPLASTIC)**  
 (ALL LINES WILL INCLUDE C/L BREAKS FOR TOWN HIGHWAYS) S=SOLID, D=DASHED  
 WAITSFIELD:  
 STA. 8+600 - STA. 9+200 LT Q RT  
 S - S


**DITCHING LOCATION**  
 WAITSFIELD:  
 STA. 8+600 - 8+768 LT  
 STA. 8+600 - 8+680 RT  
 STA. 8+946 - 9+185 RT  
 STA. 9+125 - 9+200 LT

**621.30 BOX BEAM GUARD RAIL (GALV.) (2.1METER POSTS)**  
 WAITSFIELD:  
 STA. 8+729.5 - 8+746.5 LT (16.46m)  
 STA. 9+170.3 - 9+200.0 RT (29.67m)


**646.60 TEMPORARY 100 mm WHITE LINE (PAINT)**  
 (ALL LINES WILL INCLUDE EDGE LINE BREAKS AND RADIUS FOR TOWN HIGHWAYS)  
 WAITSFIELD:  
 STA. 8+600 - STA. 9+200 LT & RT

**646.6I TEMPORARY 100 mm YELLOW LINE (PAINT)**  
 (ALL LINES WILL INCLUDE C/L BREAKS FOR TOWN HIGHWAYS) S=SOLID, D=DASHED  
 WAITSFIELD:  
 STA. 8+600 - STA. 9+200 LT Q RT  
 S - S

**CURVE #5**  
 PC FIELD STA. 8+583  
 PT FIELD STA. 8+863  
 Δ 36° 30' LT  
 T=140m  
 R=425m  
 SUPERELEVATION=0.064  
 RUNOFF=46m  
 RUNOUT=30m  
 V=80km/hr (50 m.p.h.)  
 SEE SHEET 51 FOR BANKING DETAIL

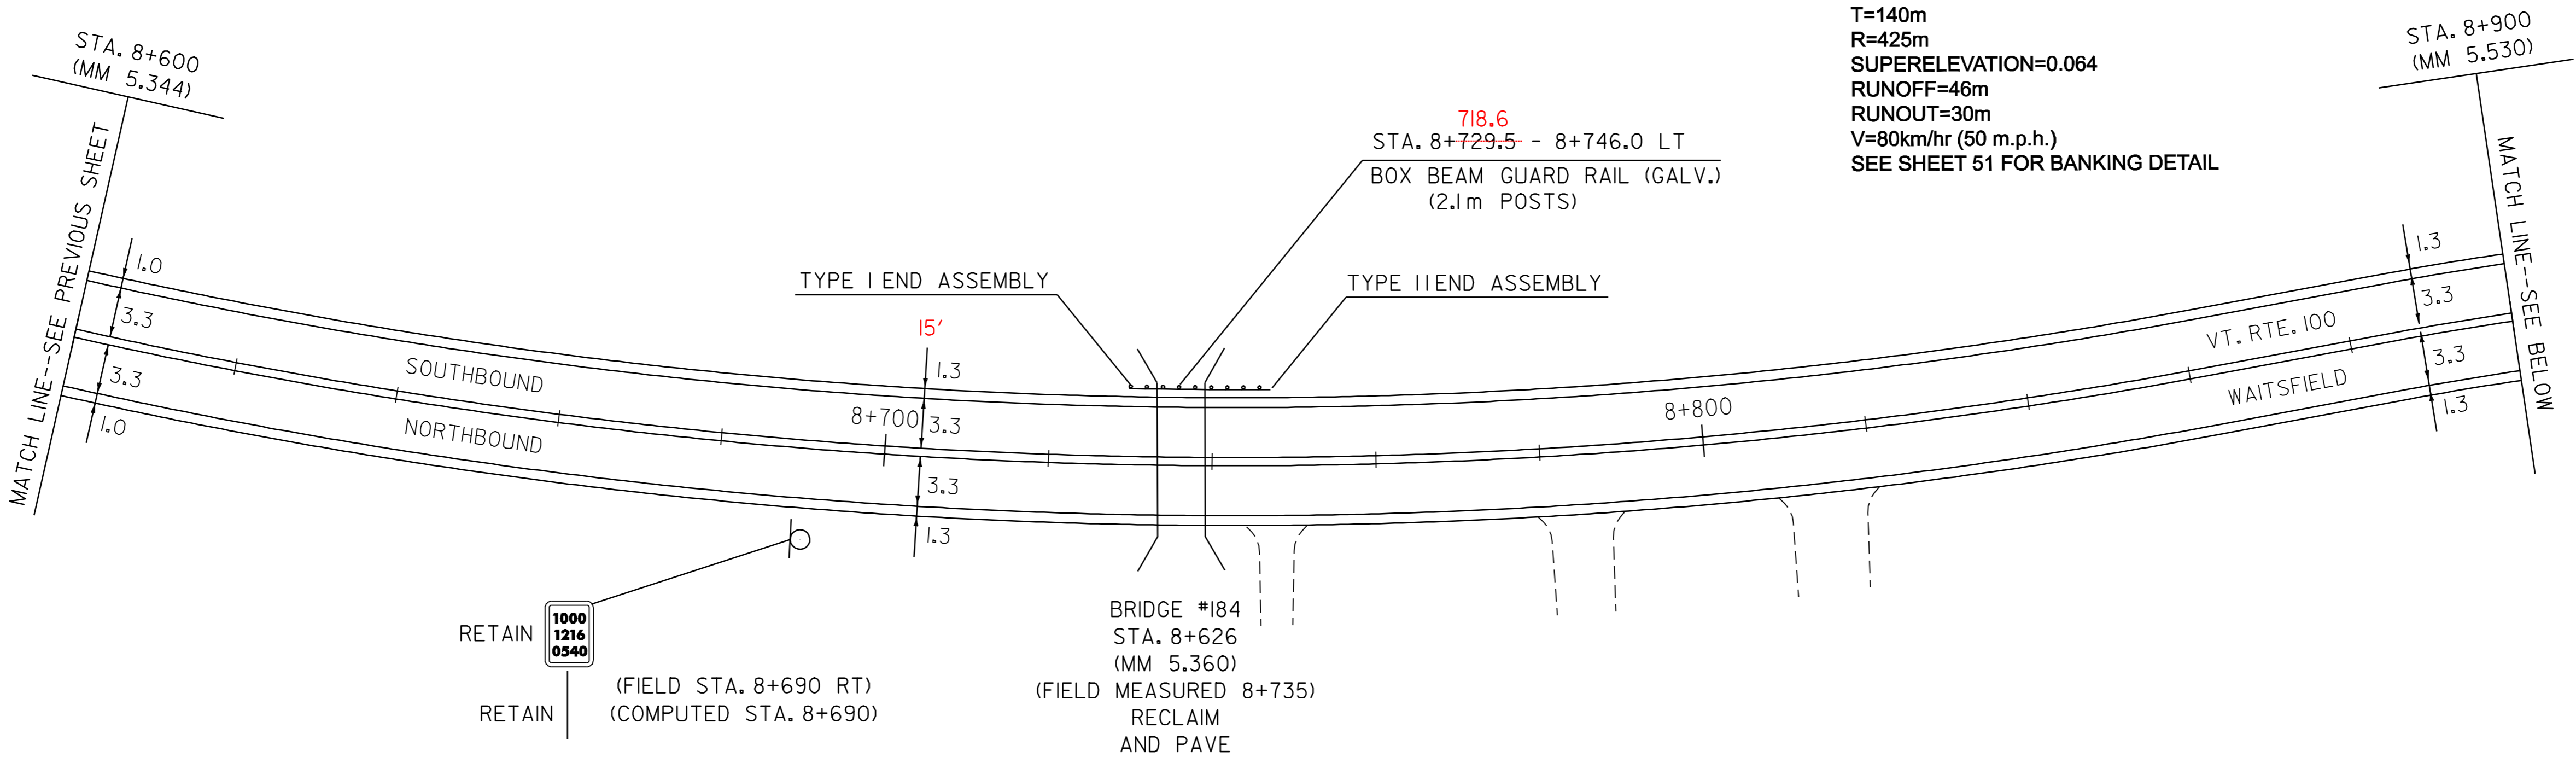

**CURVE #6**  
 PC FIELD STA. 8+960  
 PT FIELD STA. 9+120  
 Δ 30° 00' RT  
 T=80m  
 R=299m  
 SUPERELEVATION=0.076  
 RUNOFF=55m  
 RUNOUT=30m  
 V=80km/hr (50 m.p.h.)  
 SEE SHEET 51 FOR BANKING DETAIL

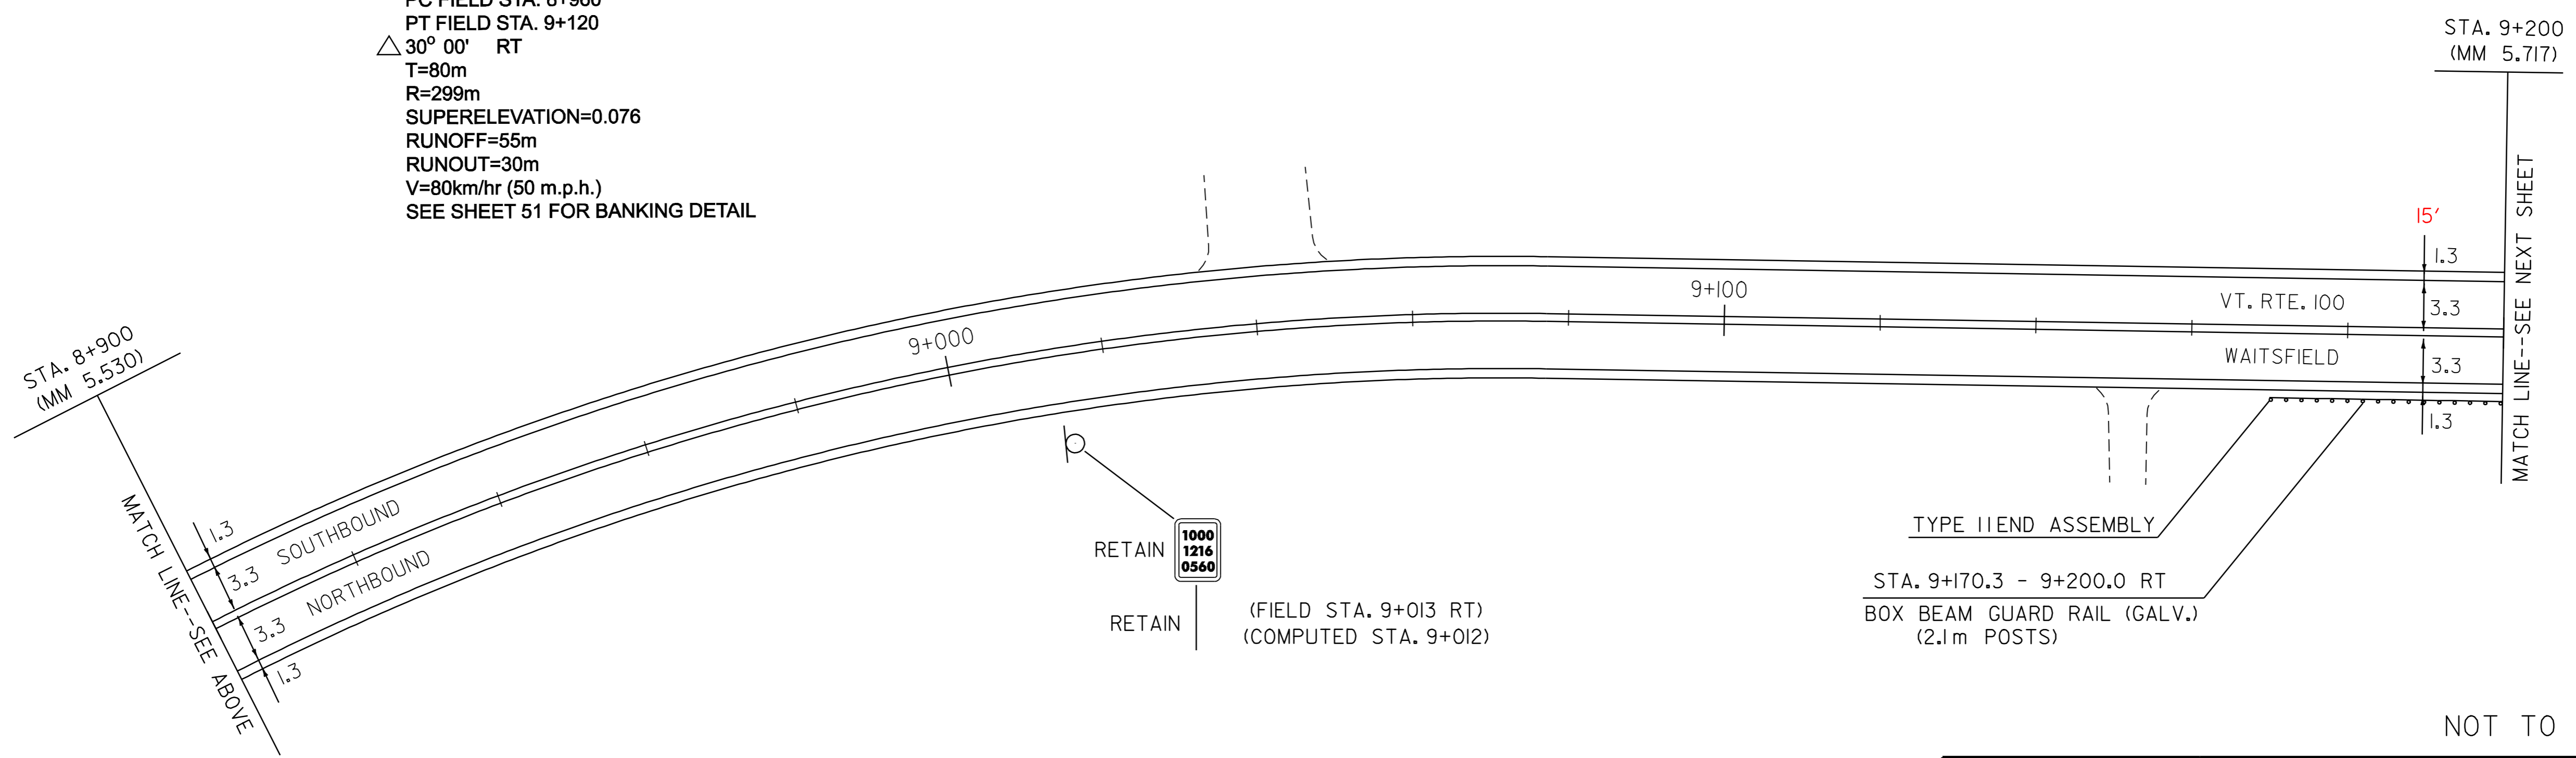

**NOTE:**  
 I. REFER TO SHEET 49 FOR DETAILS OF BOX BEAM GUARDRAIL SPANNING SMALL BRIDGES (BRIDGE # 184).

<b>PAVING PROJECT LAYOUT #5 VT. RTE. 100</b>	PROJECT NAME: WAITSFIELD-MORETOWN	PLOT DATE: 23-MAY-2008 12:3
	PROJECT NUMBER: STP 2227(I)S	DRAWN BY: J. REDMOND
	FILE NAME: /pave/00b058/00b058.dgn	CHECKED BY: J. REDMOND
	PROJECT LEADER: WOOLLAVER DESIGNED BY: J. REDMOND 00b058105.1	SHEET 35 OF 54

NOT TO SCALE

646.40 DURABLE 100 mm WHITE LINE (THERMOPLASTIC)  
 (ALL LINES WILL INCLUDE EDGE LINE BREAKS AND RADIUS FOR TOWN HIGHWAYS)

WAITSFIELD:  
 STA. 9+200 - STA. 9+800 LT & RT

646.60 TEMPORARY 100 mm WHITE LINE (PAINT)  
 (ALL LINES WILL INCLUDE EDGE LINE BREAKS AND RADIUS FOR TOWN HIGHWAYS)

WAITSFIELD:  
 STA. 9+200 - STA. 9+800 LT & RT

646.41 DURABLE 100 mm YELLOW LINE (THERMOPLASTIC)  
 (ALL LINES WILL INCLUDE C/L BREAKS FOR TOWN HIGHWAYS) S=SOLID, D=DASHED

WAITSFIELD:  
 STA. 9+200 - STA. 9+607 LT S C RT S D  
 STA. 9+607 - STA. 9+784 S S D  
 STA. 9+784 - STA. 9+800 S D S  
 STA. 9+227 DOUBLE SOLID LT, T-47

646.61 TEMPORARY 100 mm YELLOW LINE (PAINT)  
 (ALL LINES WILL INCLUDE C/L BREAKS FOR TOWN HIGHWAYS) S=SOLID, D=DASHED

WAITSFIELD:  
 STA. 9+200 - STA. 9+607 LT S C RT S D  
 STA. 9+607 - STA. 9+784 S S D  
 STA. 9+784 - STA. 9+800 S D S  
 STA. 9+227 DOUBLE SOLID LT, T-47

646.46 DURABLE 600 mm STOP BAR (THERMOPLASTIC)

WAITSFIELD:  
 STA. 9+227 LT, T-47

646.66 TEMPORARY 600 mm STOP BAR (PAINT)

WAITSFIELD:  
 STA. 9+227 LT, T-47

646.50 DURABLE LETTER OR SYMBOL (THERMOPLASTIC)

WAITSFIELD:  
 STA. 9+227 LT, T-47, "S,T,O,P" (4 EA)

646.70 TEMPORARY LETTER OR SYMBOL (PAINT)

WAITSFIELD:  
 STA. 9+227 LT, T-47, "S,T,O,P" (4 EA)

REMOVING SIGNS  
 3 AS SHOWN


619.17 YIELDING MARKER POSTS

WAITSFIELD:  
 STA. 9+740 LT & RT (2)

DITCHING LOCATION



WAITSFIELD:  
 STA. 9+200 - 9+214 LT

TH 47  
 FARNWORTH RD.  
 STA. 9+194  
 (MM 5.713)  
 (FIELD MEASURED 9+227)

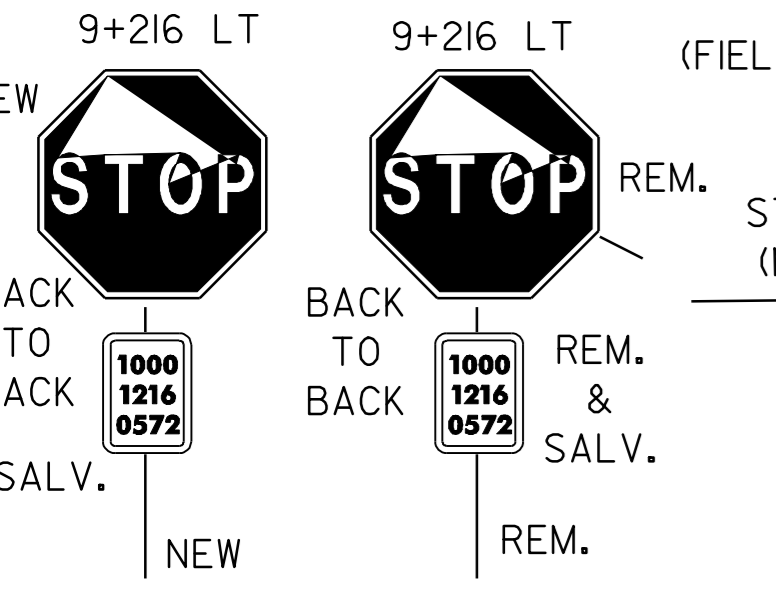

9+216 LT  
 (MM FIELD STA. 9+216 LT)  
 (COMPUTED STA. 9+205)

STA. 9+200.0 - 9+238.0 RT  
 BOX BEAM GUARD RAIL (GALV.)  
 (2.1m POSTS)

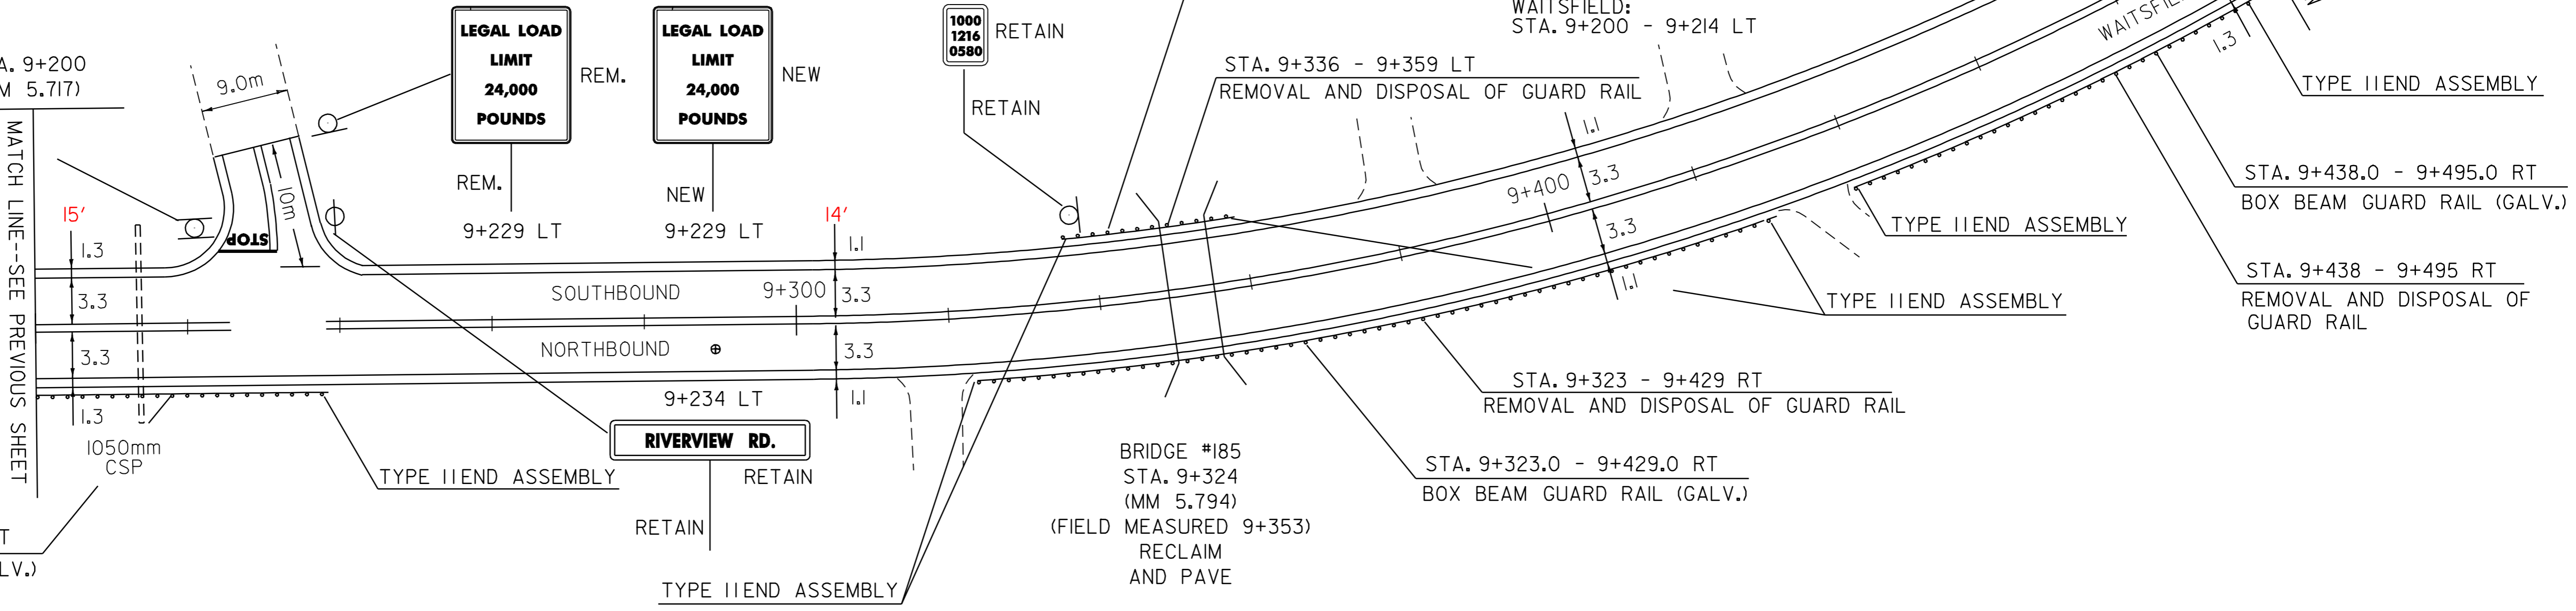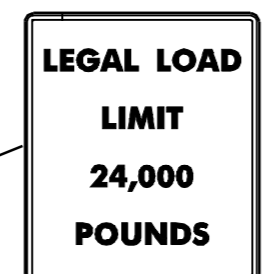

621.80 REMOVAL AND DISPOSAL OF GUARD RAIL

WAITSFIELD:  
 STA. 9+323 - 9+429 RT (106m)  
 STA. 9+336 - 9+359 LT (23m)  
 STA. 9+438 - 9+720 RT (57m)  
 STA. 9+526 - 9+720 RT (194m)

**CURVE #7**  
 PC FIELD STA. 9+346  
 PT FIELD STA. 9+646  
 38° 45' LT  
 T=150m  
 R=427m  
 SUPERELEVATION=0.064  
 RUNOFF=46m  
 RUNOUT=30m  
 V=80km/hr (50 m.p.h.)  
 SEE SHEET 51 FOR BANKING DETAIL

621.30 BOX BEAM GUARD RAIL (GALV.)

WAITSFIELD:  
 STA. 9+323.0 - 9+429.0 RT (106.07m)  
 STA. 9+438.0 - 9+495.0 RT (56.69m)  
 STA. 9+526.0 - 9+720.0 RT (193.85m)


621.30 BOX BEAM GUARD RAIL (GALV.)  
 (2.1METER POSTS)

WAITSFIELD:  
 STA. 9+200.0 - 9+238.0 RT (38.0m)

621.30 BOX BEAM GUARD RAIL (GALV.) (MOD. 3)

WAITSFIELD:  
 STA. 9+335.0 - 9+359.0 LT (23.98m)

STA. 9+500  
 (MM 5.903)

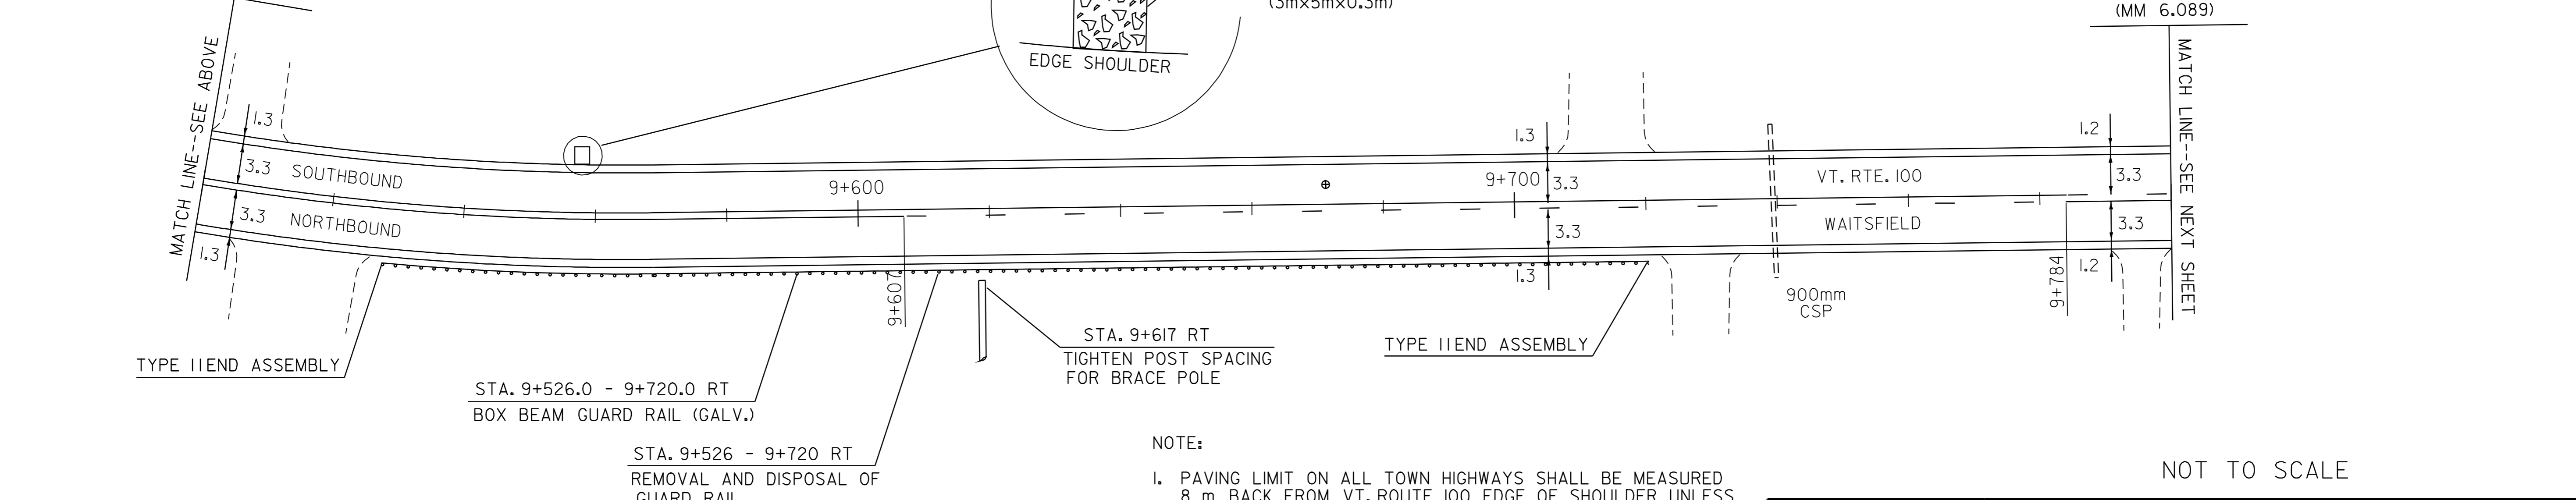

STA. 9+526.0 - 9+720.0 RT  
 BOX BEAM GUARD RAIL (GALV.)

STA. 9+526 - 9+720 RT  
 REMOVAL AND DISPOSAL OF  
 GUARD RAIL

STA. 9+617 RT  
 TIGHTEN POST SPACING  
 FOR BRACE POLE

NOTE:

- PAVING LIMIT ON ALL TOWN HIGHWAYS SHALL BE MEASURED 8 m BACK FROM VT. ROUTE 100 EDGE OF SHOULDER UNLESS DENOTED OTHERWISE ON THE PLANS OR AS DIRECTED BY THE RESIDENT ENGINEER.
- REFER TO SHEETS 45 AND 48 FOR DETAILS OF BOX BEAM GUARDRAIL (GALVANIZED) (MOD. 3) ON BRIDGE # 185.
- REFER TO SHEET 49 FOR DETAILS OF BOX BEAM GUARDRAIL POST SPACING AT NON-YIELDING OBJECTS.

NOT TO SCALE

**PAVING  
 PROJECT  
 LAYOUT #6  
 VT. RTE. 100**

PROJECT NAME:	WAITSFIELD-MORETOWN
PROJECT NUMBER:	STP 2227(1)S
FILE NAME:	/pave/00b058/00b058.dgn
PROJECT LEADER:	WOOLAVER
DESIGNED BY:	J. REDMOND
PLOT DATE:	23-MAY-2008 12:3
DRAWN BY:	J. REDMOND
CHECKED BY:	J. REDMOND
SHEET	36 OF 54

CORE NO.	LOCATION	DEPTH (mm)
3	9+288 RT	175
5	9+672 LT	163

**646.40 DURABLE 100 mm WHITE LINE (THERMOPLASTIC)**  
 (ALL LINES WILL INCLUDE EDGE LINE BREAKS AND RADIUS FOR TOWN HIGHWAYS)  
 WAITSFIELD:  
 STA. 9+800 - STA. 10+400 LT & RT

**646.41 DURABLE 100 mm YELLOW LINE (THERMOPLASTIC)**  
 (ALL LINES WILL INCLUDE C/L BREAKS FOR TOWN HIGHWAYS) S=SOLID, D=DASHED  
 WAITSFIELD:  
 STA. 9+800 - STA. 10+018 LT D S  
 STA. 10+018 - STA. 10+400 S S

**604.412 REHABILITATION OF DI, CB OR MH**  
 WAITSFIELD:  
 STA. 10+007 LT (THROATED)  
 STA. 10+226 LT (THROATED)  
 STA. 10+393 LT (ROUND)

**619.17 YIELDING MARKER POSTS**  
 WAITSFIELD:  
 STA. 9+875 LT & RT (2)  
 STA. 10+007 LT & RT (2)  
 STA. 10+226 LT & RT (2)  
 STA. 10+273 LT & RT (2)  
 STA. 10+393 LT & RT (2)

**646.60 TEMPORARY 100 mm WHITE LINE (PAINT)**  
 (ALL LINES WILL INCLUDE EDGE LINE BREAKS AND RADIUS FOR TOWN HIGHWAYS)  
 WAITSFIELD:  
 STA. 9+800 - STA. 10+400 LT & RT


**646.61 TEMPORARY 100 mm YELLOW LINE (PAINT)**  
 (ALL LINES WILL INCLUDE C/L BREAKS FOR TOWN HIGHWAYS) S=SOLID, D=DASHED  
 WAITSFIELD:  
 STA. 9+800 - STA. 10+018 LT D S  
 STA. 10+018 - STA. 10+400 S S

**617.10 RELOCATE MAILBOX - SINGLE SUPPORT**  
 WAITSFIELD:  
 STA. 10+339 RT

**617.12 RELOCATE MAILBOX - MULTIPLE SUPPORT**  
 WAITSFIELD:  
 STA. 9+879 RT (2 BOX SUPPORT)

**DITCHING LOCATION**  
 WAITSFIELD:  
 STA. 10+100 - 10+117 LT  
 STA. 10+140 - 10+273 LT  
 STA. 10+273 RT (CLEAN CULVERT OUTLET DITCH)

**REMOVING SIGNS**  
 3 AS SHOWN

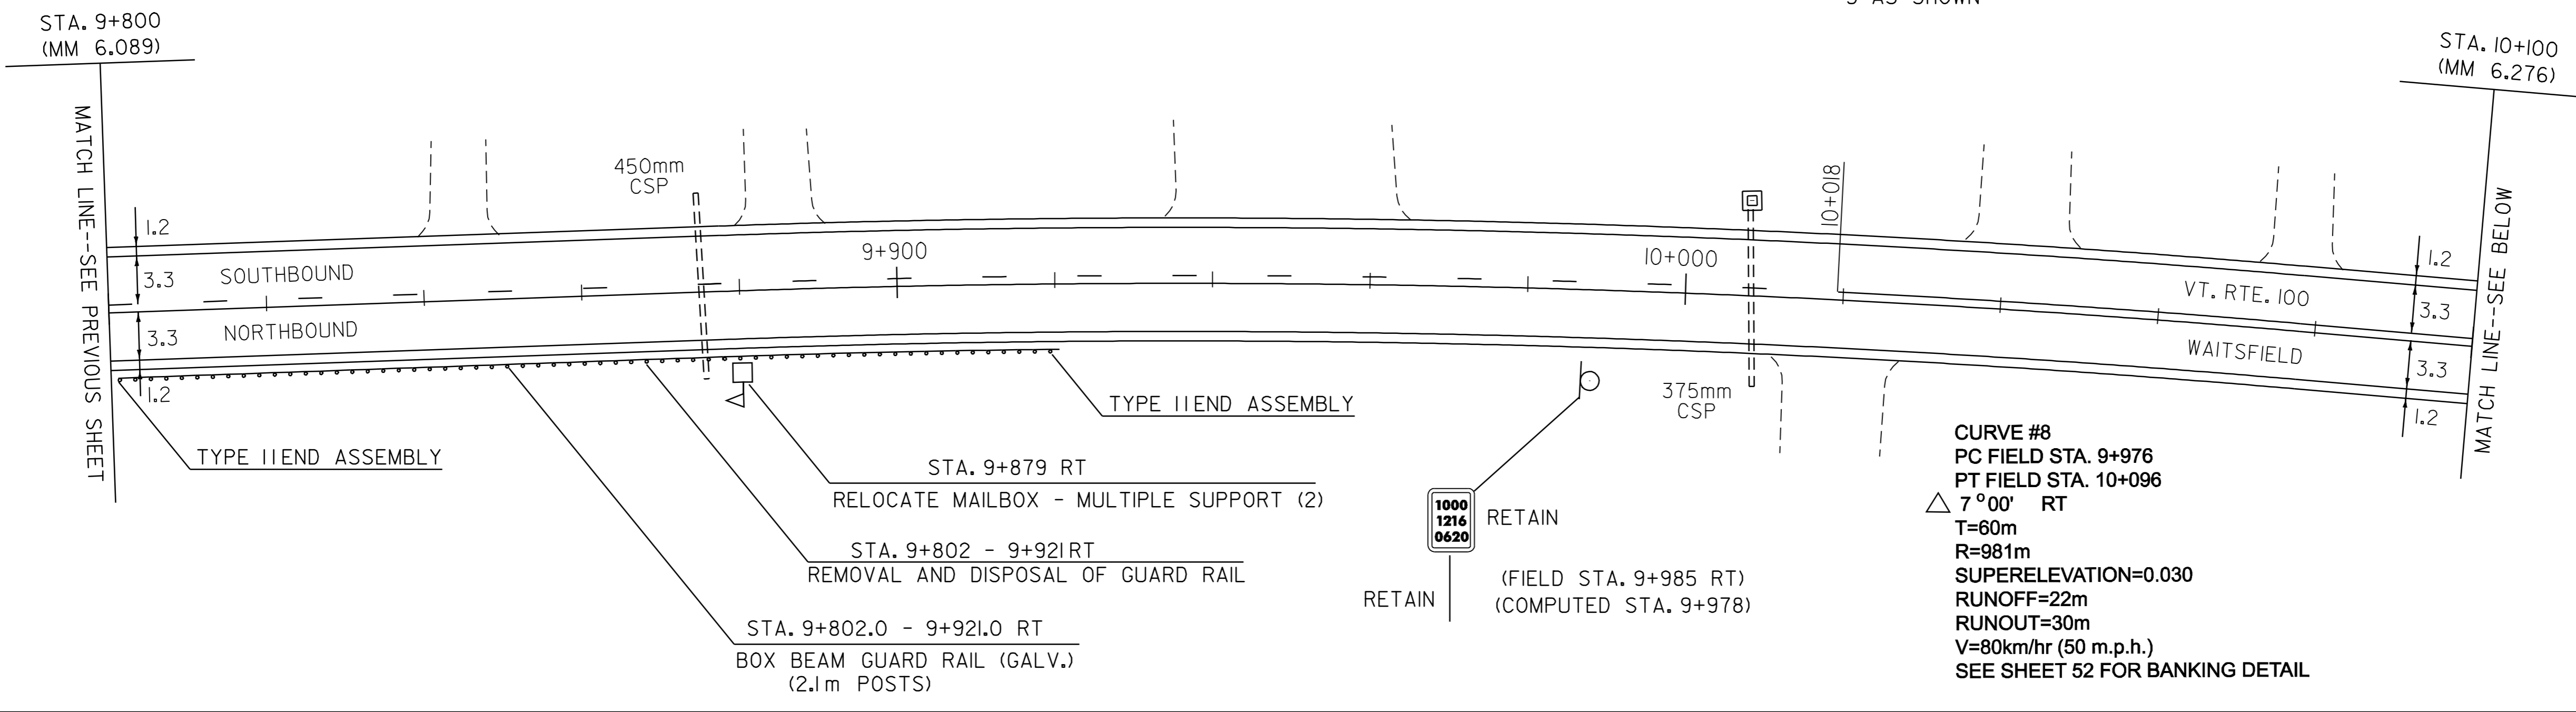

**621.81 REMOVAL AND DISPOSAL OF GUIDE POSTS**  
 WAITSFIELD:  
 STA. 10+328 RT (1 EACH)


**621.80 REMOVAL AND DISPOSAL OF GUARD RAIL**  
 WAITSFIELD:  
 STA. 9+802 - 9+921 RT (119m)  
 STA. 10+140 - 10+284 RT (144m)  
 STA. 10+316 RT (61m ALONG TH #9)  
 STA. 10+331 - 10+400 RT (69m)

**621.30 BOX BEAM GUARD RAIL (GALV.)**  
 WAITSFIELD:  
 STA. 10+331.0 - 10+400.0 RT (69.00m)

**621.30 BOX BEAM GUARD RAIL (GALV.) (2.1 METER POSTS)**  
 WAITSFIELD:  
 STA. 9+802.0 - 9+921.0 RT (118.87m)  
 STA. 10+140.0 - 10+284.0 RT (144.48m)  
 STA. 10+316.0 RT (62.18m ALONG TH #9)

**621.30 BOX BEAM GUARD RAIL (GALV.)**  
 STA. 10+331.0 - 10+400.0 RT

**CURVE #9**  
 PC FIELD STA. 10+290  
 PT FIELD STA. 10+490  
 Δ 24° 00' LT  
 T=100m  
 R=524m  
 SUPERELEVATION=0.058  
 RUNOFF=41m  
 RUNOUT=30m  
 V=80km/hr (50 m.p.h.)  
 SEE SHEET 52 FOR DETAIL

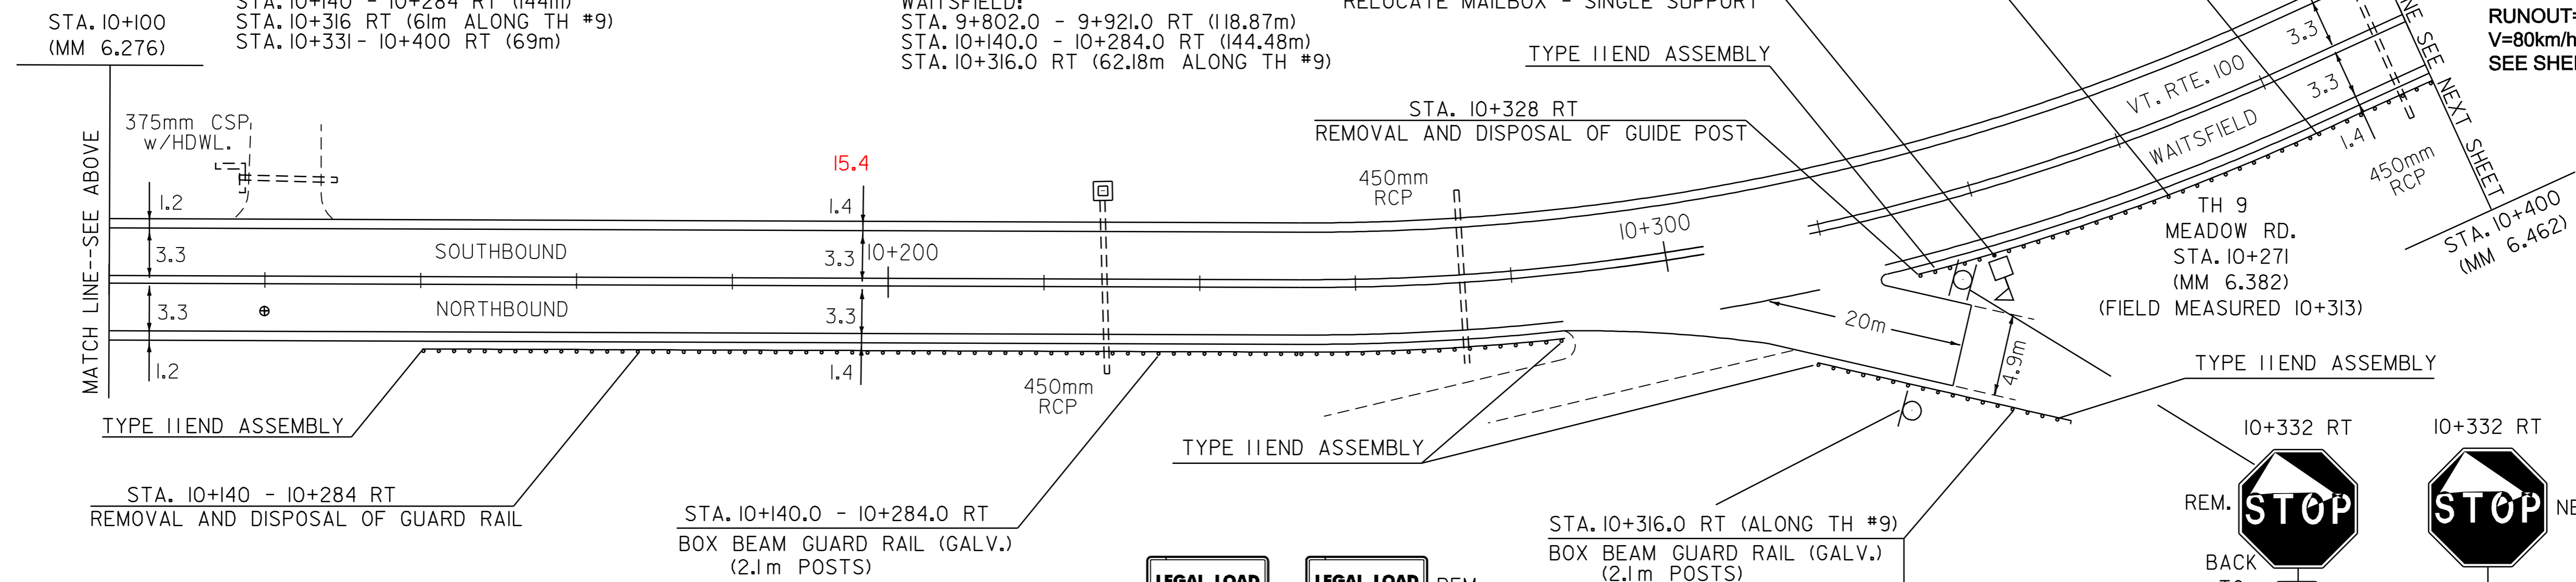

CORE NO.	LOCATION	DEPTH (mm)
4	10+120 RT	165

**PAVING PROJECT LAYOUT #7 VT. RTE. 100**

PROJECT NAME: WAITSFIELD-MORETOWN  
 PROJECT NUMBER: STP 2227(1)S  
 FILE NAME: /pave/00b058/00b058.dgn  
 PROJECT LEADER: WOOLAVER  
 DESIGNED BY: J. REDMOND  
 00b058107.1

PLOT DATE: 23-MAY-2008 12:5  
 DRAWN BY: J. REDMOND  
 CHECKED BY: J. REDMOND  
 SHEET 37 OF 54

NOT TO SCALE

REMOVING SIGNS  
8 AS SHOWN

646.40 DURABLE 100 mm WHITE LINE (THERMOPLASTIC)  
(ALL LINES WILL INCLUDE EDGE LINE BREAKS AND RADIUS FOR TOWN HIGHWAYS)

WAITSFIELD:  
STA. 10+400 - STA. 11+000 LT & RT

646.60 TEMPORARY 100 mm WHITE LINE (PAINT)  
(ALL LINES WILL INCLUDE EDGE LINE BREAKS AND RADIUS FOR TOWN HIGHWAYS)

WAITSFIELD:  
STA. 10+400 - STA. 11+000 LT & RT

646.41 DURABLE 100 mm YELLOW LINE (THERMOPLASTIC)  
(ALL LINES WILL INCLUDE C/L BREAKS FOR TOWN HIGHWAYS) S=SOLID, D=DASHED

WAITSFIELD:  
STA. 10+400 - STA. 10+960 LT S C RT S  
STA. 10+960 - STA. 11+000 D S S  
STA. 10+775 DOUBLE SOLID LT, T-6

646.61 TEMPORARY 100 mm YELLOW LINE (PAINT)  
(ALL LINES WILL INCLUDE C/L BREAKS FOR TOWN HIGHWAYS) S=SOLID, D=DASHED

WAITSFIELD:  
STA. 10+400 - STA. 10+960 LT S C RT S  
STA. 10+960 - STA. 11+000 D S S  
STA. 10+775 DOUBLE SOLID LT, T-6

646.46 DURABLE 600 mm STOP BAR (THERMOPLASTIC)

WAITSFIELD:  
STA. 10+775 LT, T-6

646.66 TEMPORARY 600 mm STOP BAR (PAINT)

WAITSFIELD:  
STA. 10+775 LT, T-6

646.50 DURABLE LETTER OR SYMBOL (THERMOPLASTIC)

WAITSFIELD:  
STA. 10+775 LT, T-6, "S,T,O,P" (4 EA)

646.70 TEMPORARY LETTER OR SYMBOL (PAINT)

WAITSFIELD:  
STA. 10+775 LT, T-6, "S,T,O,P" (4 EA)



604.412 REHABILITATION OF  
DI, CB OR MH



WAITSFIELD:  
STA. 10+480 LT

619.17 YIELDING MARKER POSTS

WAITSFIELD:  
STA. 10+480 LT & RT (2)

DITCHING LOCATION

WAITSFIELD:  
STA. 10+456 - 10+486 LT  
STA. 10+523 - 10+632 LT  
STA. 10+643 - 10+676 LT  
STA. 10+641 - 10+696 RT

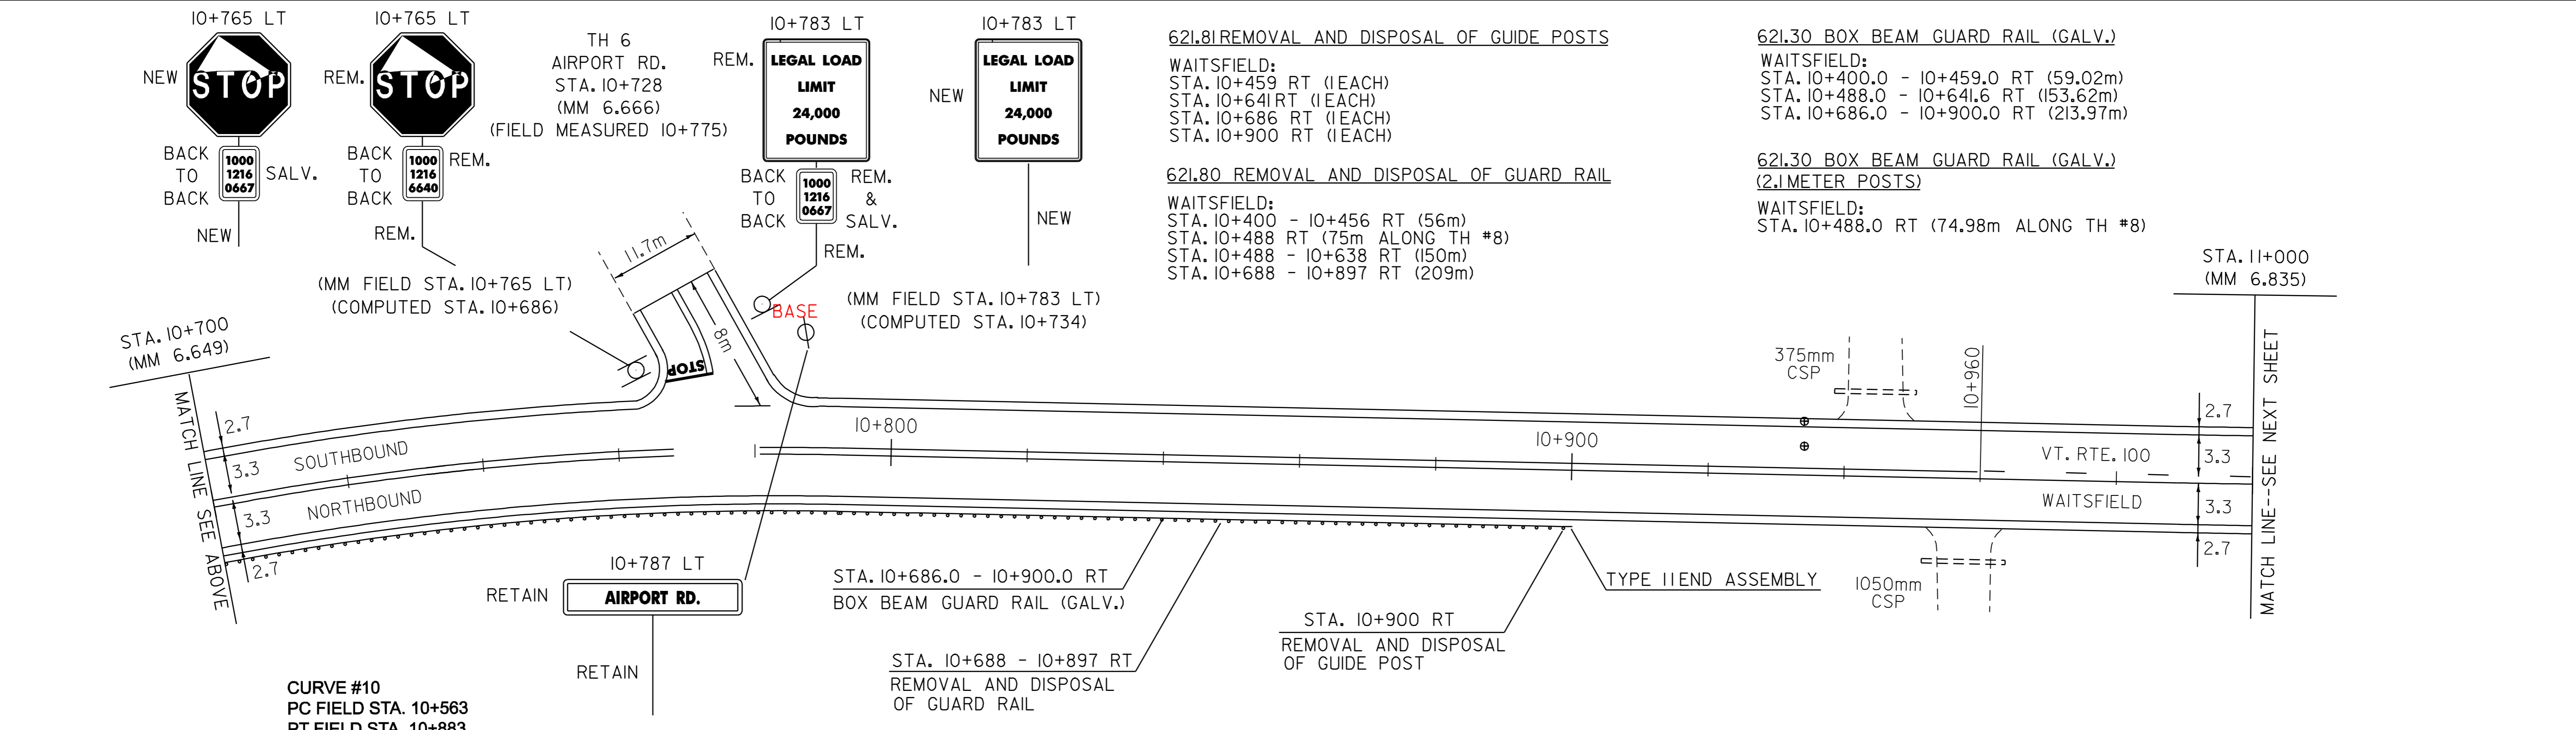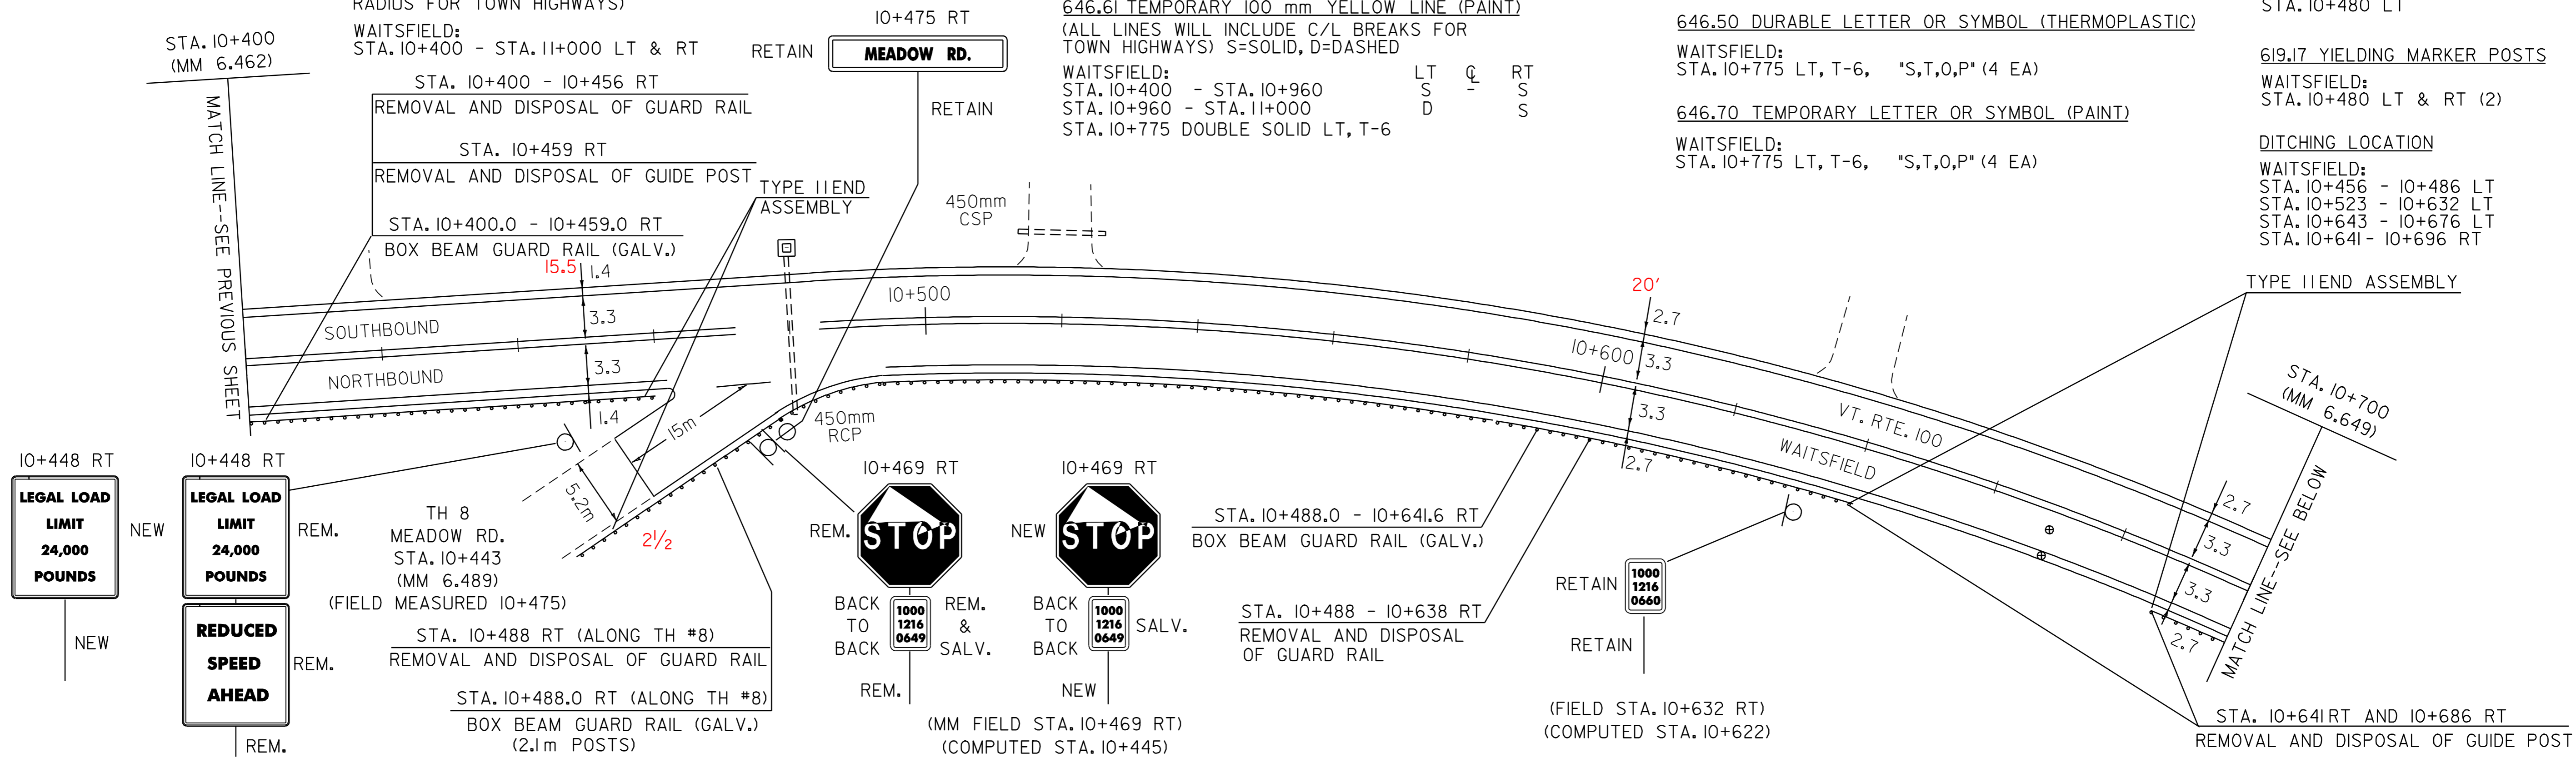

**CURVE #10**  
PC FIELD STA. 10+563  
PT FIELD STA. 10+883  
39° 00' RT  
T=160m  
R=452m  
SUPERELEVATION=0.062  
RUNOFF=45m  
RUNOUT=30m  
V=80km/hr (50 m.p.h.)  
SEE SHEET 52 FOR BANKING DETAIL

- NOTE:
- PAVING LIMIT ON ALL TOWN HIGHWAYS SHALL BE MEASURED 8 m BACK FROM VT. ROUTE 100 EDGE OF SHOULDER UNLESS DENOTED OTHERWISE ON THE PLANS OR AS DIRECTED BY THE RESIDENT ENGINEER.
  - THERE SHALL NOT BE ANY PAVEMENT MARKINGS PLACED ON TH 8. THE MAINLINE EDGELINE AND CENTERLINE SHALL HAVE A GAP FOR THE INTERSECTION.

**PAVING  
PROJECT  
LAYOUT #8  
VT. RTE. 100**

PROJECT NAME: WAITSFIELD-MORETOWN  
PROJECT NUMBER: STP 2227(1)S  
FILE NAME: /pave/00b058/00b058.dgn  
PROJECT LEADER: WOOLAVER  
DESIGNED BY: J. REDMOND  
00b058108.1  
PLOT DATE: 23-MAY-2008 12:30  
DRAWN BY: J. REDMOND  
CHECKED BY: J. REDMOND  
SHEET 38 OF 54

CORE NO.	LOCATION	DEPTH (mm)
7	10+668 RT	119
8	10+668 RT 113 (SHLD.)	
11	10+934 LT	100
12	10+934 LT 119 (SHLD.)	

NOT TO SCALE

**646.40 DURABLE 100 mm WHITE LINE (THERMOPLASTIC)**  
 (ALL LINES WILL INCLUDE EDGE LINE BREAKS AND RADIUS FOR TOWN HIGHWAYS)

WAITSFIELD:  
 STA. 11+000 - STA. 11+600 LT & RT

**646.60 TEMPORARY 100 mm WHITE LINE (PAINT)**  
 (ALL LINES WILL INCLUDE EDGE LINE BREAKS AND RADIUS FOR TOWN HIGHWAYS)

WAITSFIELD:  
 STA. 11+000 - STA. 11+600 LT & RT

**646.41 DURABLE 100 mm YELLOW LINE (THERMOPLASTIC)**  
 (ALL LINES WILL INCLUDE C/L BREAKS FOR TOWN HIGHWAYS) S=SOLID, D=DASHED

WAITSFIELD:  
 STA. 11+000 - STA. 11+184 LT D S  
 STA. 11+184 - STA. 11+600 S S  
 STA. 11+314 DOUBLE SOLID LT, T-2

**646.61 TEMPORARY 100 mm YELLOW LINE (PAINT)**  
 (ALL LINES WILL INCLUDE C/L BREAKS FOR TOWN HIGHWAYS) S=SOLID, D=DASHED

WAITSFIELD:  
 STA. 11+000 - STA. 11+184 LT D S  
 STA. 11+184 - STA. 11+600 S S  
 STA. 11+314 DOUBLE SOLID LT, T-2

**646.46 DURABLE 600 mm STOP BAR (THERMOPLASTIC)**

WAITSFIELD:  
 STA. 11+314 LT, T-2

**646.66 TEMPORARY 600 mm STOP BAR (PAINT)**

WAITSFIELD:  
 STA. 11+314 LT, T-2

**646.50 DURABLE LETTER OR SYMBOL (THERMOPLASTIC)**

WAITSFIELD:  
 STA. 11+314 LT, T-2, "S,T,O,P" (4 EA)

**646.70 TEMPORARY LETTER OR SYMBOL (PAINT)**

WAITSFIELD:  
 STA. 11+314 LT, T-2, "S,T,O,P" (4 EA)



**DITCHING LOCATION**

WAITSFIELD:  
 STA. 11+070 - 11+172 LT  
 STA. 11+182 - 11+308 LT

**REMOVING SIGNS**

2 AS SHOWN

**CURVE #11**  
 PC FIELD STA. 11+064  
 PT FIELD STA. 11+204  
 Δ 4°00' LT  
 T=70m  
 R=2005m  
 SUPERELEVATION=0.021  
 RUNOFF=14m  
 RUNOUT=30m  
 V=80km/hr (50 m.p.h.)  
 SEE SHEET 53 FOR BANKING DETAIL

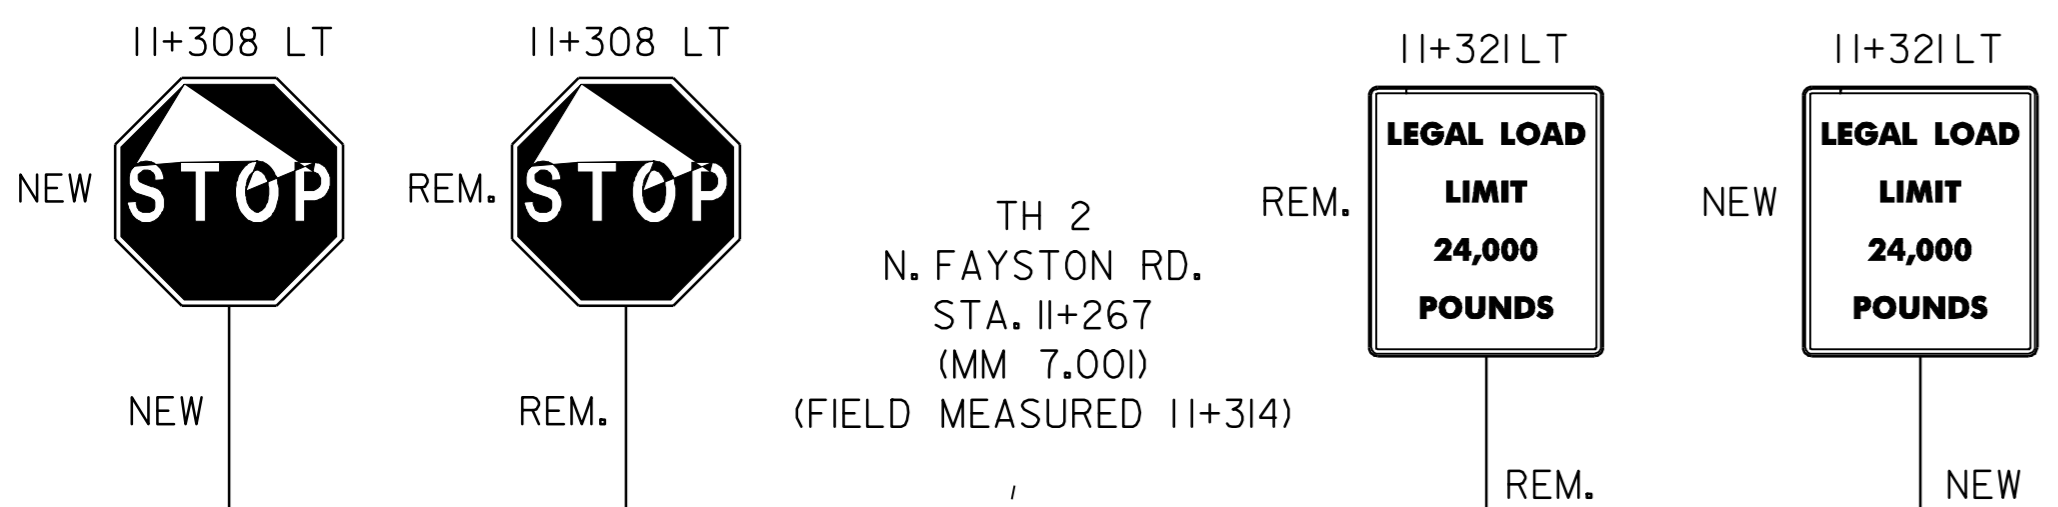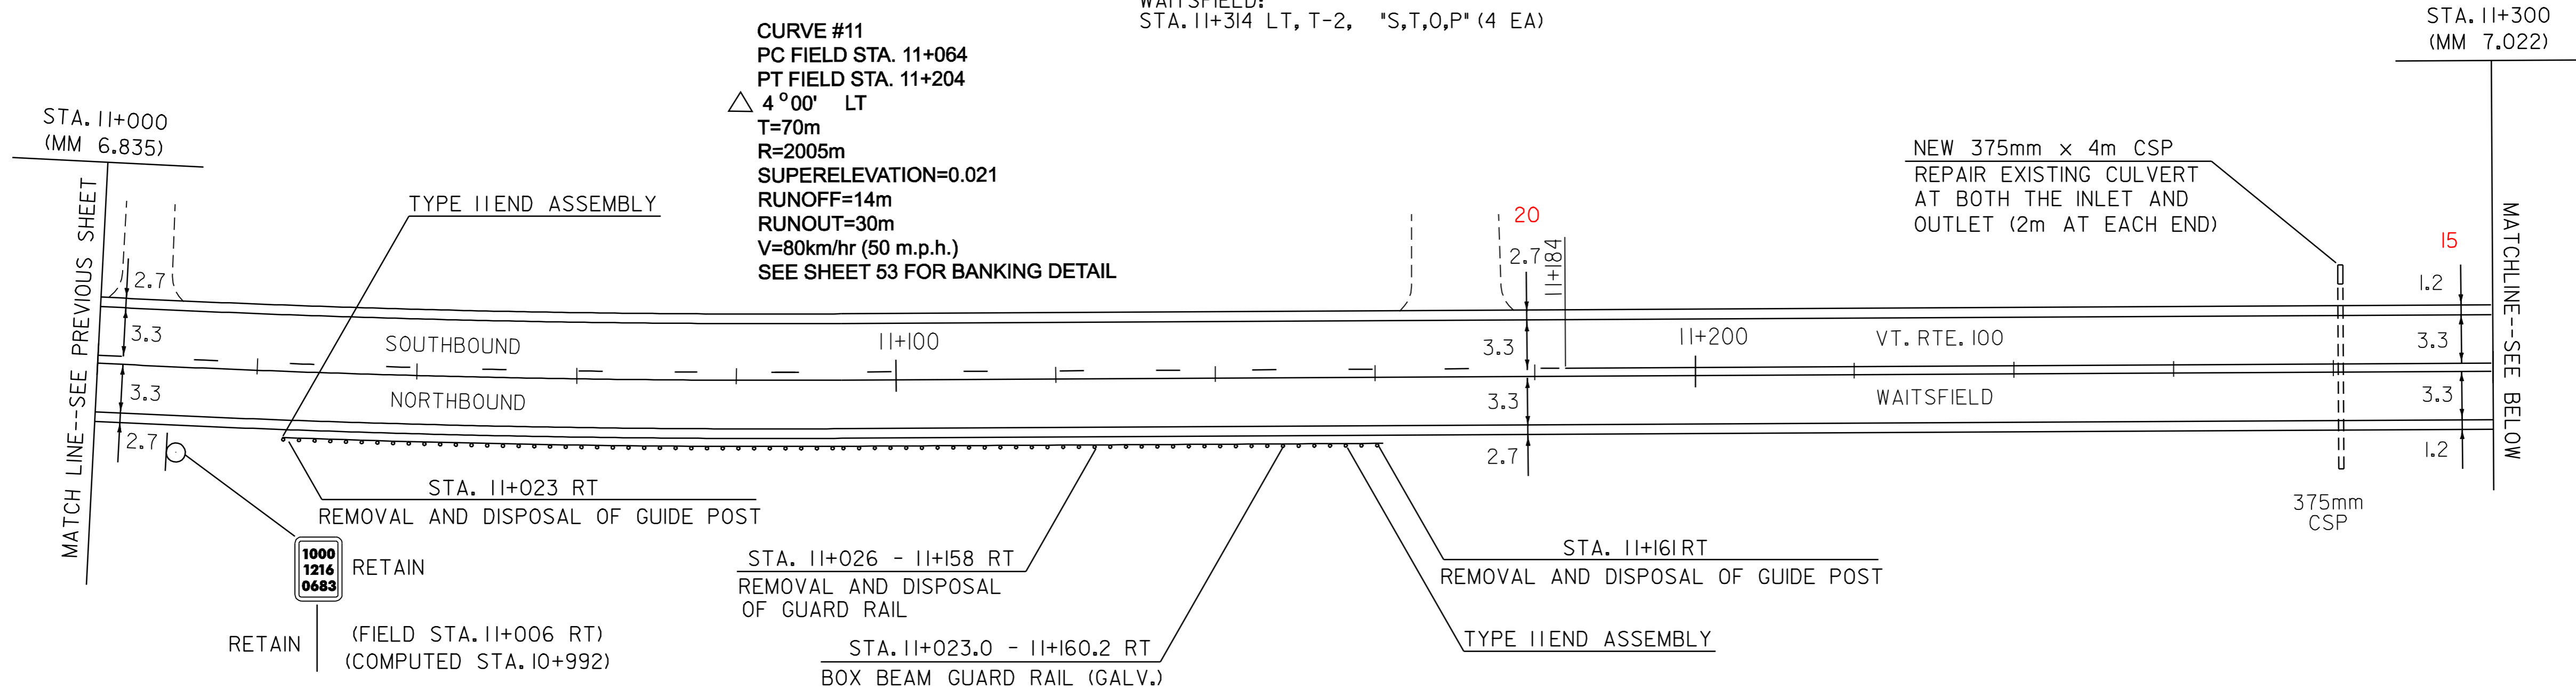

**621.81 REMOVAL AND DISPOSAL OF GUIDE POSTS**  
 WAITSFIELD:  
 STA. 11+023 RT (1 EACH)  
 STA. 11+161 RT (1 EACH)

**621.80 REMOVAL AND DISPOSAL OF GUARD RAIL**  
 WAITSFIELD:  
 STA. 11+026 - 11+158 RT (132m)  
 STA. 11+456 - 11+466 RT (10m)  
 STA. 11+458 - 11+467 LT (9m)  
 STA. 11+492 - 11+502 RT (10m)  
 STA. 11+493 - 11+505 LT (12m)


**525.10 REMOVAL OF EXISTING RAILING**  
 WAITSFIELD:  
 STA. 11+466 - 11+492 RT (26m)  
 STA. 11+467 - 11+493 LT (26m)

**621.30 BOX BEAM GUARD RAIL (GALV.)**  
 WAITSFIELD:  
 STA. 11+023.0 - 11+160.2 RT (137.16m)

**621.30 BOX BEAM GUARD RAIL (GALV.) (MOD. 3)**  
 WAITSFIELD:  
 STA. 11+456.14 - 11+501.86 RT (45.72m)  
 STA. 11+457.14 - 11+502.86 LT (45.72m)

STA. 11+458 - 11+467 LT & STA. 11+493 - 11+505 LT  
 REMOVAL AND DISPOSAL OF GUARD RAIL  
 STA. 11+467 - 11+493 LT  
 REMOVAL OF EXISTING RAIL  
 STA. 11+457.14 - 11+502.86 LT  
 BOX BEAM GUARD RAIL (GALV.) (MOD. 3)

BRIDGE #186  
 STA. 11+433  
 (MM 7.104)  
 (FIELD MEASURED 11+479)  
 COLD PLANE  
 AND PAVE

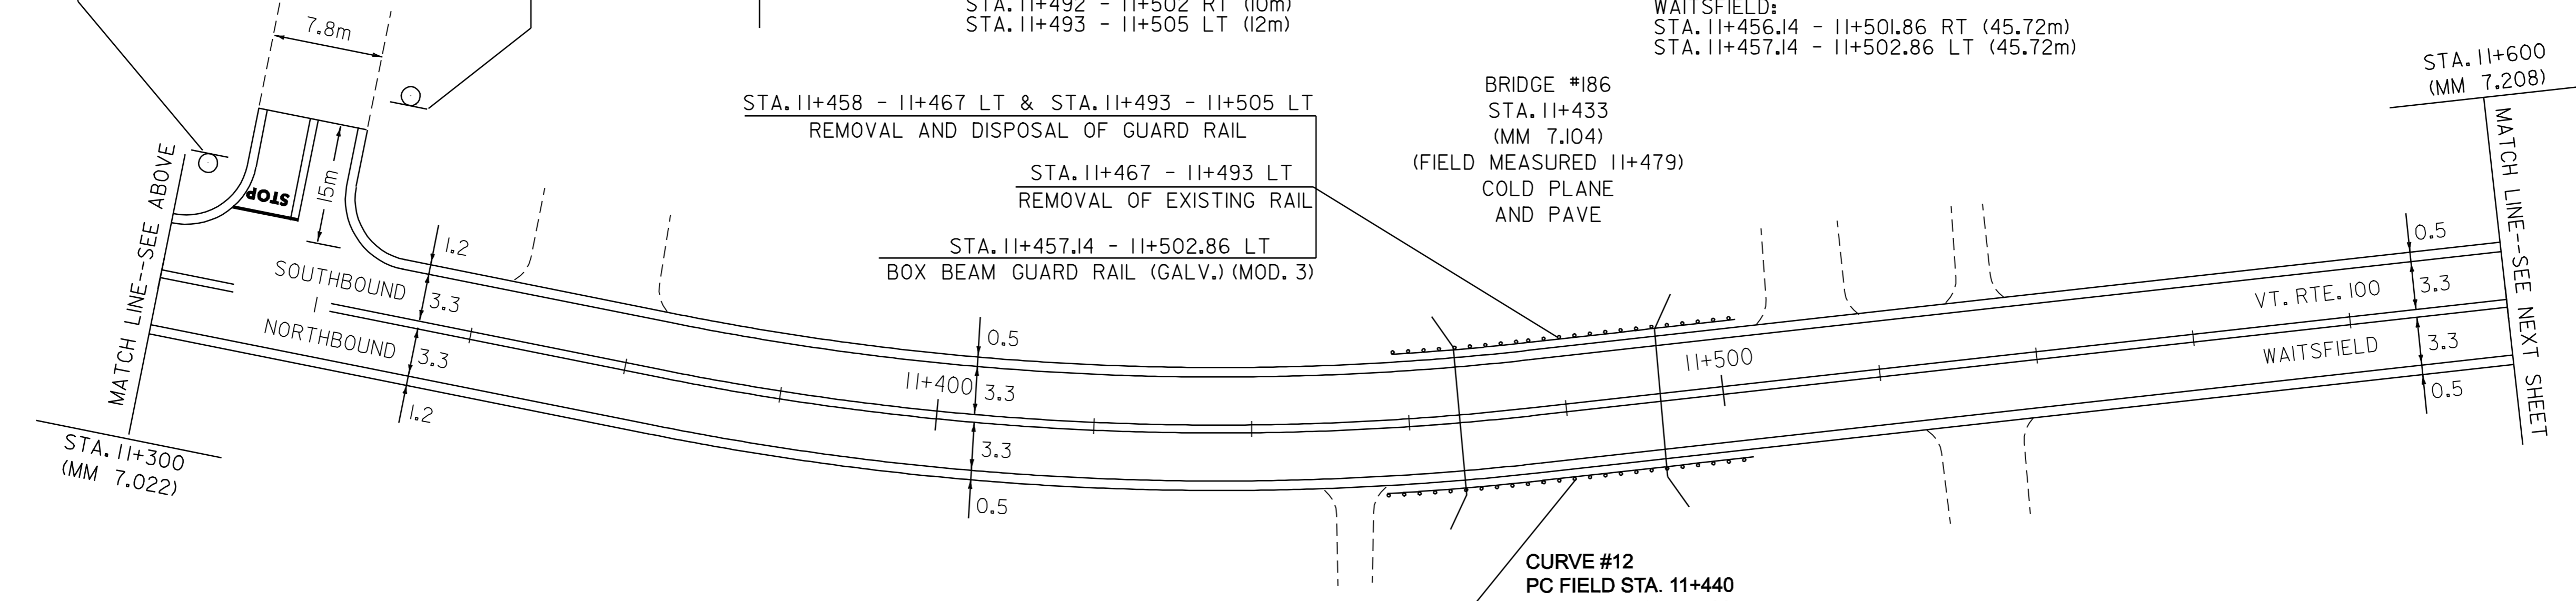

STA. 11+456 - 11+466 RT & STA. 11+492 - 11+502 RT  
 REMOVAL AND DISPOSAL OF GUARD RAIL  
 STA. 11+466 - 11+492 RT  
 REMOVAL OF EXISTING RAIL  
 STA. 11+456.14 - 11+501.86 RT  
 BOX BEAM GUARD RAIL (GALV.) (MOD. 3)

**CURVE #12**  
 PC FIELD STA. 11+440  
 PT FIELD STA. 11+520  
 Δ 17°30' LT  
 T=40m  
 R=260m  
 SUPERELEVATION=0.079  
 RUNOFF=57m  
 RUNOUT=30m  
 V=80km/hr (50 m.p.h.)  
 SEE SHEET 53 FOR BANKING DETAIL

**NOTE:**  
 1. PAVING LIMIT ON ALL TOWN HIGHWAYS SHALL BE MEASURED 8 m BACK FROM VT. ROUTE 100 EDGE OF SHOULDER UNLESS DENOTED OTHERWISE ON THE PLANS OR AS DIRECTED BY THE RESIDENT ENGINEER.  
 2. REFER TO SHEETS 45 AND 47 FOR DETAILS OF BOX BEAM GUARDRAIL (GALVANIZED) (MOD. 3) ON BRIDGE # 186.

**PAVING PROJECT LAYOUT #9 VT. RTE. 100**

PROJECT NAME: WAITSFIELD-MORETOWN  
 PROJECT NUMBER: STP 2227(1)S  
 FILE NAME: /pave/00b058/00b058.dgn  
 PROJECT LEADER: WOOLAVER  
 DESIGNED BY: J. REDMOND  
 00b058109.1  
 PLOT DATE: 23-MAY-2008 12:30  
 DRAWN BY: J. REDMOND  
 CHECKED BY: J. REDMOND  
 SHEET 39 OF 54

NOT TO SCALE

646.40 DURABLE 100 mm WHITE LINE (THERMOPLASTIC)  
 (ALL LINES WILL INCLUDE EDGE LINE BREAKS AND RADIUS FOR TOWN HIGHWAYS)

WAITSFIELD:  
 STA. 11+600 - STA. 12+199 LT & RT

646.60 TEMPORARY 100 mm WHITE LINE (PAINT)  
 (ALL LINES WILL INCLUDE EDGE LINE BREAKS AND RADIUS FOR TOWN HIGHWAYS)

WAITSFIELD:  
 STA. 11+600 - STA. 12+199 LT & RT

646.41 DURABLE 100 mm YELLOW LINE (THERMOPLASTIC)  
 (ALL LINES WILL INCLUDE C/L BREAKS FOR TOWN HIGHWAYS) S=SOLID, D=DASHED

WAITSFIELD:  
 STA. 11+600 - STA. 12+199 LT CL RT  
 S - S

646.61 TEMPORARY 100 mm YELLOW LINE (PAINT)  
 (ALL LINES WILL INCLUDE C/L BREAKS FOR TOWN HIGHWAYS) S=SOLID, D=DASHED



WAITSFIELD:  
 STA. 11+600 - STA. 12+199 LT CL RT  
 S - S

619.17 YIELDING MARKER POSTS

WAITSFIELD:  
 STA. 11+907 LT & RT (2)

DITCHING LOCATION

WAITSFIELD:  
 STA. 11+787 - 11+810 LT  
 STA. 11+907 RT (CLEAN CULV. OUTLET DITCH)

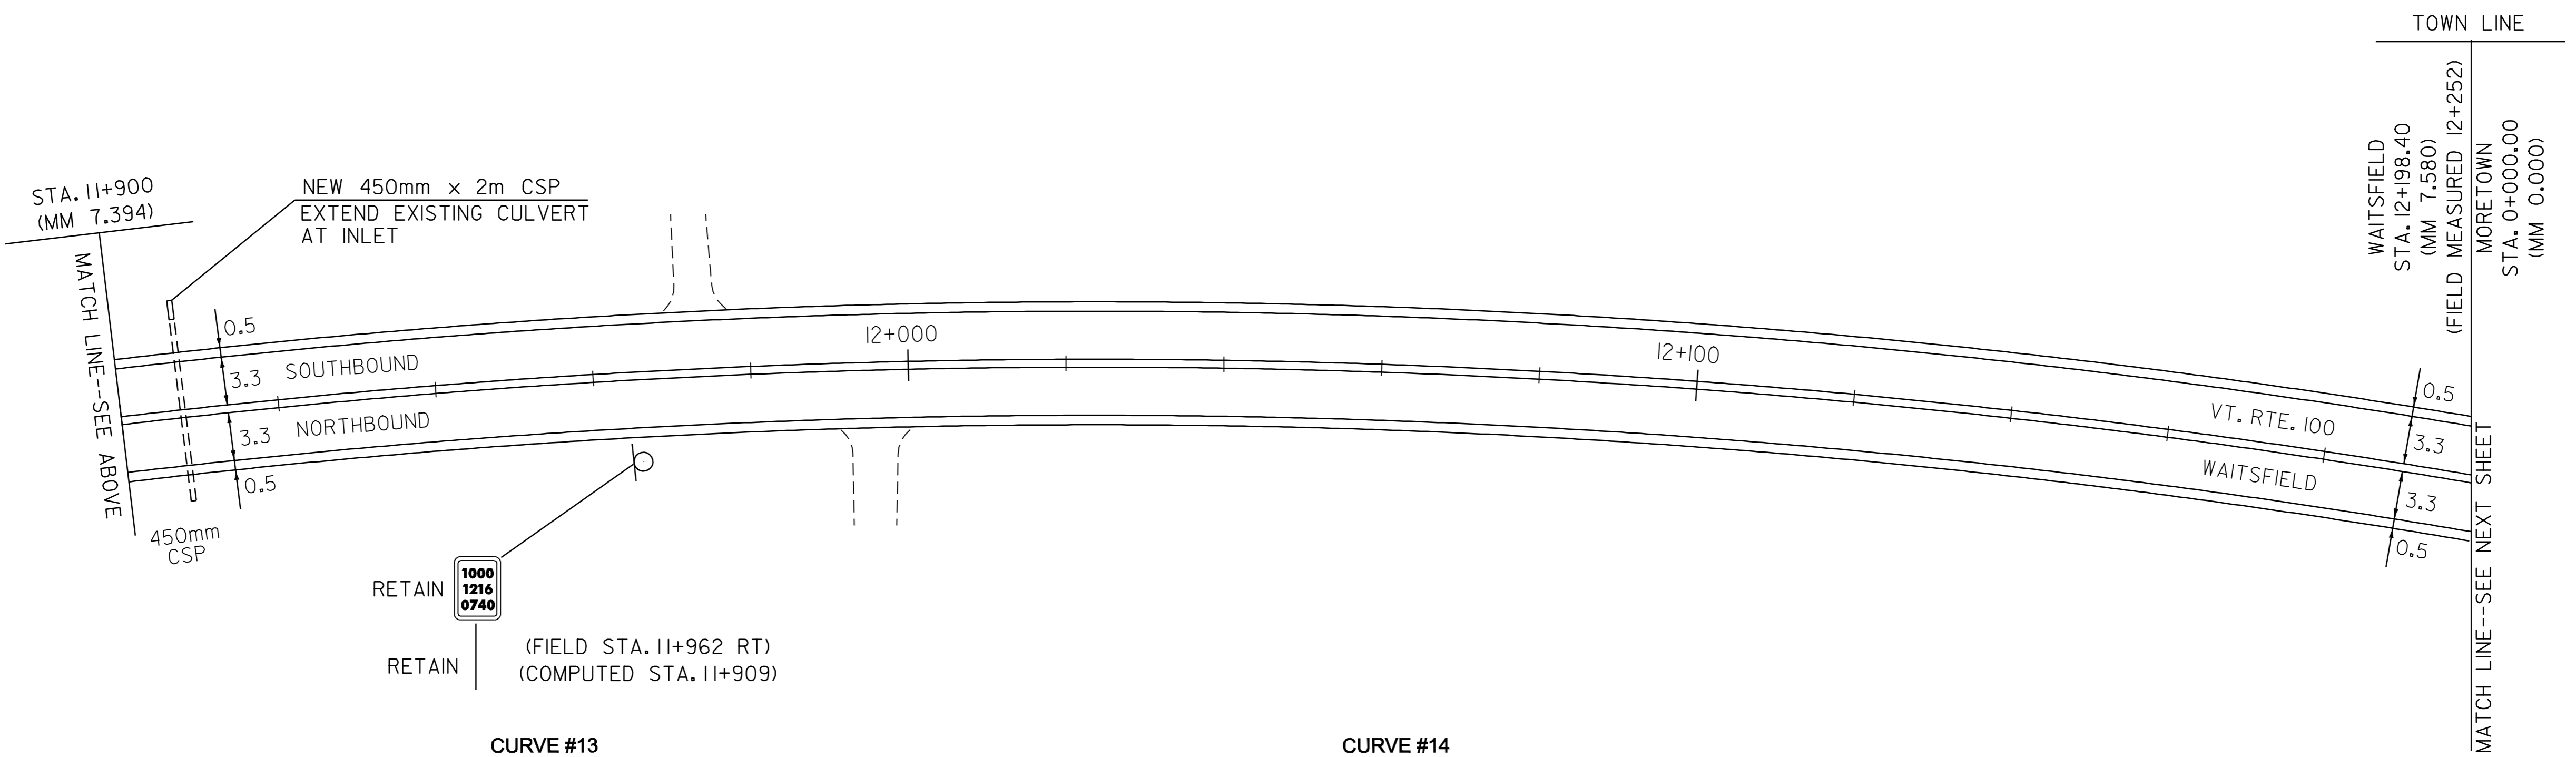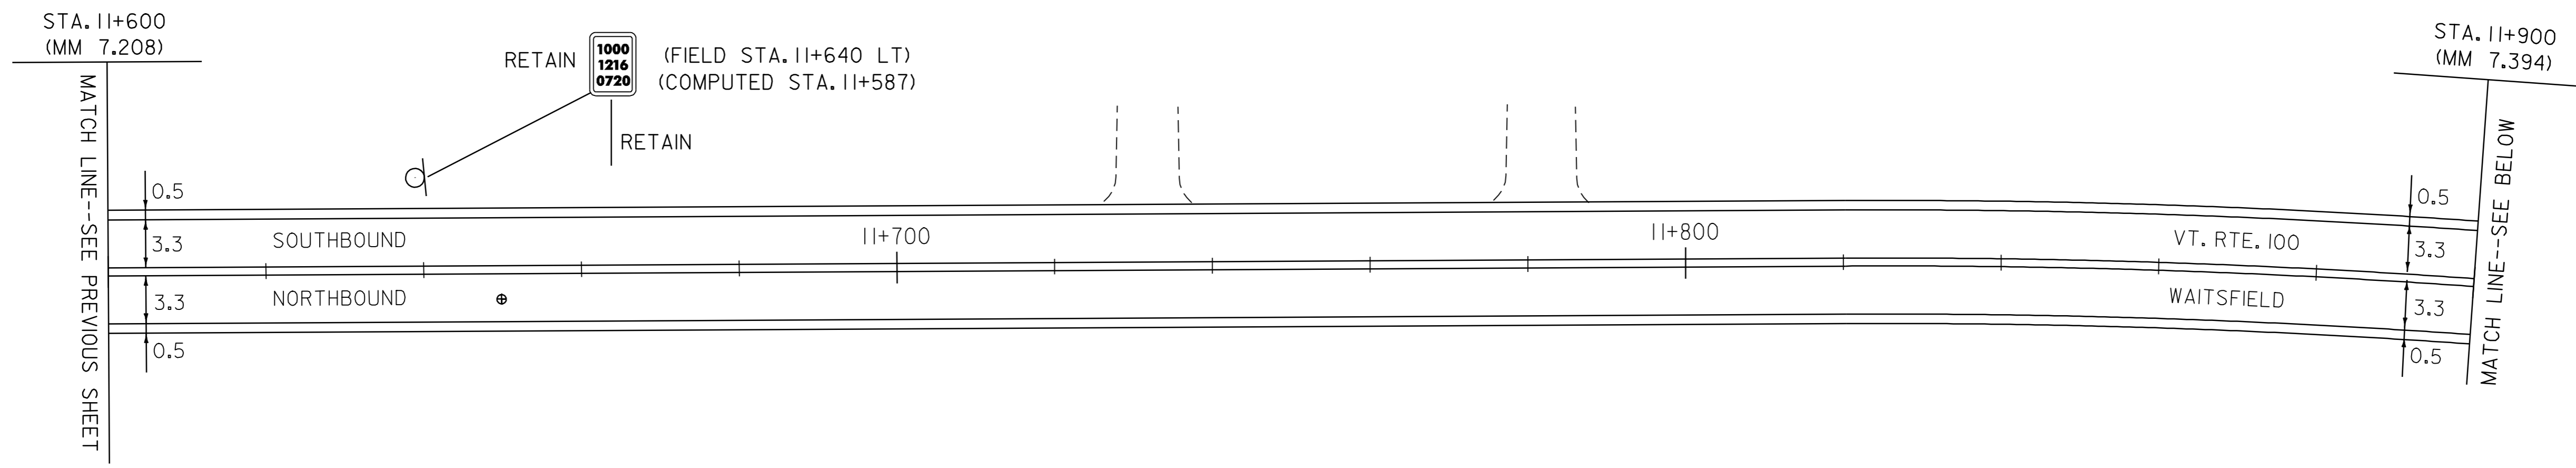

**CURVE #13**  
 PC FIELD STA. 11+912  
 PT FIELD STA. 12+032  
 Δ 6° 30' RT  
 T=60m  
 R=1057m  
 SUPERELEVATION=0.033  
 RUNOFF=23m  
 RUNOUT=30m  
 V=80km/hr (50 m.p.h.)  
 SEE SHEET 53 FOR BANKING DETAIL

**CURVE #14**  
 PC FIELD STA. 12+050  
 PT FIELD STA. 12+130  
 Δ 13° 00' RT  
 T=40m  
 R=351m  
 SUPERELEVATION=0.071  
 RUNOFF=52m  
 RUNOUT=30m  
 V=80km/hr (50 m.p.h.)  
 SEE SHEET 53 FOR BANKING DETAIL

NOT TO SCALE

<b>PAVING PROJECT LAYOUT #10 VT. RTE. 100</b>	PROJECT NAME: WAITSFIELD-MORETOWN	PLOT DATE: 23-MAY-2008 12:3
	PROJECT NUMBER: STP 2227(1)S	DRAWN BY: J. REDMOND
	FILE NAME: /pave/00b058/00b058.dgn	CHECKED BY: J. REDMOND
	DESIGNED BY: J. REDMOND	SHEET 40 OF 54

CORE NO.	LOCATION	DEPTH (mm)
9	11+647 RT	231

646.40 DURABLE 100 mm WHITE LINE (THERMOPLASTIC)  
 (ALL LINES WILL INCLUDE EDGE LINE BREAKS AND RADIUS FOR TOWN HIGHWAYS)

MORETOWN:  
 STA. 0+000 - STA. 0+600 LT & RT

646.60 TEMPORARY 100 mm WHITE LINE (PAINT)  
 (ALL LINES WILL INCLUDE EDGE LINE BREAKS AND RADIUS FOR TOWN HIGHWAYS)

MORETOWN:  
 STA. 0+000 - STA. 0+600 LT & RT

646.41 DURABLE 100 mm YELLOW LINE (THERMOPLASTIC)  
 (ALL LINES WILL INCLUDE C/L BREAKS FOR TOWN HIGHWAYS) S=SOLID, D=DASHED

MORETOWN:  
 STA. 0+000 - STA. 0+600 LT S C RT S

646.61 TEMPORARY 100 mm YELLOW LINE (PAINT)  
 (ALL LINES WILL INCLUDE C/L BREAKS FOR TOWN HIGHWAYS) S=SOLID, D=DASHED

MORETOWN:  
 STA. 0+000 - STA. 0+600 LT S C RT S

613.10 STONE FILL, TYPE J  
 (FOR SHOULDER/SLOPE REPAIR)

MORETOWN:  
 STA. 0+446 LT (10m<sup>3</sup>)

604.412 REHABILITATION OF DI, CB OR MH


MORETOWN:  
 STA. 0+576 LT

619.17 YIELDING MARKER POSTS

MORETOWN:  
 STA. 0+023 LT & RT (2)  
 STA. 0+131 LT & RT (2)  
 STA. 0+441 LT & RT (2)  
 STA. 0+576 LT & RT (2)

DITCHING LOCATION

MORETOWN:  
 STA. 0+131 - 0+388 LT  
 STA. 0+457 - 0+600 LT

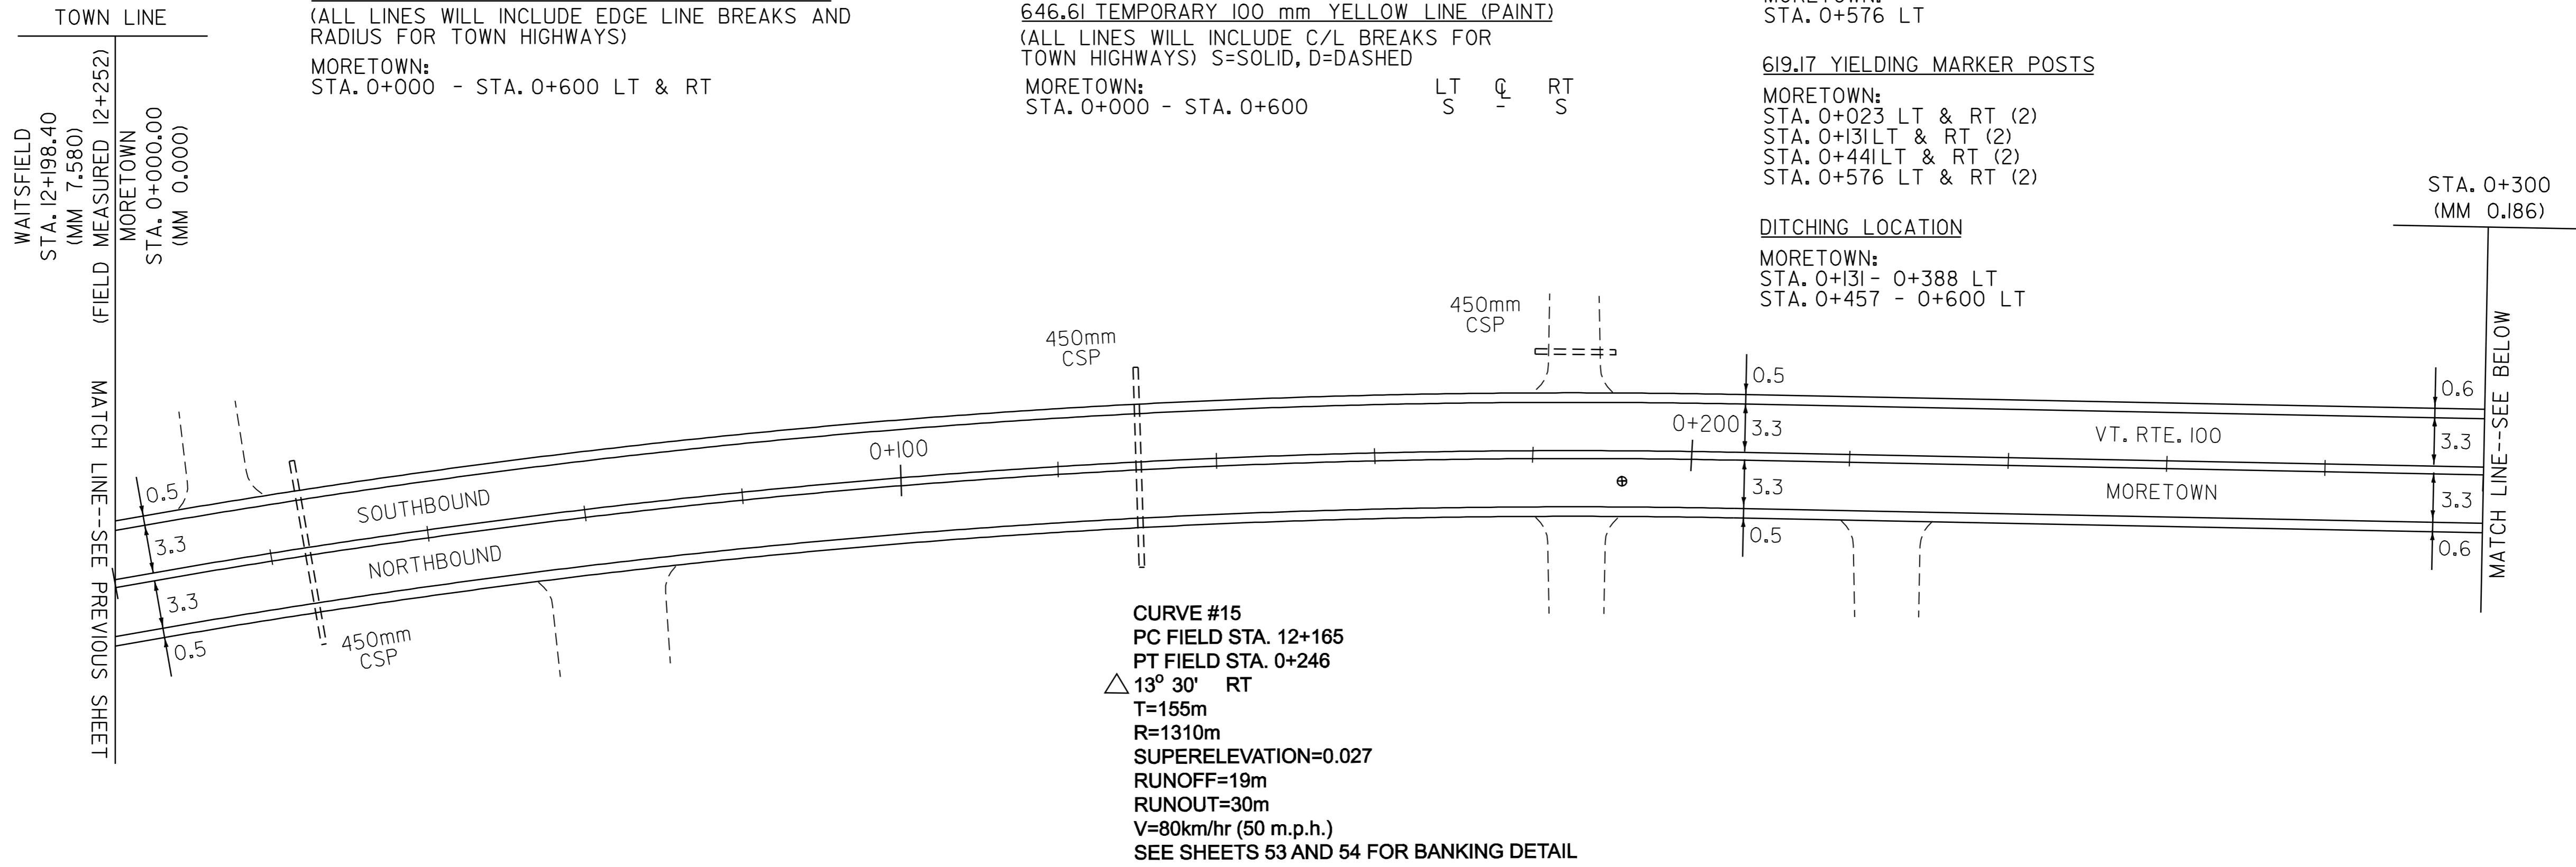

**CURVE #15**  
 PC FIELD STA. 12+165  
 PT FIELD STA. 0+246  
 Δ 13° 30' RT  
 T=155m  
 R=1310m  
 SUPERELEVATION=0.027  
 RUNOFF=19m  
 RUNOUT=30m  
 V=80km/hr (50 m.p.h.)  
 SEE SHEETS 53 AND 54 FOR BANKING DETAIL

621.30 BOX BEAM GUARD RAIL (GALV.)  
 MORETOWN:  
 STA. 0+458.1 - 0+513.0 RT (54.86m)


621.80 REMOVAL AND DISPOSAL OF GUARD RAIL

MORETOWN:  
 STA. 0+363 - 0+512 RT (149m)

621.30 BOX BEAM GUARD RAIL (GALV.)  
 (2.1 METER POSTS)

MORETOWN:  
 STA. 0+363.0 - 0+458.1 RT (95.10m)  
 STA. 0+416.0 - 0+456.2 LT (40.23m)

**CURVE #16**  
 PC FIELD STA. 0+375  
 PT FIELD STA. 0+725  
 Δ 53° 00' LT  
 T=175m  
 R=351m  
 SUPERELEVATION=0.071  
 RUNOFF=52m  
 RUNOUT=28m  
 V=80km/hr (50 m.p.h.)  
 SEE SHEET 54 FOR BANKING DETAIL

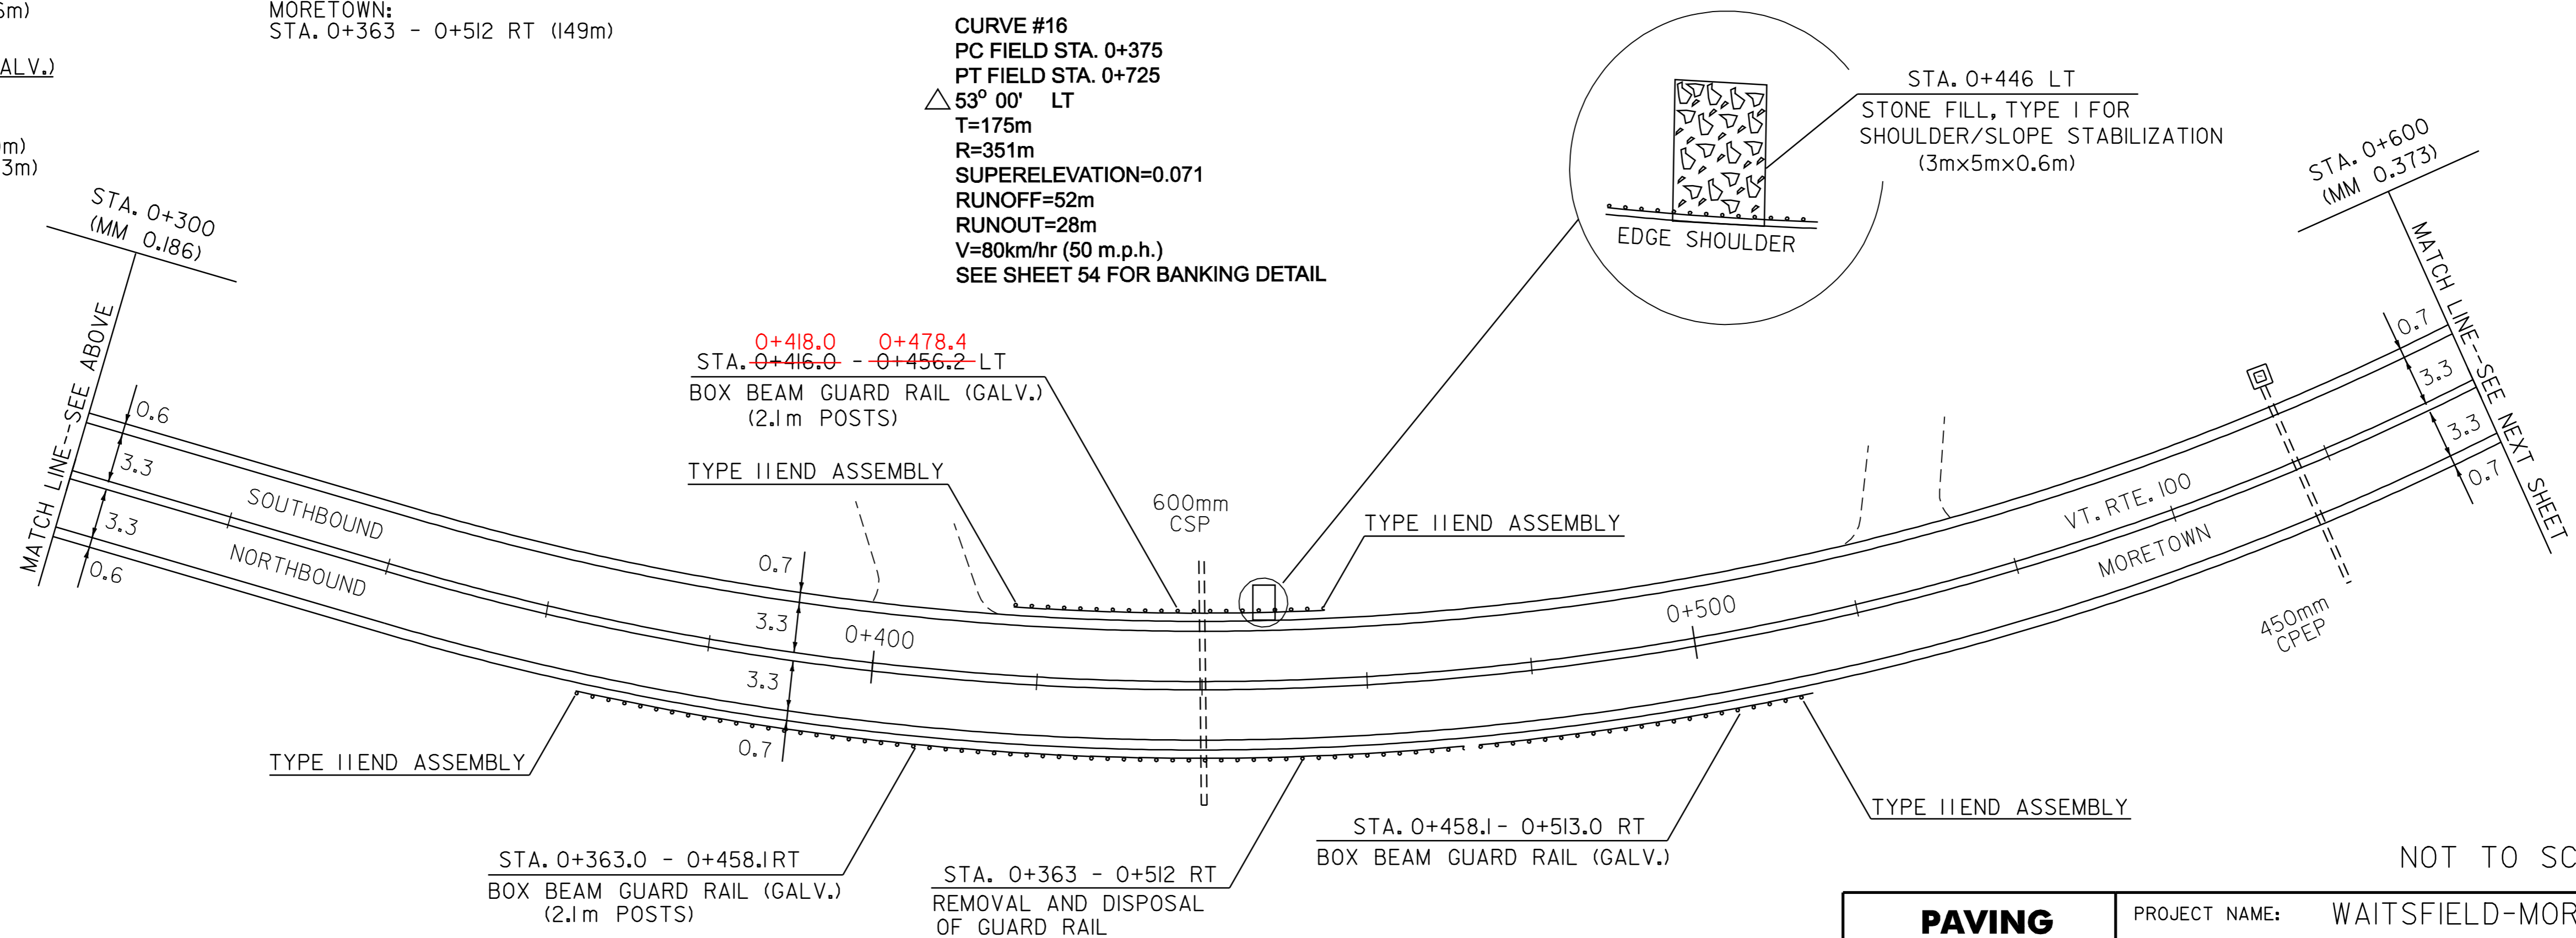

NOT TO SCALE

<b>PAVING PROJECT LAYOUT #11 VT. RTE. 100</b>	PROJECT NAME: WAITSFIELD-MORETOWN	PLOT DATE: 23-MAY-2008 12:5
	PROJECT NUMBER: STP 2227(1)S	DRAWN BY: J. REDMOND
	FILE NAME: /pave/00b058/00b058.dgn	DESIGNED BY: J. REDMOND
	DESIGNED BY: J. REDMOND	CHECKED BY: J. REDMOND
	00b058111.I	SHEET 41 OF 54

CORE NO.	LOCATION	DEPTH (mm)
10	0+190 RT	175

646.40 DURABLE 100 mm WHITE LINE (THERMOPLASTIC)  
 (ALL LINES WILL INCLUDE EDGE LINE BREAKS AND RADIUS FOR TOWN HIGHWAYS)

MORETOWN:  
 STA. 0+600 - STA. 0+760 LT & RT

646.60 TEMPORARY 100 mm WHITE LINE (PAINT)  
 (ALL LINES WILL INCLUDE EDGE LINE BREAKS AND RADIUS FOR TOWN HIGHWAYS)

MORETOWN:  
 STA. 0+600 - STA. 0+760 LT & RT

646.41 DURABLE 100 mm YELLOW LINE (THERMOPLASTIC)  
 (ALL LINES WILL INCLUDE C/L BREAKS FOR TOWN HIGHWAYS) S=SOLID, D=DASHED

MORETOWN:  
 STA. 0+600 - STA. 0+760 LT S C RT S  
 STA. 0+732 DOUBLE SOLID RT, VT ROUTE 100B

646.61 TEMPORARY 100 mm YELLOW LINE (PAINT)  
 (ALL LINES WILL INCLUDE C/L BREAKS FOR TOWN HIGHWAYS) S=SOLID, D=DASHED

MORETOWN:  
 STA. 0+600 - STA. 0+760 LT S C RT S  
 STA. 0+732 DOUBLE SOLID RT, VT ROUTE 100B

646.46 DURABLE 600 mm STOP BAR (THERMOPLASTIC)

MORETOWN:  
 VT. ROUTE 100 STA. 0+746 LT

646.66 TEMPORARY 600 mm STOP BAR (PAINT)

MORETOWN:  
 VT. ROUTE 100 STA. 0+746 LT

646.50 DURABLE LETTER OR SYMBOL (THERMOPLASTIC)

MORETOWN:  
 VT. ROUTE 100 STA. 0+746 LT "S,T,O,P" (4 EA)

646.70 TEMPORARY LETTER OR SYMBOL (PAINT)


MORETOWN:  
 VT. ROUTE 100 STA. 0+746 LT "S,T,O,P" (4 EA)

DITCHING LOCATION

MORETOWN:  
 STA. 0+600 - 0+760 LT

REMOVING SIGNS

4 AS SHOWN

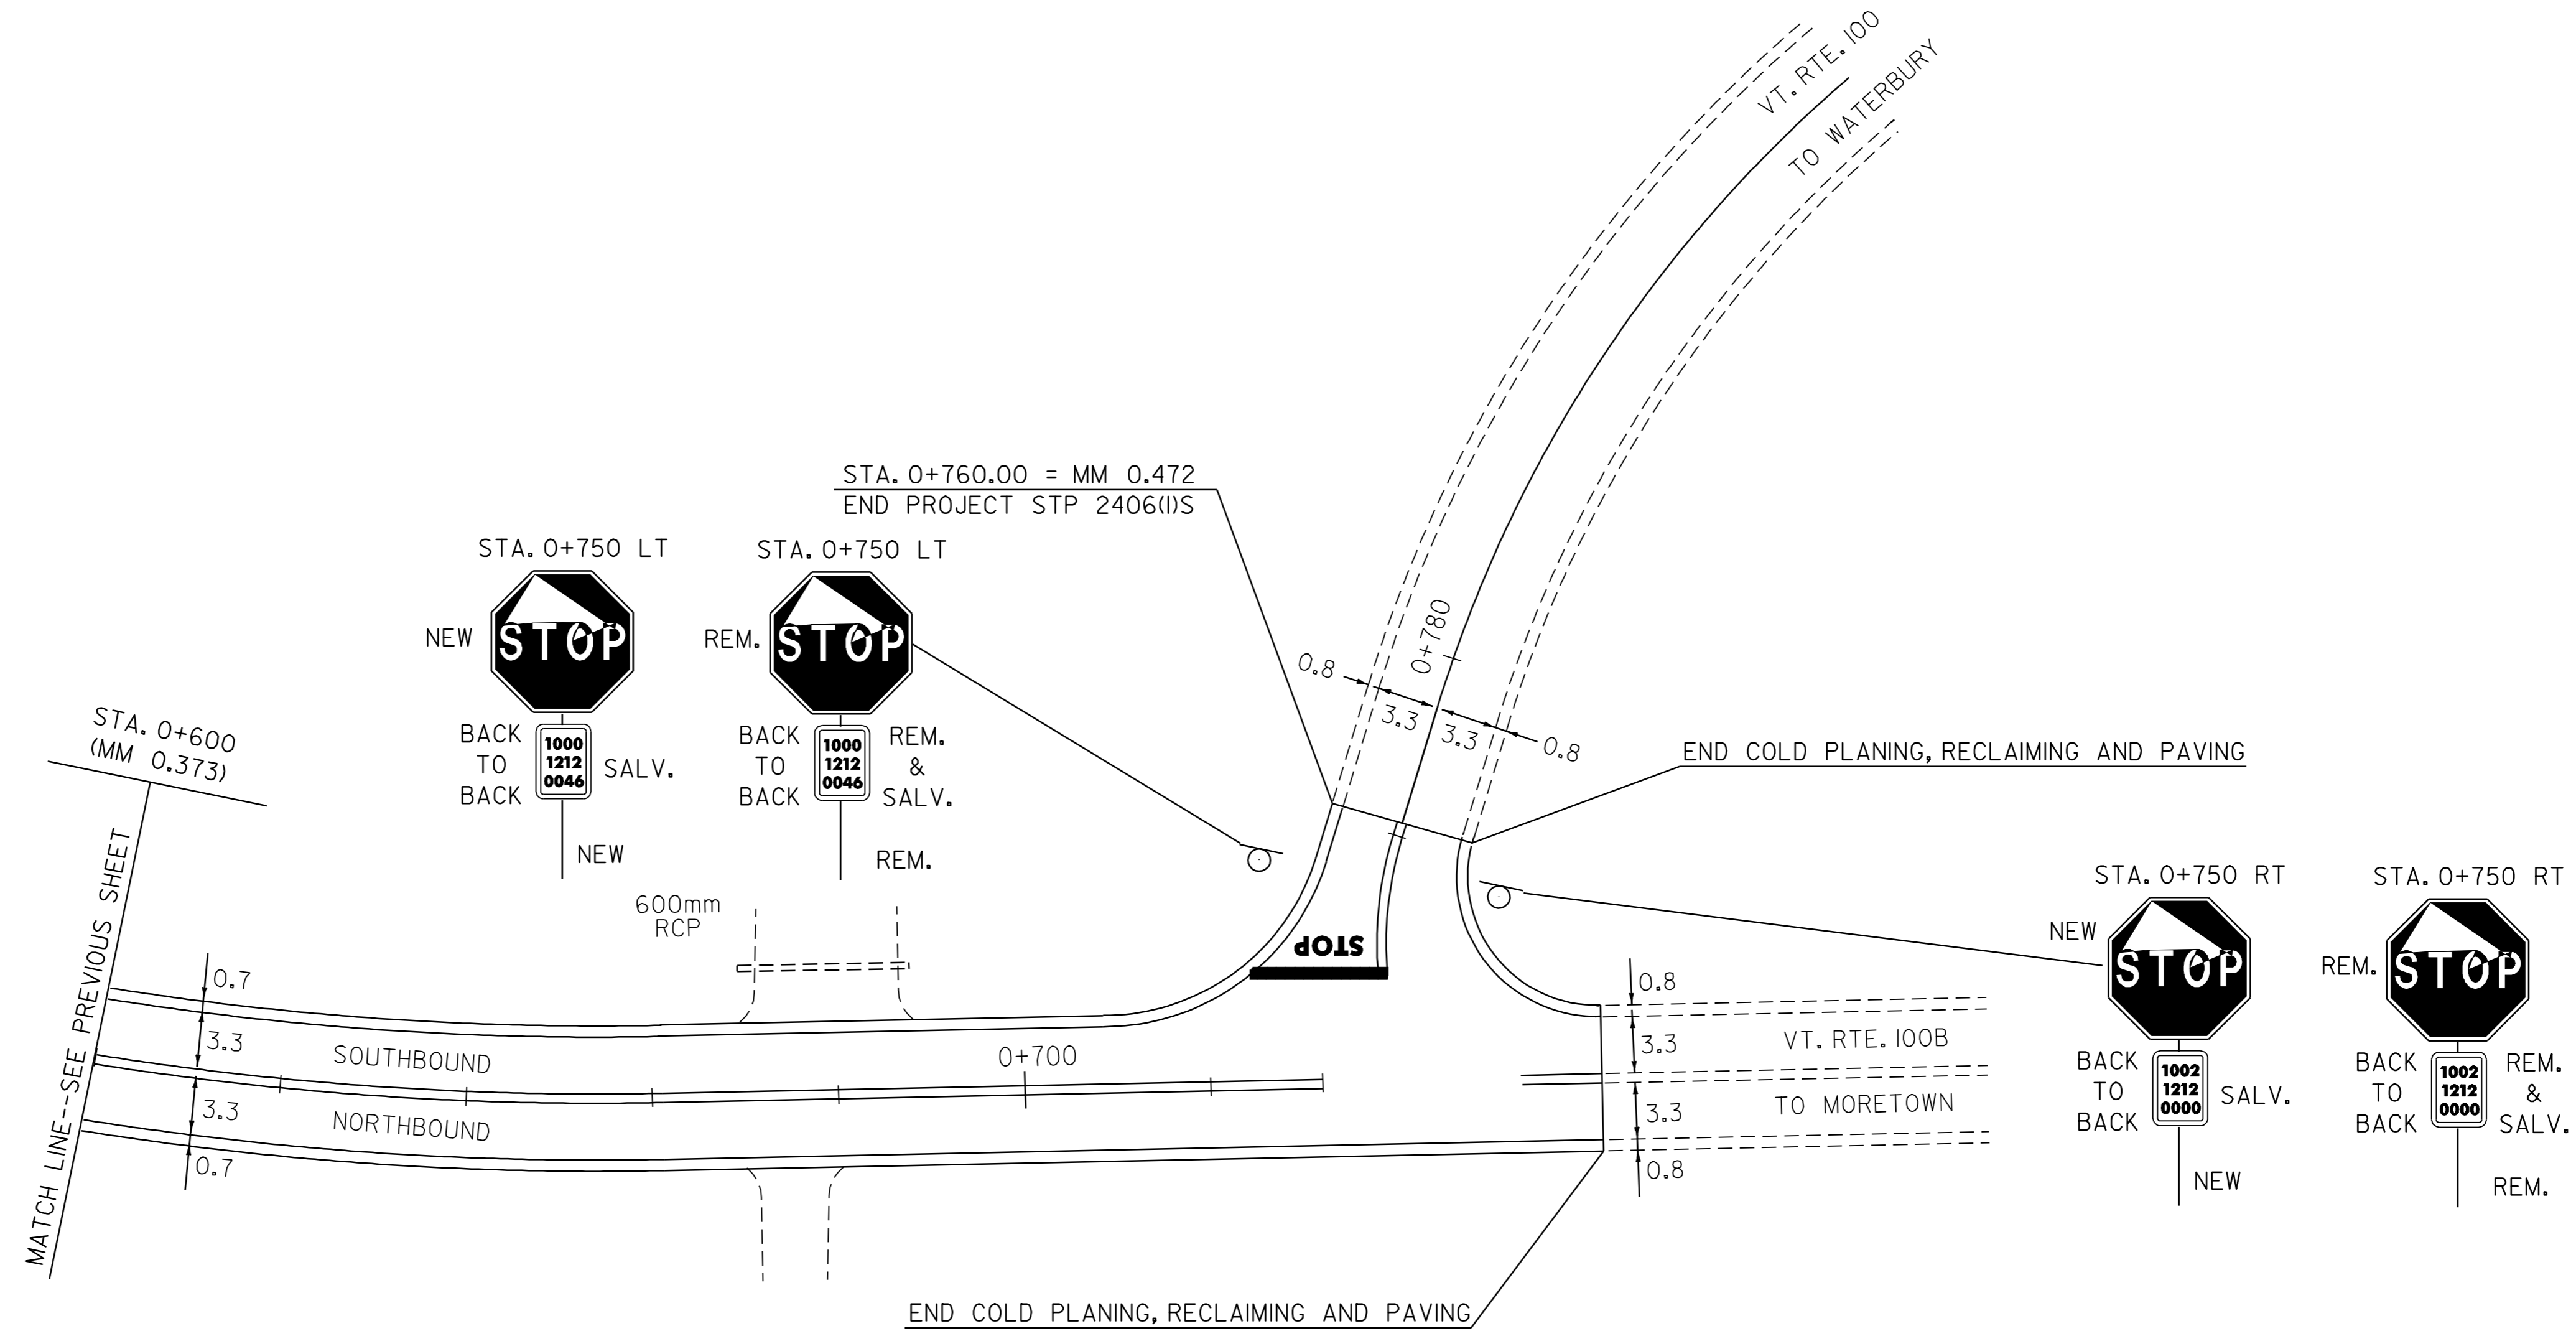

NOT TO SCALE


<b>PAVING PROJECT LAYOUT #12 VT. RTE. 100</b>	PROJECT NAME: WAITSFIELD-MORETOWN	FILE NAME: /pave/00b058/00b058.dgn	PLOT DATE: 23-MAY-2008 12:5
	PROJECT NUMBER: STP 2227(I)S	PROJECT LEADER: WOOLLAVER	DRAWN BY: J. REDMOND
	DESIGNED BY: J. REDMOND	CHECKED BY: J. REDMOND	SHEET 42 OF 54
	00b058I12.1		






# BRIDGE QUANTITY SUMMARY


FIELD STATION	FIELD STATION	BRIDGE NO.	REMOVAL OF EXIST. RAILING METERS	525.10	621.30	REMARKS
				FEET (METERS)	BOX BEAM GUARDRAIL (GALV.) (MOD. 3)	
7+894.14	7+920.87	LT 181	7	<del>89-5</del> 89-5	<del>27.25M</del> 27.25M	SEE SHEET 46 FOR DETAILS
7+894.14	7+920.87	RT 181	7	<del>87-8</del> 89-5	<del>(26.73M)</del> 27.25M	SEE SHEET 46 FOR DETAILS
9+335.00	9+359.00	LT 185	-	<del>79-4</del> 78-8	<del>24.18M</del> (23.98M)	SEE SHEET 48 FOR DETAILS
11+456.14	11+501.86	RT 186	26	150'-0"	(45.72M)	SEE SHEET 47 FOR DETAILS
11+457.14	11+502.86	LT 186	26	150'-0"	(45.72M)	SEE SHEET 47 FOR DETAILS
SUBTOTAL			66	<del>558'-2"</del> 558'-2"	<del>(168.88M)</del> 170.13	
ROUNDING			4	<del>3'-8"</del> 3'-8"	<del>(1.12M)</del> 170.13	
TOTALS			70	<del>557'-8"</del> 558'-2"	<del>(170.00M)</del> 170.13	

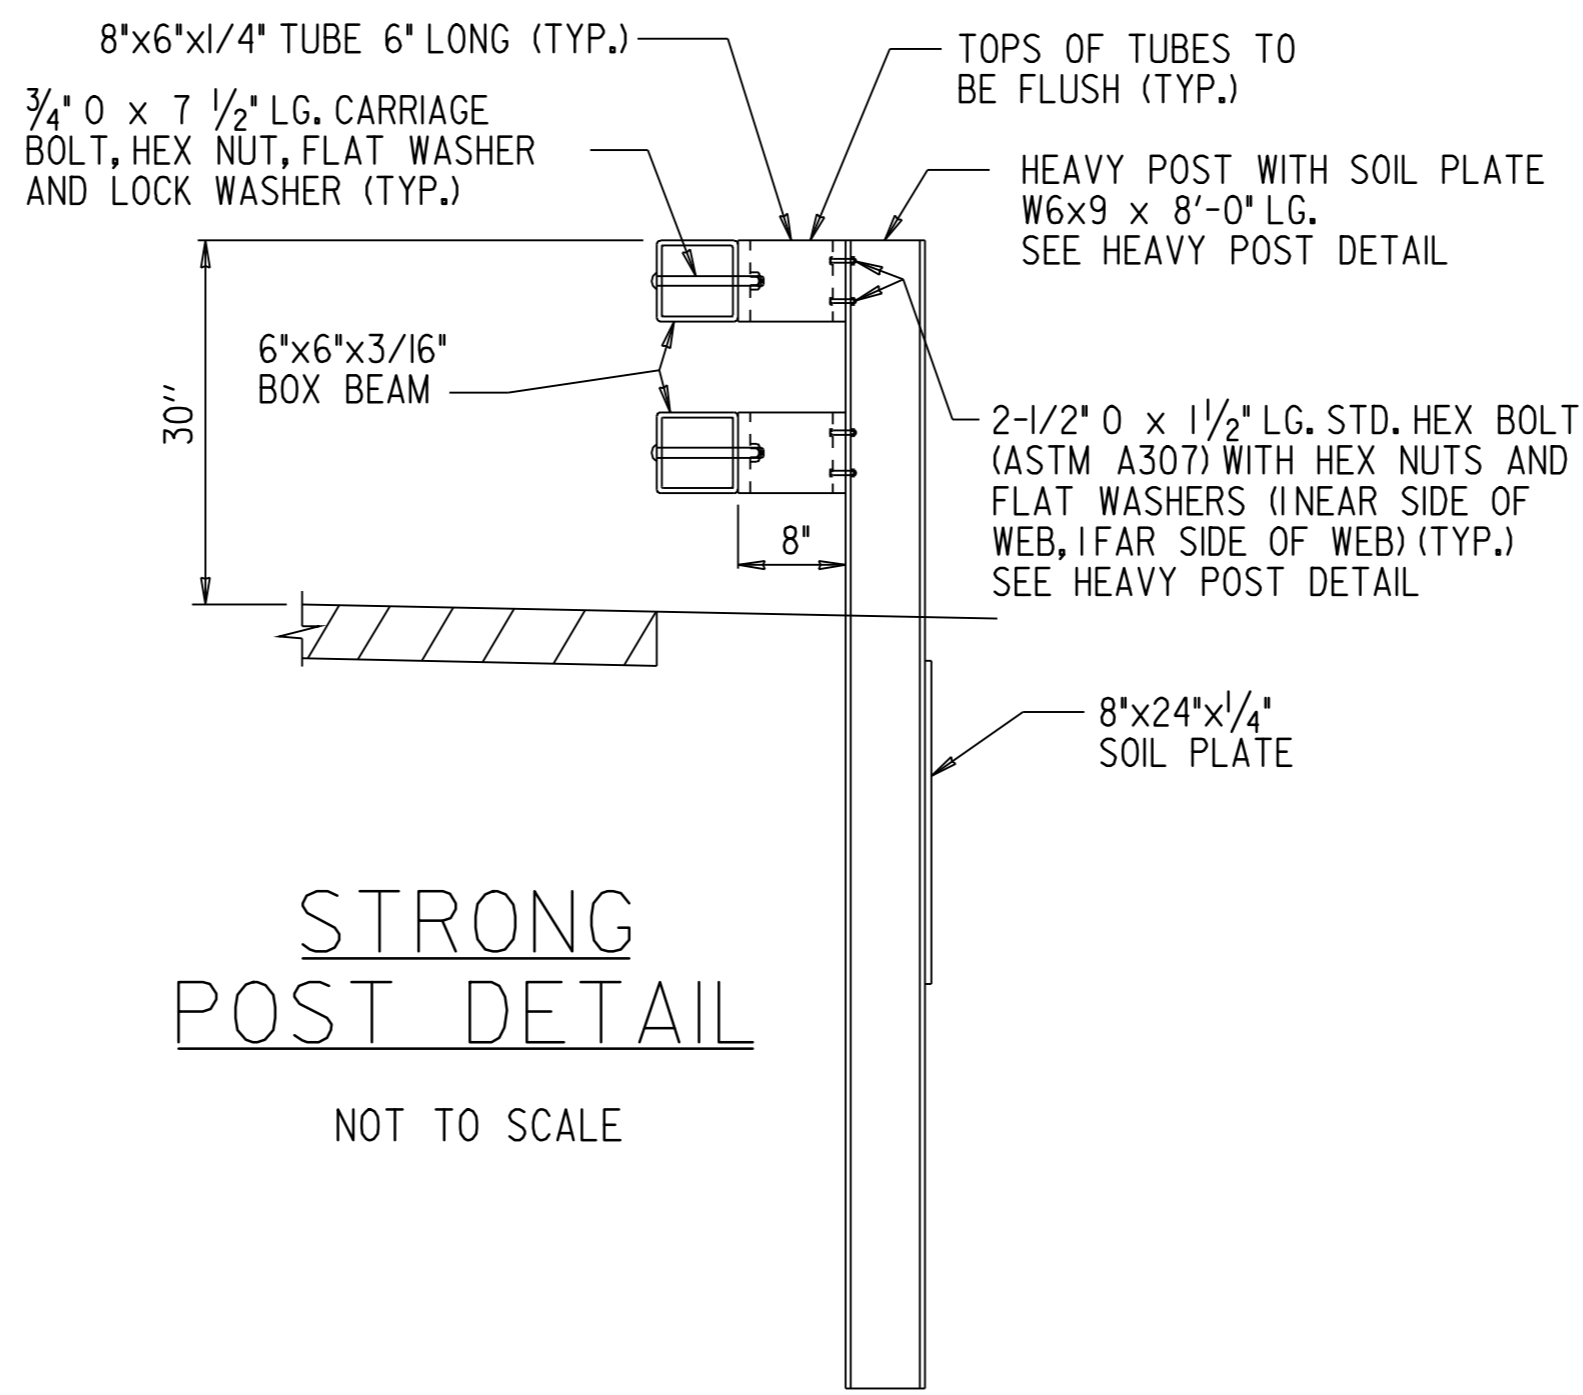

**STRONG POST DETAIL**  
NOT TO SCALE

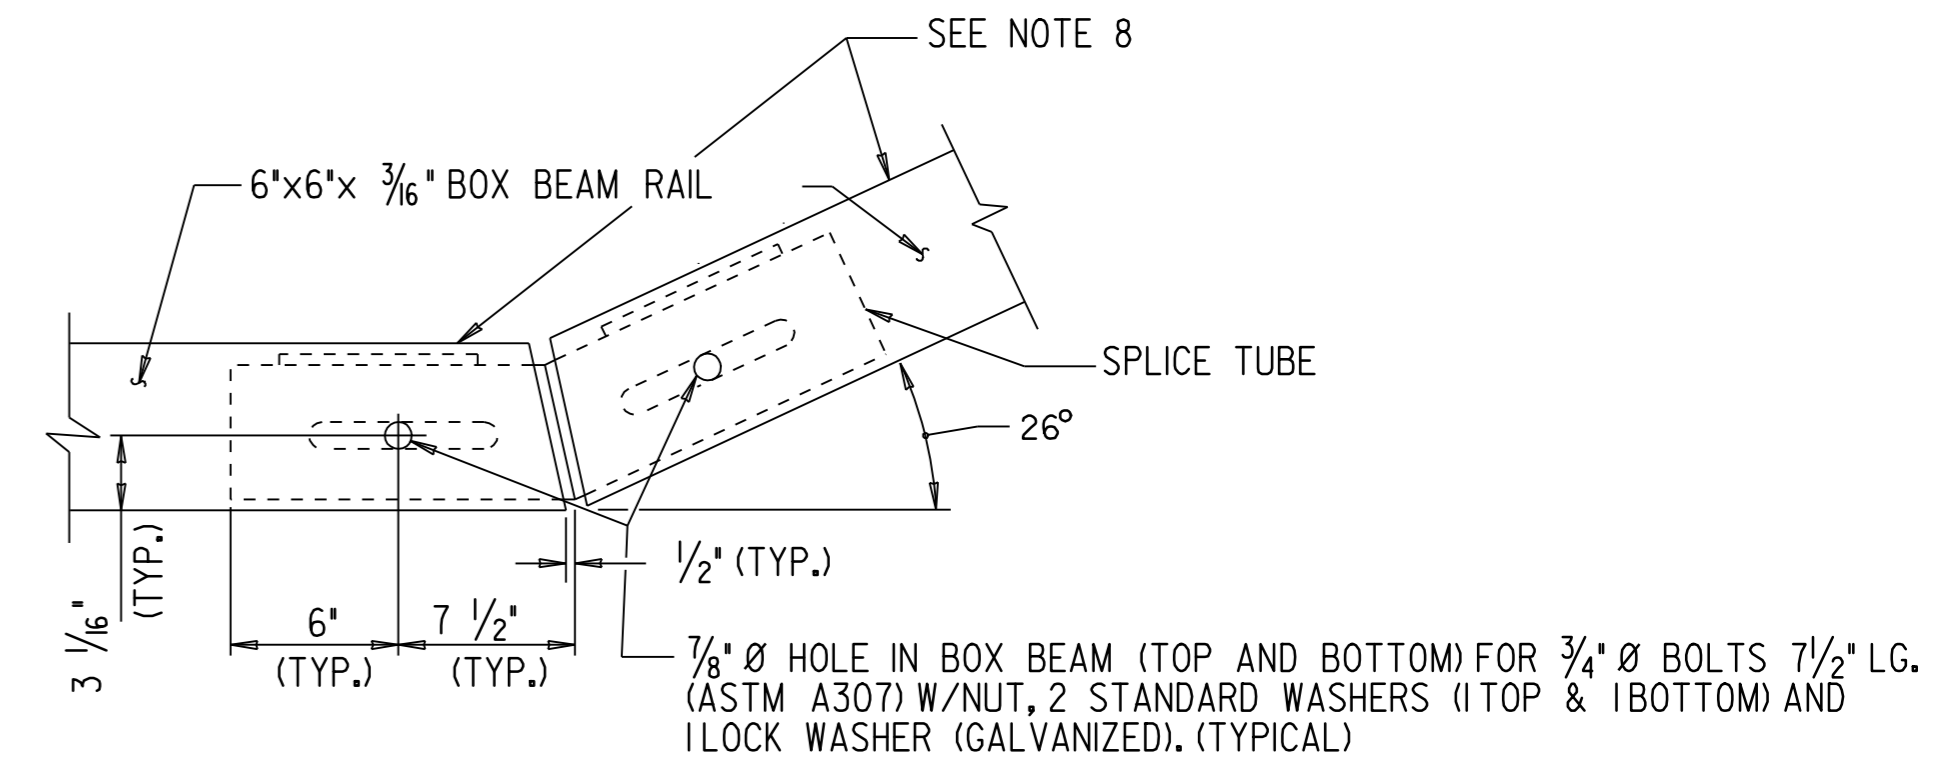


**SPLICE DETAIL AT TURN BACK IN LOWER TRANSITION GUARD RAIL**  
NOT TO SCALE

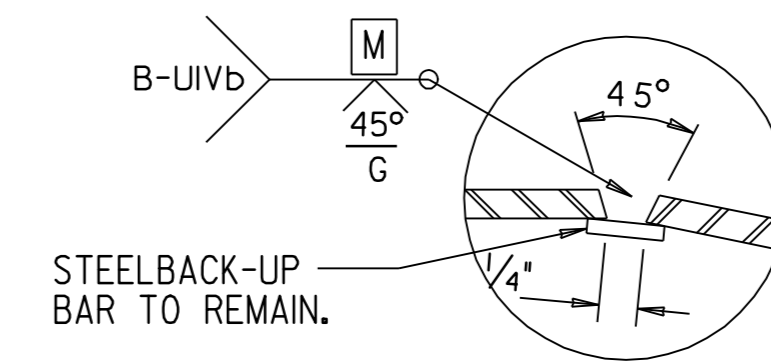

**WELD DETAIL FOR SPLICE TUBE**  
NOT TO SCALE


**NOTES:**

- ALL BOX BEAM DETAIL DIMENSIONS ARE IN ENGLISH UNITS. THE FINAL QUANTITIES HAVE BEEN CONVERTED TO METRIC FOR PAYMENT.
- ALL BOX BEAM COMPONENTS, INCLUDING POSTS AND HARDWARE, SHALL CONFORM TO THE CURRENT SPECIFICATION FOR BOX BEAM GUARD RAIL. REFER TO STANDARD G-IBM FOR DETAILS. ALL BOX BEAM COMPONENTS, INCLUDING POSTS AND HARDWARE, SHALL BE GALVANIZED.
- FOR DETAILS OF STANDARD POST, EXTRA LONG POST, RAIL ELEMENT, RAIL SUPPORT ANGLE, SPLICE CONNECTIONS, END COVER PLATE, TYPE I AND TYPE II END ASSEMBLIES AND DELINEATION DEVICE, SEE THE VAOT STANDARD SHEET G-IBM, "BOX BEAM GUARD RAIL."
- IN LOCATIONS OF STANDARD BOX BEAM PLACEMENT (SUCH AS RAIL CONTINUING BEYOND THE END OF RUB RAIL), EXTRA LONG POSTS SHALL BE USED IF THE TOP OF EMBANKMENT IS LESS THAN ONE METER (3') BEHIND THE FACE OF RAIL. REFER TO STANDARD G-IBM FOR DETAILS OF EXTRA LONG POSTS.
- THE BOX BEAM RAIL AND LOWER RUB RAIL SHALL BE SHOP BENT TO THE INDICATED RADIUS AT ALL NECESSARY LOCATIONS DETAILED IN THESE PLANS. THE RADIUS SHALL BE CONFIRMED BY THE CONTRACTOR PRIOR TO FABRICATION.
- THE COST OF ALL EQUIPMENT, LABOR, AND MATERIALS NECESSARY TO COMPLETE THE WORK SHOWN FOR THESE DETAILS SHALL BE INCIDENTAL TO THE ITEM 621.30, BOX BEAM GUARD RAIL (MOD. 3). THE LENGTH OF THE LOWER BOX BEAM GUARD RAIL (RUB RAIL), INCLUDING ALL TURN BACK MATERIALS, SHALL NOT BE PAID SEPARATELY, BUT SHALL BE INCIDENTAL TO ITEM 621.30, BOX BEAM GUARD RAIL (MOD. 3).
- BOX BEAM BRIDGE RAIL HEIGHT (30") SHALL TRANSITION TO THE NORMAL ROADWAY HEIGHT OF 27" AT THE POINT WHERE THE LOWER RUB RAIL TURNS BACK UNDER THE UPPER BOX BEAM RAIL.
- PROTRUSIONS CAUSED BY WELDING ARE NOT PERMITTED ON THE INSIDE WALLS OF THE SPLICE AREA.
- PROTRUSIONS CAUSED BY WELDING ARE NOT PERMITTED ON THE OUTSIDE WALLS OF THE SPLICE TUBE OR THE OUTSIDE SURFACES OF THE FILL PLATE.
- THE COST OF PROVIDING AND INSTALLING NEW BRIDGE POSTS SHALL BE INCLUDED IN THE UNIT PRICE FOR ITEM 621.30, BOX BEAM GUARD RAIL (MOD. 3).

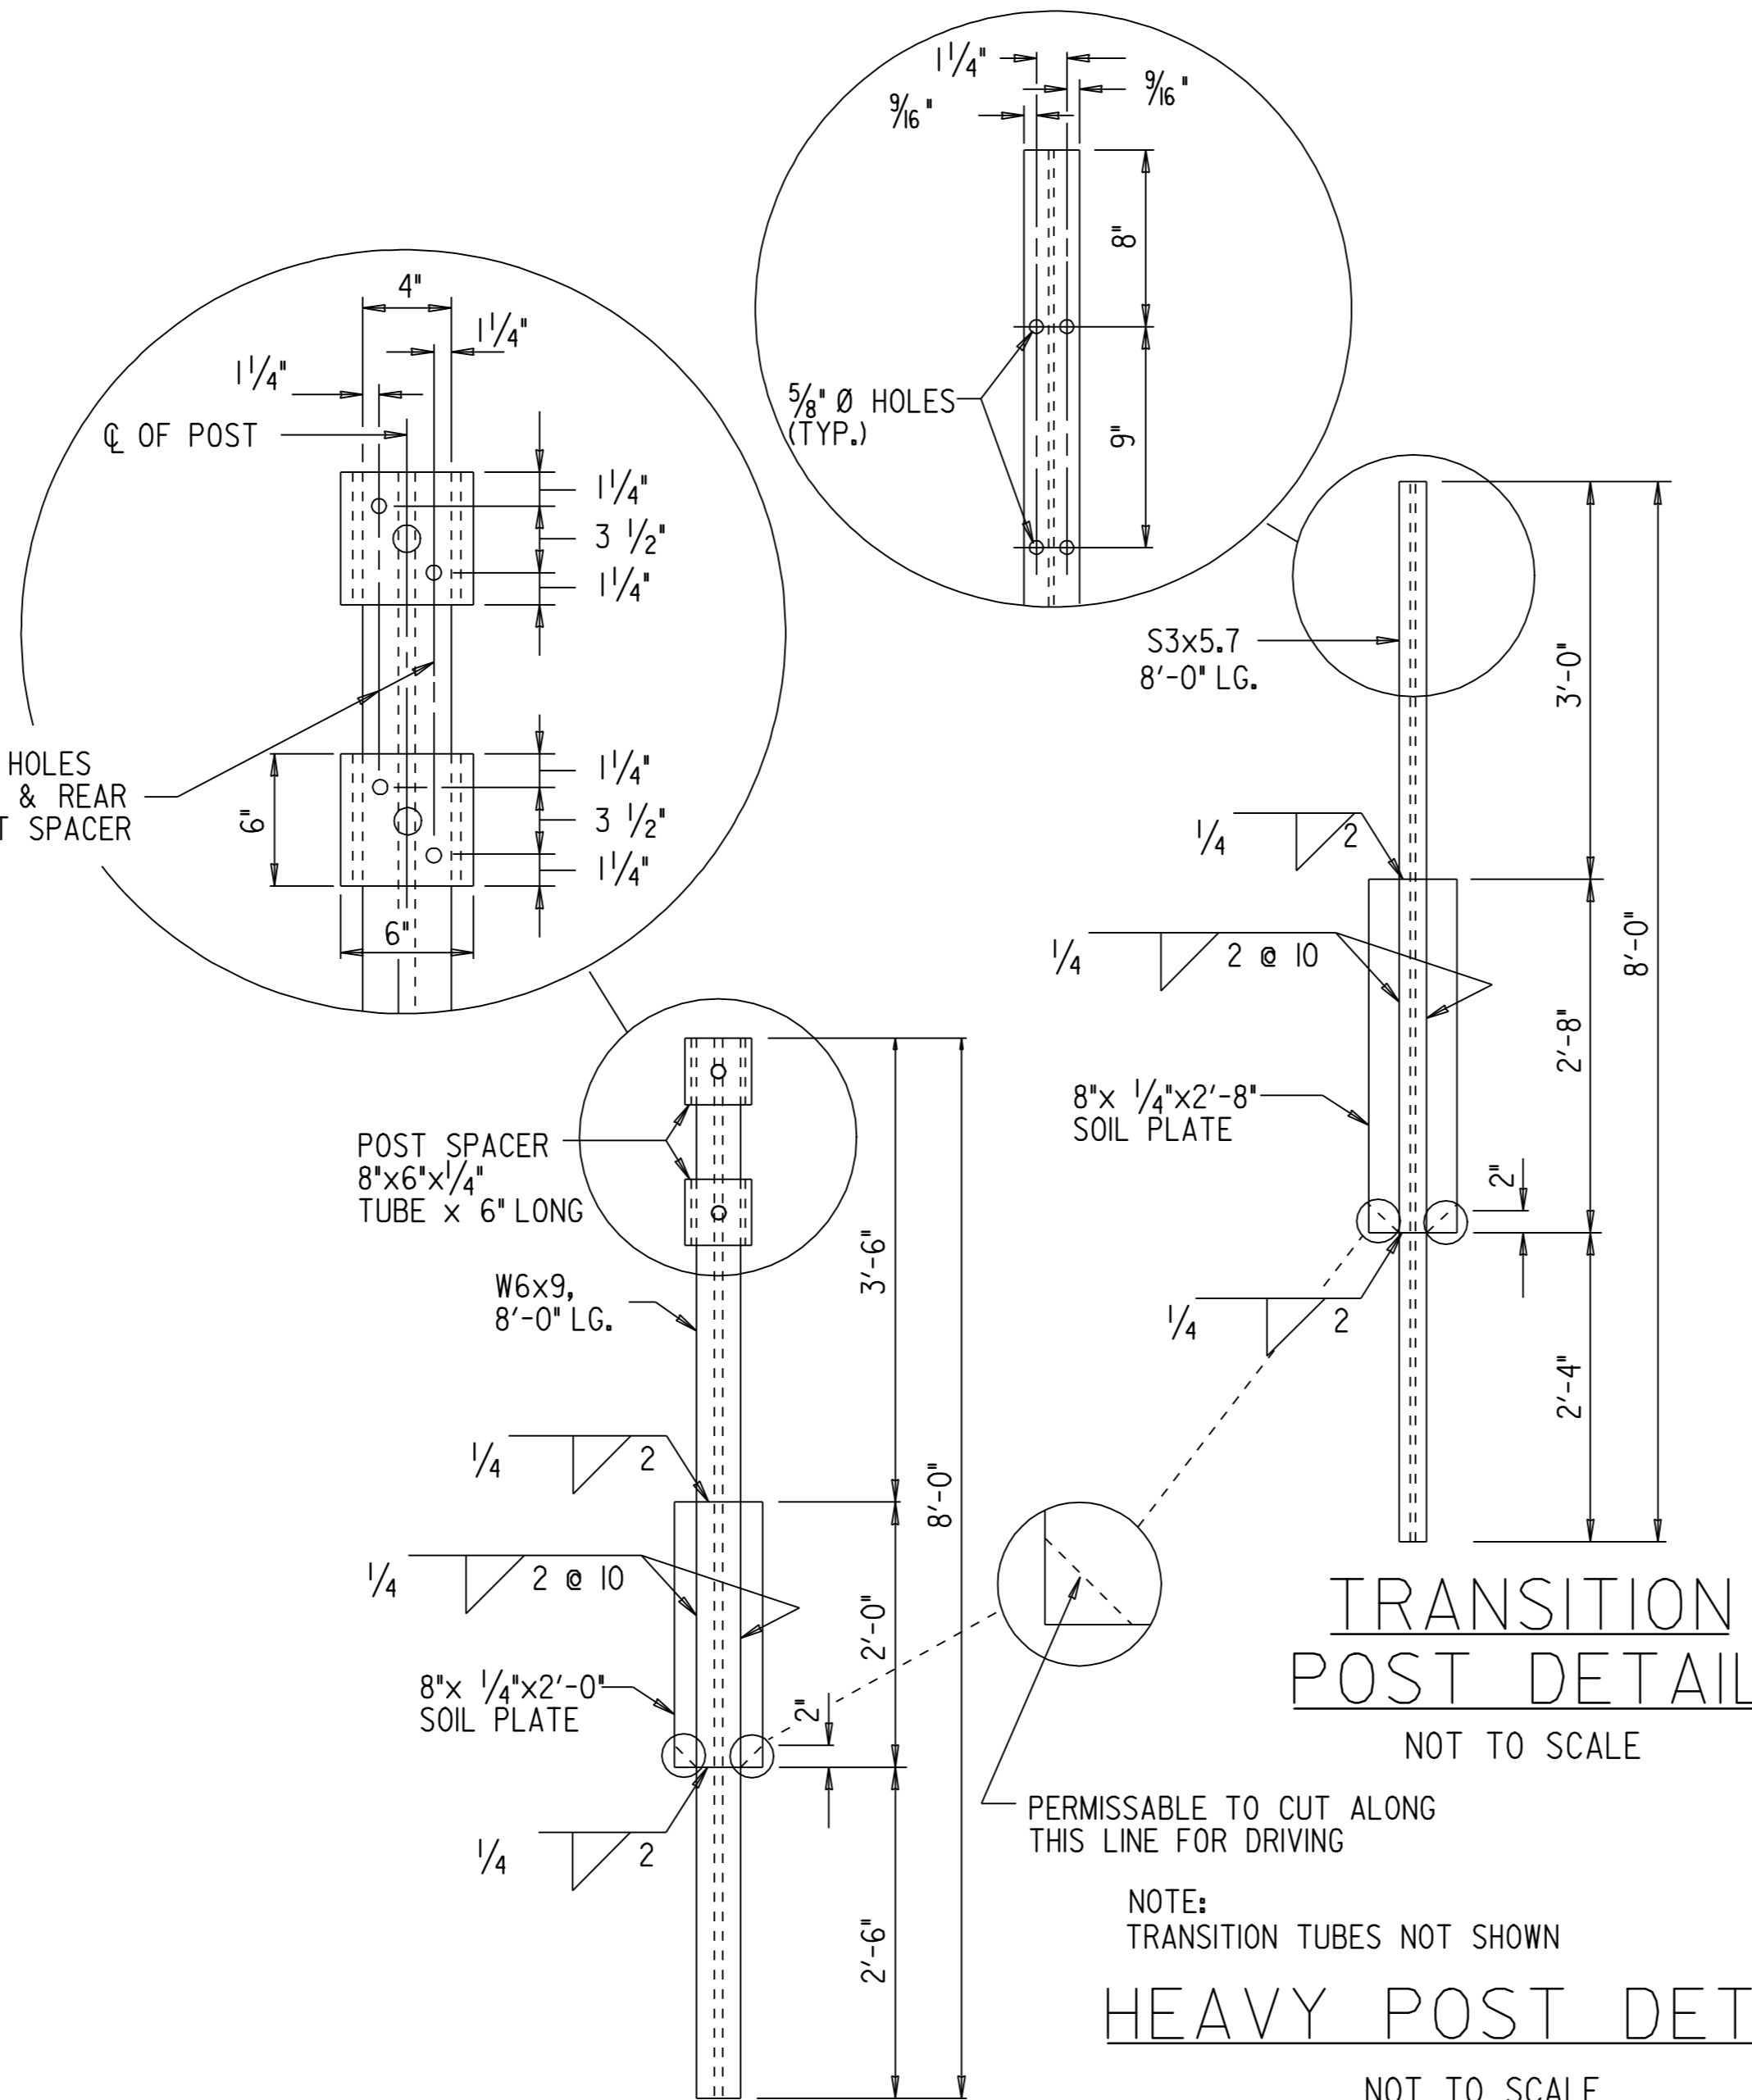





**TRANSITION POST DETAIL**  
NOT TO SCALE

**HEAVY POST DETAIL**  
NOT TO SCALE

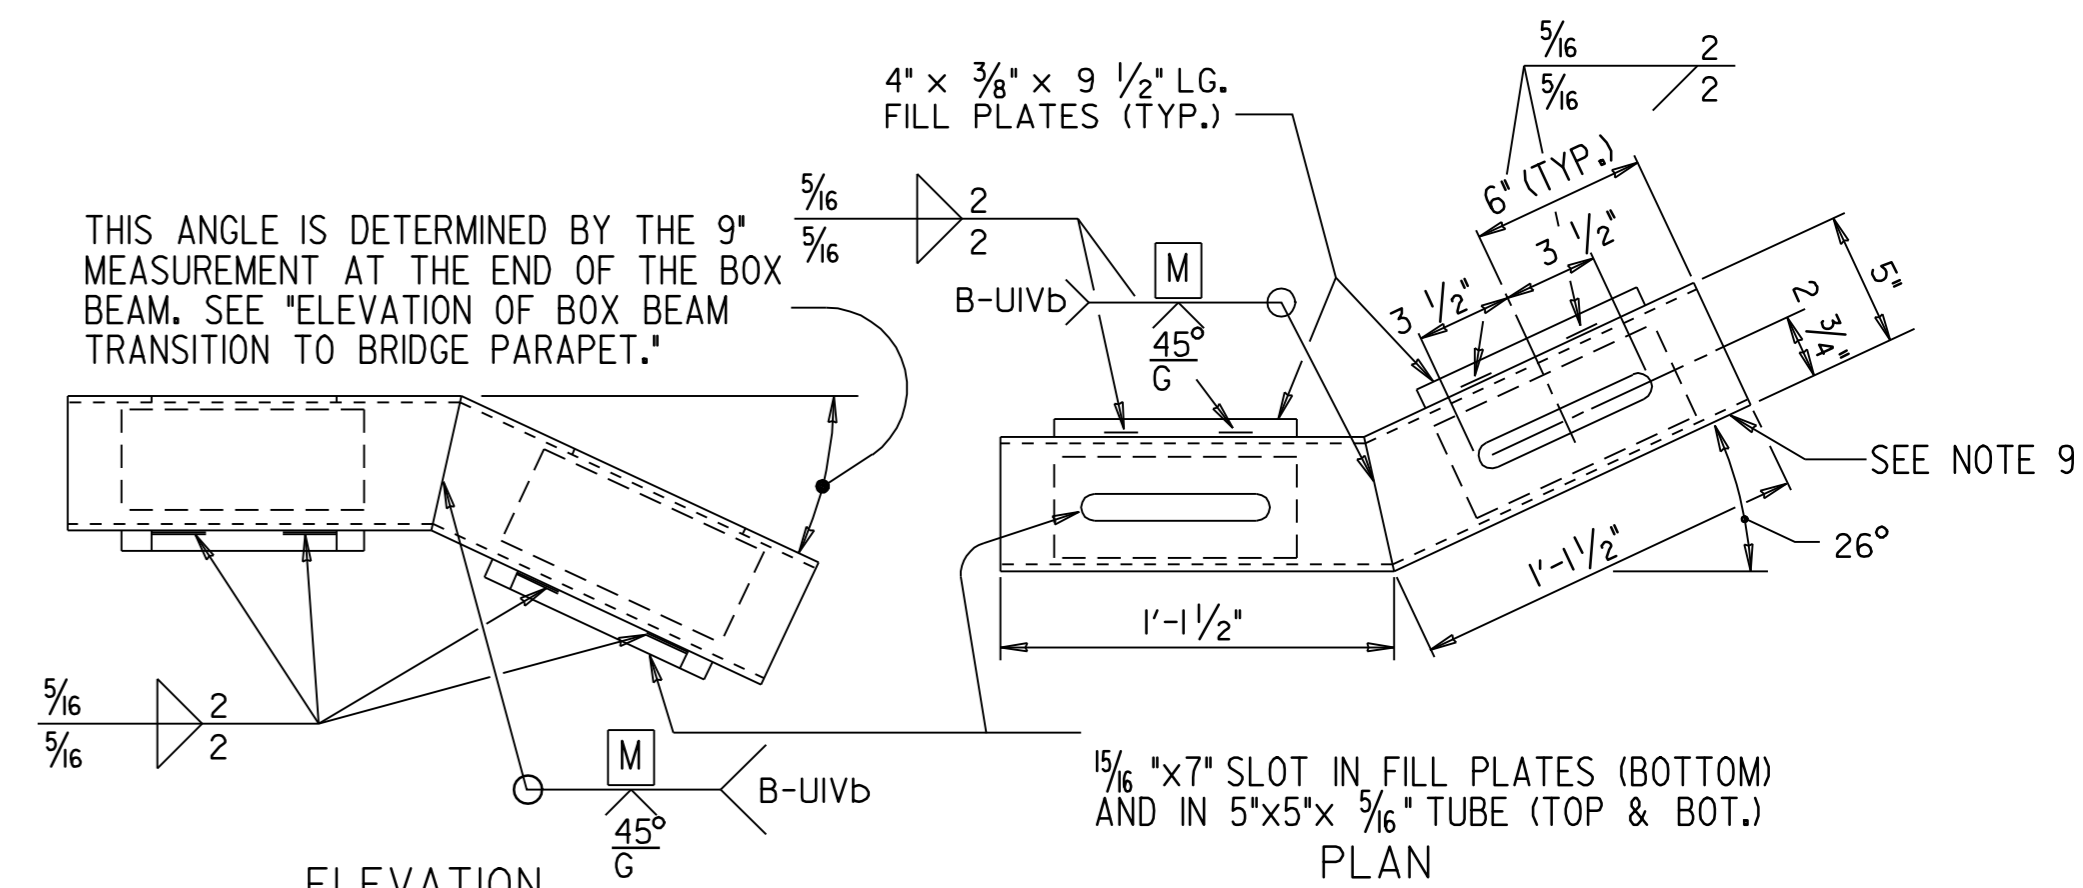


**SPLICE TUBE DETAIL FOR TURN BACK**  
NOT TO SCALE

<b>BRIDGE SUMMARY/DETAIL SHEET</b>	PROJECT: WAITSFIELD - MORETOWN	PROJECT NO.: STP 2227(I)S
	DESIGN FILE NAME: pave/00b058/00b058.dgn	PLOT DATE: 23-MAY-2008
	IPARM FILE NAME: 00b058brgl1	SURVEYED BY: LEW
	SQUAD LEADER: LEW	DRAWN BY: 7/05
	SHEET: 45	OF 54

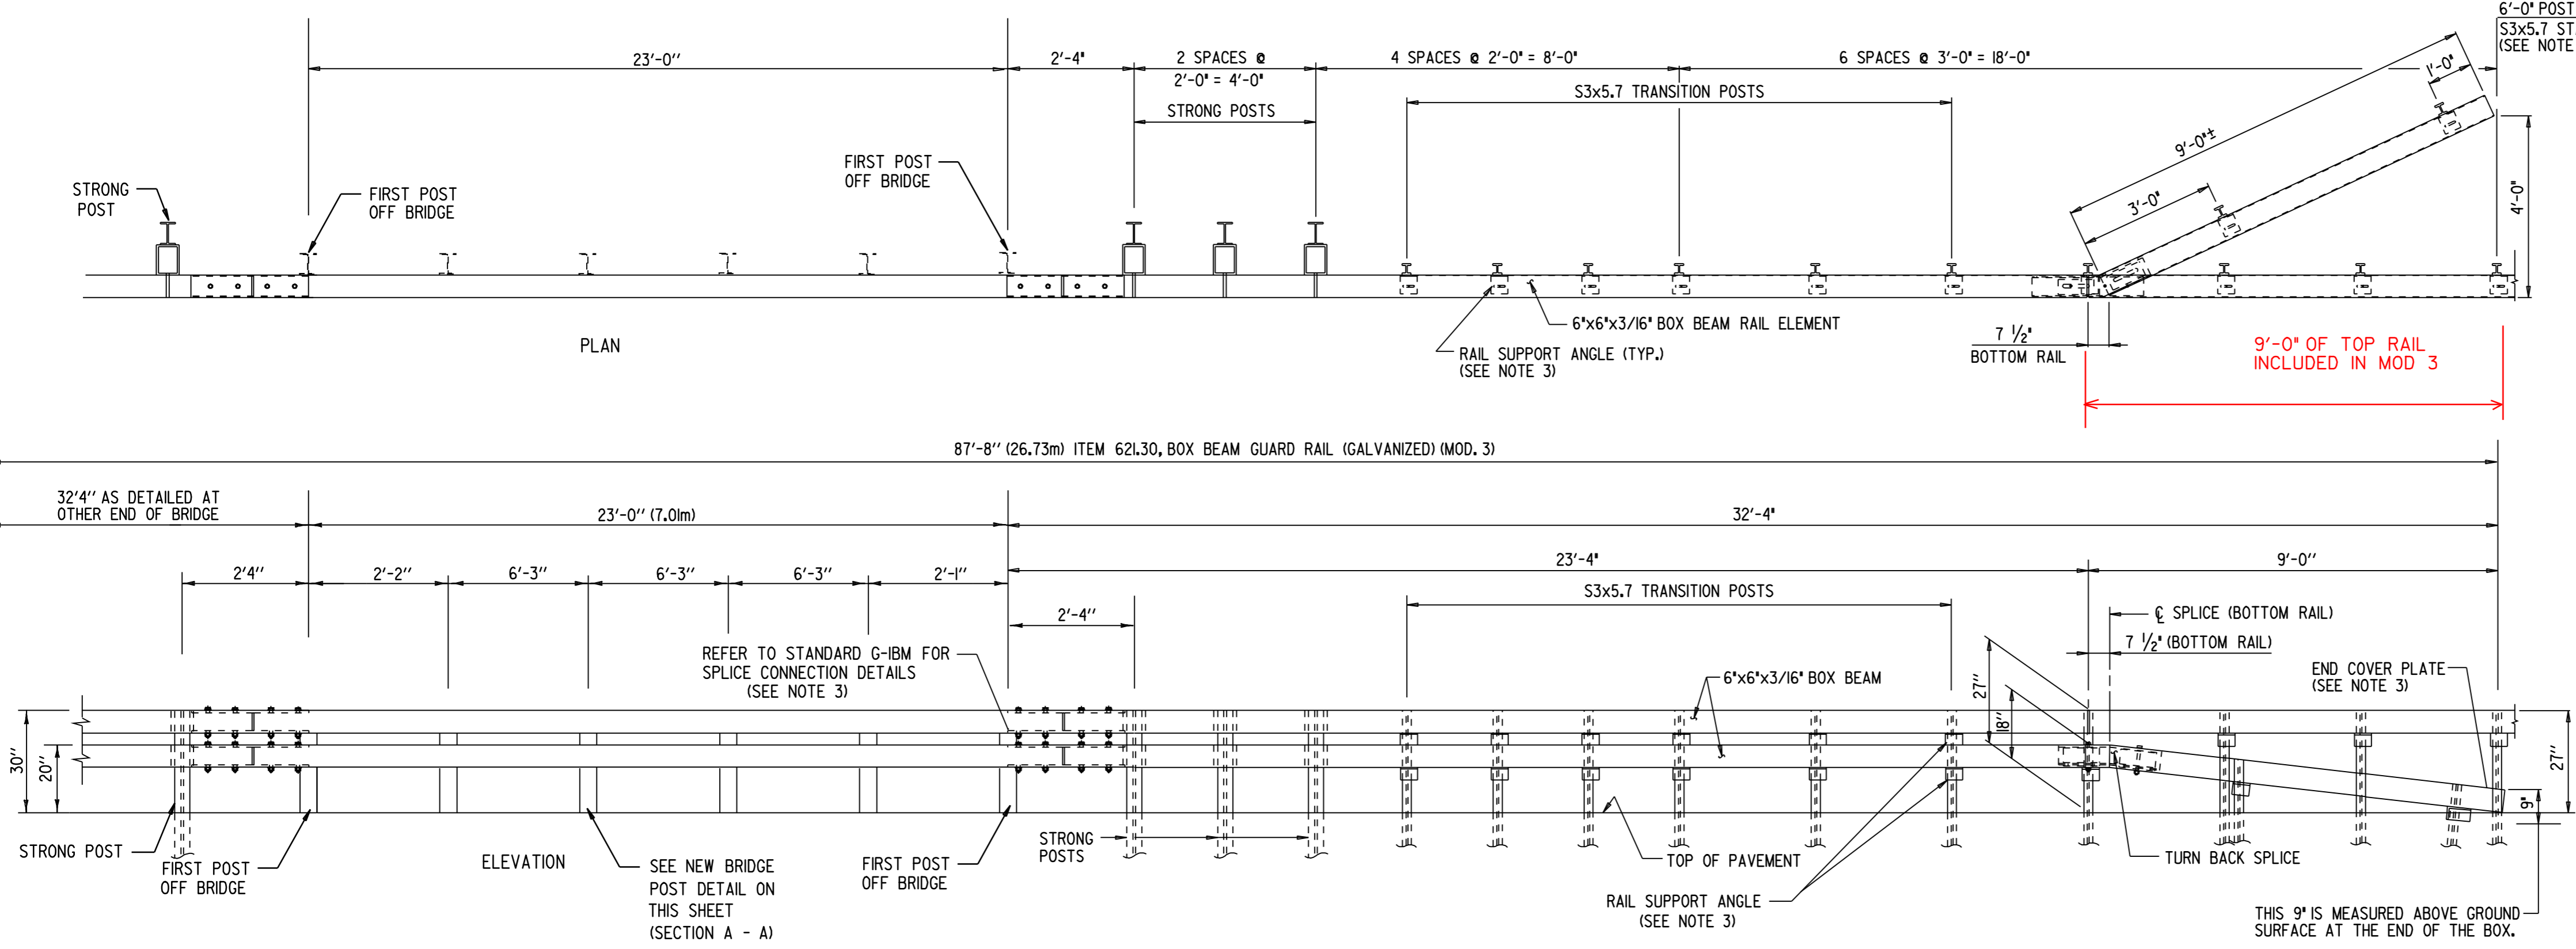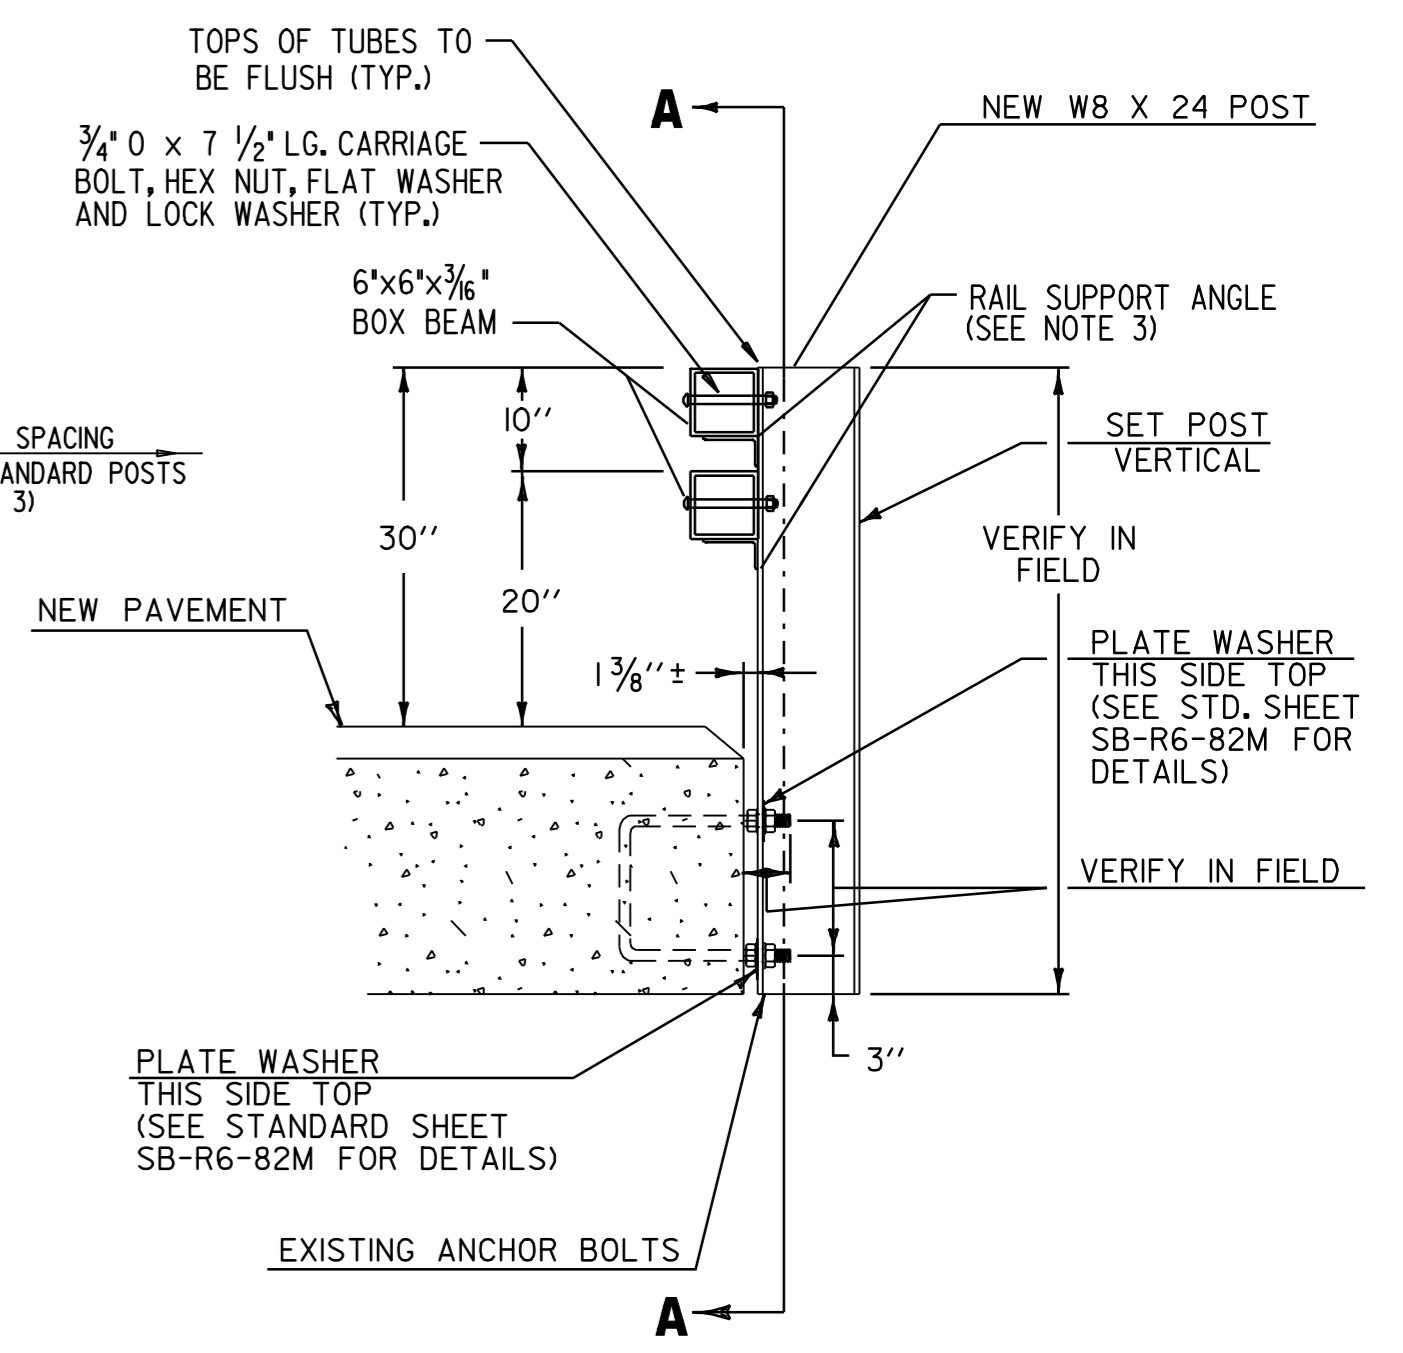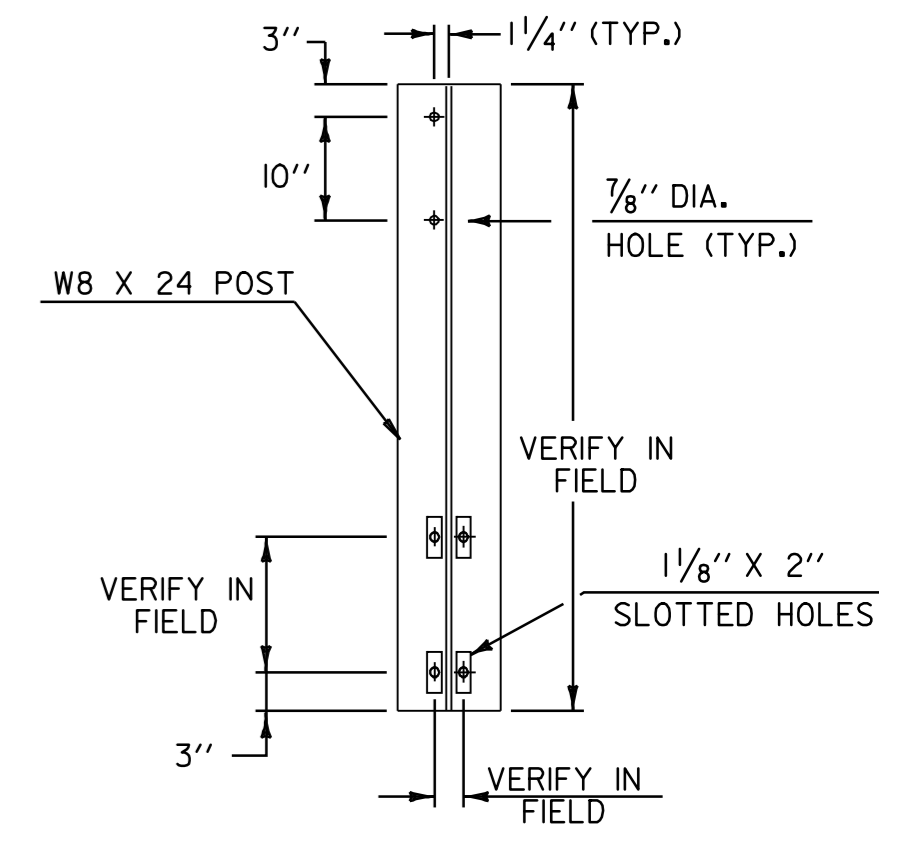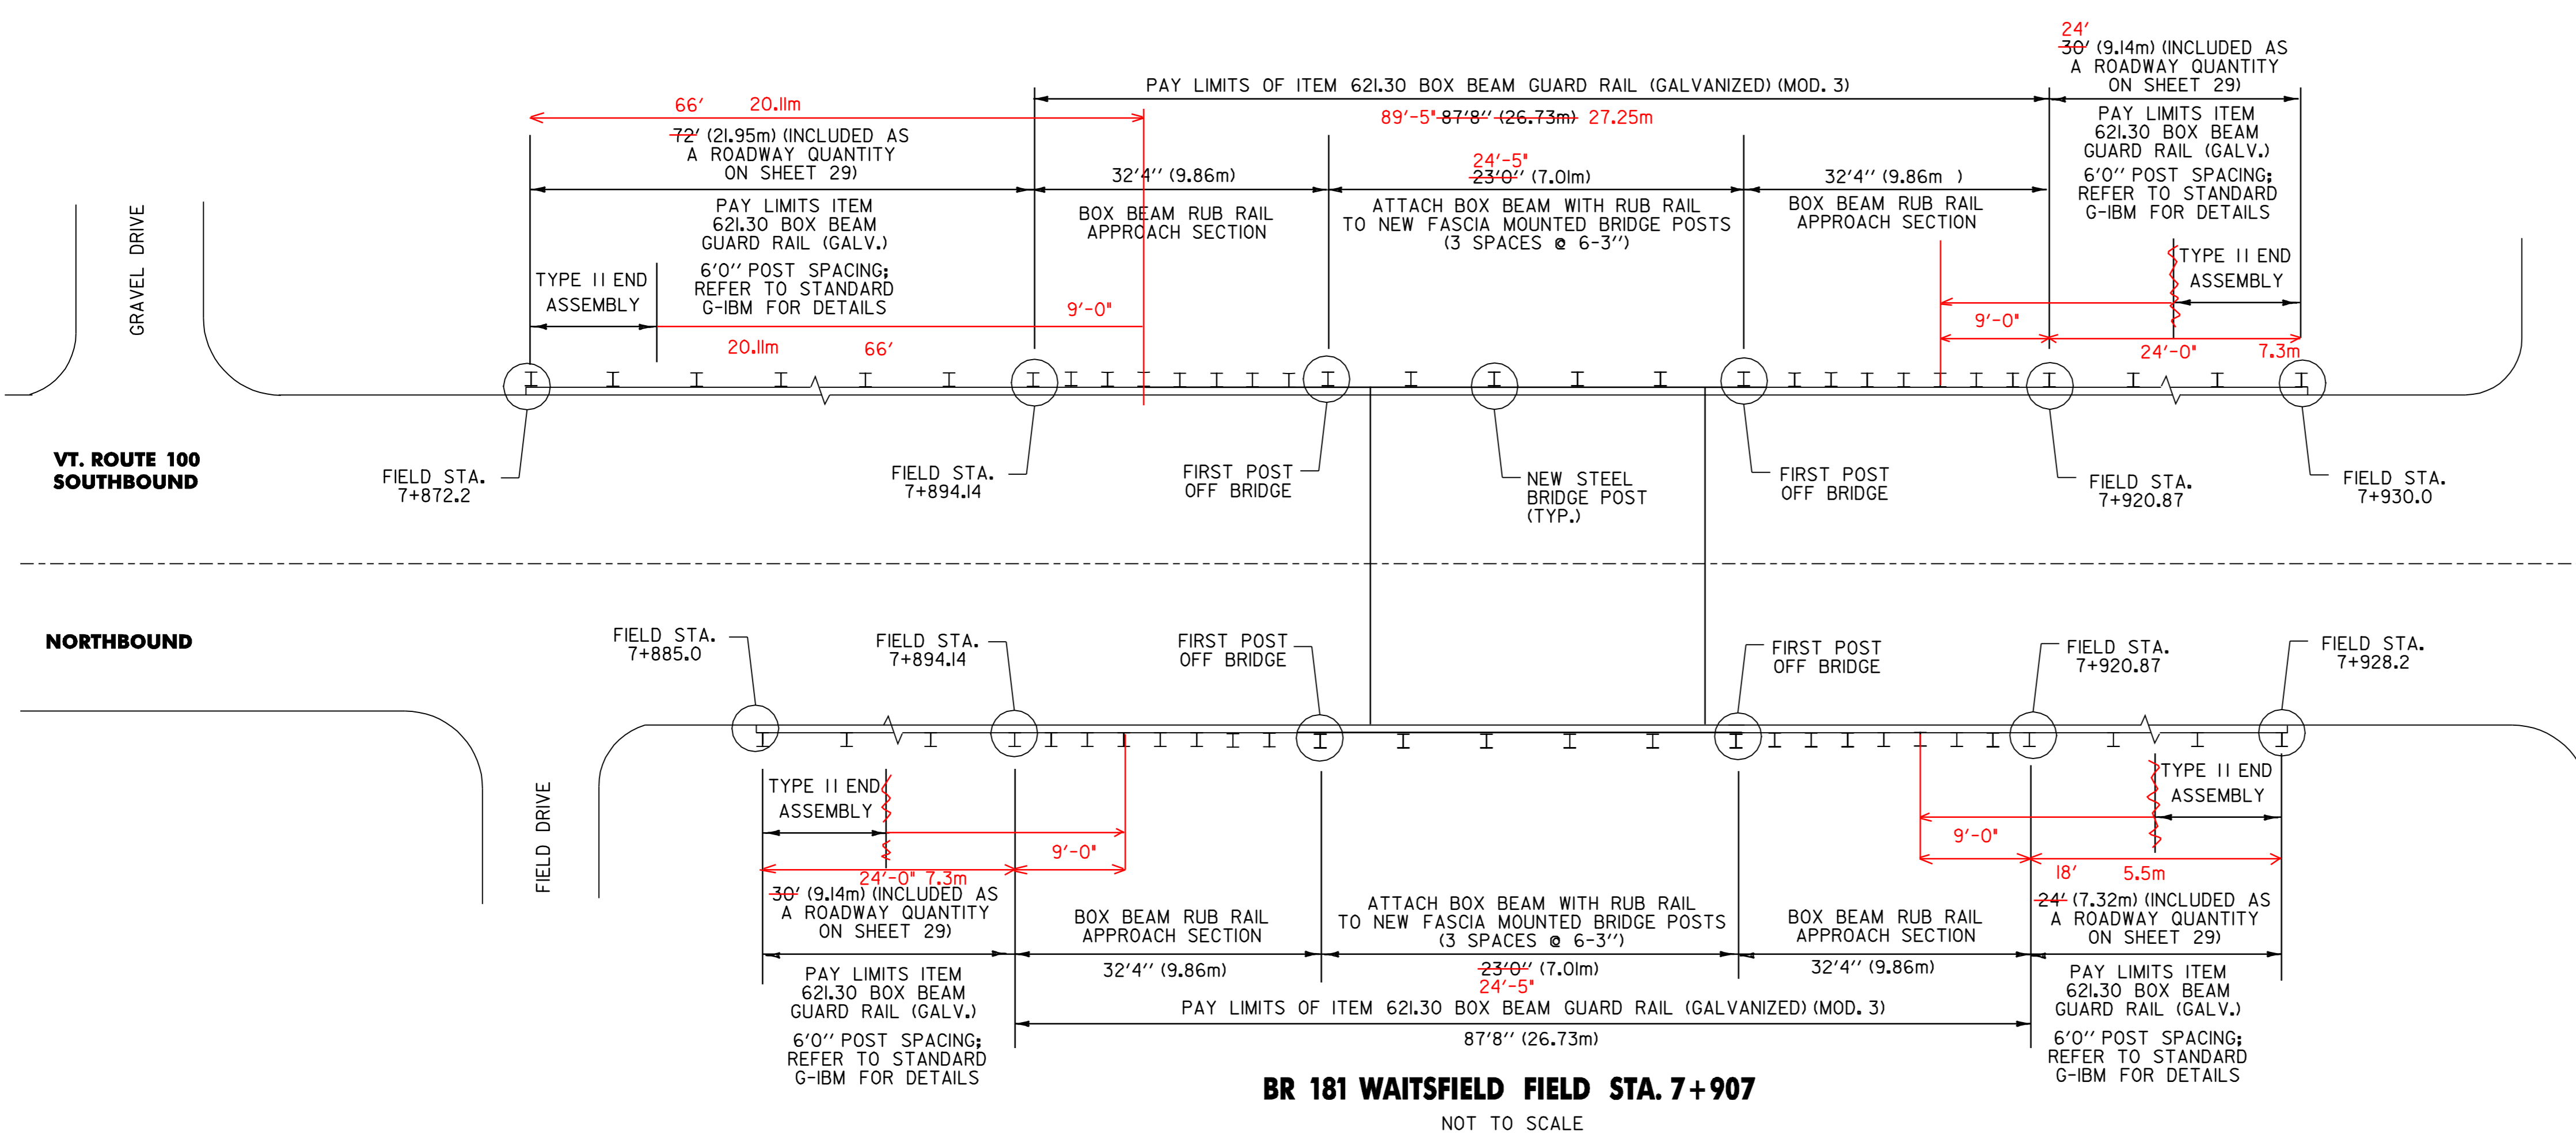


NOTE: REFER TO SHEET 45 FOR THE GENERAL NOTES, STRONG POST DETAILS, TRANSITION POST DETAILS, SPLICE DETAILS AND WELDING DETAILS ASSOCIATED WITH THE BOX BEAM GUARD RAIL (GALVANIZED) (MOD. 3) DETAILED ON THIS SHEET.

<h3>BRIDGE #181 DETAIL SHEET</h3>	PROJECT :	PROJECT NO. :
	WAITSFIELD - MORETOWN	STP 2227(I) S
	DESIGN FILE NAME: pave/00b058/00b058.dgn	PLOT DATE: 23-MAY-2008
	IPARM FILE NAME: 00b058br-g2.i	SURVEY DATE: 7/05
	SURVEYED BY: LFW	DRAWN BY: LFW
SQUAD LEADER: LFW	SHEET: 46 OF 54	


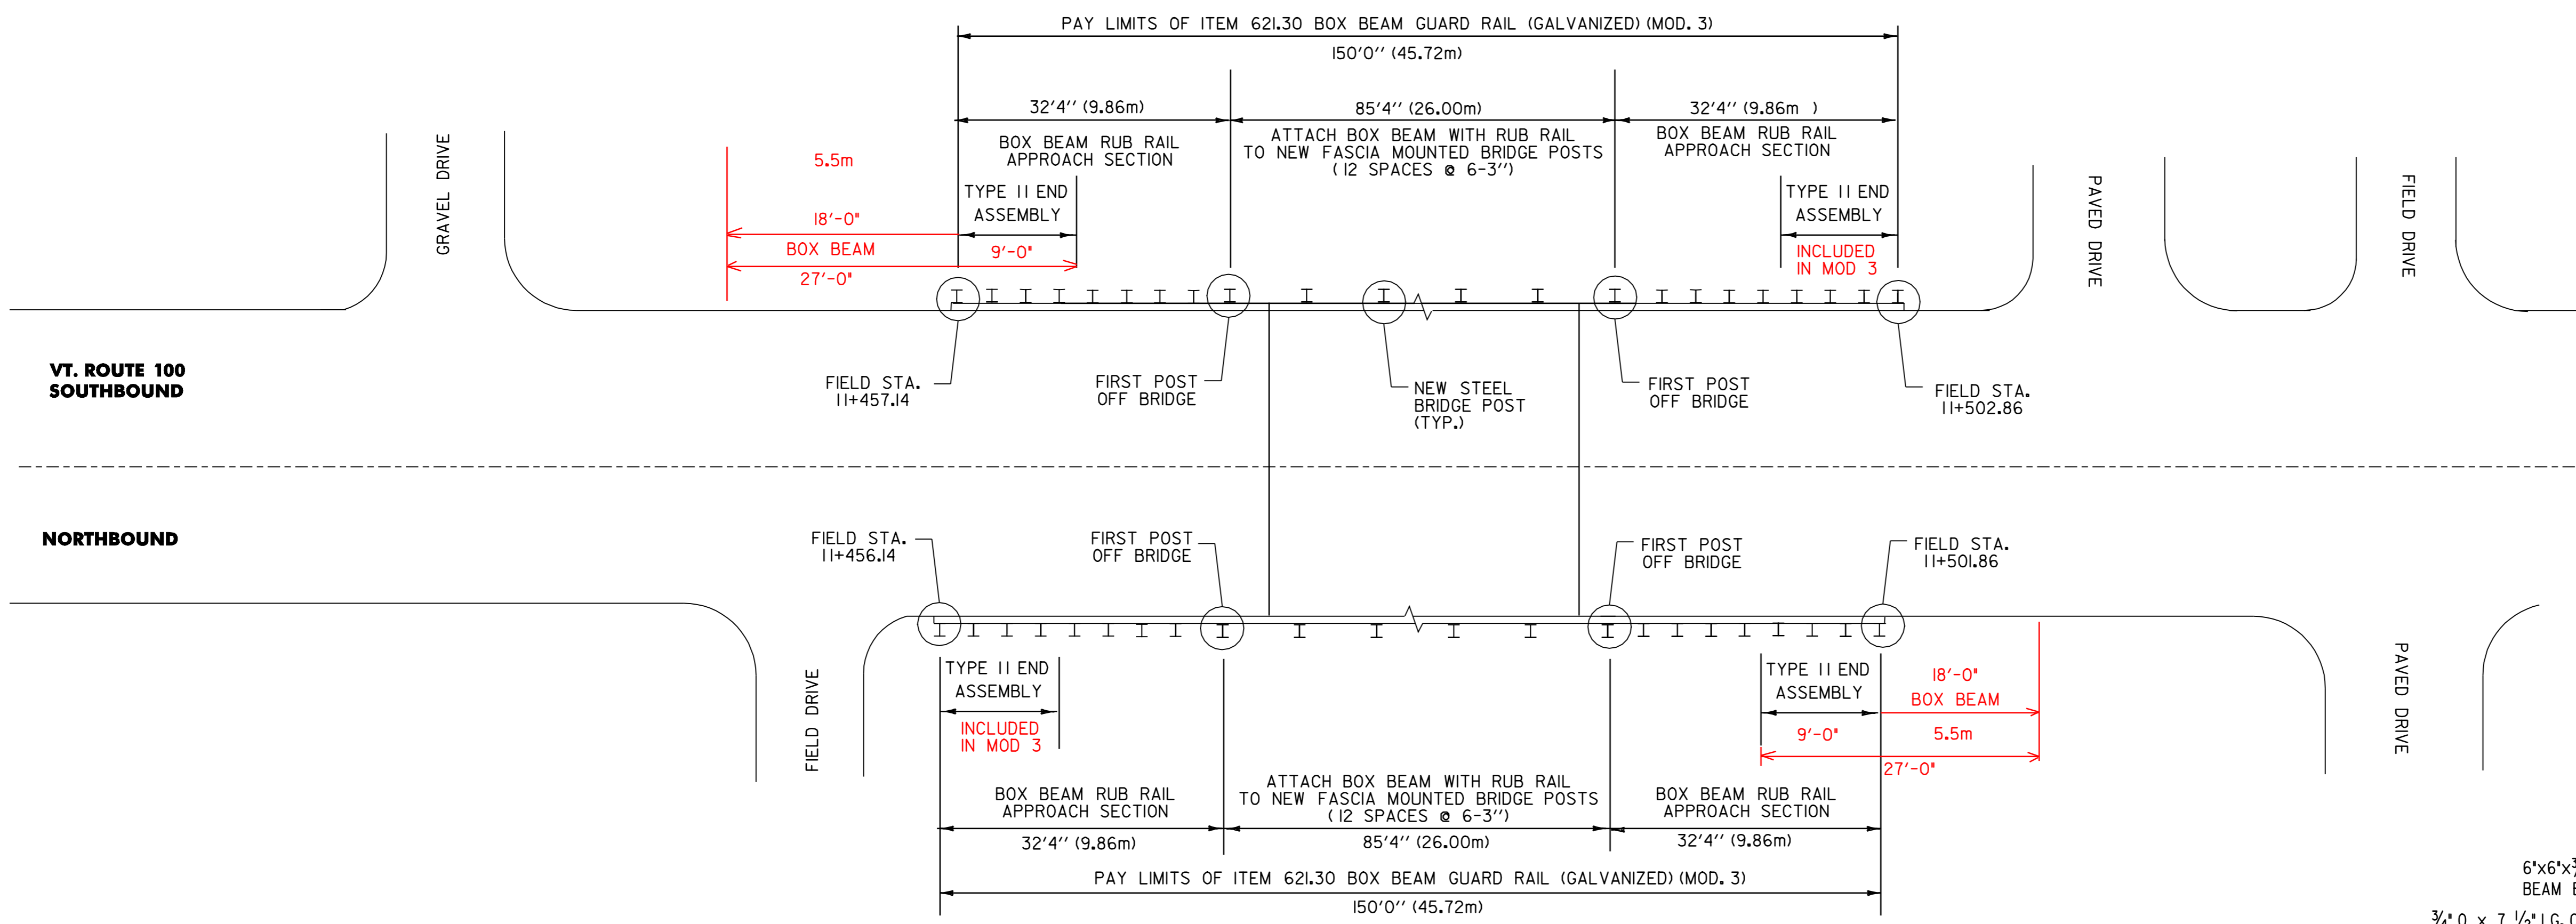


**BR 186 WAITSFIELD FIELD STA. 11+479**  
NOT TO SCALE

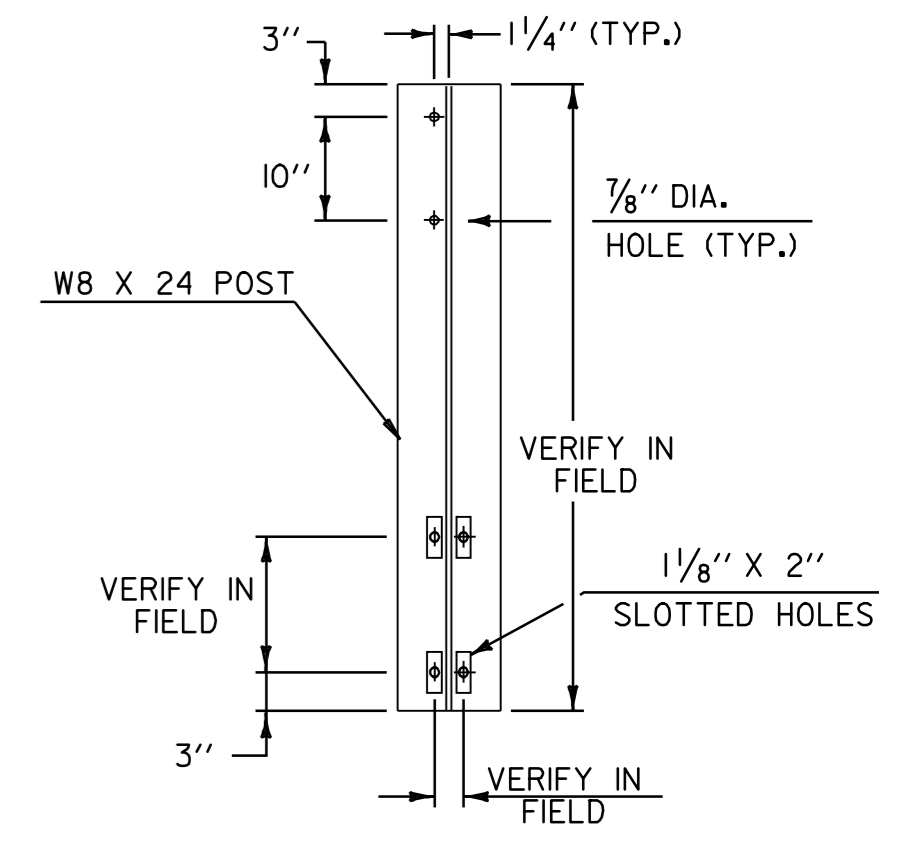


**SECTION A-A**

**BR 186 BRIDGE POST DETAIL**  
NOT TO SCALE

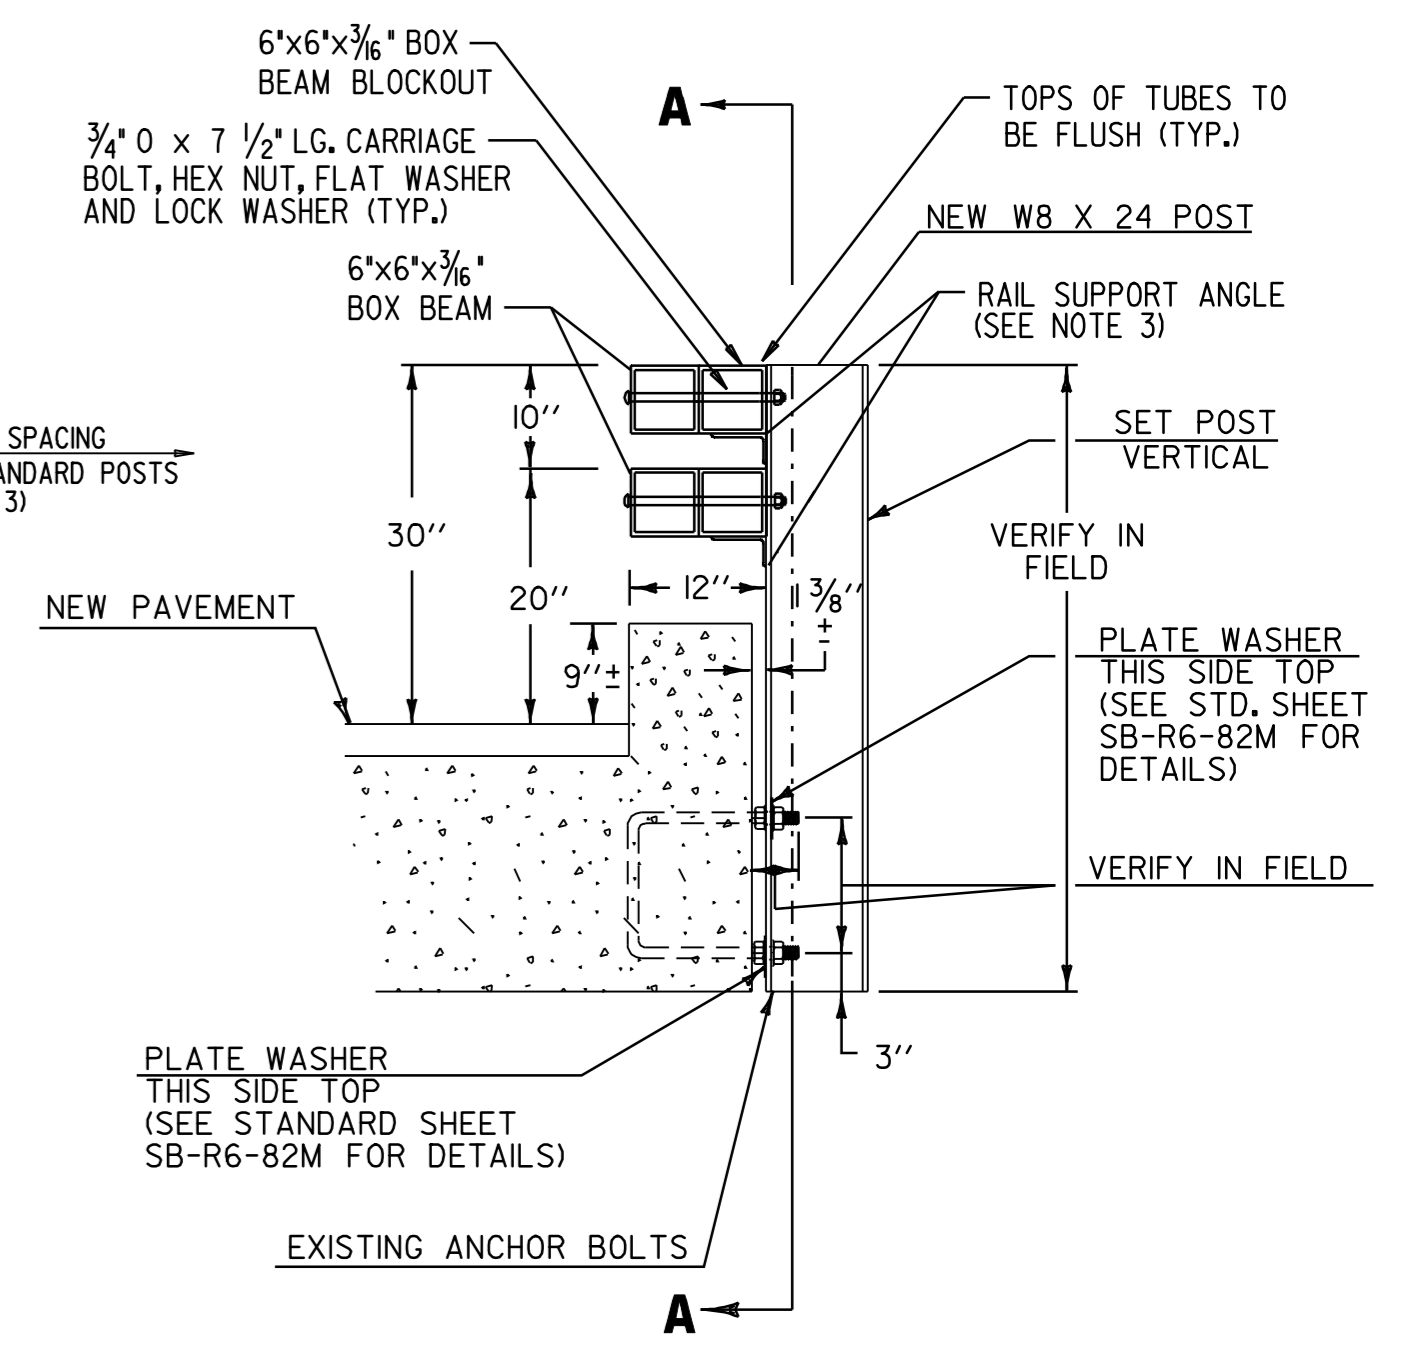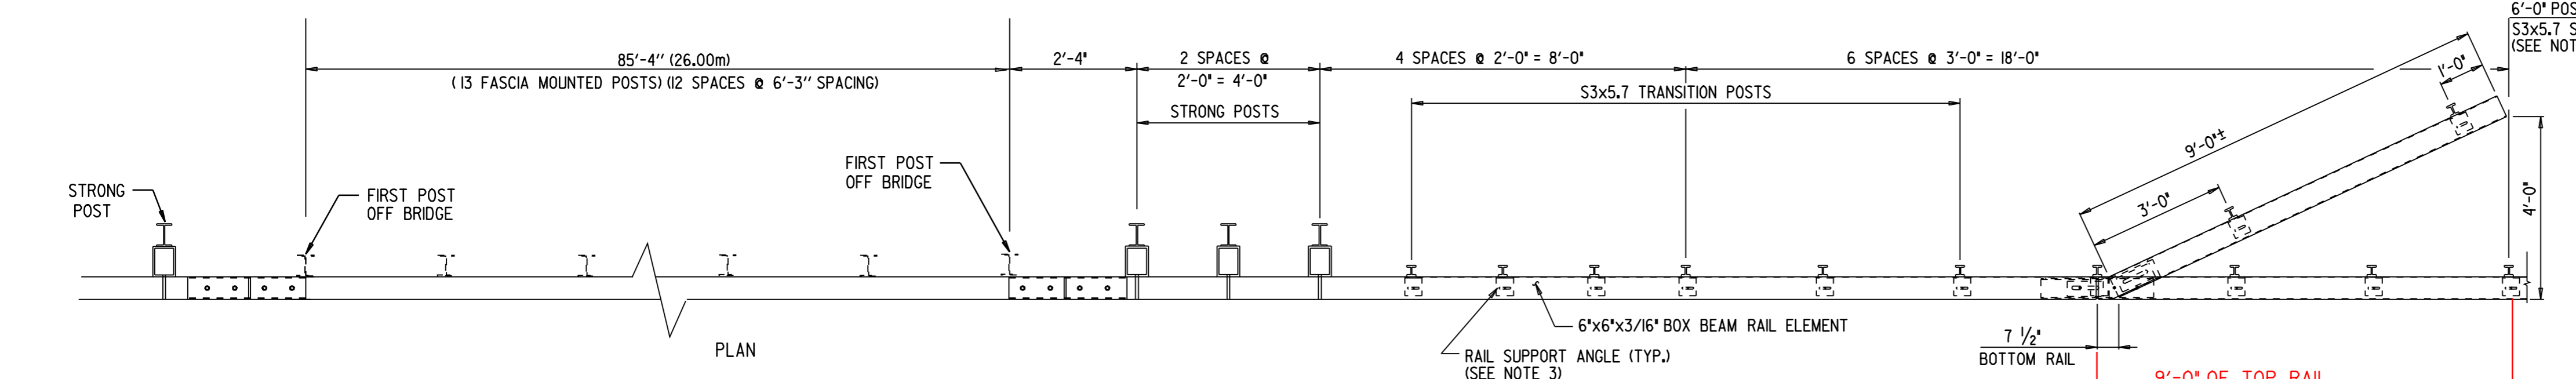


**BRIDGE POST DETAIL NOTES**

1. LOCATION OF EXISTING ANCHOR BOLTS TO BE VERIFIED IN THE FIELD BY THE CONTRACTOR PRIOR TO ORDERING BRIDGE POSTS.
2. POSTS SHALL BE SHOP CUT AND DRILLED PRIOR TO GALVANIZING.
3. SEE STANDARD SHEET SB-R6-82M FOR ADDITIONAL POST DETAILS.

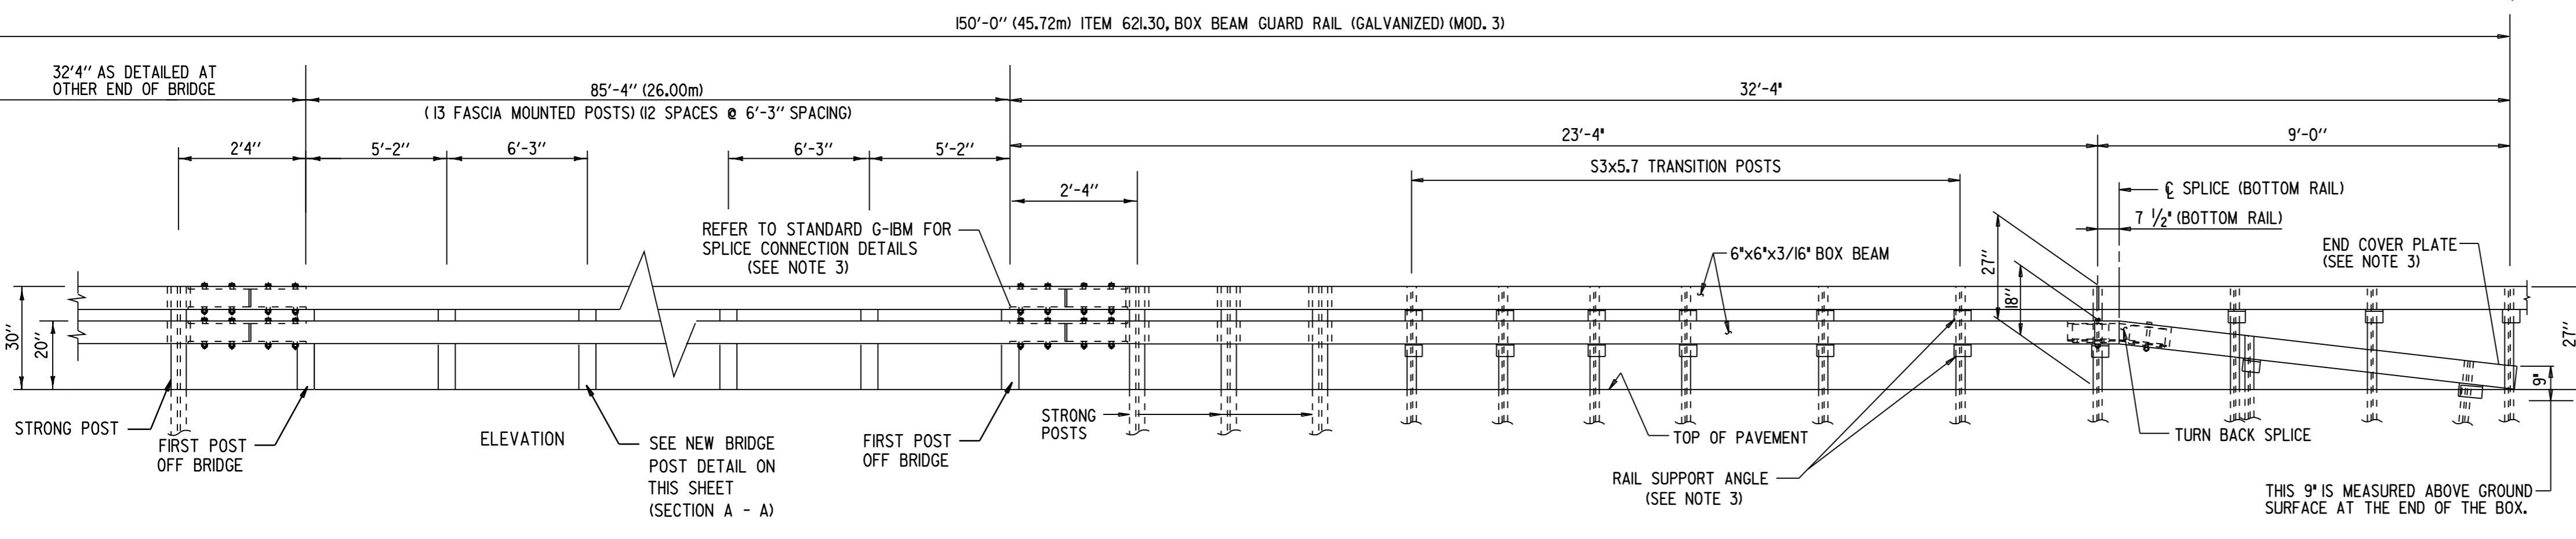


NOTE: REFER TO SHEET 45 FOR THE GENERAL NOTES, STRONG POST DETAILS, TRANSITION POST DETAILS, SPLICE DETAILS AND WELDING DETAILS ASSOCIATED WITH THE BOX BEAM GUARD RAIL (GALVANIZED) (MOD. 3) DETAILED ON THIS SHEET.



<p><b>BRIDGE #186</b> <b>DETAIL</b> <b>SHEET</b></p>	PROJECT :	PROJECT NO. :
	WAITSFIELD - MORETOWN	STP 2227(I) S
	DESIGN FILE NAME: pave/00b058/00b058.dgn	PLOT DATE: 23-MAY-2008
	IPARM FILE NAME: 00b058brg3.i	SURVEY DATE: 7/05
	SURVEYED BY: LFW	DRAWN BY: 7/05
SQUAD LEADER: LFW	SHEET: 47 OF 54	

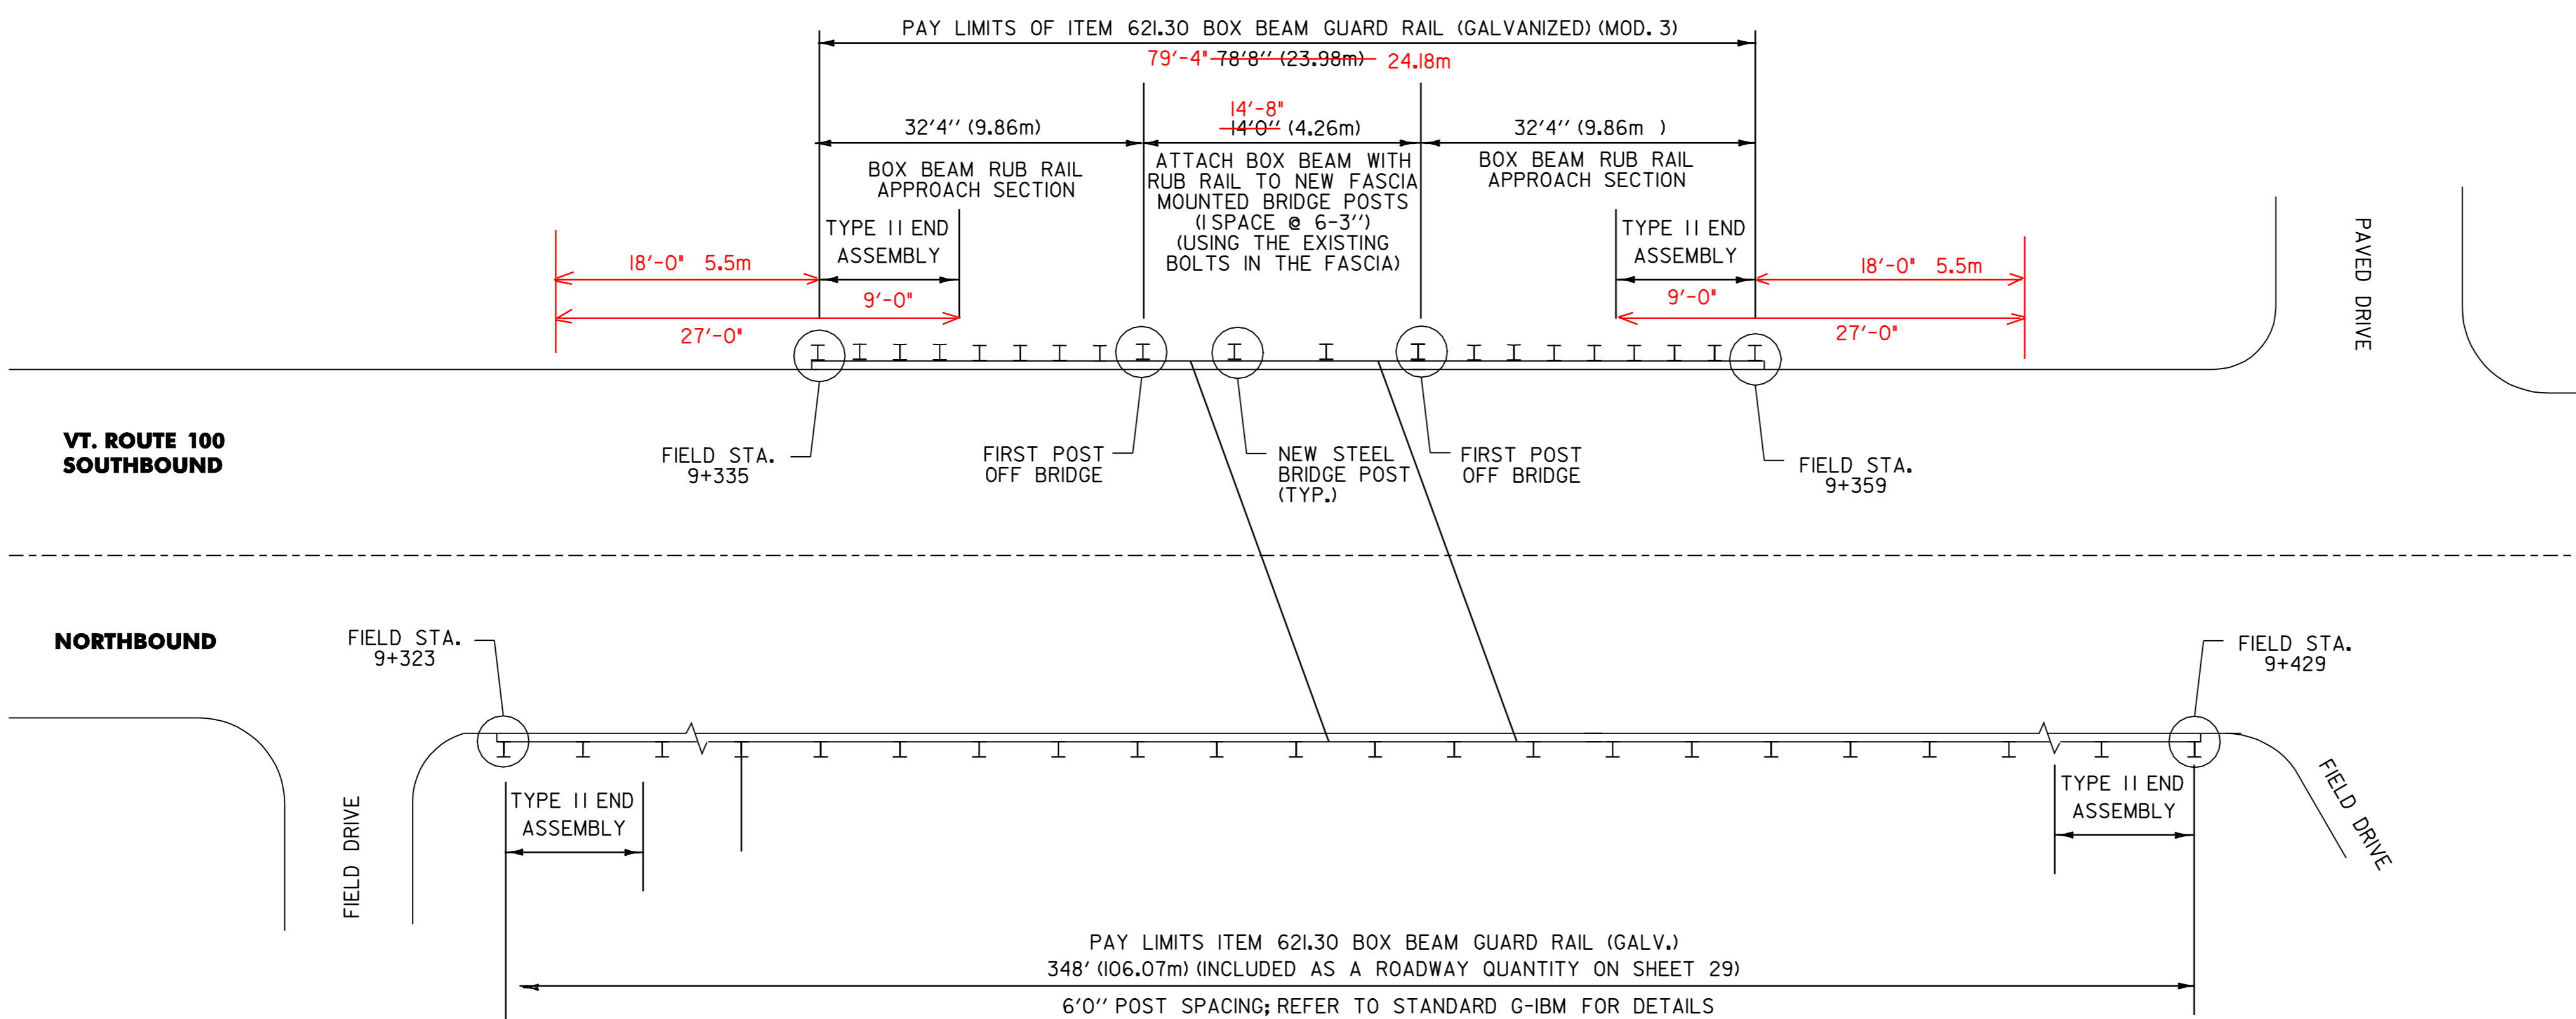

**BR 185 WAITSFIELD FIELD STA. 9+353**  
NOT TO SCALE

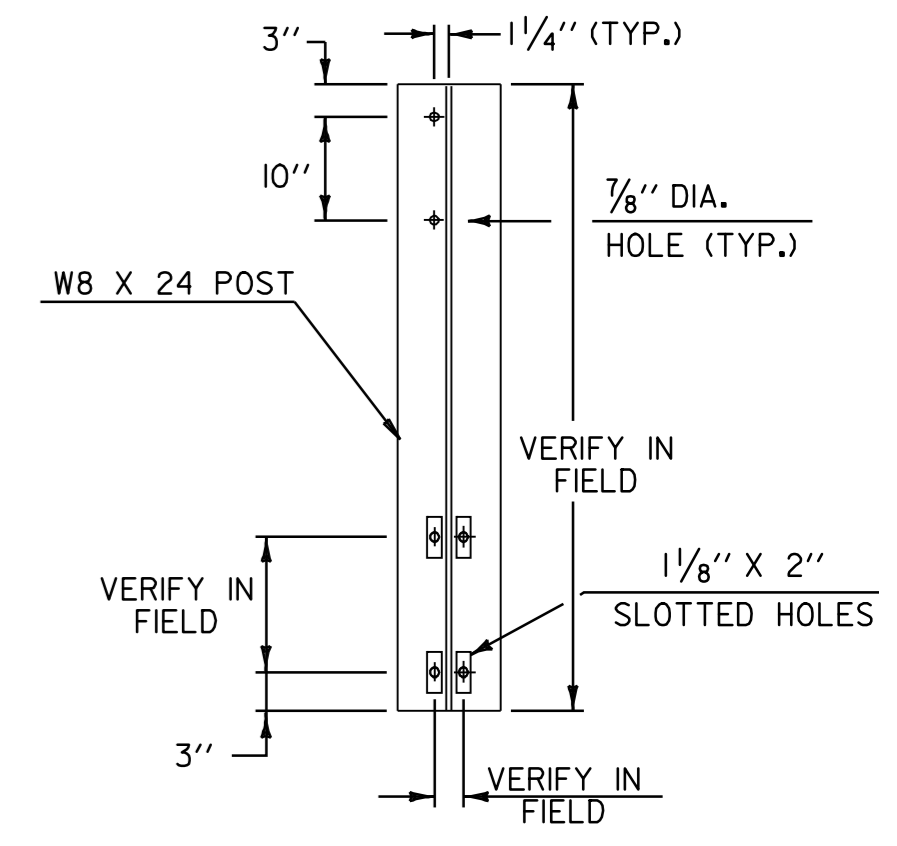


**SECTION A-A**  
**BR 185 BRIDGE POST DETAIL**  
NOT TO SCALE

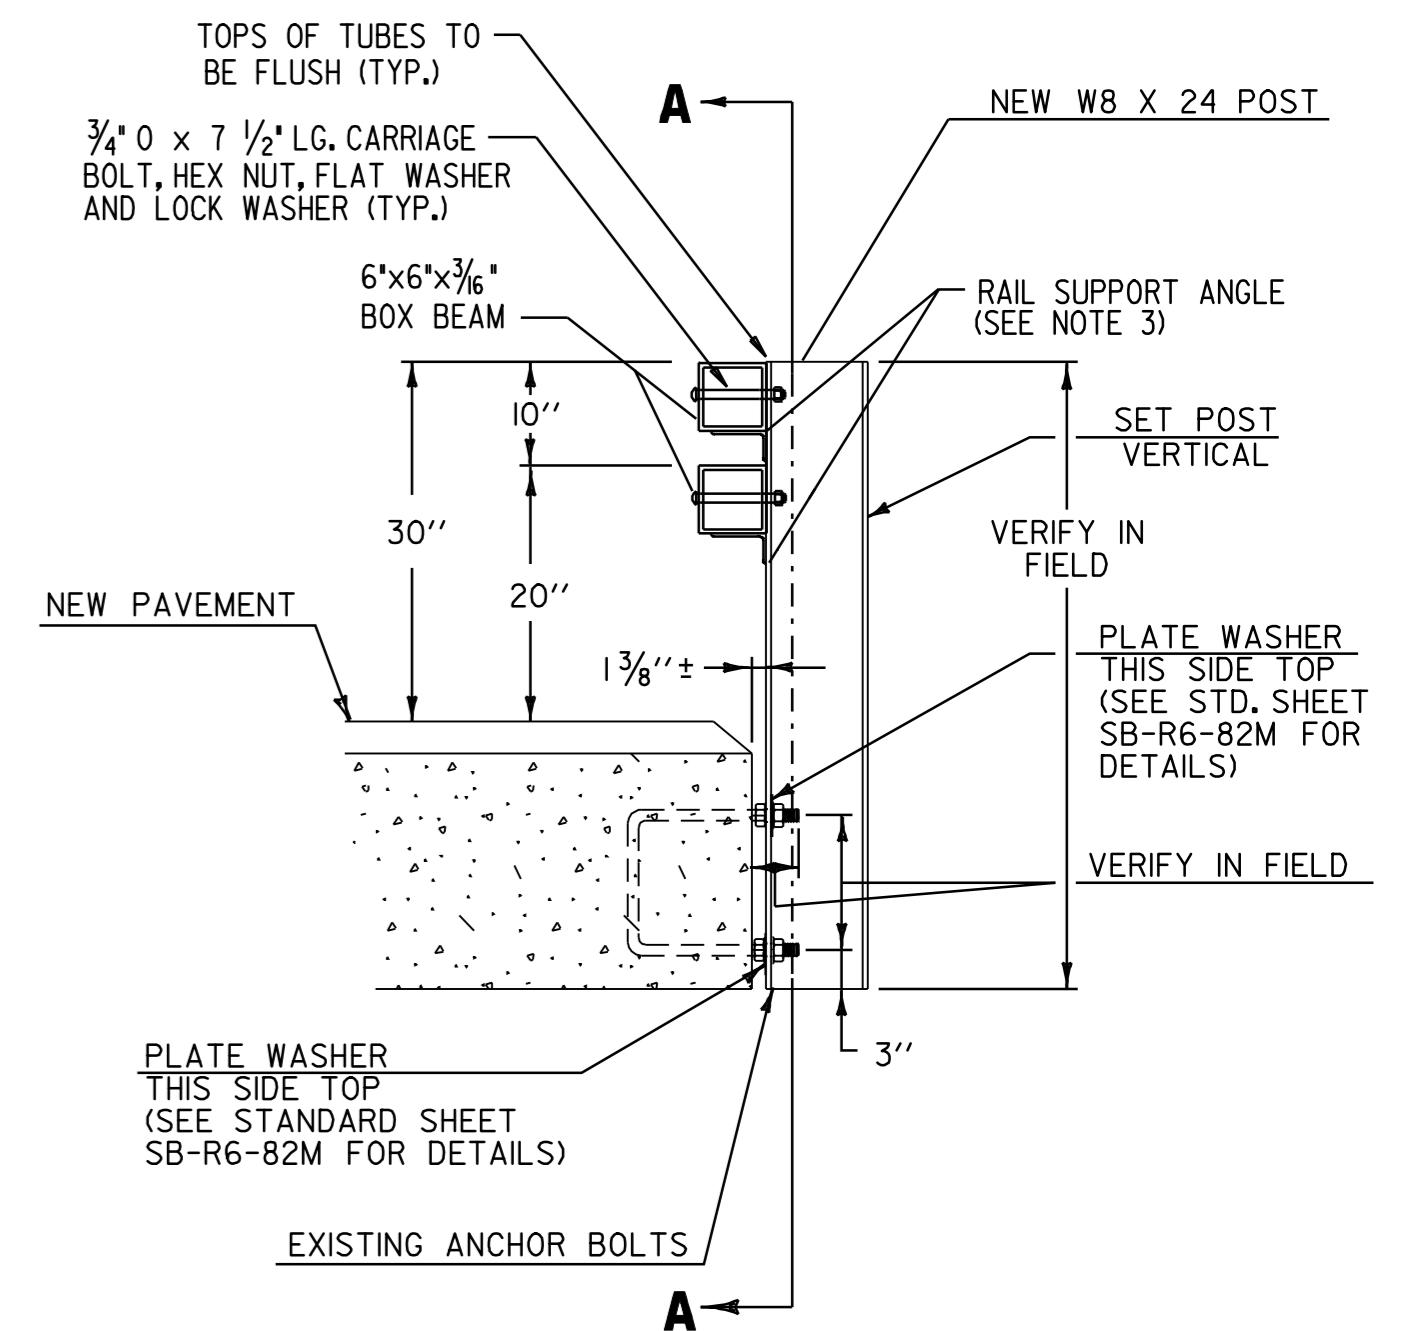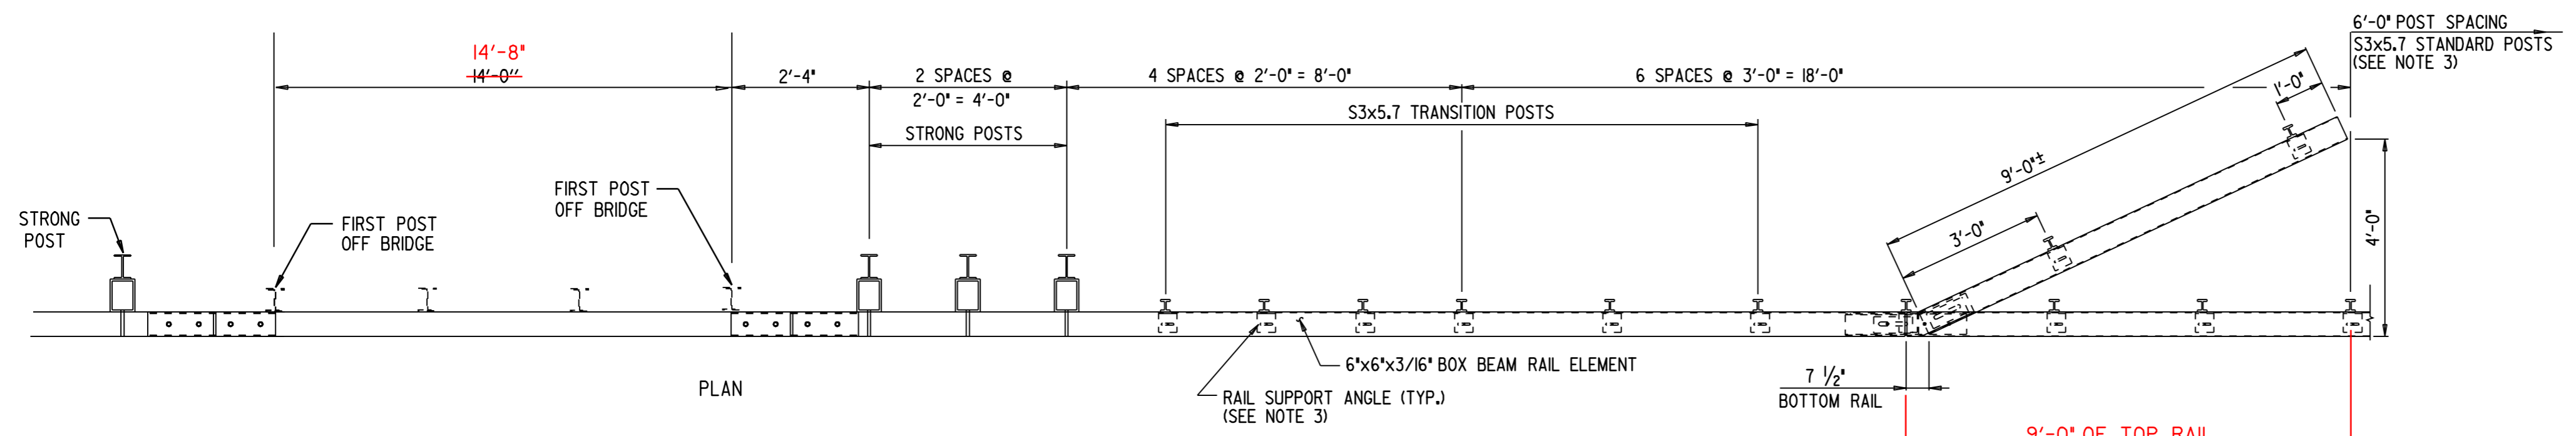


**BRIDGE POST DETAIL NOTES**

1. LOCATION OF EXISTING ANCHOR BOLTS TO BE VERIFIED IN THE FIELD BY THE CONTRACTOR PRIOR TO ORDERING BRIDGE POSTS.
2. POSTS SHALL BE SHOP CUT AND DRILLED PRIOR TO GALVANIZING.
3. SEE STANDARD SHEET SB-R6-82M FOR ADDITIONAL POST DETAILS.

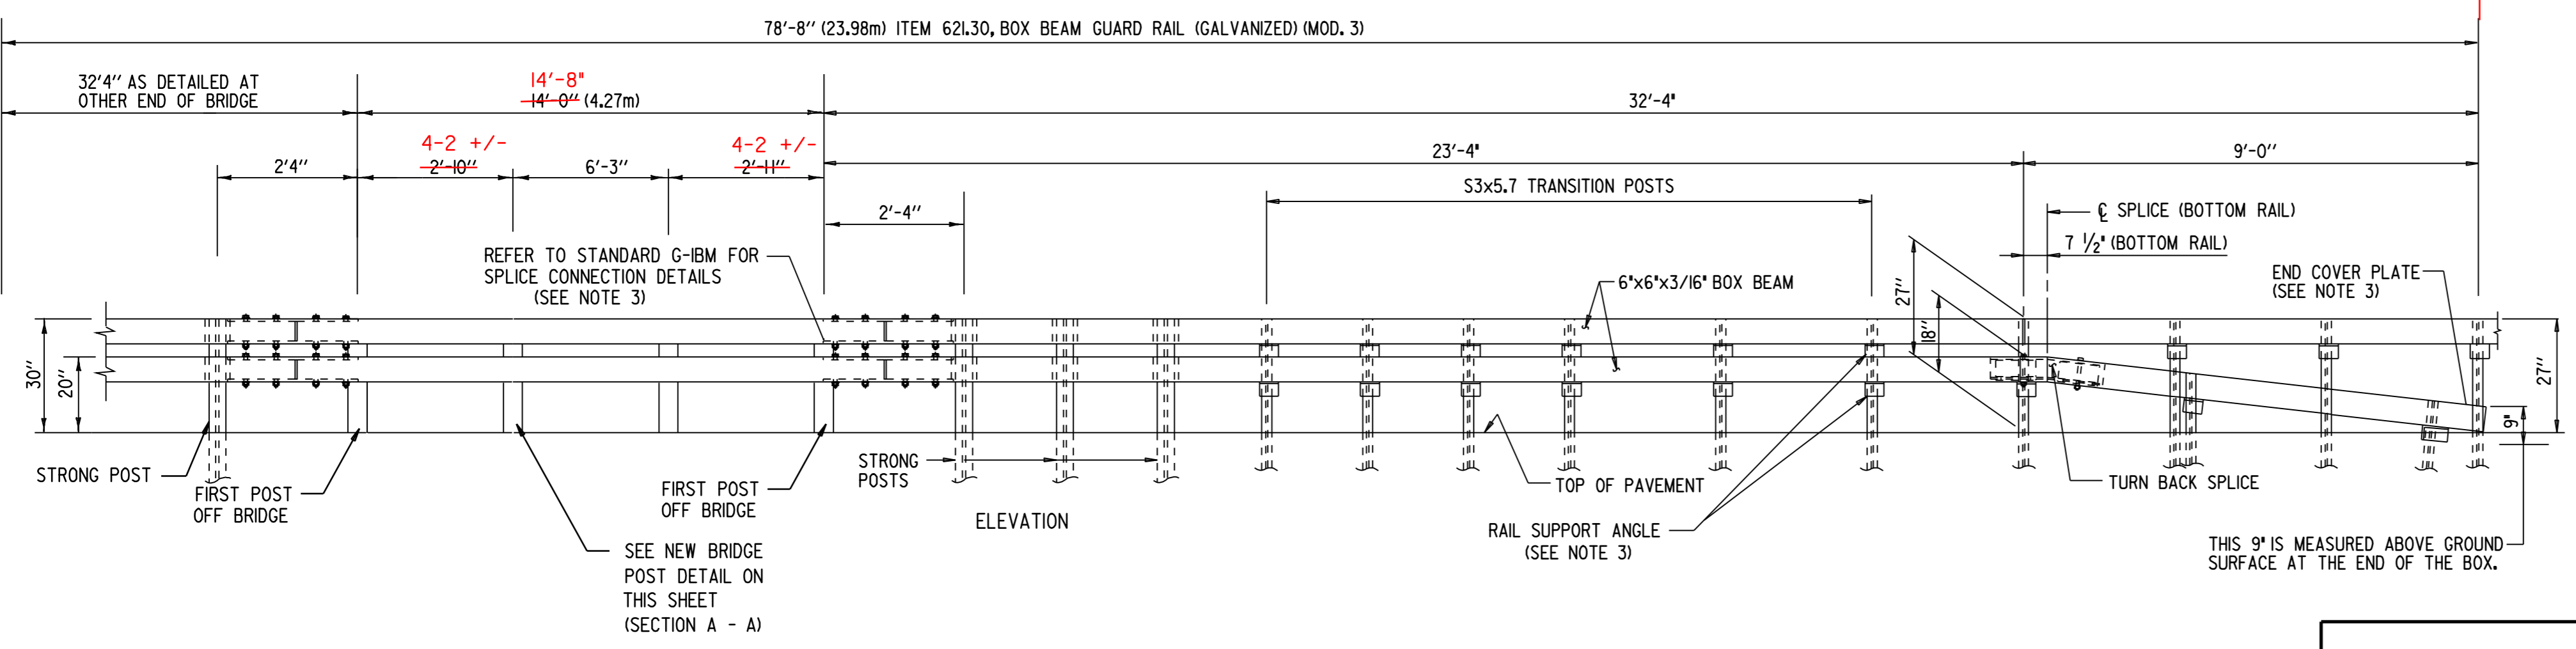


NOTE: REFER TO SHEET 45 FOR THE GENERAL NOTES, STRONG POST DETAILS, TRANSITION POST DETAILS, SPLICE DETAILS AND WELDING DETAILS ASSOCIATED WITH THE BOX BEAM GUARD RAIL (GALVANIZED) (MOD. 3) DETAILED ON THIS SHEET.

<b>BRIDGE #185 DETAIL SHEET</b>	PROJECT :	WAITSFIELD - MORETOWN	PROJECT NO. :	STP 2227(I) S
	DESIGN FILE NAME:	pave/00b058/00b058.dgn	PLOT DATE:	23-MAY-2008
	IPARM FILE NAME:	00b058br-g4.i	SURVEY DATE:	7/05
	SURVEYED BY:	LFW	DRAWN BY:	7/05
	SQUAD LEADER:	LFW	SHEET:	48 OF 54

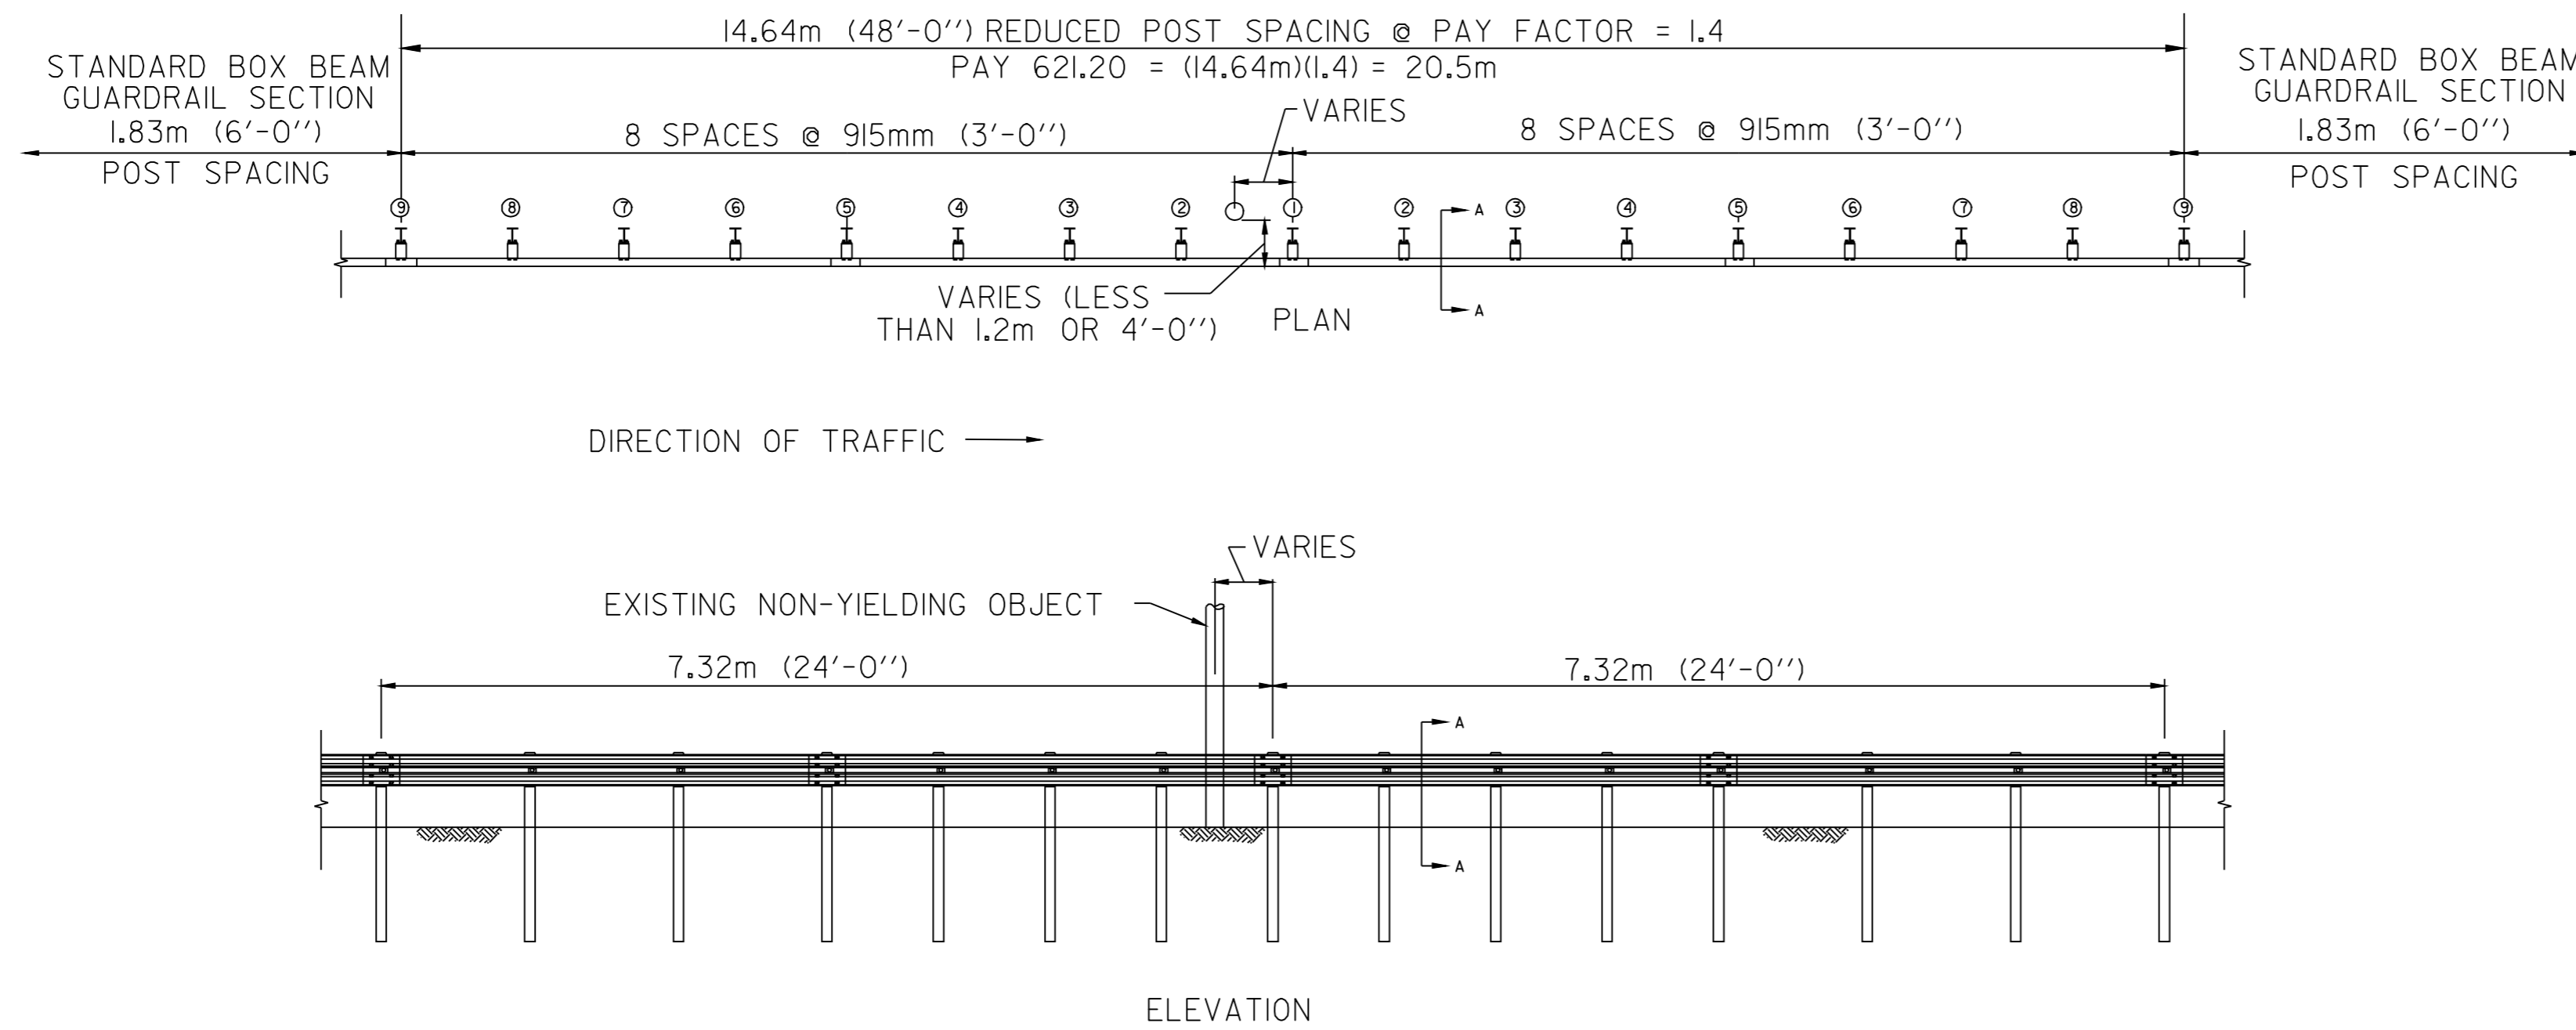


**NON-YIELDING OBJECT APPROACH DETAIL**

**WAITSFIELD  
FIELD STA. 9+617 RT  
NOT TO SCALE**

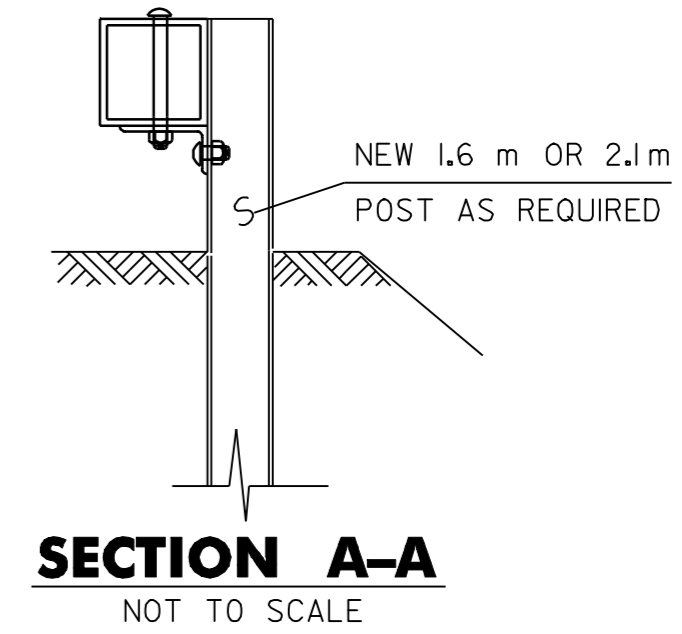

**NOTES**

1. SEE STANDARD G-IBM FOR BOX BEAM GUARDRAIL DETAILS.
2. THIS WORK SHALL BE PAID UNDER ITEM 621.30 BOX BEAM GUARDRAIL (GALV.) OR 621.30 BOX BEAM GUARDRAIL (GALV.) (2.1m POSTS) AT THE PAY FACTOR INDICATED IN THIS DETAIL.
3. THIS DETAIL TO BE USED AS INDICATED ON THE ITEM DETAIL SUMMARY SHEETS OR AS DIRECTED BY THE RESIDENT ENGINEER.

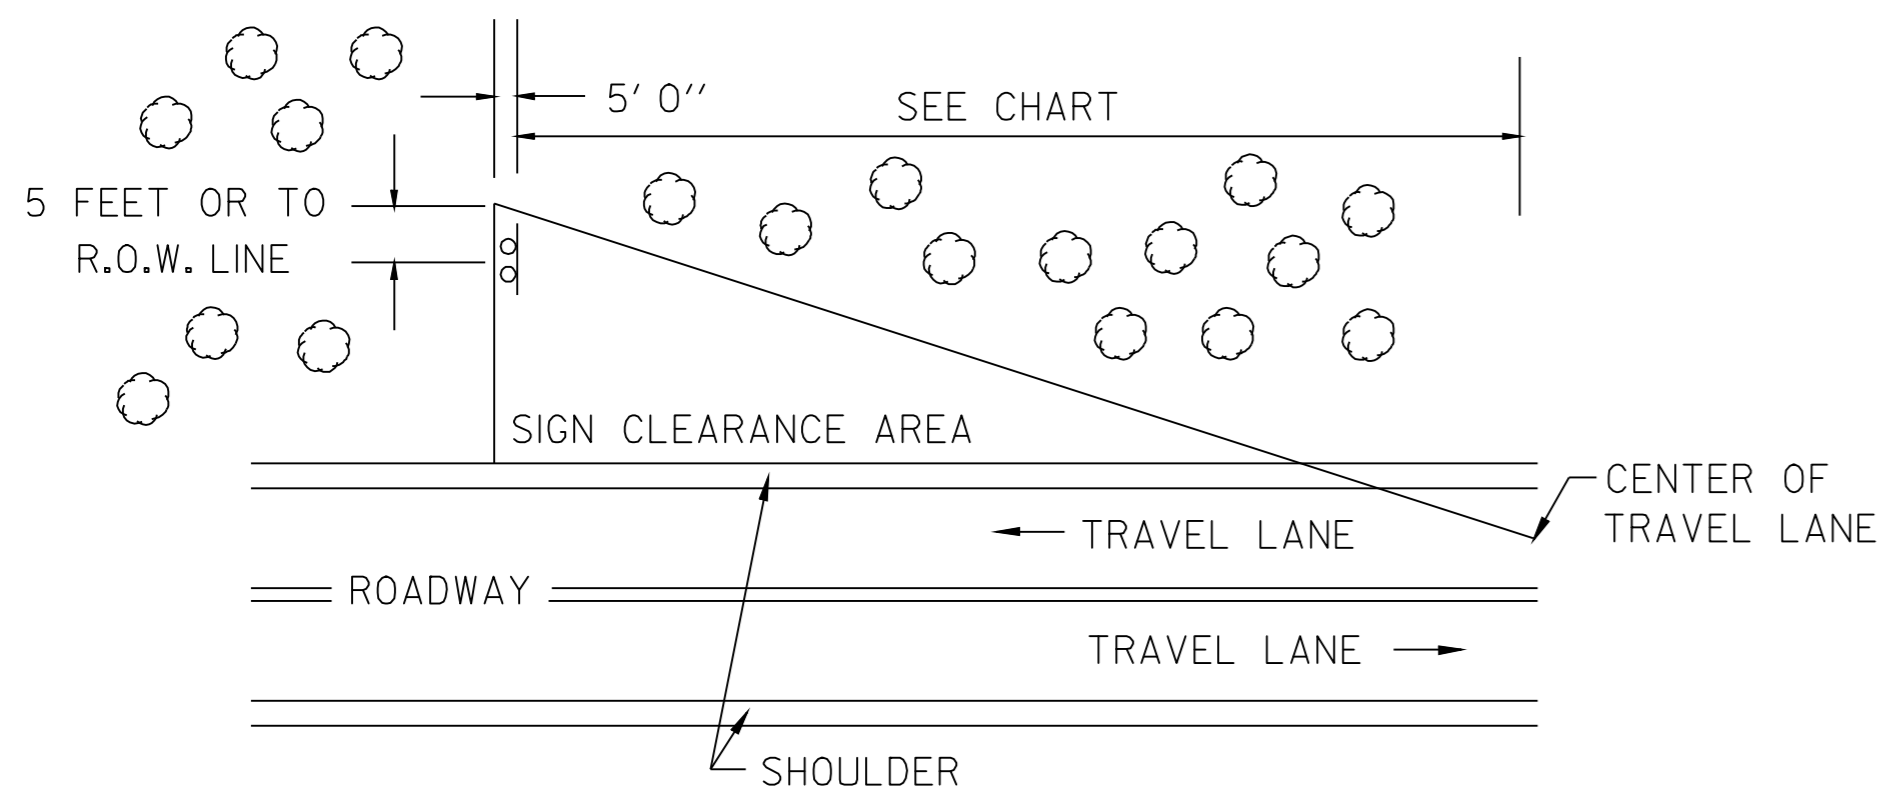


MINIMUM SIGN SIGHT DISTANCE CHART

APPROACH SPEED (mph)	SIGHT DISTANCE	
	(meters)	(feet)
30 OR LESS	90	300
35	105	350
40	120	400
45	135	450
50	150	500
55	165	550


**CLEARING LIMITS FOR SIGNS ON CONVENTIONAL ROADS  
NOT TO SCALE**

THE CONTRACTOR SHALL REMOVE ALL WOODY STEMMED GROWTH INCLUDING BRUSH, SAPLINGS TREE LIMBS GROWING WITHIN OR PROJECTING INTO THE CLEARANCE AREA AND DOWN TO GROUND LEVEL. PAYMENT WILL BE FOR THINNING AND TRIMMING (FOR SIGNS) ITEM 201.31, AND PAID FOR PER EACH. (NO CHEMICALS, POISONS, OR DEFOLIANTS ALLOWED).

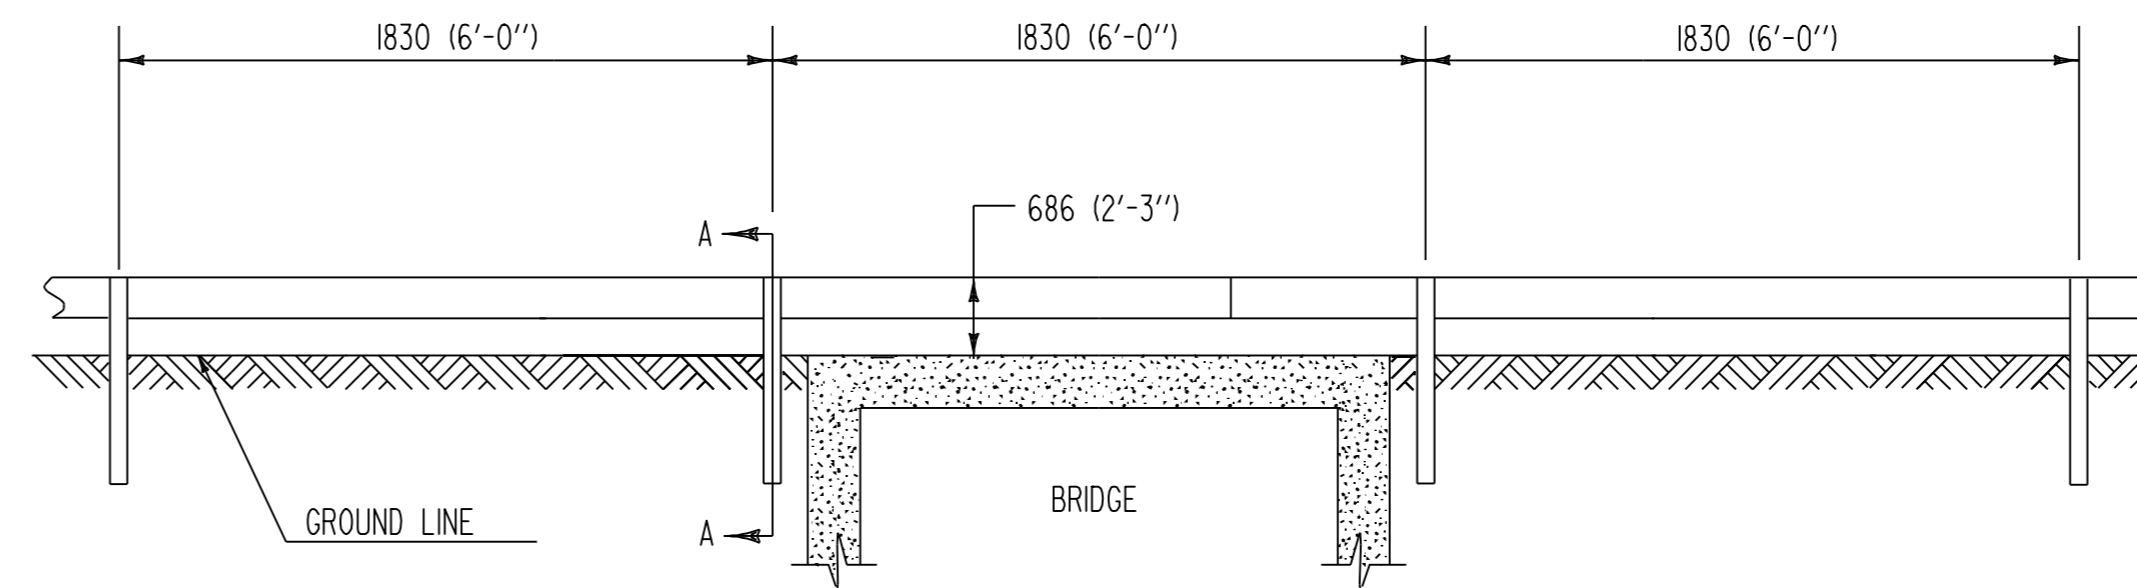

**DETAIL OF STEEL BEAM GUARDRAIL AT SMALL CULVERTS AND BRIDGES**

WAITSFIELD BRIDGE #180 - FIELD STA 7+646  
WAITSFIELD BRIDGE #184 - FIELD STA 8+735  
NOT TO SCALE

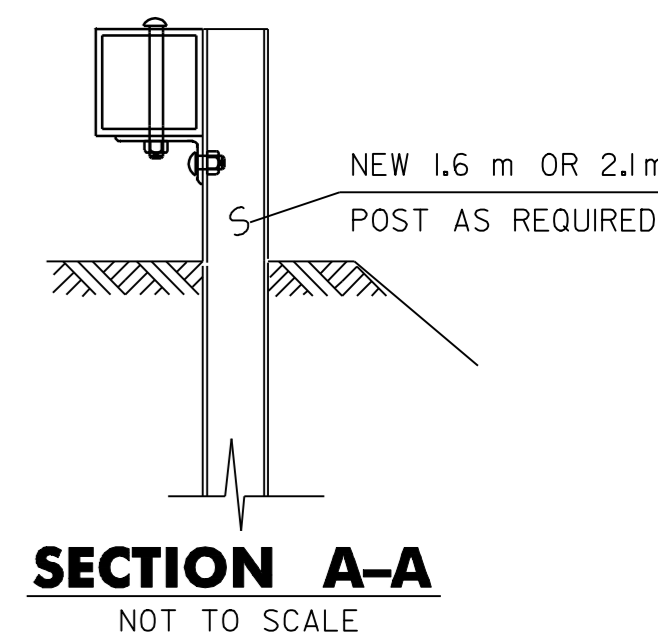


**NOTES**

1. SEE STANDARD G-IBM FOR BOX BEAM GUARDRAIL DETAILS.
2. THIS WORK SHALL BE PAID UNDER ITEM 621.30 BOX BEAM GUARDRAIL (GALV.) OR BOX BEAM GUARDRAIL (GALV.) (2.1m POSTS) AT A PAY FACTOR OF 1.0. REFER TO LAYOUT SHEETS FOR DETAILS.
3. THIS DETAIL TO BE USED AS INDICATED ON THE ITEM DETAIL SUMMARY SHEETS OR AS DIRECTED BY THE RESIDENT ENGINEER.


**MISCELLANEOUS DETAIL SHEET  
(BOX BEAM SPAN AT SMALL BRIDGE DETAIL)  
(BOX BEAM DETAIL AT NON-YIELDING OBJECTS)  
(CLEARING LIMITS FOR SIGNS)**

DESIGNED BY LFW DATE 7/05  
DRAWN BY LFW DATE 7/05  
DESIGN FILE NO. /pave/00b058/00b058.dgn  
PRF FILE 00b058d+1.i DATE PLOTTED 23-MAY-2008 12  
PROJ. NAME: WAITSFIELD - MORETOWN  
PROJ. NO.: STP 2227(1)S  
SHEET 49 OF 54 SHEETS

**CURVE #1**  
 PC FIELD STA. 7+135  
 PT FIELD STA. 7+485  
 △ 8°30' RT  
 T=175m  
 R=2355m  
 SUPERELEVATION=NC  
 RUNOFF=N/A  
 RUNOUT=N/A  
 V=80km/hr (50 m.p.h.)

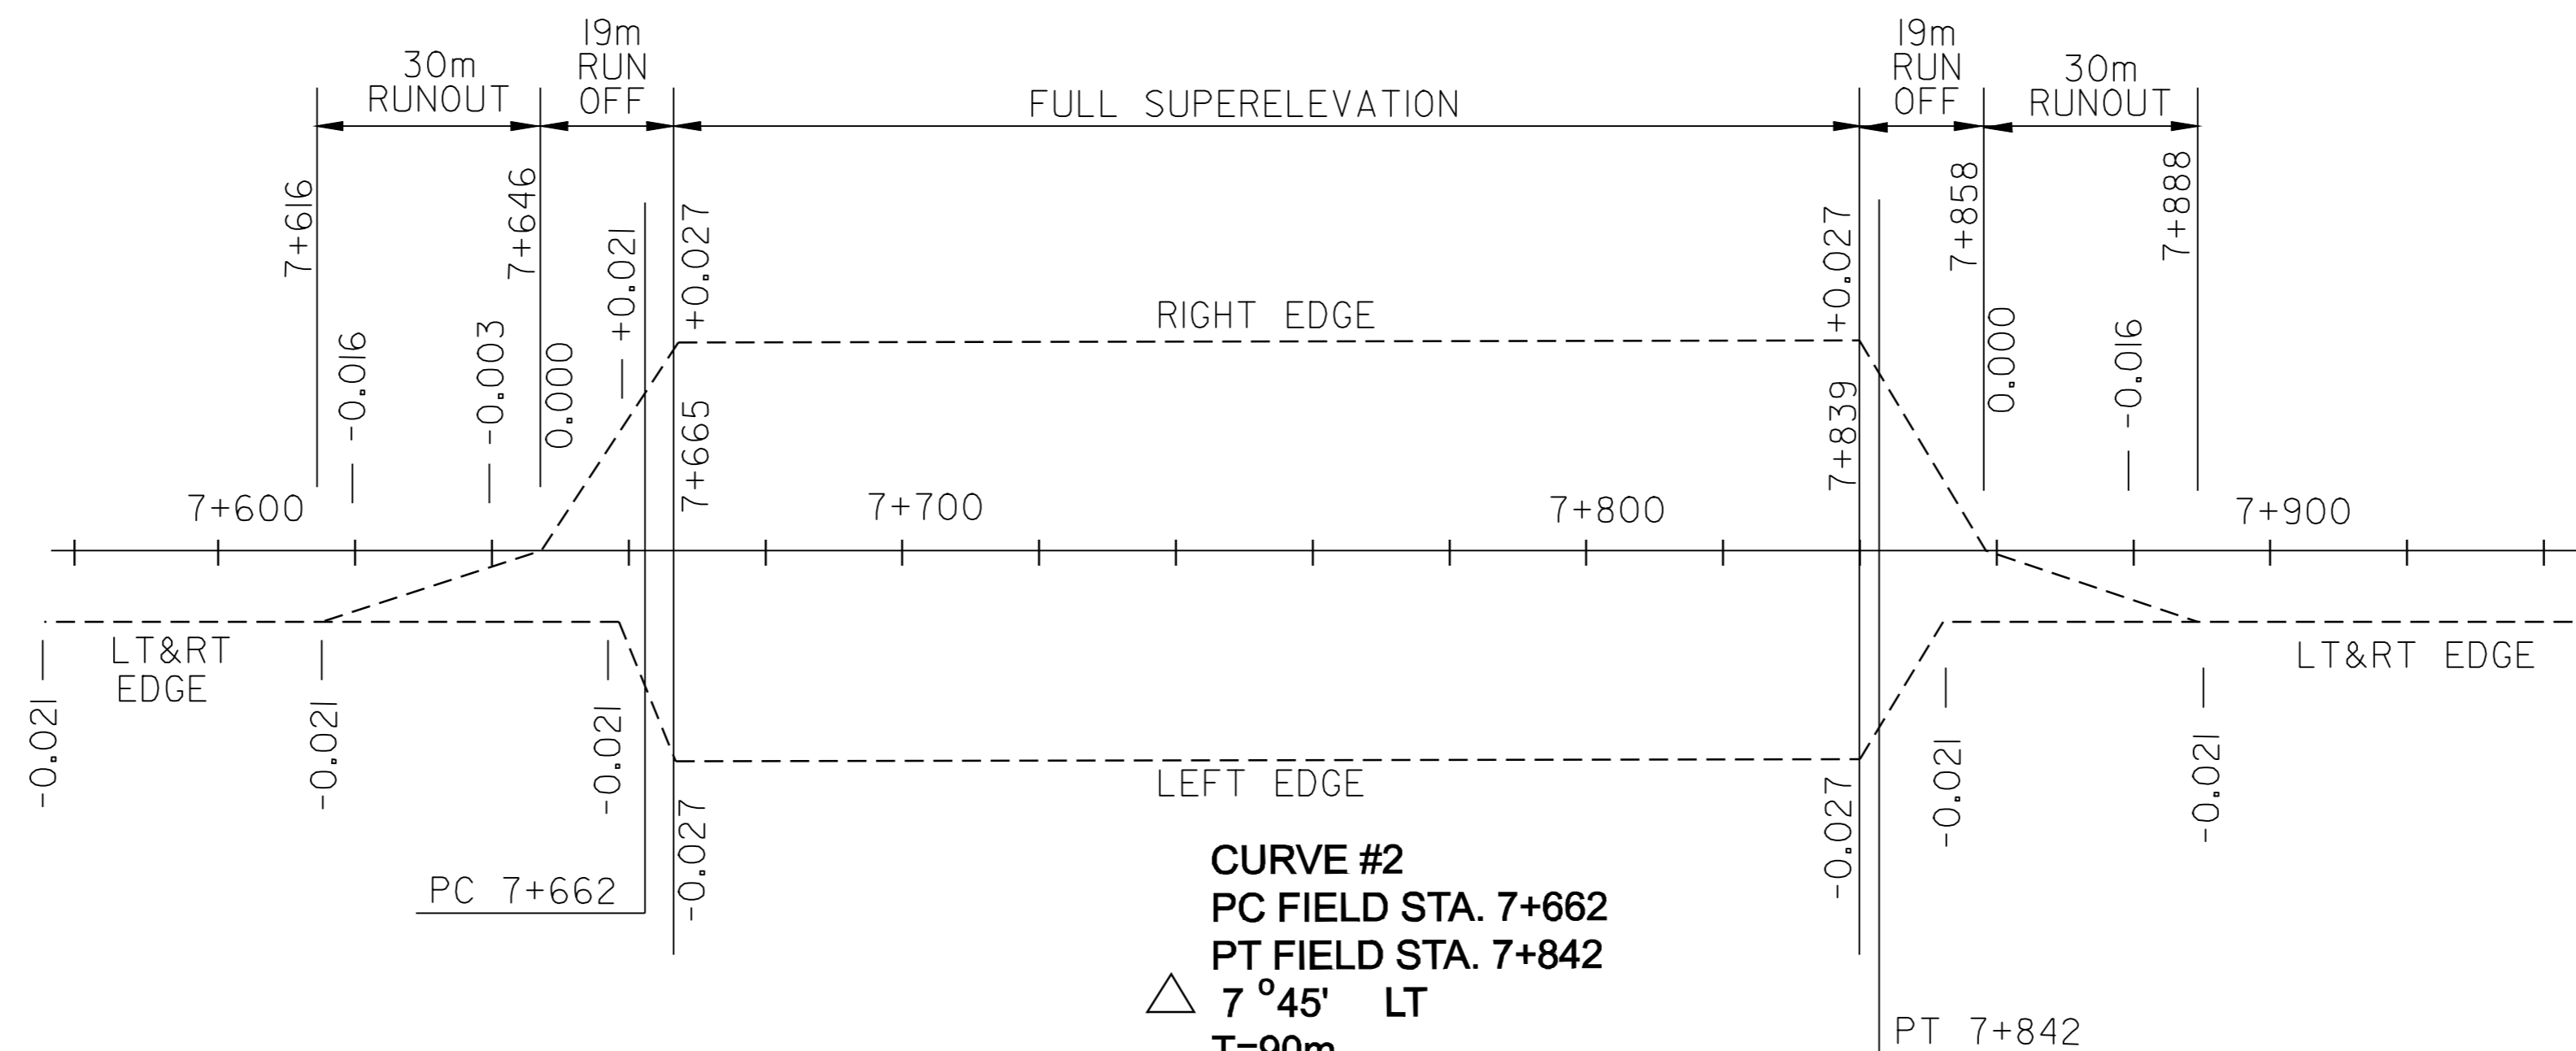

**CURVE #2**  
 PC FIELD STA. 7+662  
 PT FIELD STA. 7+842  
 △ 7°45' LT  
 T=90m  
 R=1329m  
 SUPERELEVATION=0.027  
 RUNOFF=19m  
 RUNOUT=30m  
 V=80km/hr (50 m.p.h.)

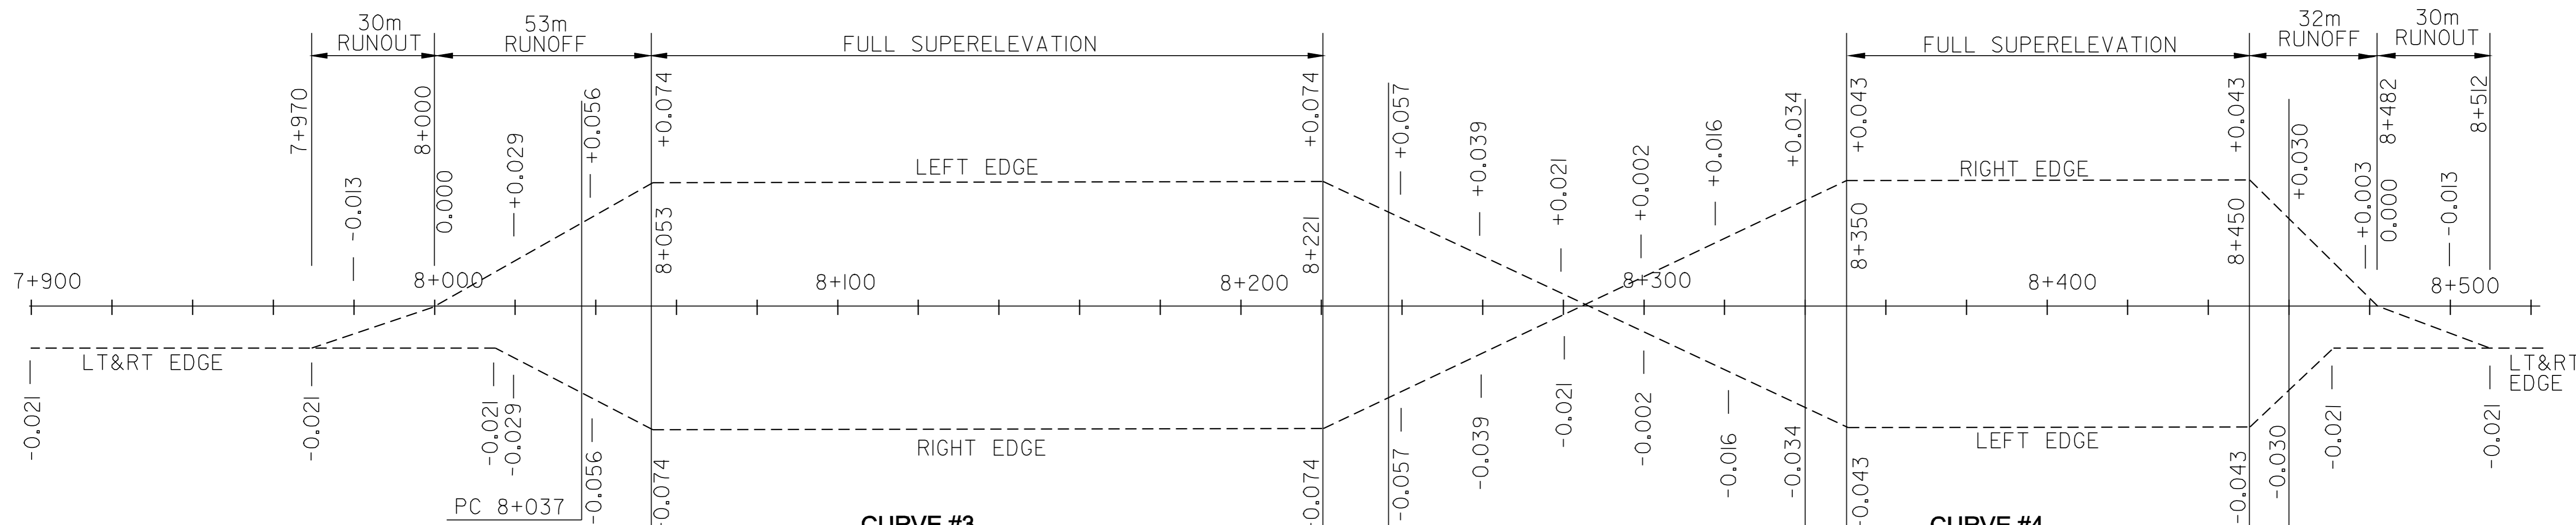

**CURVE #3**  
 PC FIELD STA. 8+037  
 PT FIELD STA. 8+237  
 △ 33°15' RT  
 T=100m  
 R=335m  
 SUPERELEVATION=0.074  
 RUNOFF=53m  
 RUNOUT=30m  
 V=80km/hr (50 m.p.h.)

**CURVE #4**  
 PC FIELD STA. 8+340  
 PT FIELD STA. 8+460  
 △ 9°00' LT  
 T=60m  
 R=762m  
 SUPERELEVATION=0.043  
 RUNOFF=32m  
 RUNOUT=30m  
 V=80km/hr (50 m.p.h.)




**NOTES:**

SUPERELEVATION DIAGRAMS ARE NOT TO SCALE.

THE CONTRACTOR IS RESPONSIBLE FOR THE ENGINEERING WORK REQUIRED TO LAYOUT AND MAINTAIN THE CROSS SLOPES IN THE REGRADING OF THE RECLAIMED AREAS.

SUPERELEVATION  
 DIAGRAM  
 SHEET #1

DESIGNED BY	LFW	DATE	1/05
DRAWN BY	LFW	DATE	1/05
DESIGN FILE NO.	_pave/00b058/00b058.dgn		
PRF FILE	00b058bd1.i	DATE PLOTTED	23-MAY-2008
PROJ. NAME	WAITSFIELD - MORETOWN		
PROJ. NO.	STP 2227(1)S		
SHEET	50	OF	54 SHEETS

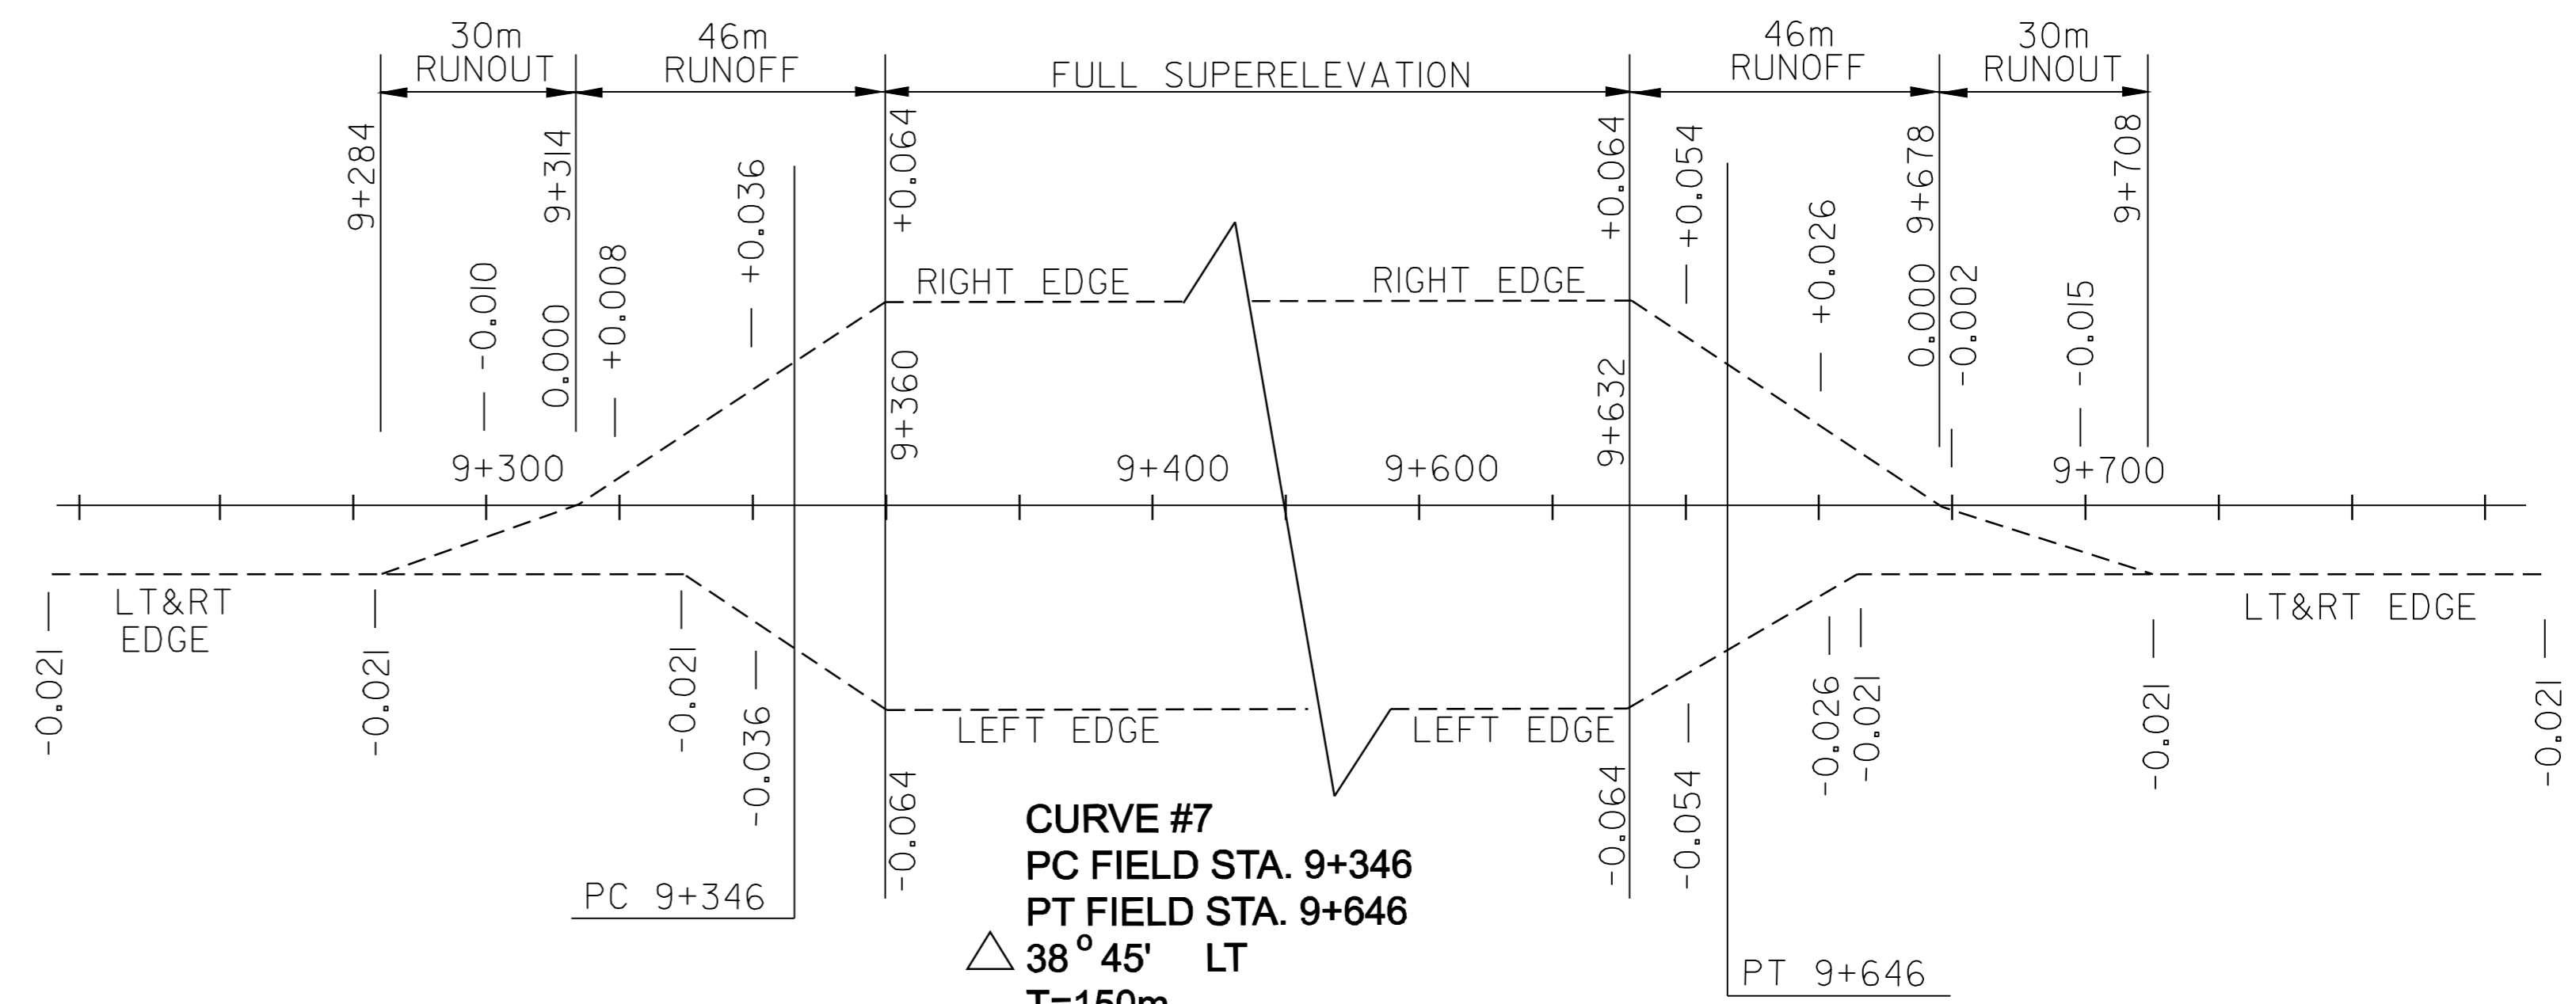
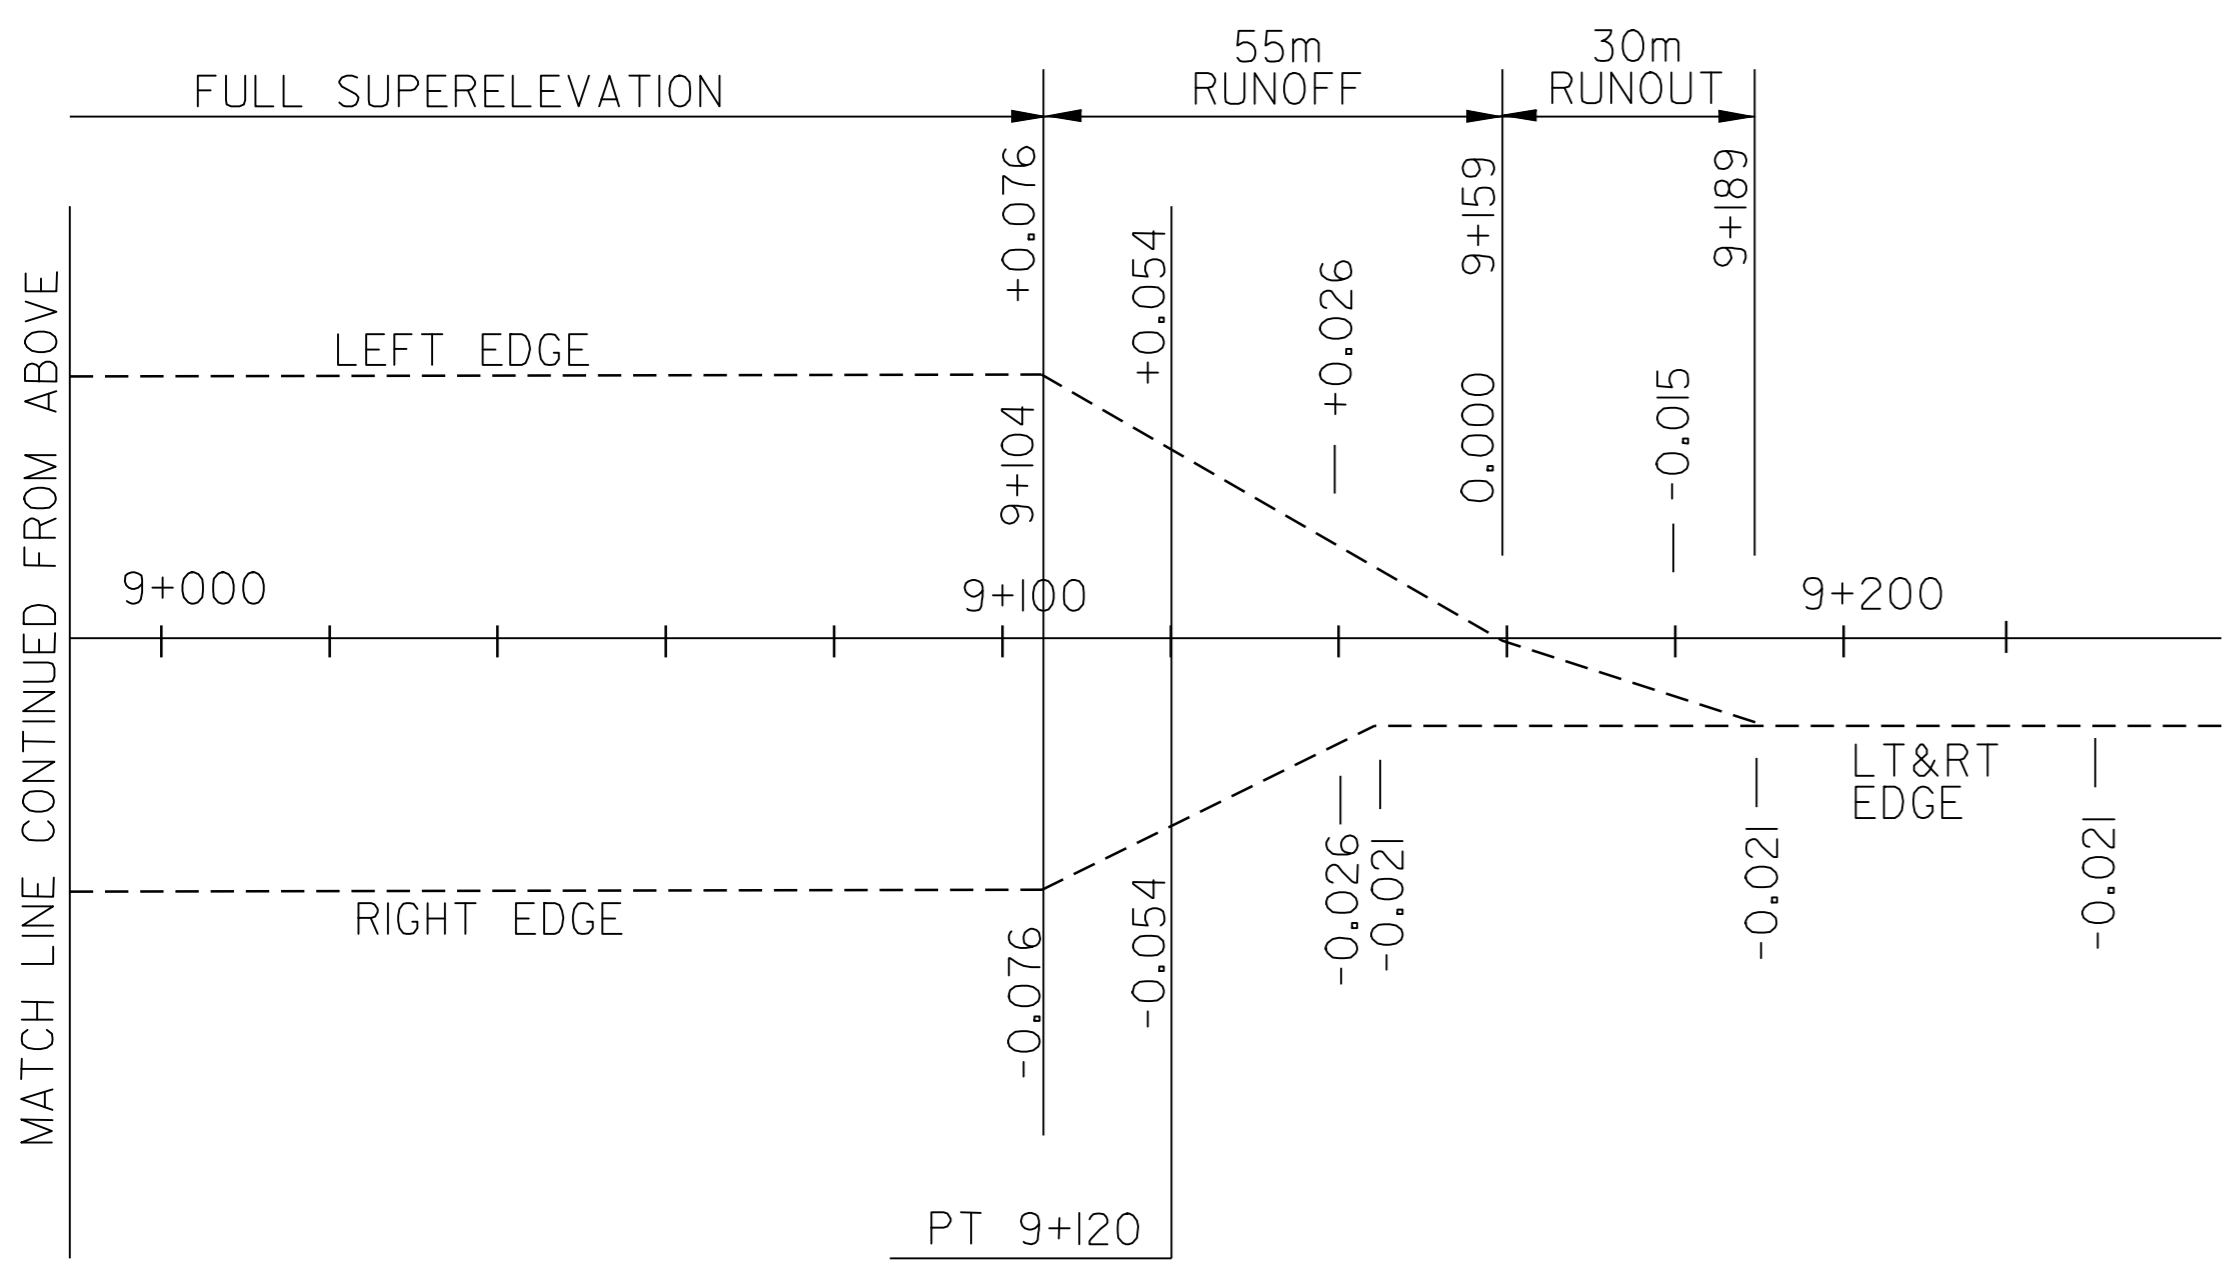
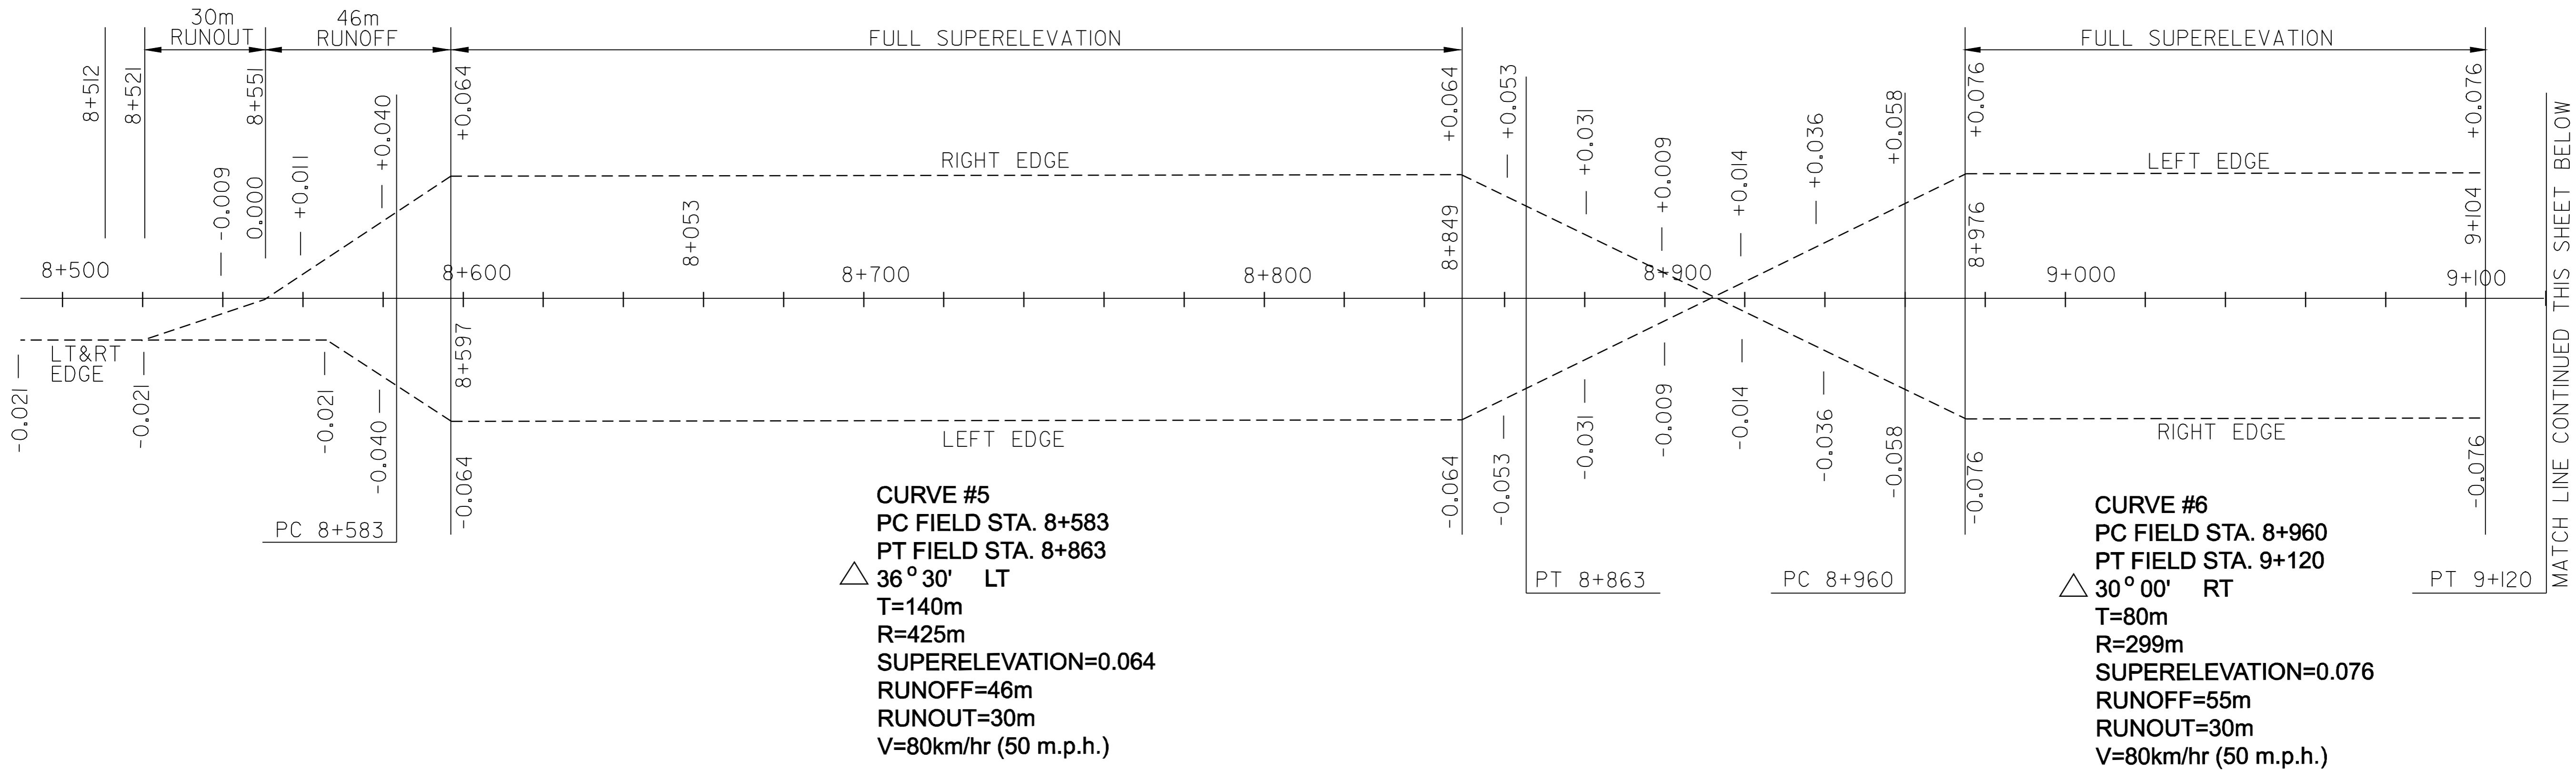


NOTES:  
 SUPERELEVATION DIAGRAMS ARE NOT TO SCALE.  
 THE CONTRACTOR IS RESPONSIBLE FOR THE ENGINEERING WORK  
 REQUIRED TO LAYOUT AND MAINTAIN THE CROSS SLOPES IN THE  
 REGRADING OF THE RECLAIMED AREAS.

SUPERELEVATION  
 DIAGRAM  
 SHEET #2

DESIGNED BY	LFW	DATE	1/05
DRAWN BY	LFW	DATE	1/05
DESIGN FILE NO.	_pave/00b058/00b058.dgn		
PRF FILE	00b058bd2.i	DATE PLOTTED	23-MAY-2008
PROJ. NAME	WAITSFIELD - MORETOWN		
PROJ. NO.	STP 2227(1)S		
SHEET	51	OF	54 SHEETS

MATCH LINE CONTINUED THIS SHEET BELOW

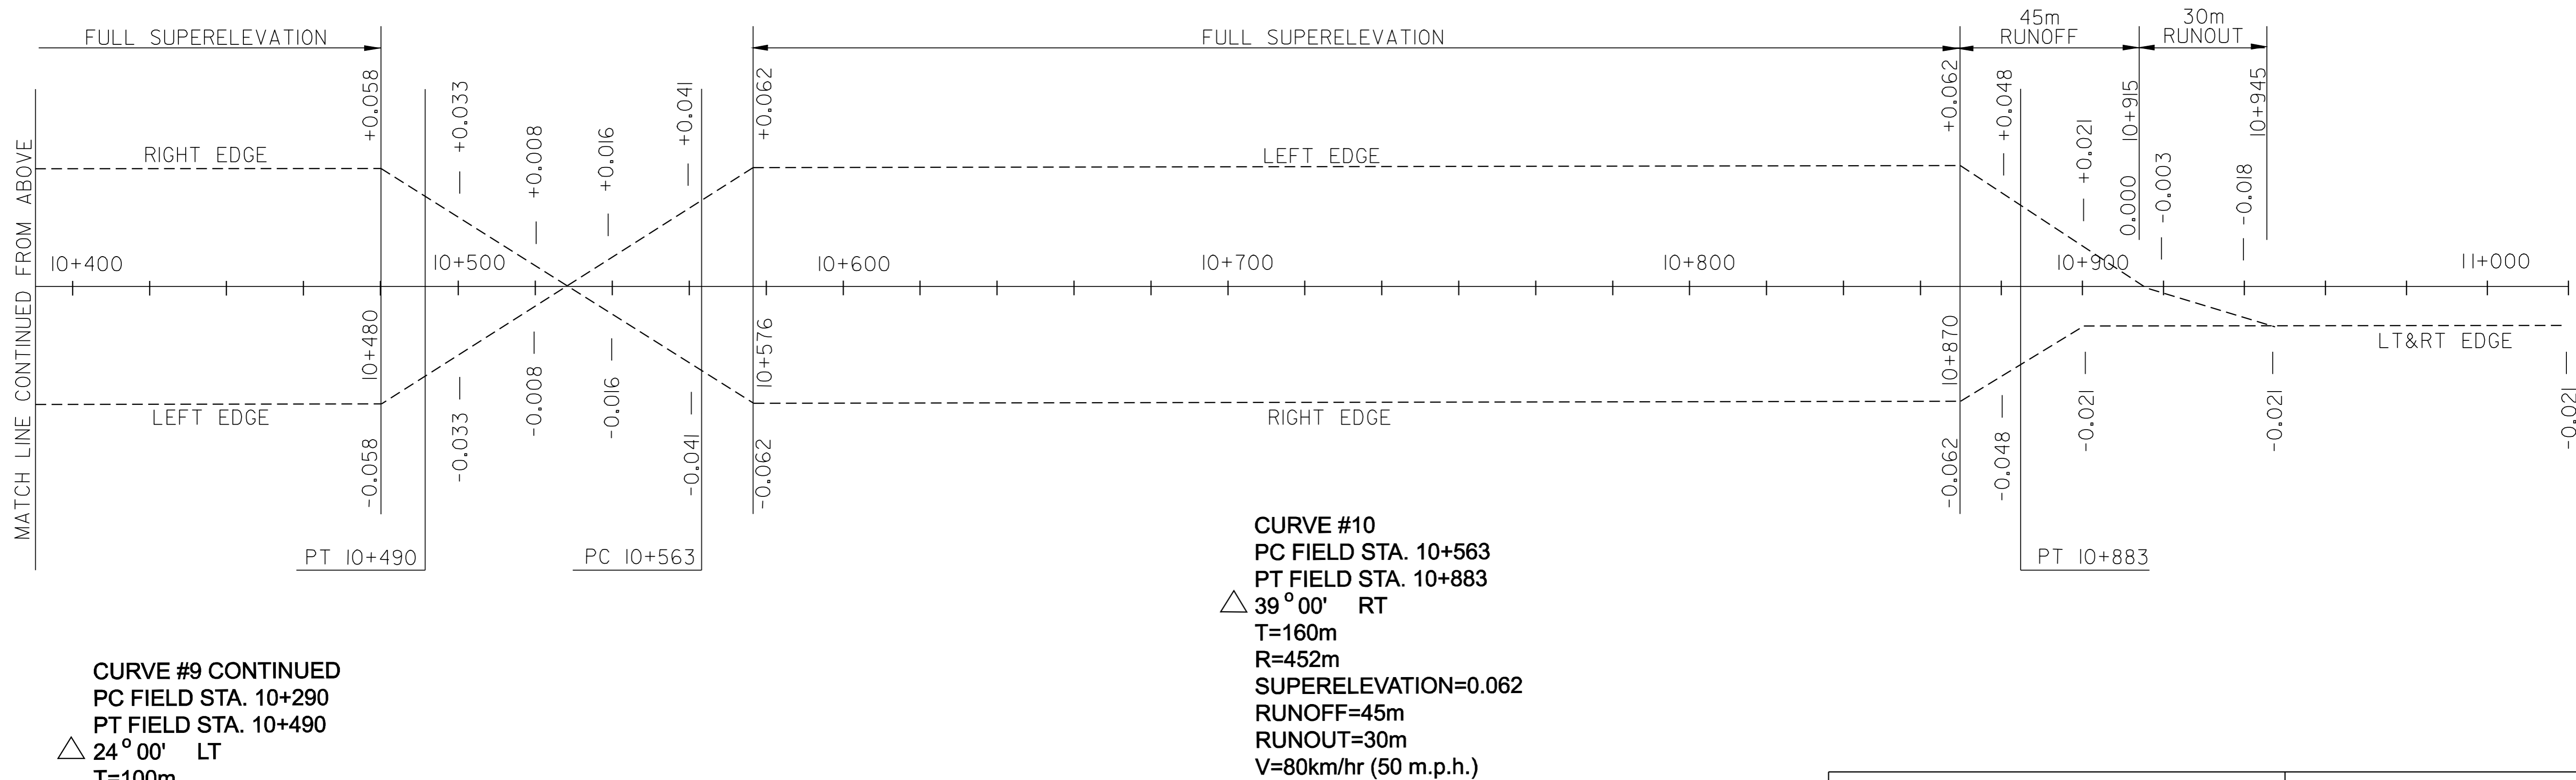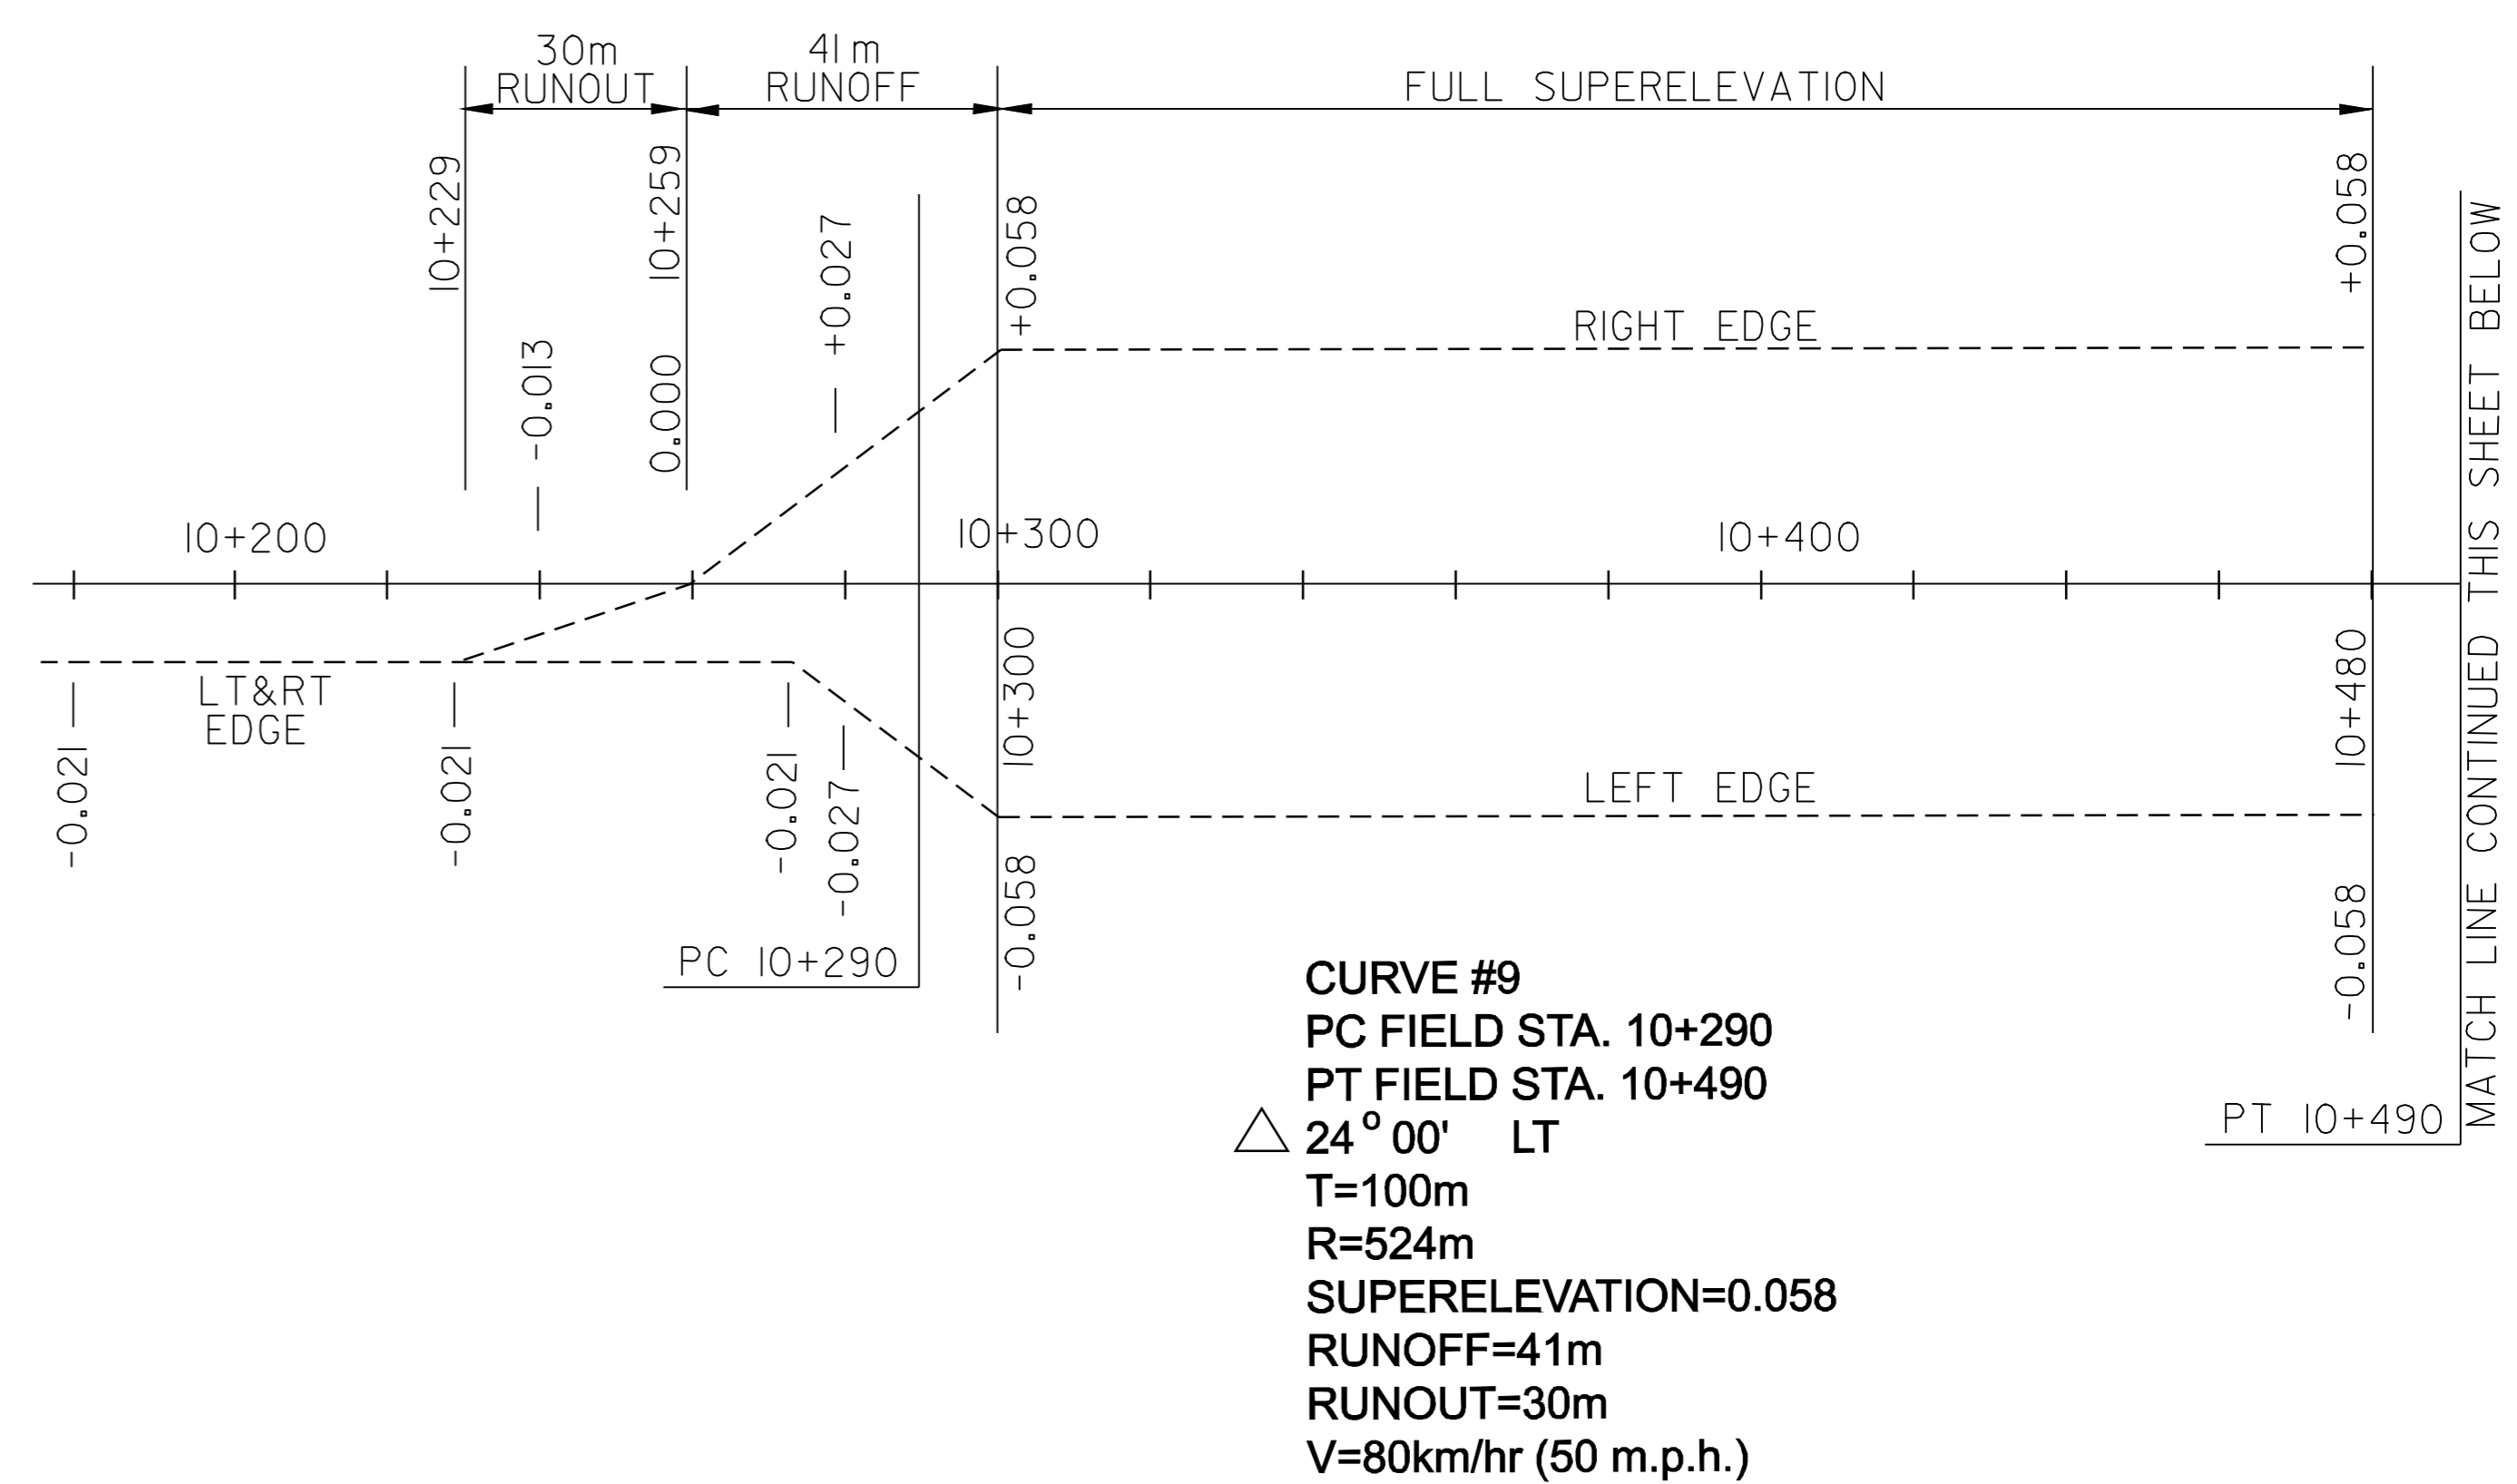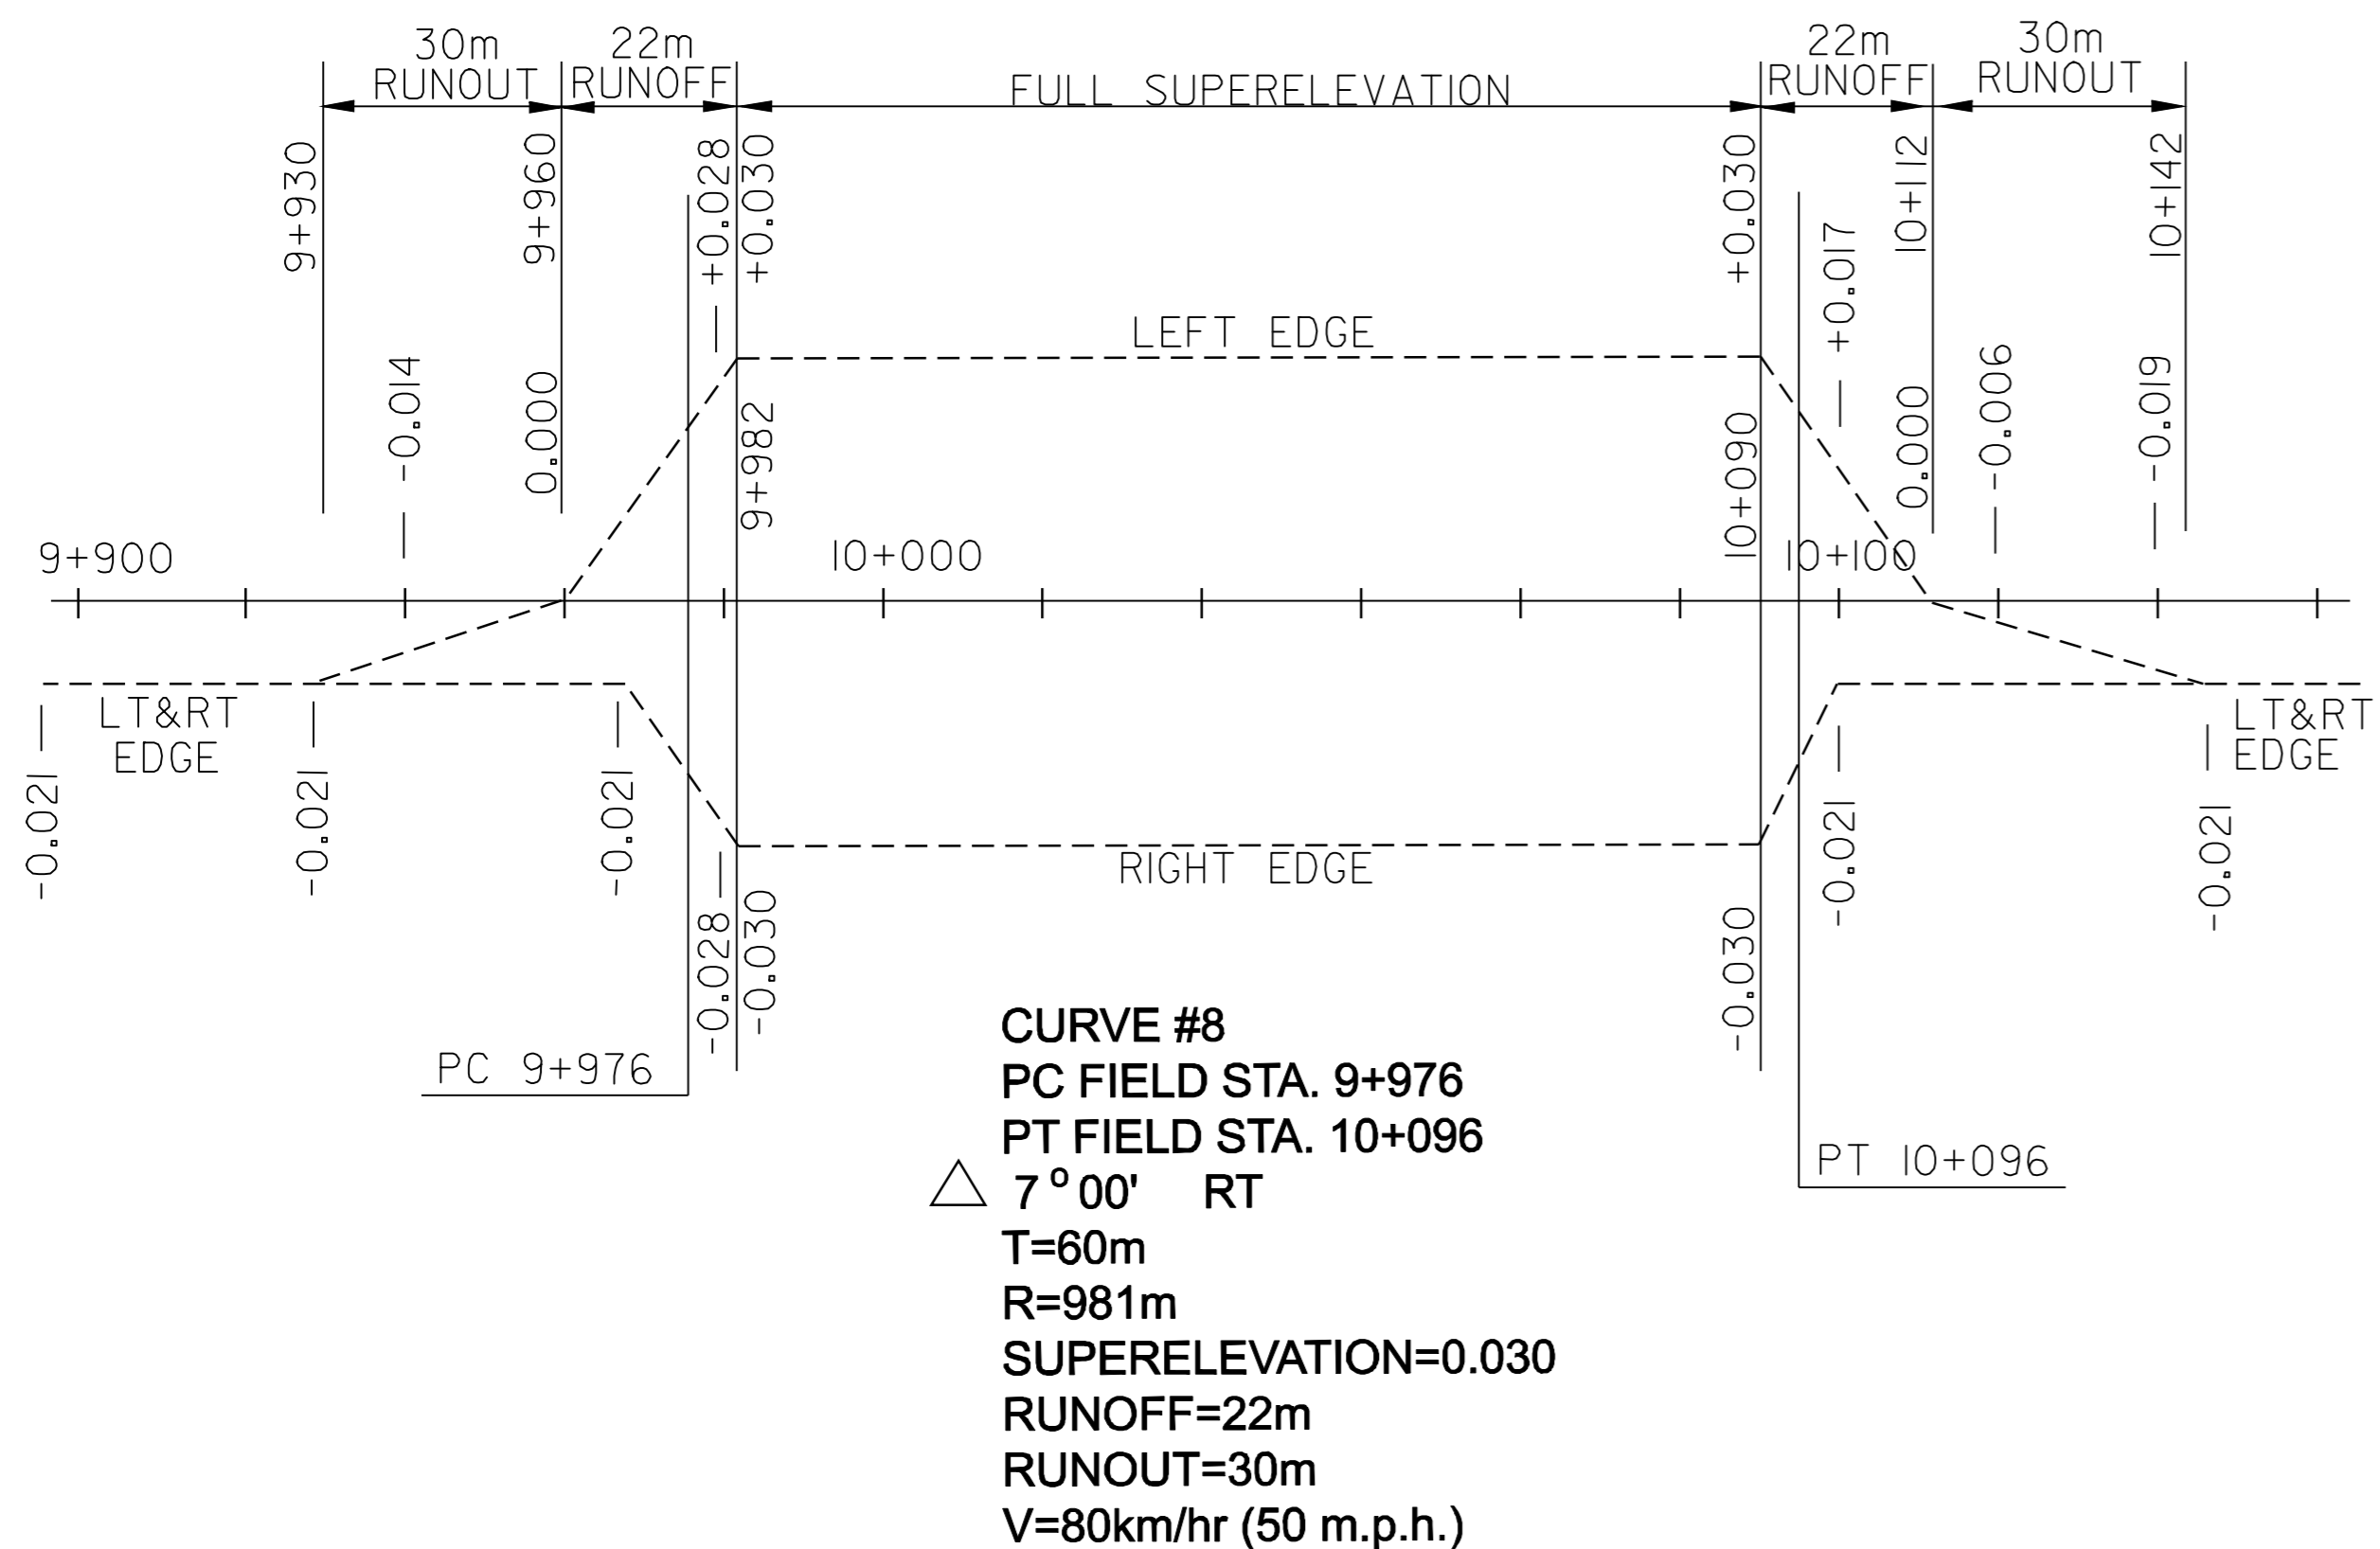

**CURVE #9 CONTINUED**  
 PC FIELD STA. 10+290  
 PT FIELD STA. 10+490  
 △ 24°00' LT  
 T=100m  
 R=524m  
 SUPERELEVATION=0.058  
 RUNOFF=41m  
 RUNOUT=30m  
 V=80km/hr (50 m.p.h.)

**NOTES:**


SUPERELEVATION DIAGRAMS ARE NOT TO SCALE.

THE CONTRACTOR IS RESPONSIBLE FOR THE ENGINEERING WORK REQUIRED TO LAYOUT AND MAINTAIN THE CROSS SLOPES IN THE REGRADING OF THE RECLAIMED AREAS.


SUPERELEVATION  
 DIAGRAM  
 SHEET # 3

DESIGNED BY	LFW	DATE	1/05
DRAWN BY	LFW	DATE	1/05
DESIGN FILE NO.	_pave/00b058/00b058.dgn		
PRF FILE	00b058bd3.i	DATE PLOTTED	23-MAY-2008
PROJ. NAME	WAITSFIELD - MORETOWN		
PROJ. NO.	STP 2227(1)S		
SHEET	52	OF	54 SHEETS


MATCH LINE CONTINUED THIS SHEET BELOW

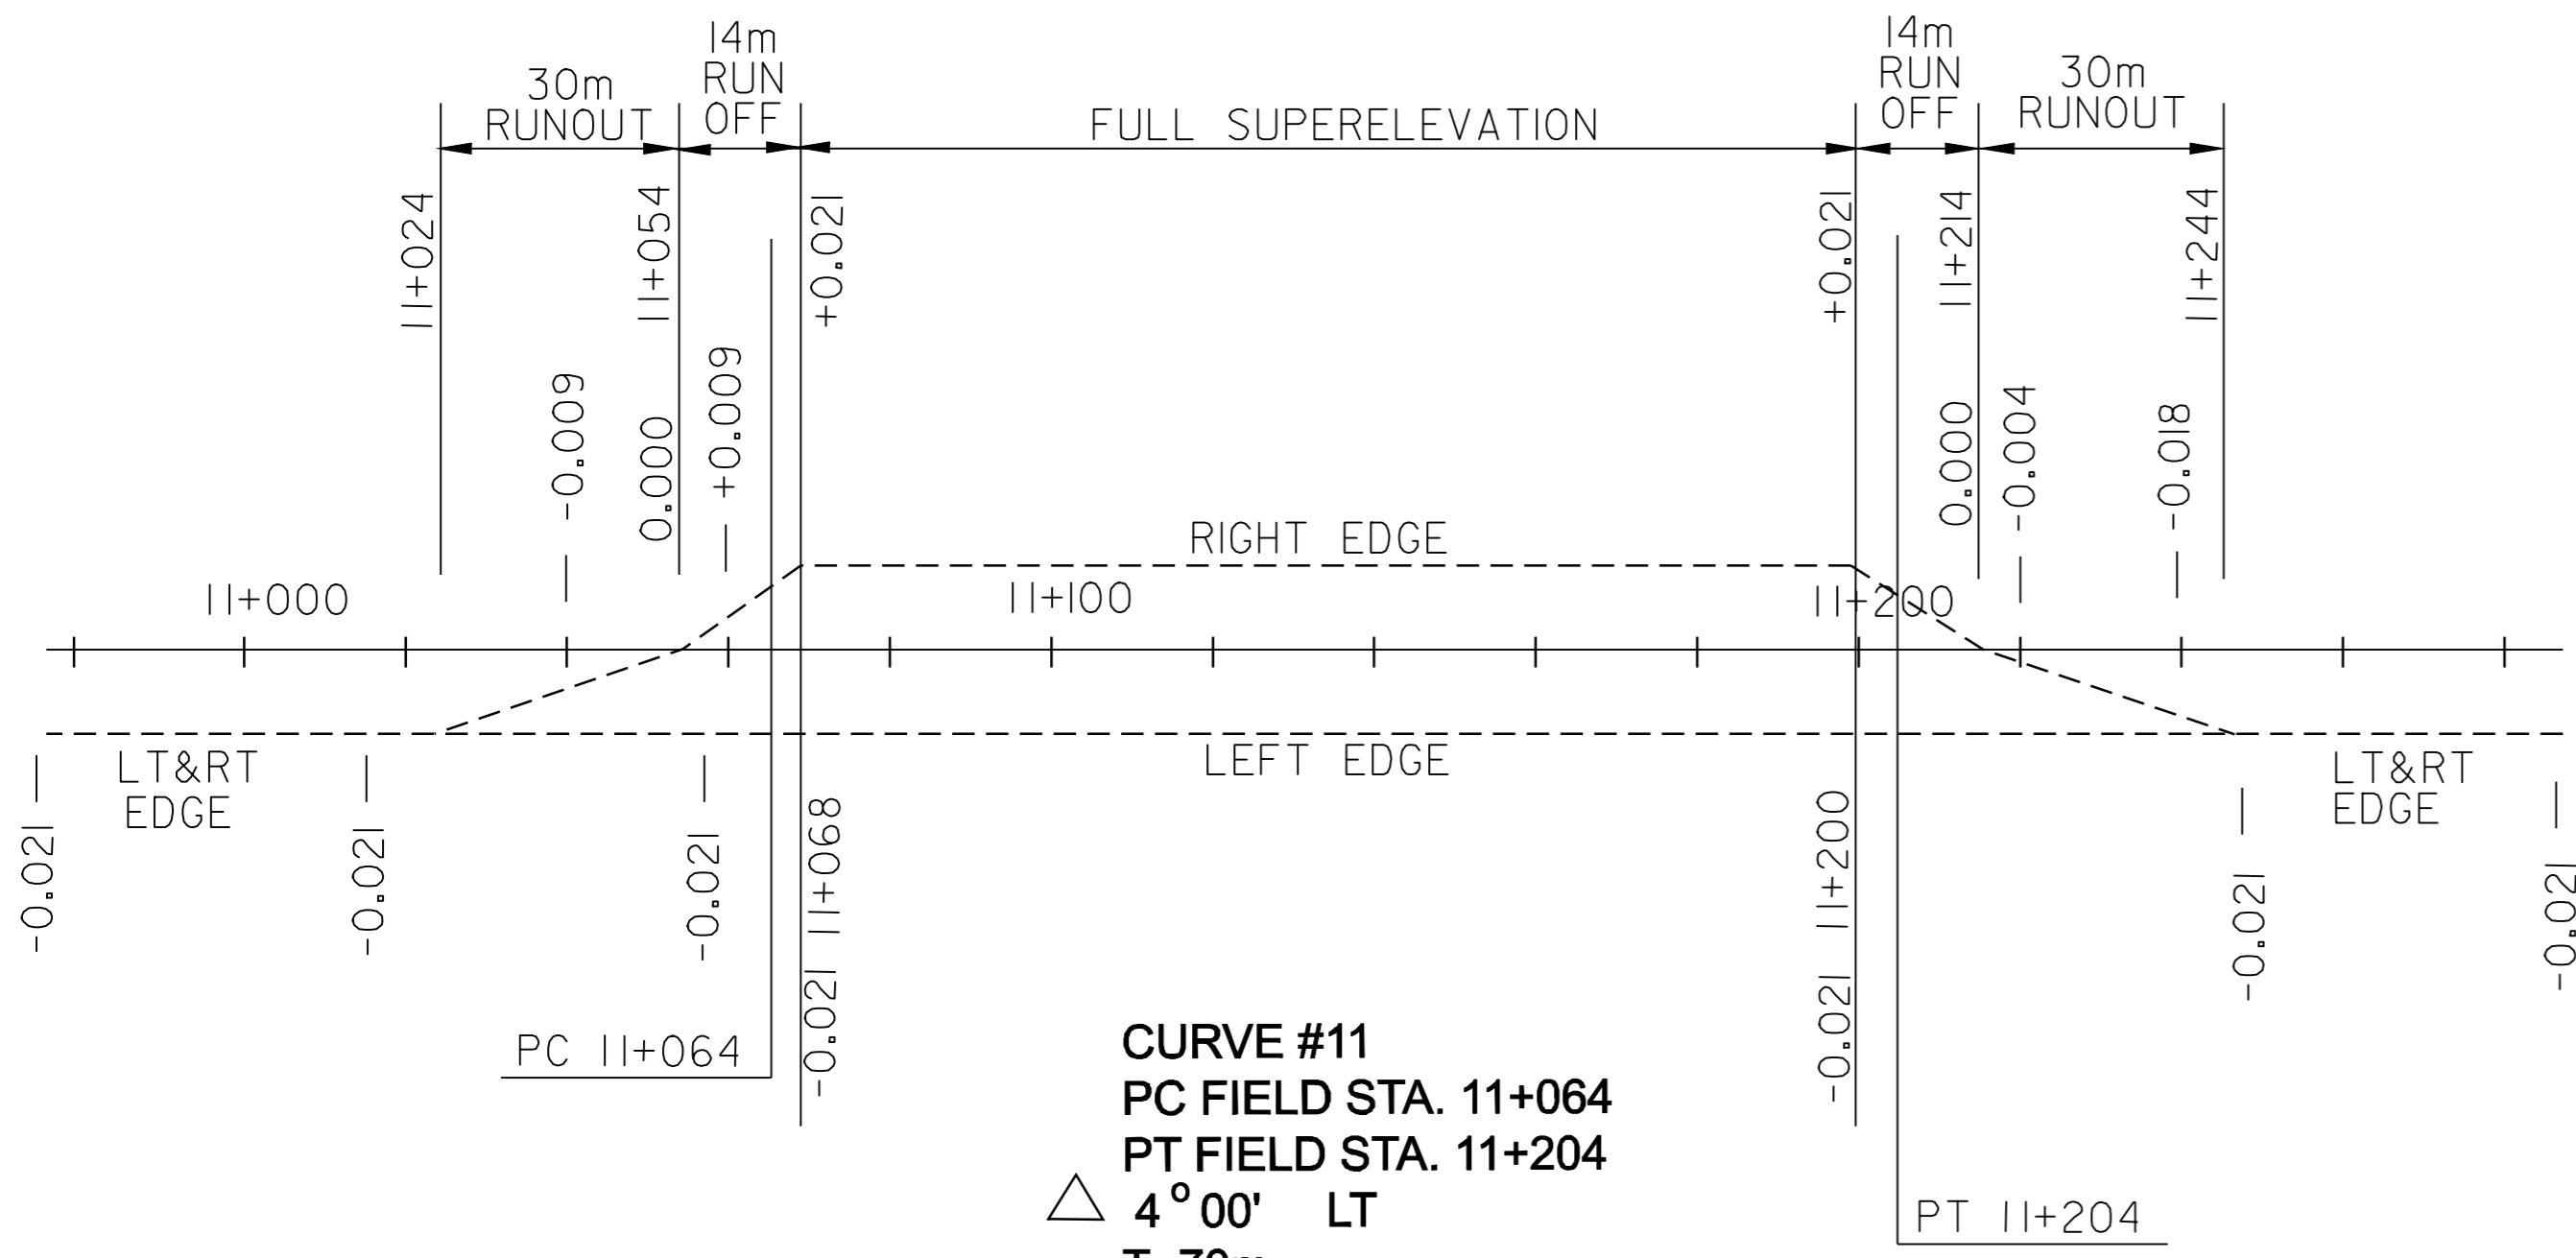

**CURVE #11**  
 PC FIELD STA. 11+064  
 PT FIELD STA. 11+204  
 4°00' LT  
 T=70m  
 R=2005m  
 SUPERELEVATION=0.021  
 RUNOFF=14m  
 RUNOUT=30m  
 V=80km/hr (50 m.p.h.)

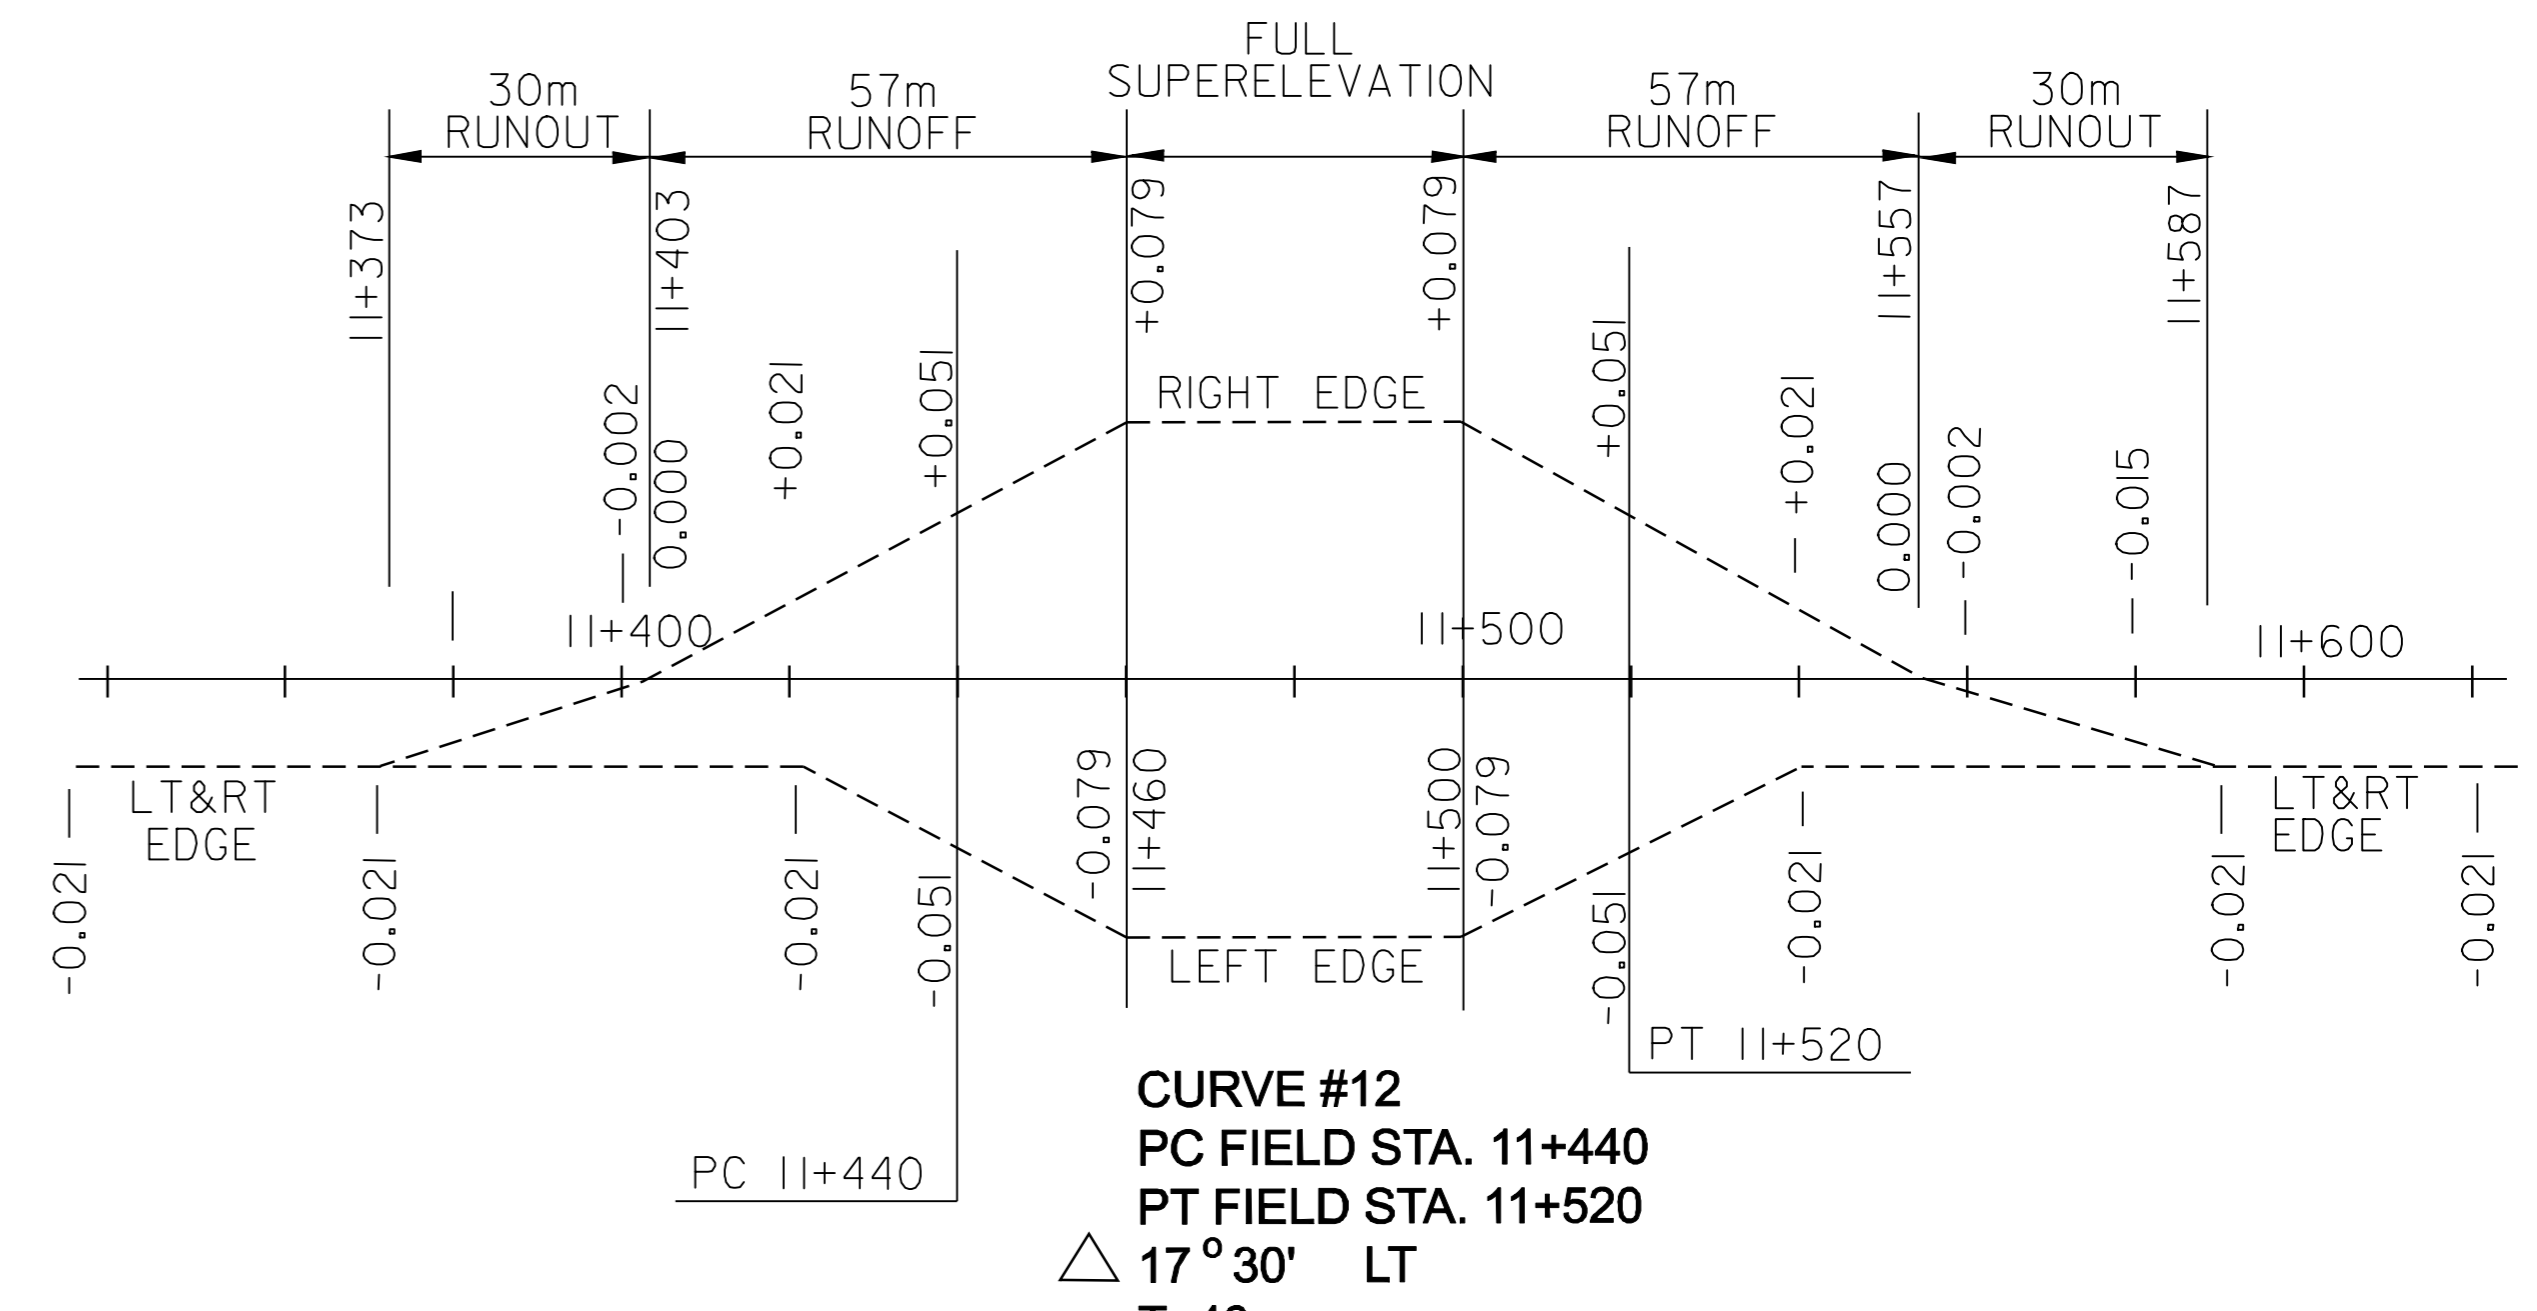


**CURVE #12**  
 PC FIELD STA. 11+440  
 PT FIELD STA. 11+520  
 17°30' LT  
 T=40m  
 R=260m  
 SUPERELEVATION=0.079  
 RUNOFF=57m  
 RUNOUT=30m  
 V=80km/hr (50 m.p.h.)

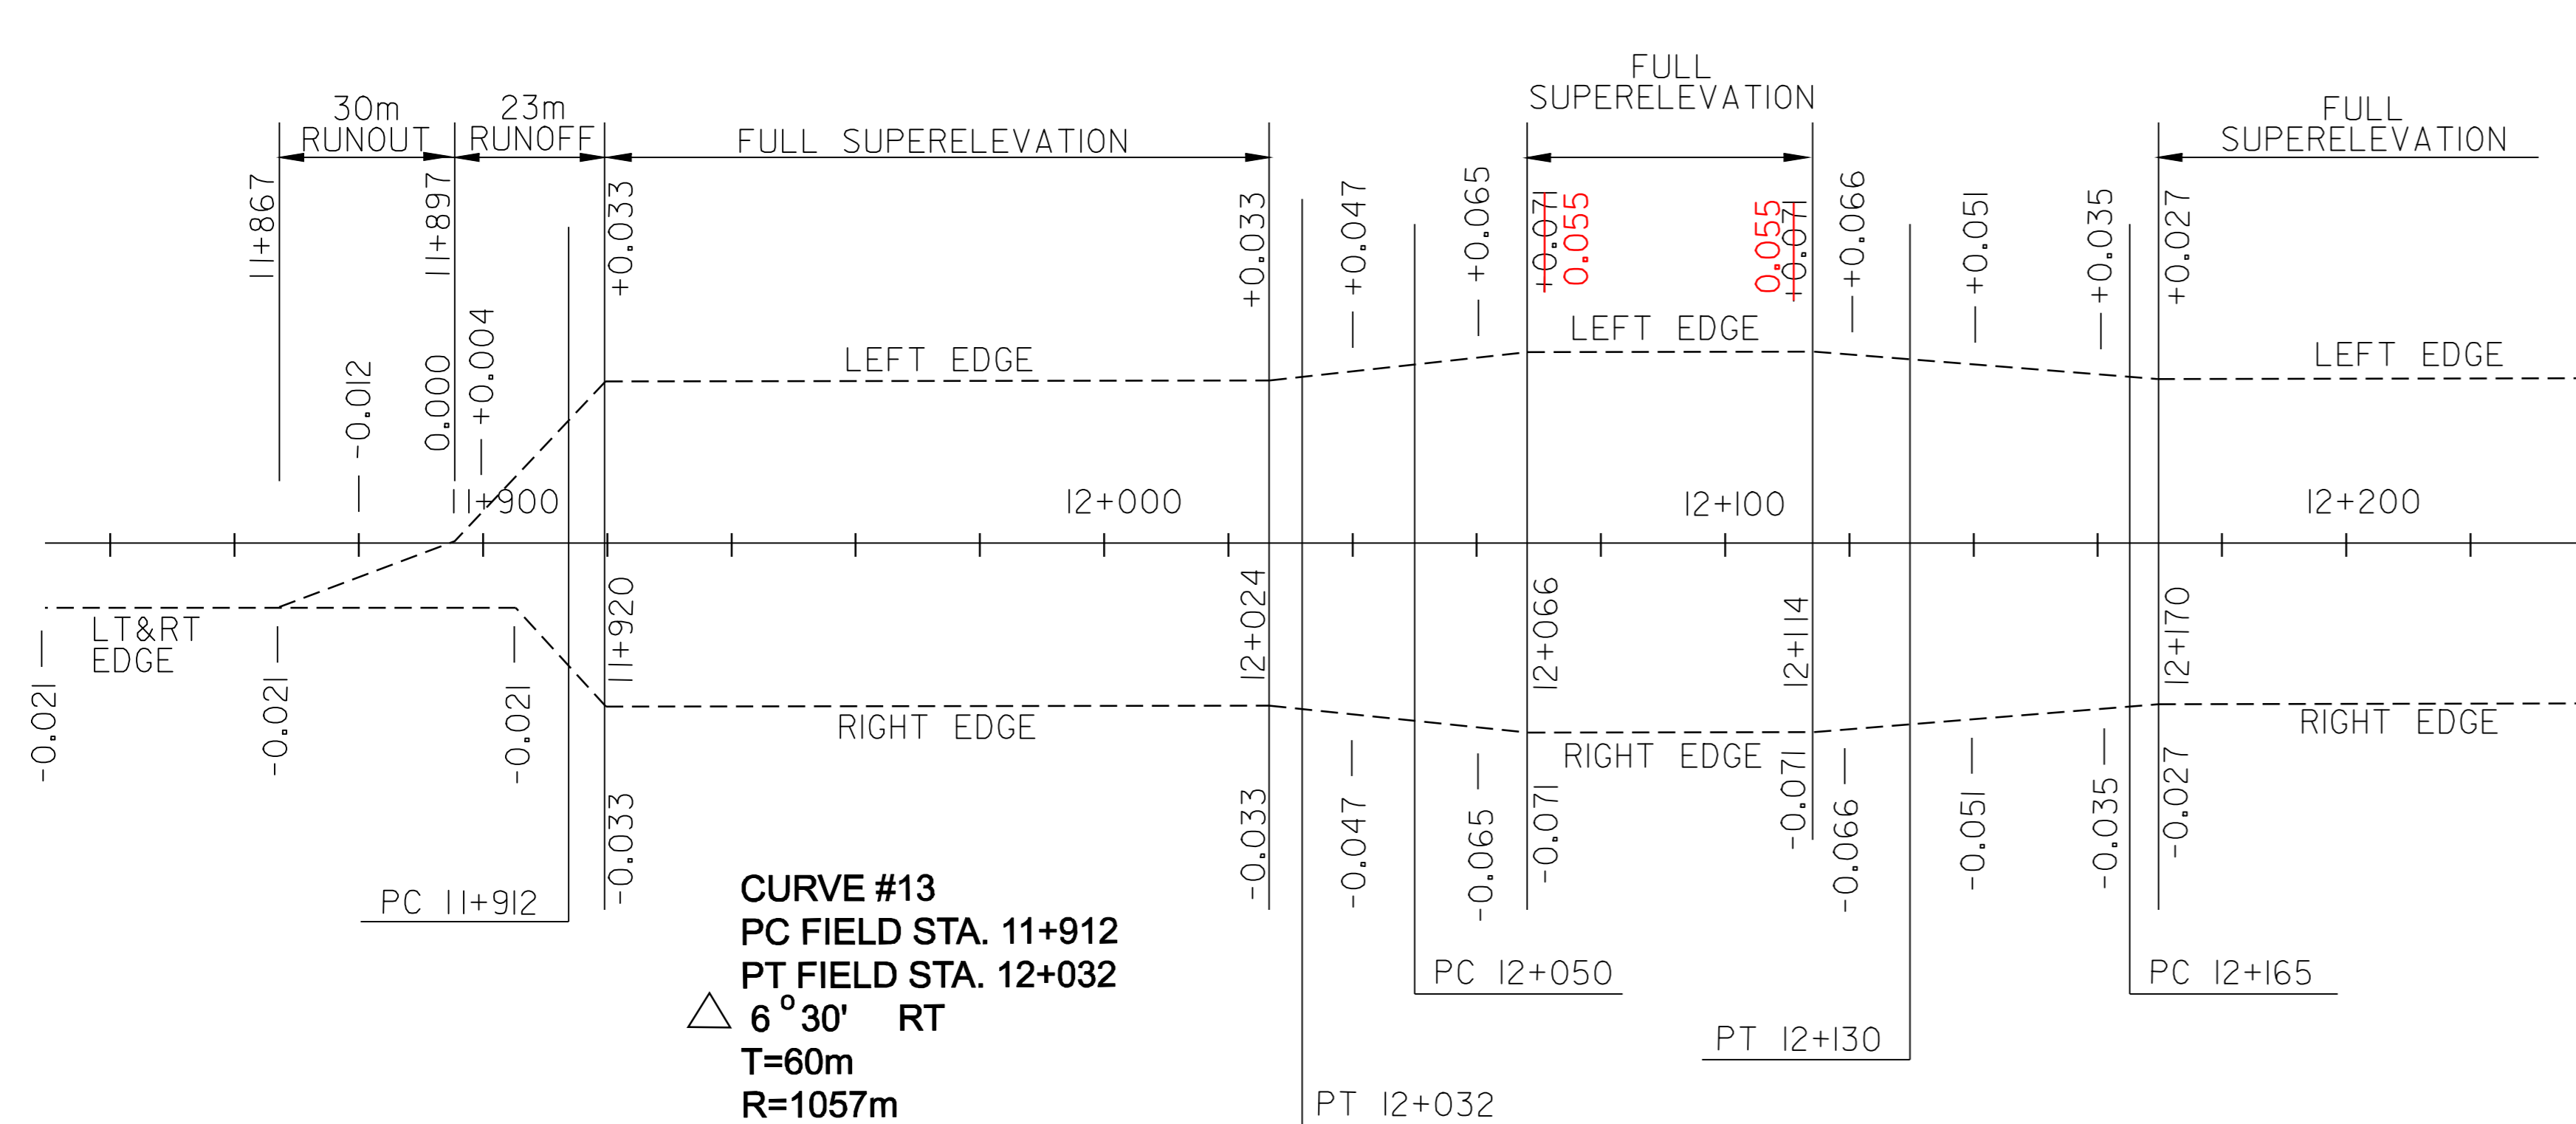

**CURVE #13**  
 PC FIELD STA. 11+912  
 PT FIELD STA. 12+032  
 6°30' RT  
 T=60m  
 R=1057m  
 SUPERELEVATION=0.033  
 RUNOFF=23m  
 RUNOUT=30m  
 V=80km/hr (50 m.p.h.)

**CURVE #14**  
 PC FIELD STA. 12+050  
 PT FIELD STA. 12+130  
 13°00' RT  
 T=40m  
 R=351m  
 SUPERELEVATION=0.071  
 RUNOFF=52m  
 RUNOUT=30m  
 V=80km/hr (50 m.p.h.)

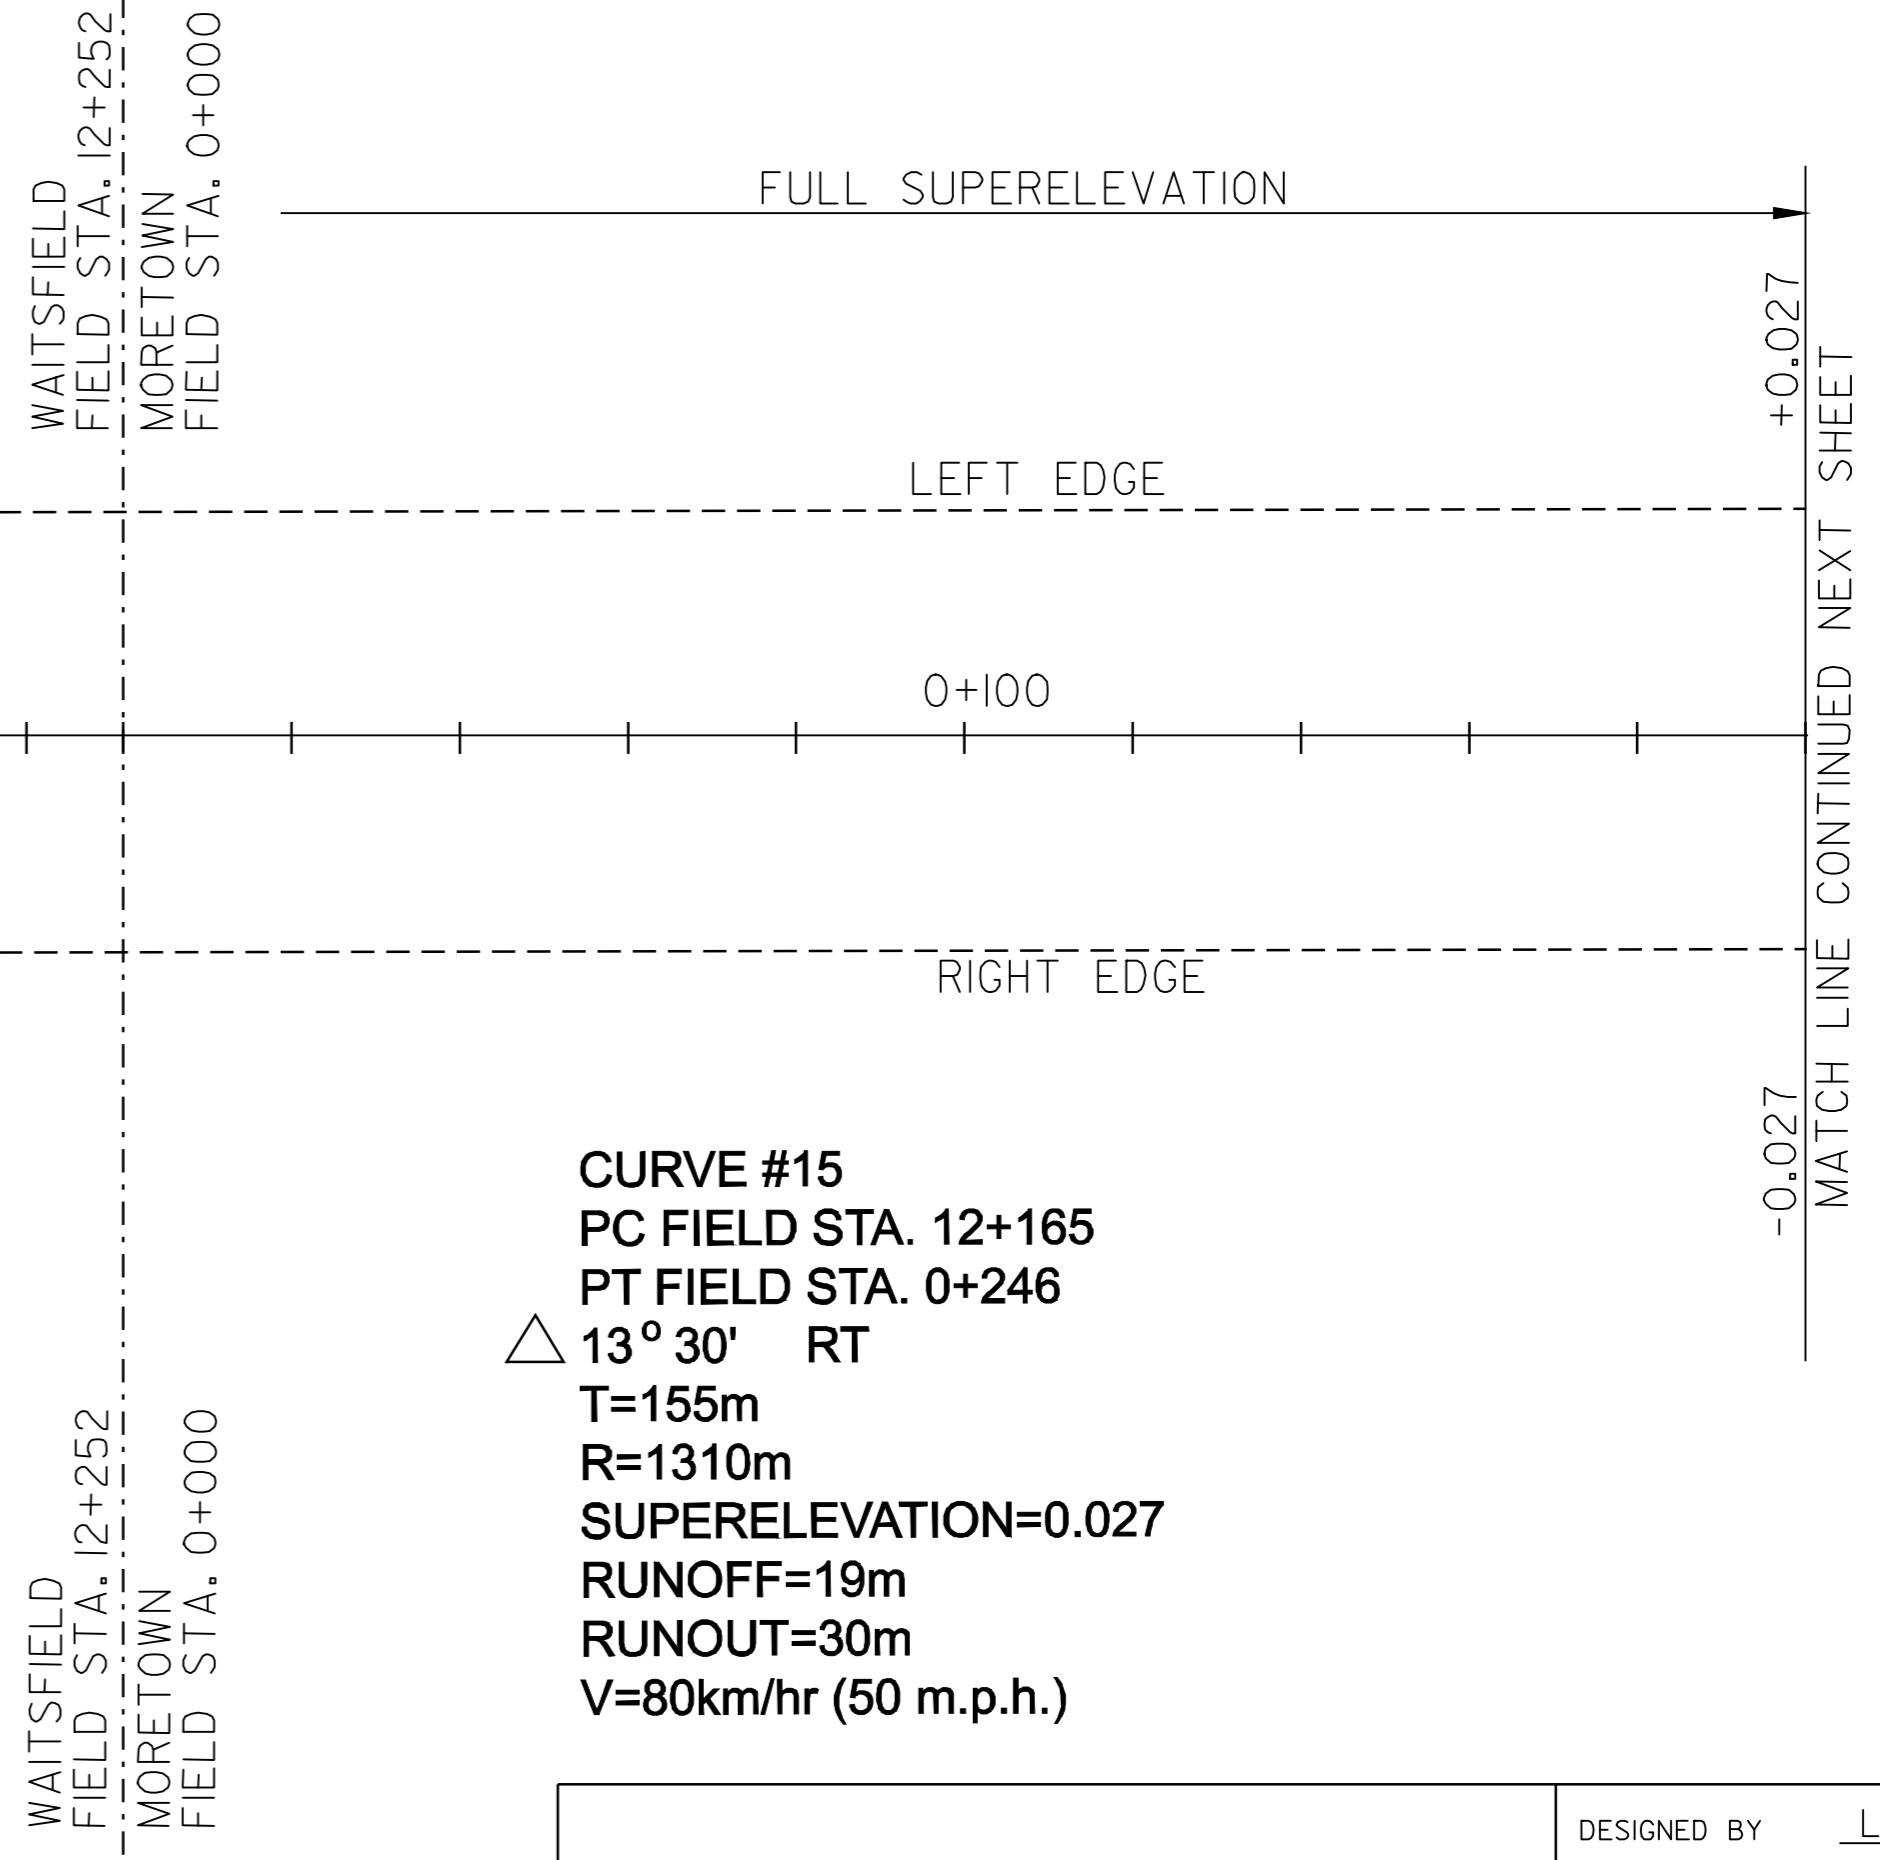



**CURVE #15**  
 PC FIELD STA. 12+165  
 PT FIELD STA. 0+246  
 13°30' RT  
 T=155m  
 R=1310m  
 SUPERELEVATION=0.027  
 RUNOFF=19m  
 RUNOUT=30m  
 V=80km/hr (50 m.p.h.)

NOTES:  
 SUPERELEVATION DIAGRAMS ARE NOT TO SCALE.  
 THE CONTRACTOR IS RESPONSIBLE FOR THE ENGINEERING WORK REQUIRED TO LAYOUT AND MAINTAIN THE CROSS SLOPES IN THE REGRADING OF THE RECLAIMED AREAS.

SUPERELEVATION  
 DIAGRAM  
 SHEET # 4

DESIGNED BY	LFW	DATE	1/05
DRAWN BY	LFW	DATE	1/05
DESIGN FILE NO.	_pave/00b058/00b058.dgn		
PRF FILE	00b058bd4.i	DATE PLOTTED	23-MAY-2008
PROJ. NAME	WAITSFIELD - MORETOWN		
PROJ. NO.	STP 2227(1)S		
SHEET	53	OF	54 SHEETS

MATCH LINE CONTINUED NEXT SHEET

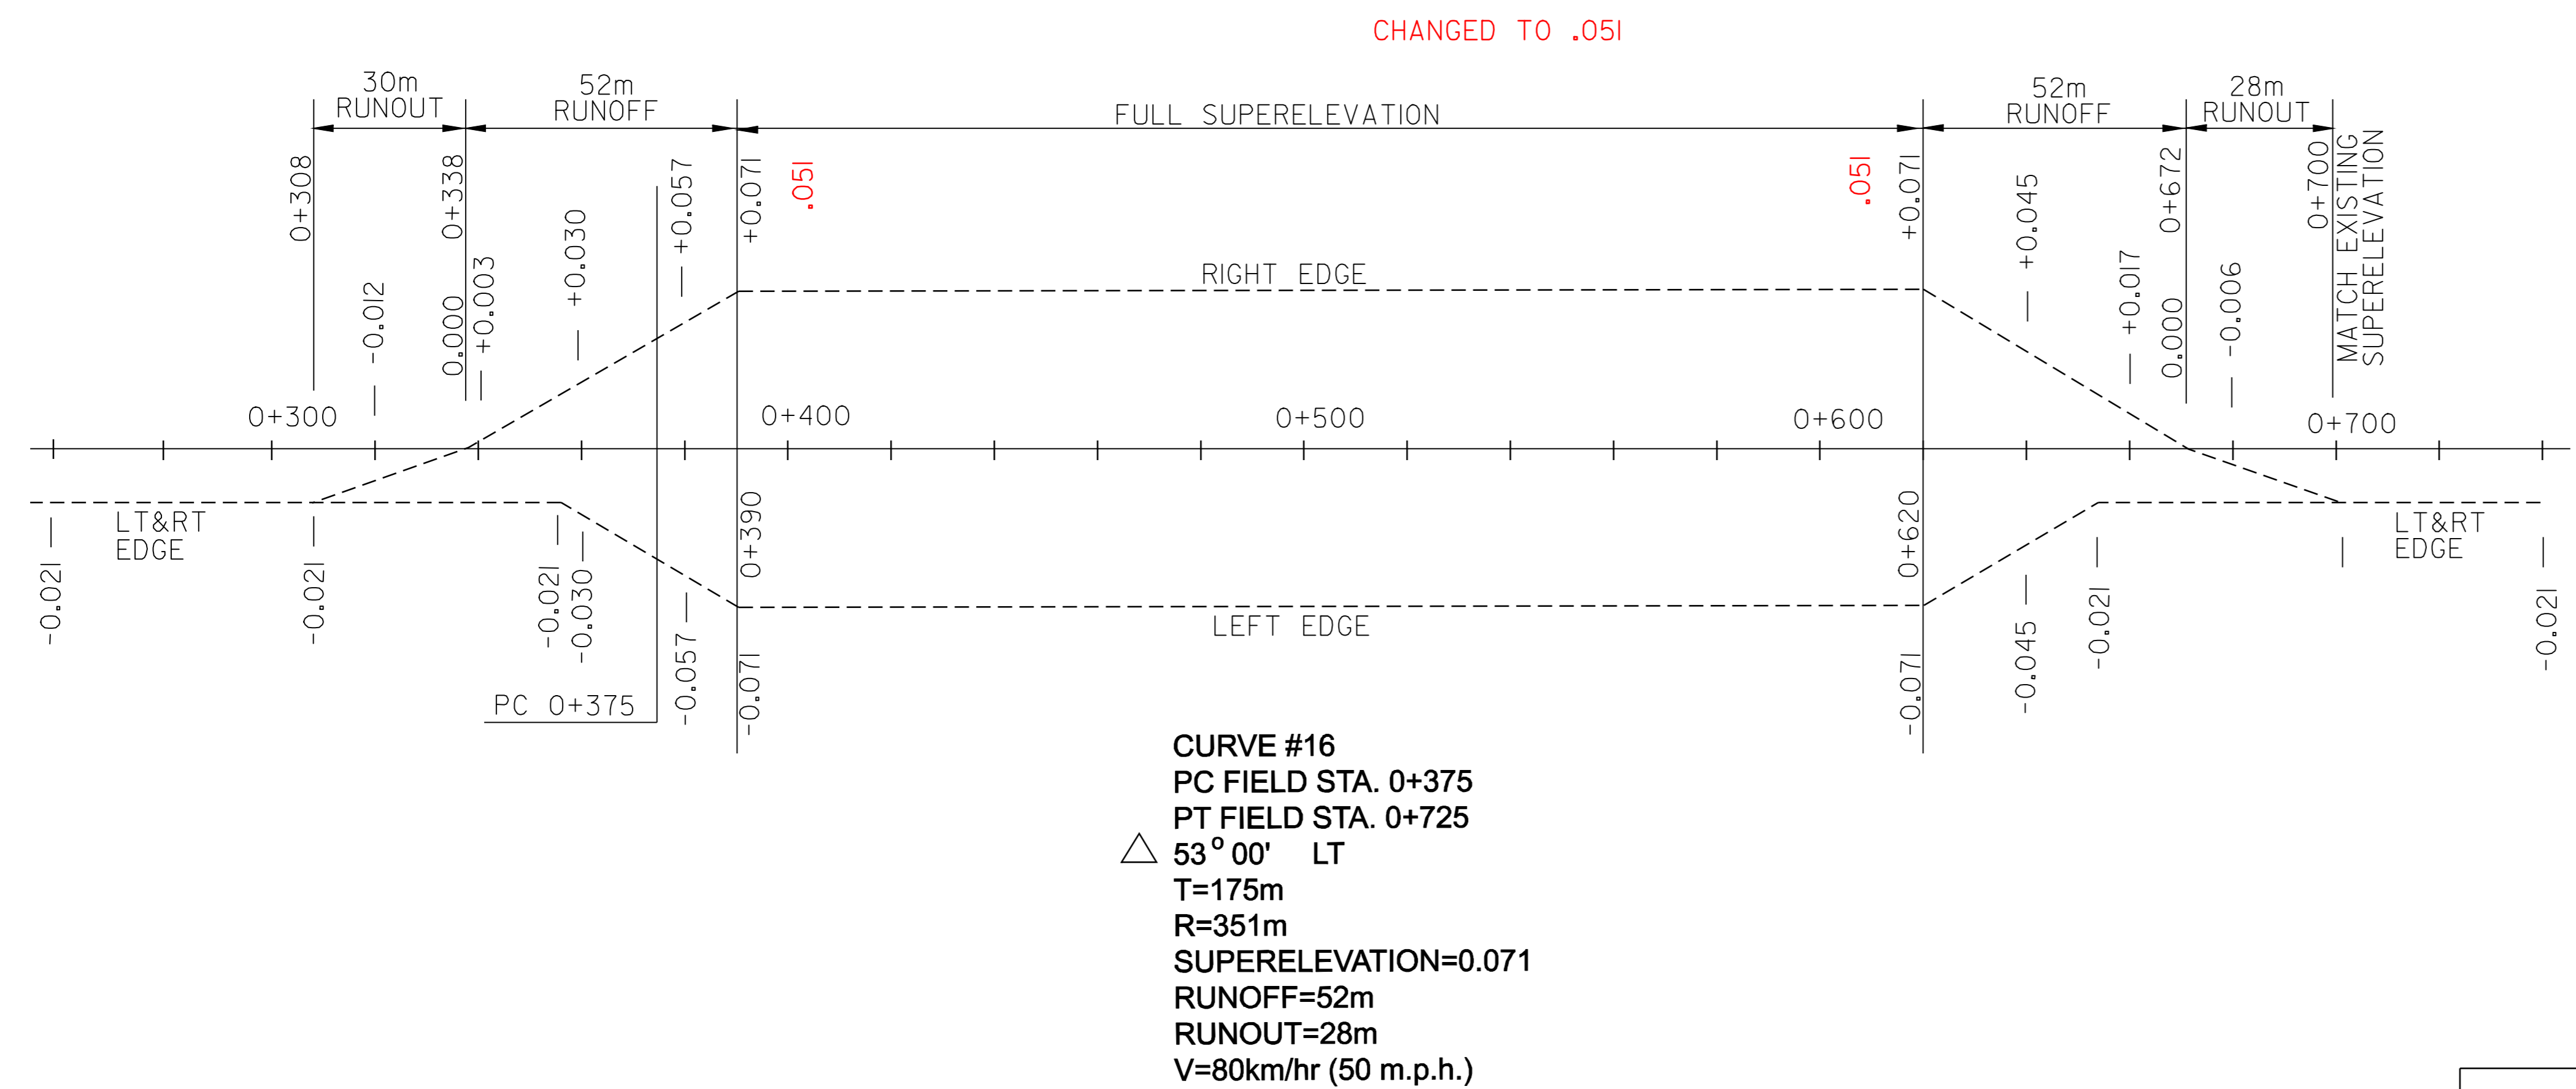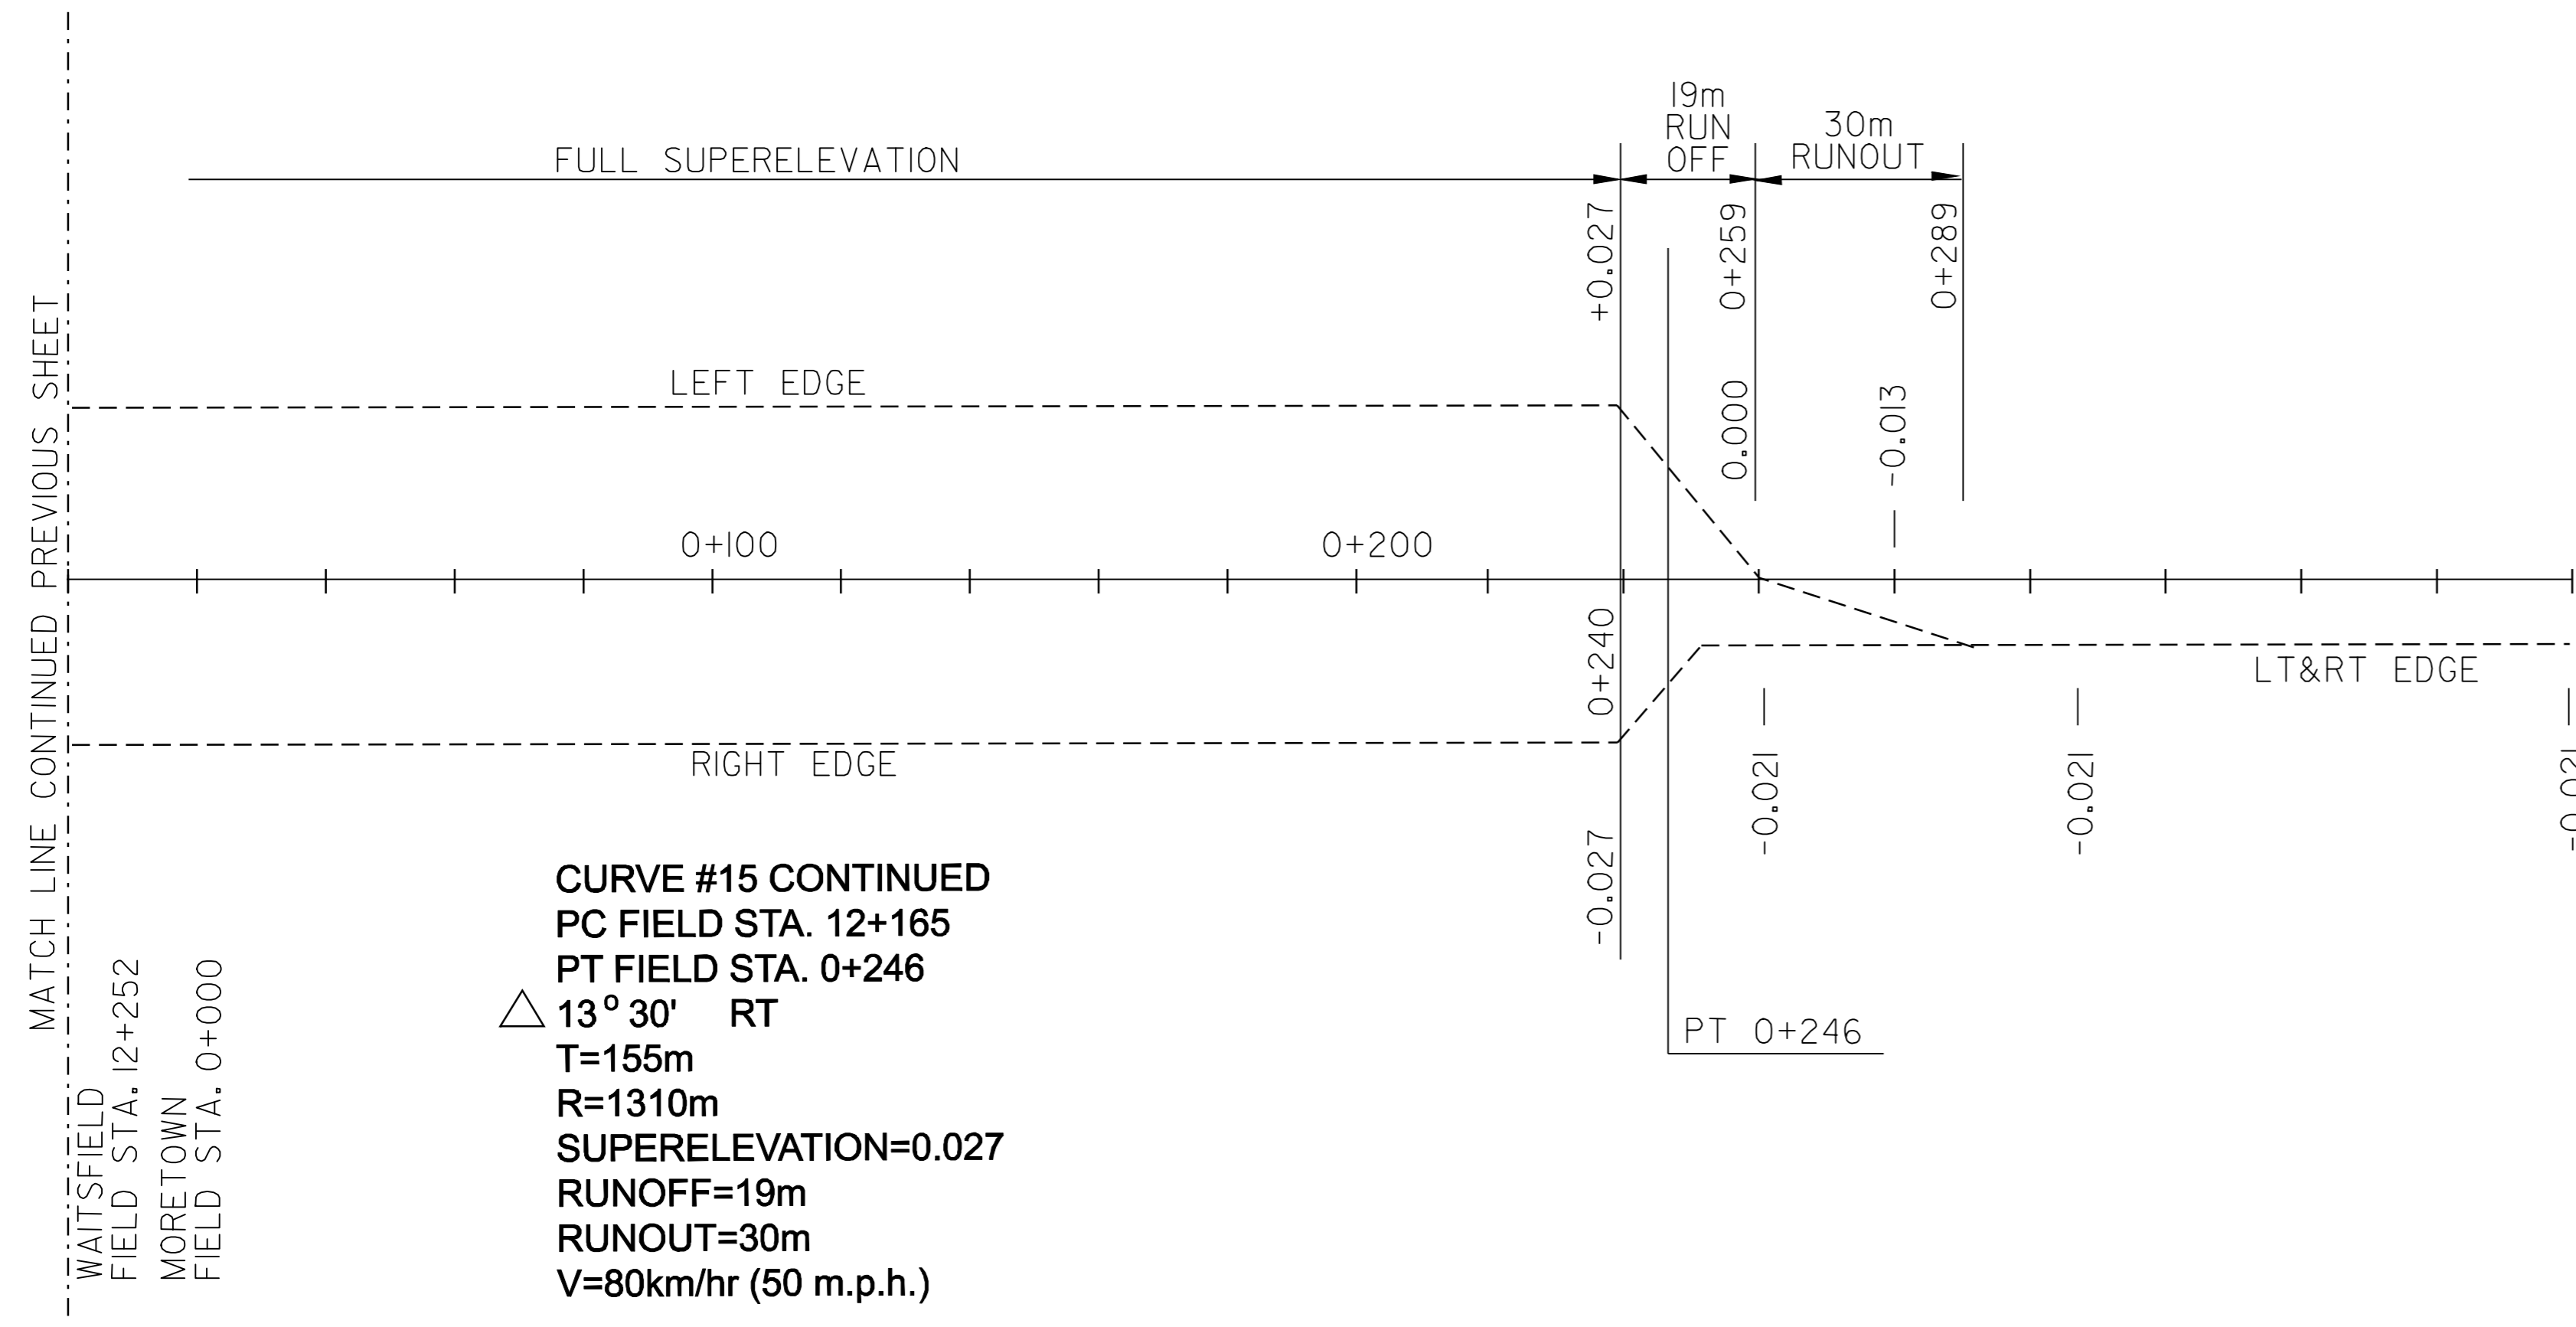

**NOTES:**

SUPERELEVATION DIAGRAMS ARE NOT TO SCALE.

THE CONTRACTOR IS RESPONSIBLE FOR THE ENGINEERING WORK REQUIRED TO LAYOUT AND MAINTAIN THE CROSS SLOPES IN THE REGRADING OF THE RECLAIMED AREAS.

SUPERELEVATION  
DIAGRAM  
SHEET #5

DESIGNED BY	LFW	DATE	1/05
DRAWN BY	LFW	DATE	1/05
DESIGN FILE NO.	_pave/00b058/00b058.dgn		
PRF FILE	00b058bd5.i	DATE PLOTTED	23-MAY-2008
PROJ. NAME	WAITSFIELD - MORETOWN		
PROJ. NO.	STP 2227(1)S		
SHEET	54	OF	54 SHEETS