

REMOVING SIGNS
5 AS SHOWN

646.40 DURABLE 100 mm WHITE LINE (THERMOPLASTIC)
(ALL LINES WILL INCLUDE EDGE LINE BREAKS AND RADIUS FOR TOWN HIGHWAYS)
FAYSTON:
STA. 7+229 - STA. 7+600 LT & RT

646.41 DURABLE 100 mm YELLOW LINE (THERMOPLASTIC)
(ALL LINES WILL INCLUDE C/L BREAKS FOR TOWN HIGHWAYS) S=SOLID, D=DASHED
FAYSTON:
STA. 7+229 - STA. 7+600
STA. 7+458 DOUBLE SOLID RT, T-24
STA. 7+519 DOUBLE SOLID RT, T-25

646.46 DURABLE 600 mm STOP BAR (THERMOPLASTIC)
FAYSTON:
STA. 7+458 RT, T-24
STA. 7+519 RT, T-25

646.60 TEMPORARY 100 mm WHITE LINE (PAINT)
(ALL LINES WILL INCLUDE EDGE LINE BREAKS AND RADIUS FOR TOWN HIGHWAYS)
FAYSTON:
STA. 7+229 - STA. 7+600 LT & RT


646.61 TEMPORARY 100 mm YELLOW LINE (PAINT)
(ALL LINES WILL INCLUDE C/L BREAKS FOR TOWN HIGHWAYS) S=SOLID, D=DASHED
FAYSTON:
STA. 7+229 - STA. 7+600
STA. 7+458 DOUBLE SOLID RT, T-24
STA. 7+519 DOUBLE SOLID RT, T-25

646.66 TEMPORARY 600 mm STOP BAR (PAINT)
FAYSTON:
STA. 7+458 RT, T-24
STA. 7+519 RT, T-25

604.412 REHABILITATION OF DI, CB OR MH
FAYSTON:
STA. 7+231RT (THROATED)
STA. 7+506 RT **NOT CHANGED**

619.17 YIELDING MARKER POSTS
FAYSTON:
STA. 7+231RT & LT (2)
STA. 7+438 RT & LT (2)
STA. 7+463 RT (1)
STA. 7+466 LT (1)
STA. 7+506 RT & LT (2)
STA. 7+530 RT & LT (2)


DITCHING LOCATION
FAYSTON:
STA. 7+231 - 7+250 RT 7+235 - 7+251 LT
STA. 7+466 - 7+506 RT
463

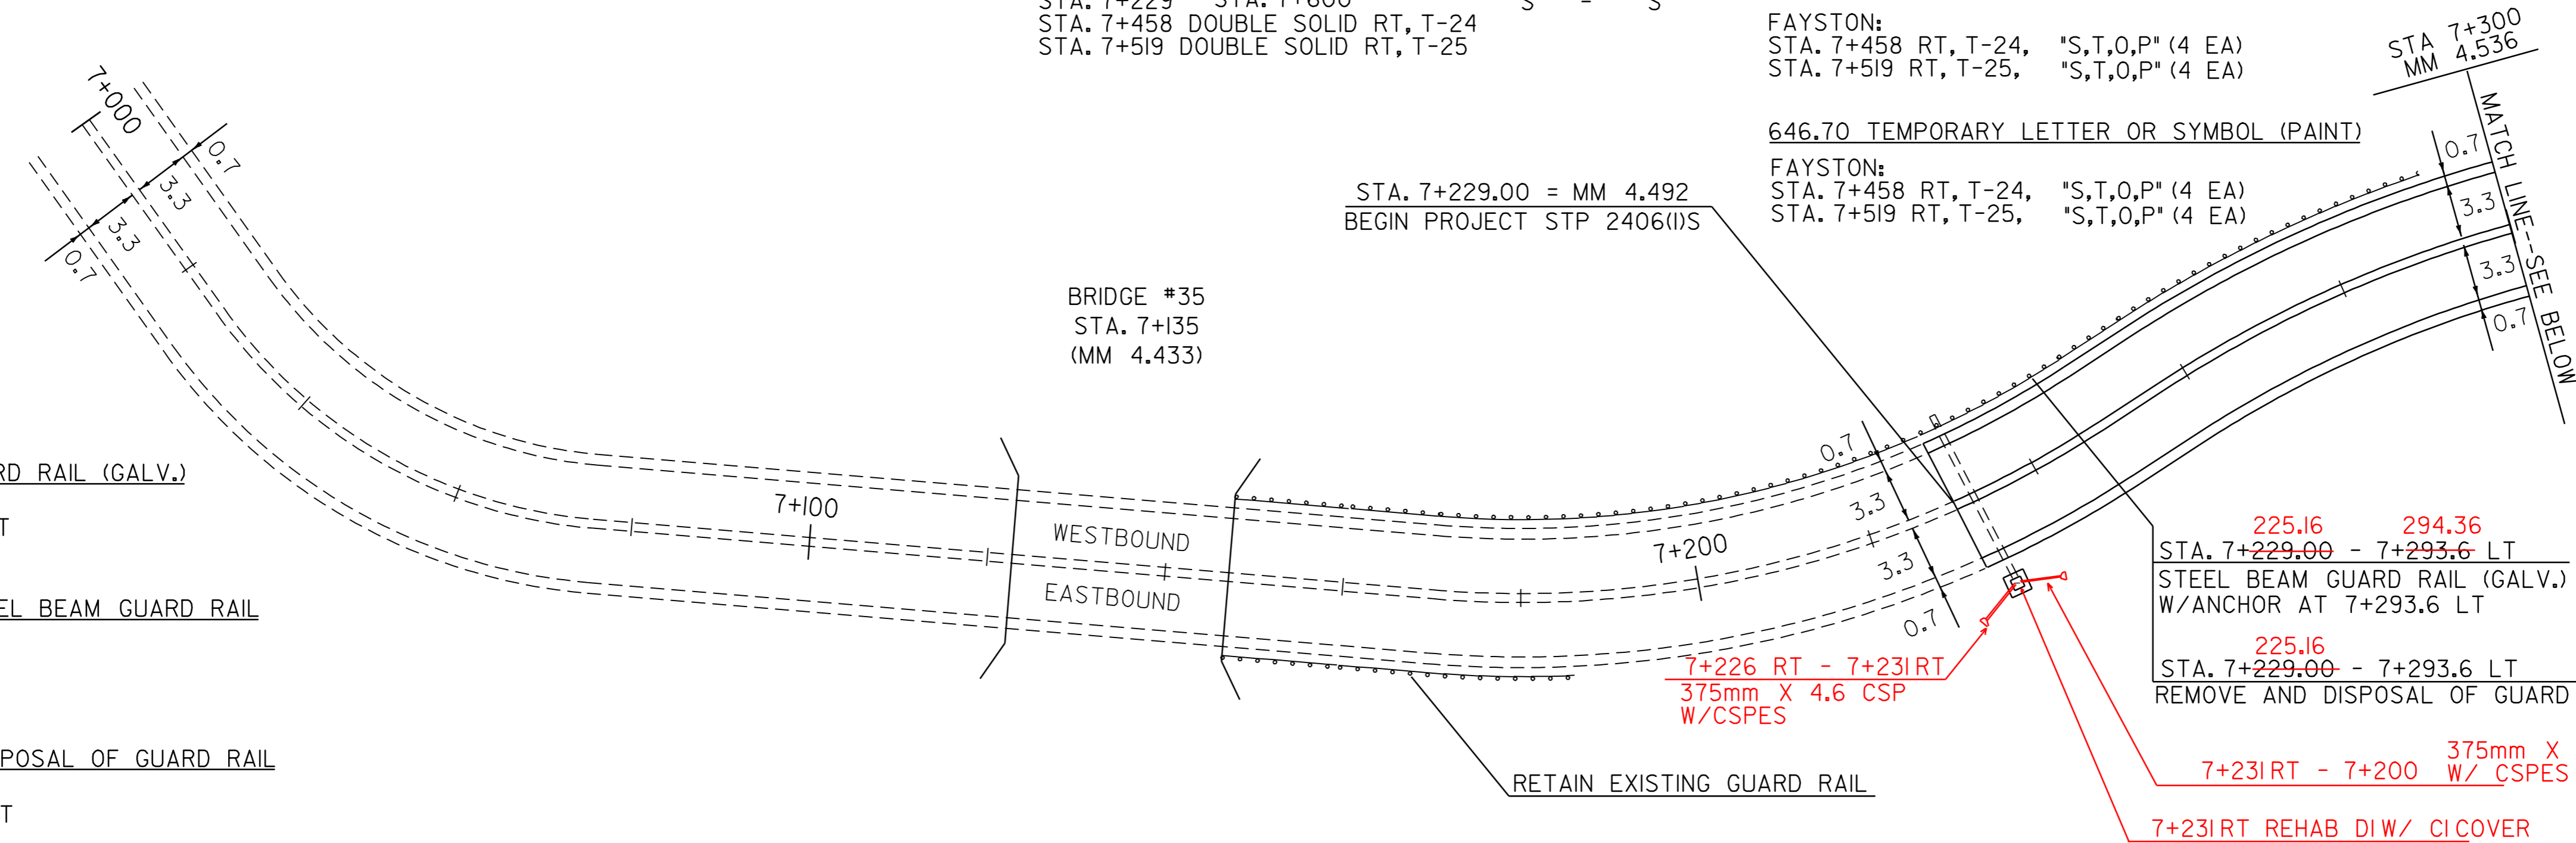

621.20 STEEL BEAM GUARD RAIL (GALV.)
FAYSTON:
STA. 7+229 - 7+293.6 LT

621.60 ANCHOR FOR STEEL BEAM GUARD RAIL
FAYSTON:
STA. 7+293.6 LT

621.80 REMOVAL AND DISPOSAL OF GUARD RAIL
FAYSTON:
STA. 7+229 - 7+293.6 LT

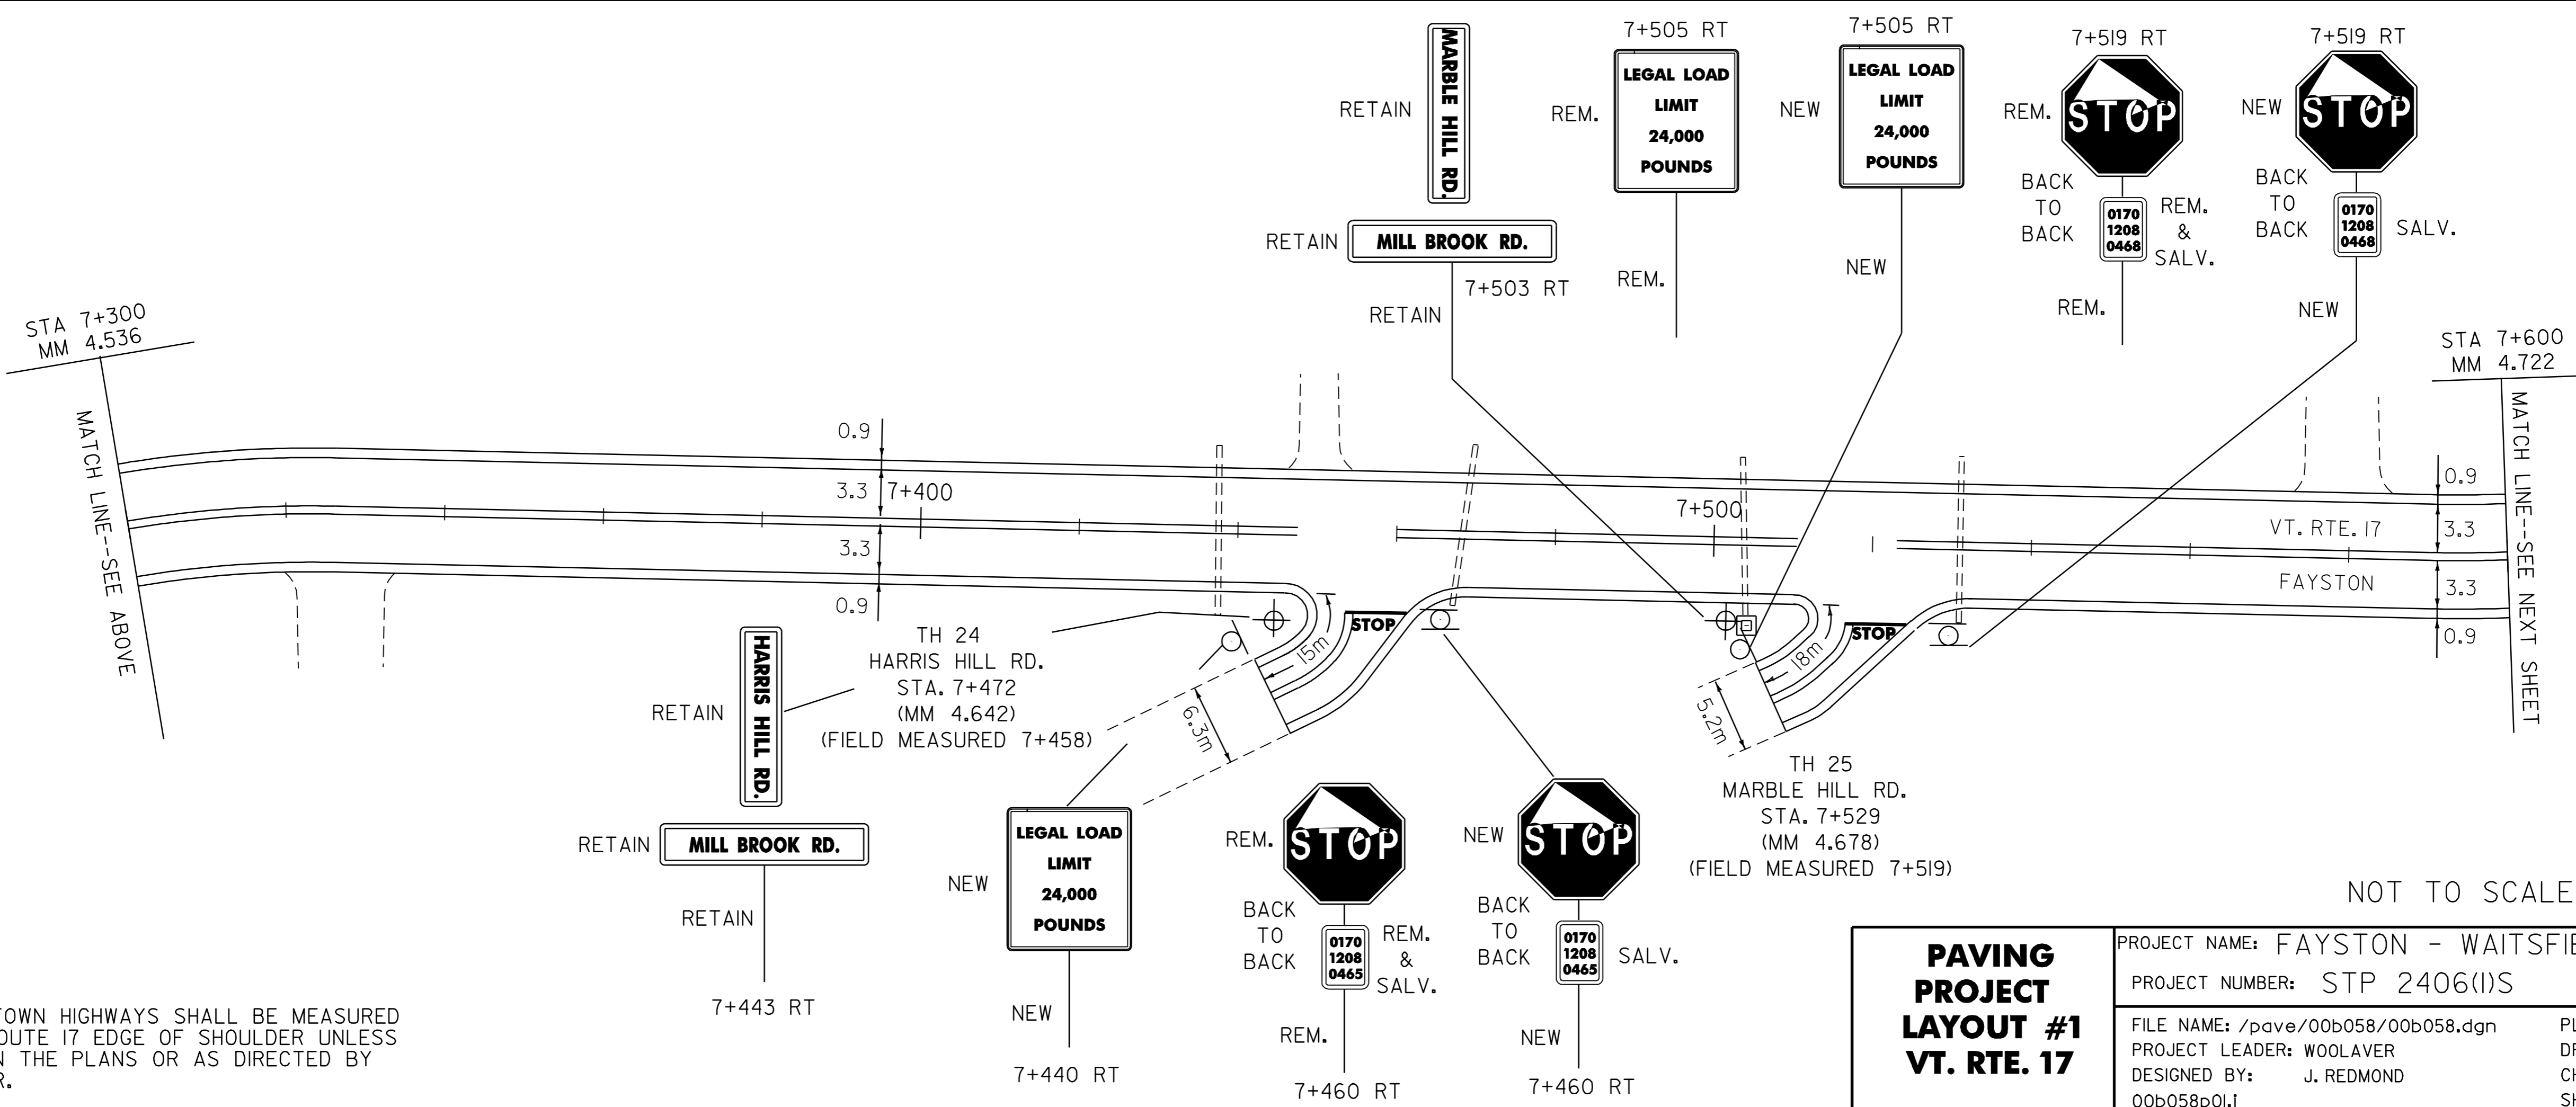

NOTE:
1. PAVING LIMIT ON ALL TOWN HIGHWAYS SHALL BE MEASURED 8 m BACK FROM VT. ROUTE 17 EDGE OF SHOULDER UNLESS DENOTED OTHERWISE ON THE PLANS OR AS DIRECTED BY THE RESIDENT ENGINEER.

PAVING PROJECT LAYOUT #1 VT. RTE. 17	PROJECT NAME: FAYSTON - WAITSFIELD
	PROJECT NUMBER: STP 2406(I)S
	FILE NAME: /pave/00b058/00b058.dgn
	PROJECT LEADER: WOOLLAVER
DESIGNED BY: J. REDMOND	PLOT DATE: 23-MAY-2008 12:30
00b058p01.i	DRAWN BY: J. REDMOND
	CHECKED BY: J. REDMOND
	SHEET 12 OF 54