

646.40 DURABLE 100 mm WHITE LINE (THERMOPLASTIC)
 (ALL LINES WILL INCLUDE EDGE LINE BREAKS AND RADIUS FOR TOWN HIGHWAYS)
 FAYSTON:
 STA. 7+600 - STA. 8+200 LT & RT

646.41 DURABLE 100 mm YELLOW LINE (THERMOPLASTIC)
 (ALL LINES WILL INCLUDE C/L BREAKS FOR TOWN HIGHWAYS) S=SOLID, D=DASHED
 FAYSTON:
 STA. 7+600 - STA. 8+200 LT S CL RT S
 STA. 8+076 DOUBLE SOLID LT, T-17

646.46 DURABLE 600 mm STOP BAR (THERMOPLASTIC)
 FAYSTON:
 STA. 8+076 LT, T-17

646.66 TEMPORARY 600 mm STOP BAR (PAINT)
 FAYSTON:
 STA. 8+076 LT, T-17


646.50 DURABLE LETTER OR SYMBOL (THERMOPLASTIC)
 FAYSTON:
 STA. 8+076 LT, T-17, "S,T,O,P" (4 EA)

646.70 TEMPORARY LETTER OR SYMBOL (PAINT)
 FAYSTON:
 STA. 8+076 LT, T-17, "S,T,O,P" (4 EA)

646.60 TEMPORARY 100 mm WHITE LINE (PAINT)
 (ALL LINES WILL INCLUDE EDGE LINE BREAKS AND RADIUS FOR TOWN HIGHWAYS)
 FAYSTON:
 STA. 7+600 - STA. 8+200 LT & RT

646.61 TEMPORARY 100 mm YELLOW LINE (PAINT)
 (ALL LINES WILL INCLUDE C/L BREAKS FOR TOWN HIGHWAYS) S=SOLID, D=DASHED
 FAYSTON:
 STA. 7+600 - STA. 8+200 LT S CL RT S
 STA. 8+076 DOUBLE SOLID LT, T-17

REMOVING SIGNS
 3 AS SHOWN

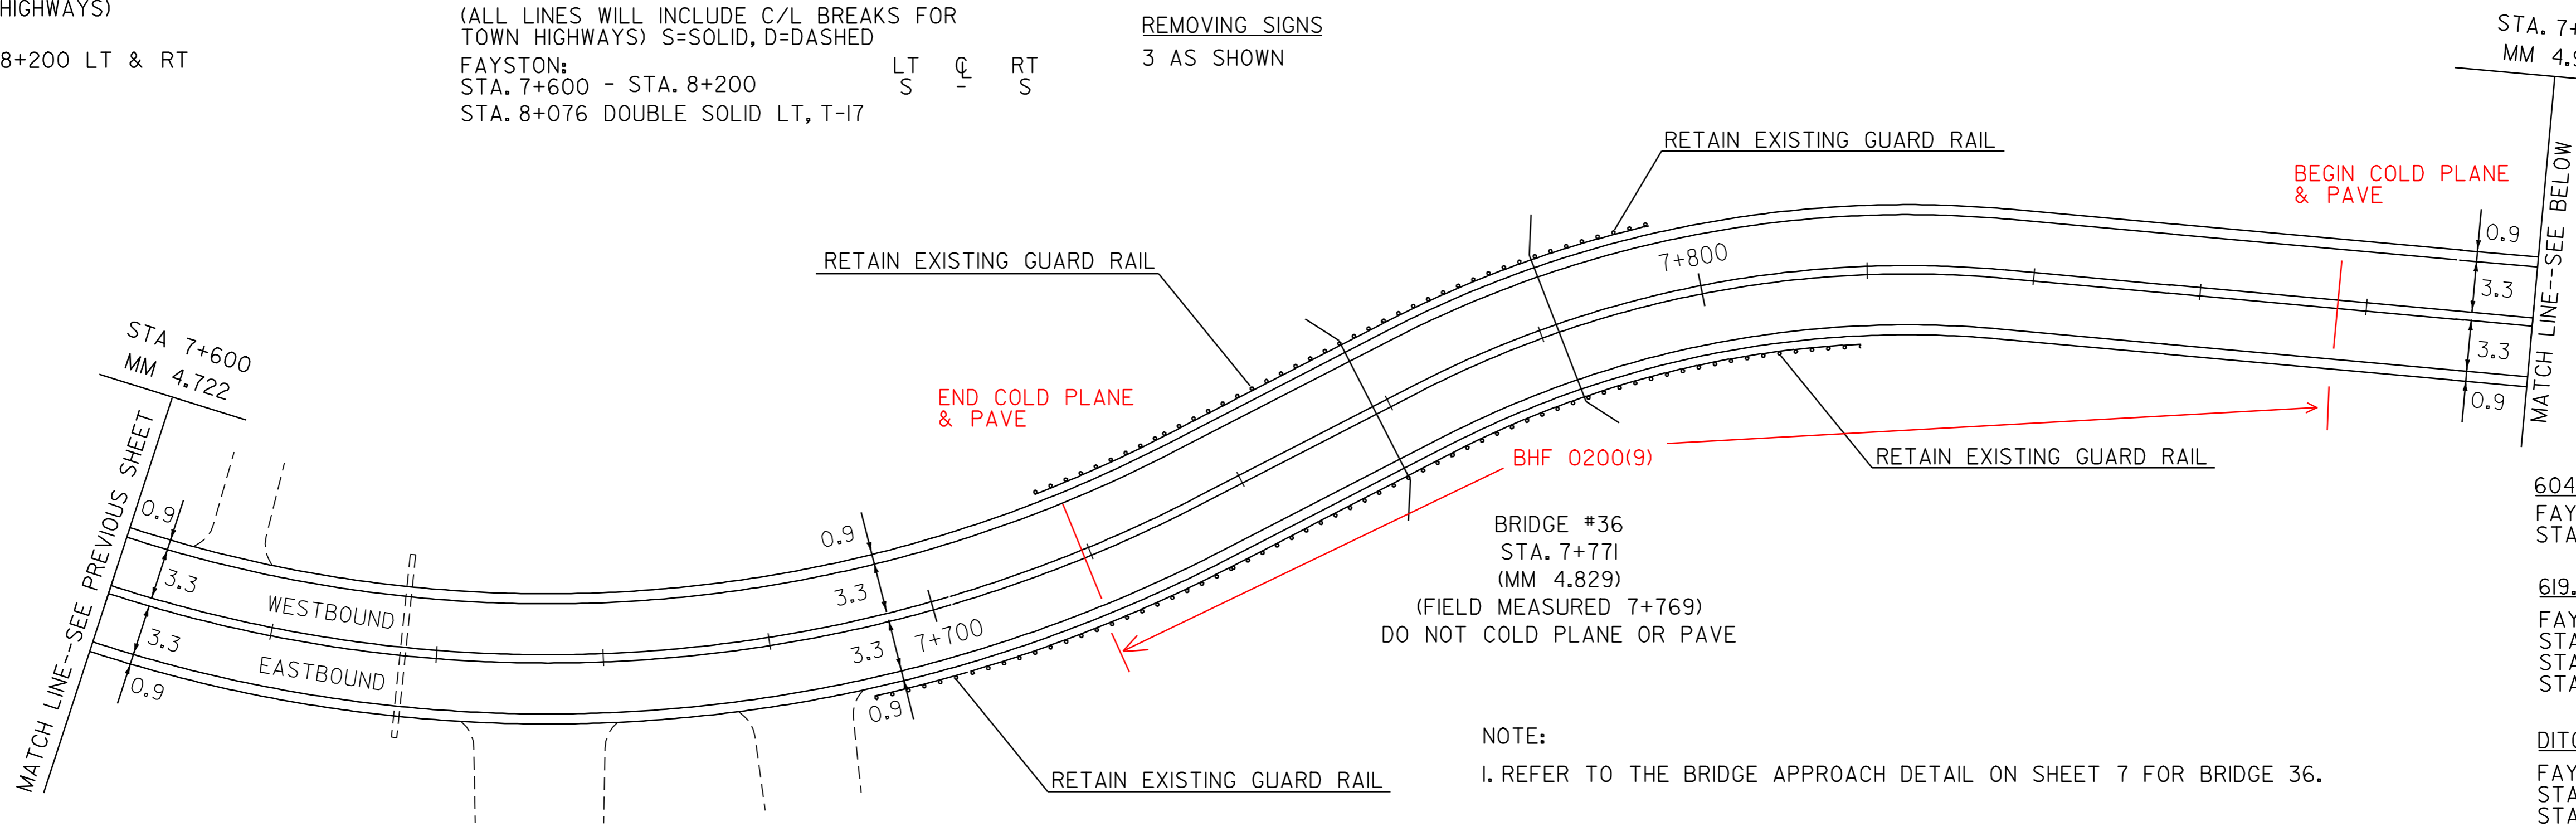

STA. 7+900
MM 4.909

BEGIN COLD PLANE & PAVE

MATCH LINE--SEE BELOW


604.412 REHABILITATION OF DI, CB OR MH
 FAYSTON:
 STA. 7+996 LT

619.17 YIELDING MARKER POSTS
 FAYSTON:
 STA. 7+636 RT & LT (2)
 STA. 7+996 RT & LT (2)
 STA. 8+165 RT & LT (2)

DITCHING LOCATION
 FAYSTON:
 STA. 7+849 - 7+930 LT
 STA. 7+947 - 8+046 LT

NOTES:

- PAVING LIMIT ON ALL TOWN HIGHWAYS SHALL BE MEASURED 8 m BACK FROM VT. ROUTE 17 EDGE OF SHOULDER UNLESS DENOTED OTHERWISE ON THE PLANS OR AS DIRECTED BY THE RESIDENT ENGINEER.
- BRIDGE 37 HAS THREE DRAINAGE STRUCTURES AT CURB LINE ON EACH SIDE. NO ADJUSTMENT IN HEIGHT WILL BE NECESSARY. REFER TO THE NOTES AND COLD PLANE DETAIL ON SHEET 7 FOR BRIDGE 37.
- REFER TO SHEET 23 FOR DETAILS OF THE TERMINAL CONNECTOR FOR STEEL BEAM GUARD RAIL.
- REFER TO SHEET 24 FOR DETAILS OF GUARD RAIL POST SPACING AT NON-YIELDING OBJECTS.

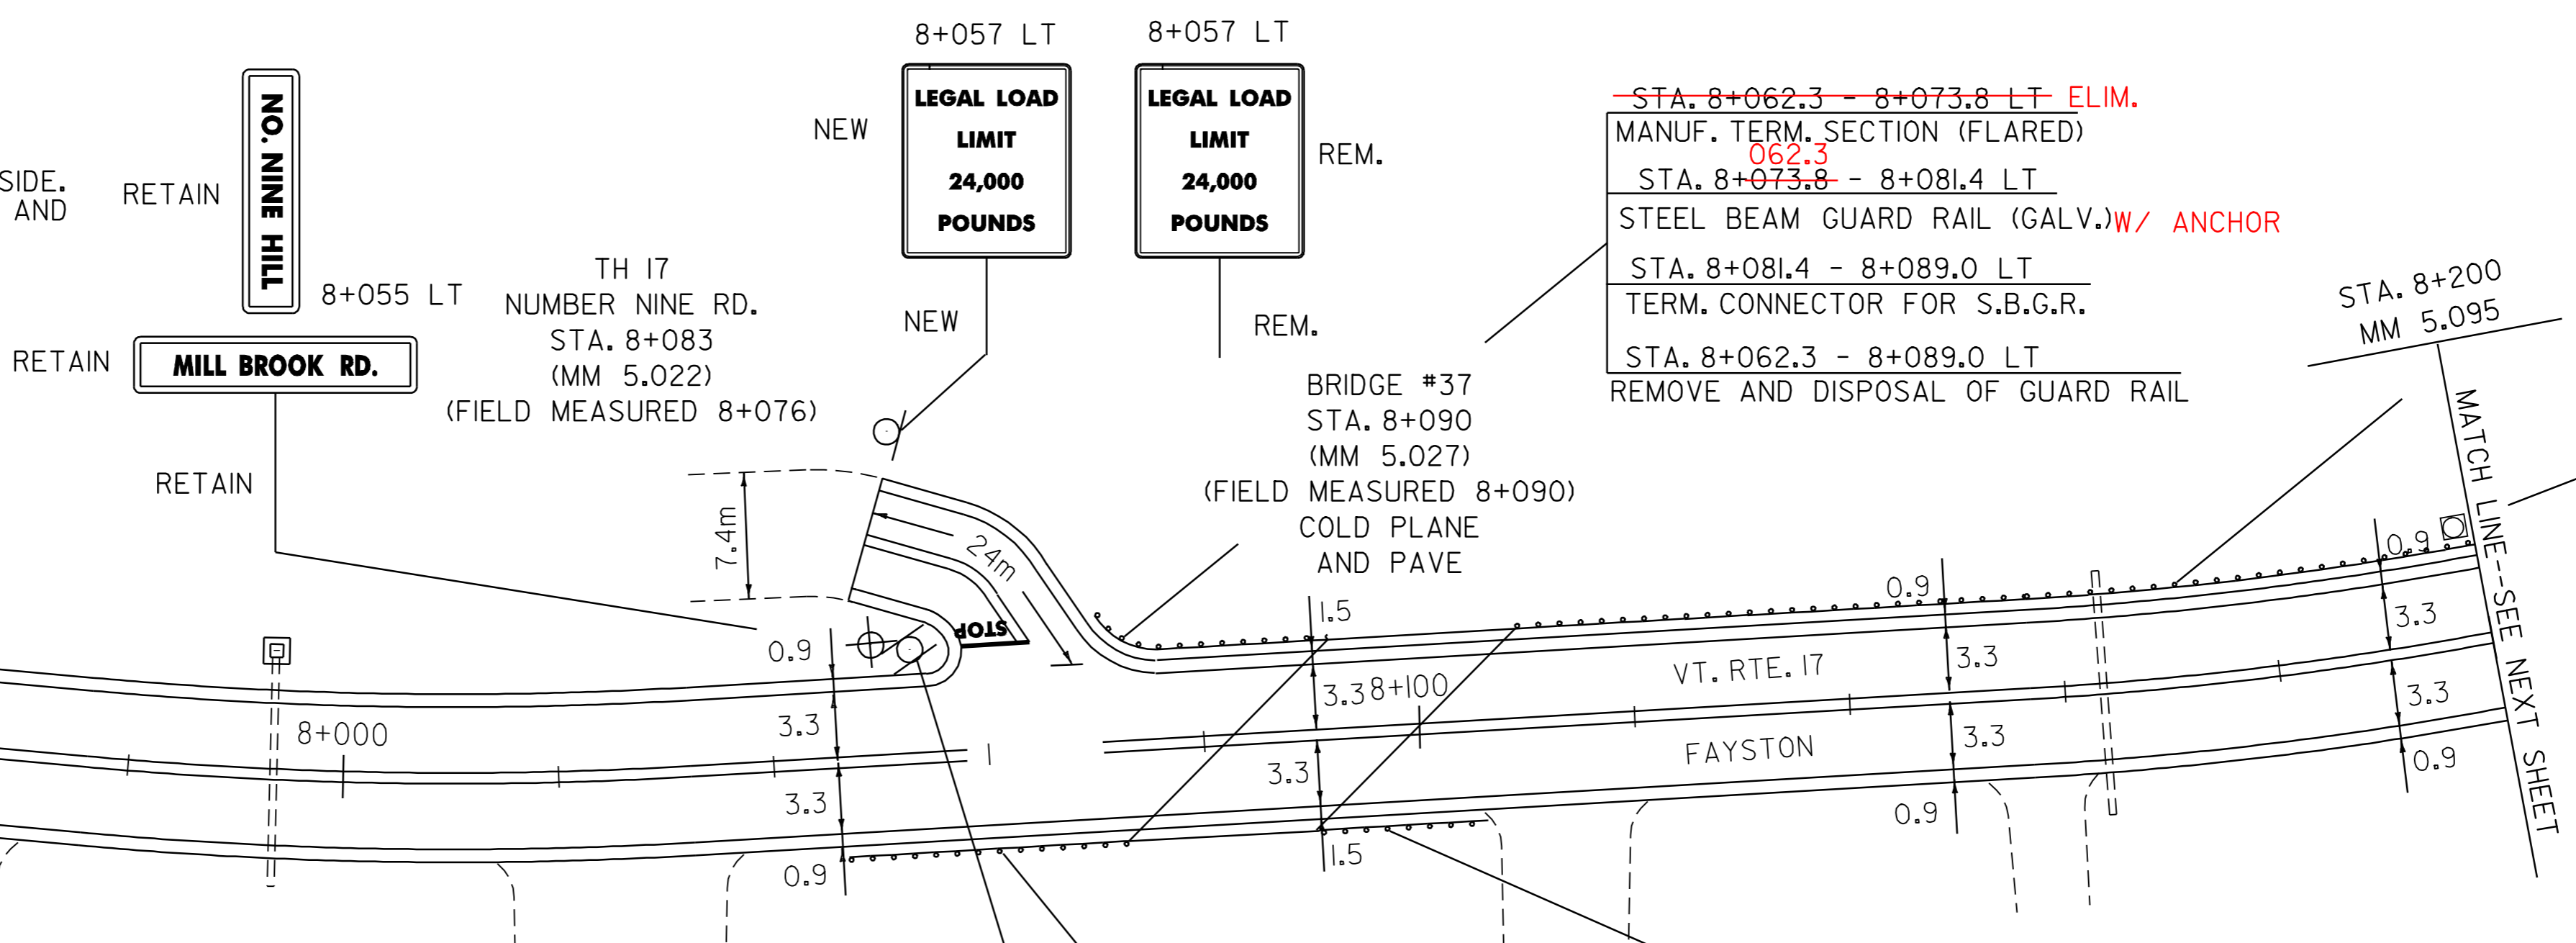

STA. 8+107.0 - 8+114.6 LT
 TERM. CONNECTOR FOR S.B.G.R.
 STA. 8+114.6 - 8+200.0 LT
 STEEL BEAM GUARD RAIL (GALV.)
 STA. 8+107.0 - 8+200.0 LT
 REMOVE AND DISPOSAL OF GUARD RAIL


STA. 8+199 LT (POWER POLE)
 TIGHTEN POST SPACING
 SEE SHEET 24 FOR DETAILS

621.20 STEEL BEAM GUARD RAIL (GALV.)
 FAYSTON:
 STA. 8+056.8 - 8+064.4 RT
 STA. 8+073.8 - 8+081.4 LT
 STA. 8+097.6 - 8+105.2 RT
 STA. 8+114.6 - 8+200.0 LT

621.505 MANUFACTURED TERMINAL SECTION (FLARED)
 FAYSTON:
 STA. 8+045.3 - 8+056.8 RT
 STA. 8+062.3 - 8+073.8 LT

621.60 ANCHOR FOR STEEL BEAM GUARD RAIL
 FAYSTON:
 STA. 8+105.2 RT

621.80 REMOVAL AND DISPOSAL OF GUARD RAIL
 FAYSTON:
 STA. 8+045.3 - 8+072.0 RT
 STA. 8+062.3 - 8+089.0 LT
 STA. 8+090.0 - 8+105.2 RT
 STA. 8+107.0 - 8+200.0 LT

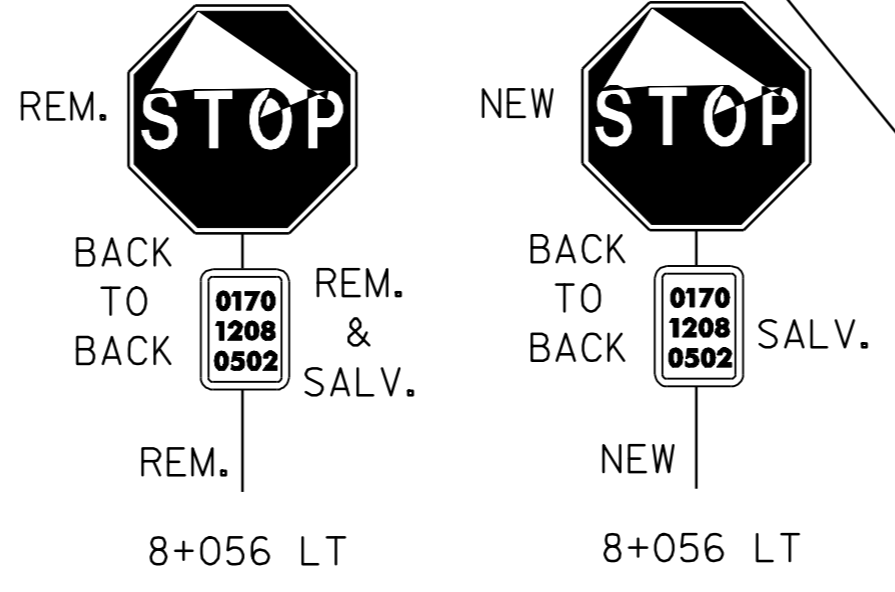

STA. 8+045.3 - 8+056.8 RT
 MANUF. TERM. SECTION (FLARED)
 STA. 8+056.8 - 8+064.4 RT
 STEEL BEAM GUARD RAIL (GALV.)
 STA. 8+064.4 - 8+072.0 RT
 TERM. CONNECTOR FOR S.B.G.R.
 STA. 8+045.3 - 8+072.0 RT
 REMOVE AND DISPOSAL OF GUARD RAIL

STA. 8+090.0 - 8+097.6 RT
 TERM. CONNECTOR FOR S.B.G.R.
 STA. 8+097.6 - 8+105.2 RT
 STEEL BEAM GUARD RAIL (GALV.) W/ANCHOR AT 8+105.2 RT
 STA. 8+090.0 - 8+105.2 RT
 REMOVE AND DISPOSAL OF GUARD RAIL

NOT TO SCALE

PAVING PROJECT LAYOUT #2 VT. RTE. 17

PROJECT NAME: FAYSTON - WAITSFIELD	FILE NAME: /pave/00b058/00b058.dgn	PLOT DATE: 23-MAY-2008 12:30
PROJECT NUMBER: STP 2406(I)S	PROJECT LEADER: WOOLAVER	DRAWN BY: J. REDMOND
	DESIGNED BY: J. REDMOND	CHECKED BY: J. REDMOND
	00b058p02.1	SHEET 13 OF 54