

REMOVING SIGNS  
3 AS SHOWN

646.40 DURABLE 100 mm WHITE LINE (THERMOPLASTIC)  
(ALL LINES WILL INCLUDE EDGE LINE BREAKS AND RADIUS FOR TOWN HIGHWAYS)

FAYSTON:  
STA. 8+200 - STA. 8+800 LT & RT

646.60 TEMPORARY 100 mm WHITE LINE (PAINT)  
(ALL LINES WILL INCLUDE EDGE LINE BREAKS AND RADIUS FOR TOWN HIGHWAYS)

FAYSTON:  
STA. 8+200 - STA. 8+800 LT & RT

646.41 DURABLE 100 mm YELLOW LINE (THERMOPLASTIC)  
(ALL LINES WILL INCLUDE C/L BREAKS FOR TOWN HIGHWAYS) S=SOLID, D=DASHED

FAYSTON:  
STA. 8+200 - STA. 8+800 LT S - RT S  
STA. 8+715 DOUBLE SOLID RT, T-26

646.61 TEMPORARY 100 mm YELLOW LINE (PAINT)  
(ALL LINES WILL INCLUDE C/L BREAKS FOR TOWN HIGHWAYS) S=SOLID, D=DASHED

FAYSTON:  
STA. 8+200 - STA. 8+800 LT S - RT S  
STA. 8+715 DOUBLE SOLID RT, T-26

646.46 DURABLE 600 mm STOP BAR (THERMOPLASTIC)

FAYSTON:  
STA. 8+715 RT, T-26

646.66 TEMPORARY 600 mm STOP BAR (PAINT)

FAYSTON:  
STA. 8+715 RT, T-26

646.50 DURABLE LETTER OR SYMBOL (THERMOPLASTIC)

FAYSTON:  
STA. 8+715 RT, T-26, "S,T,O,P" (4 EA)

646.70 TEMPORARY LETTER OR SYMBOL (PAINT)


FAYSTON:  
STA. 8+715 RT, T-26, "S,T,O,P" (4 EA)

619.17 YIELDING MARKER POSTS

FAYSTON:  
STA. 8+300 RT & LT (2)  
STA. 8+414 RT & LT (2)  
STA. 8+499 RT & LT (2)  
STA. 8+699 RT (1)  
STA. 8+702 LT (1)

DITCHING LOCATION

FAYSTON:  
~~STA. 8+730 - 8+800 RT ELIM.~~

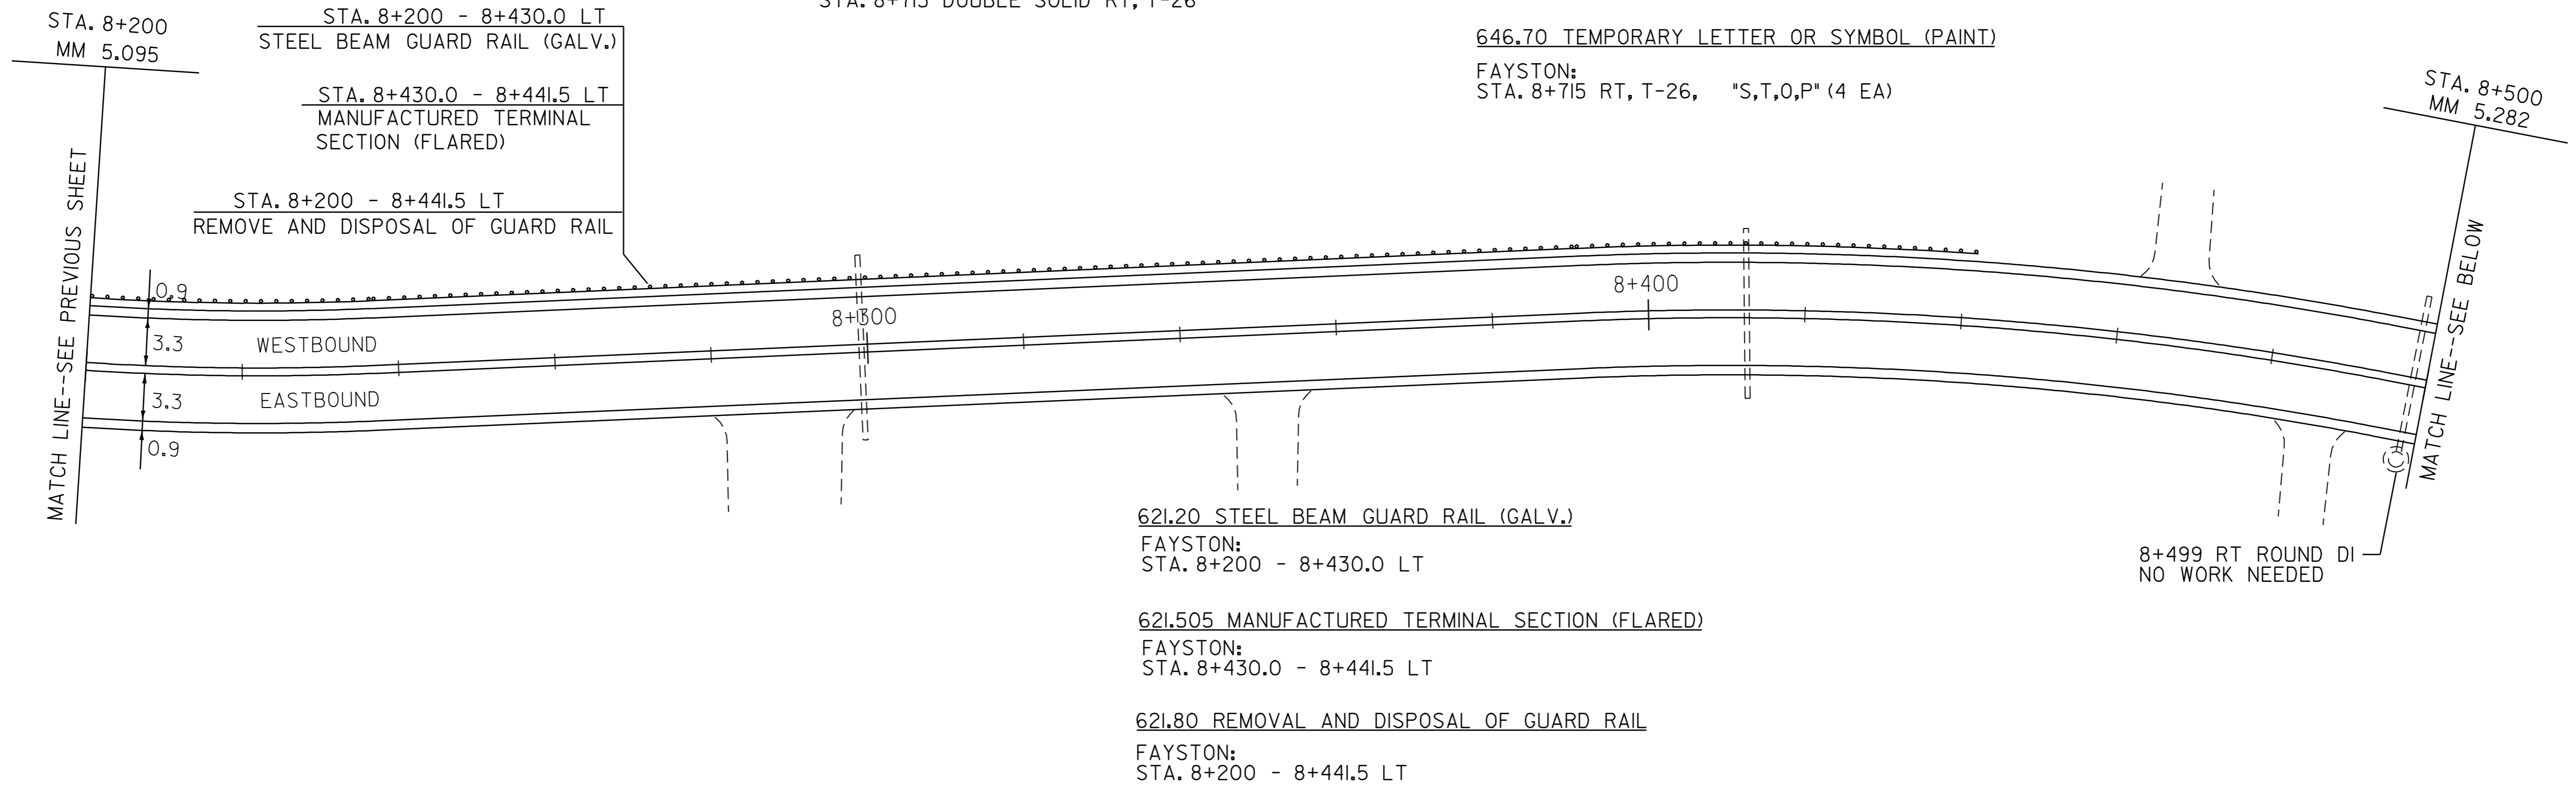

621.20 STEEL BEAM GUARD RAIL (GALV.)  
FAYSTON:  
STA. 8+200 - 8+430.0 LT

621.505 MANUFACTURED TERMINAL SECTION (FLARED)  
FAYSTON:  
STA. 8+430.0 - 8+441.5 LT

621.80 REMOVAL AND DISPOSAL OF GUARD RAIL  
FAYSTON:  
STA. 8+200 - 8+441.5 LT


8+499 RT ROUND DI  
NO WORK NEEDED

STA. 8+500  
MM 5.282



MATCH LINE--SEE ABOVE

8+700 RT 600mm CSP  
EXTEND 2.0m PAID AS 4M 450mm CSP

PIPE EXTENSION

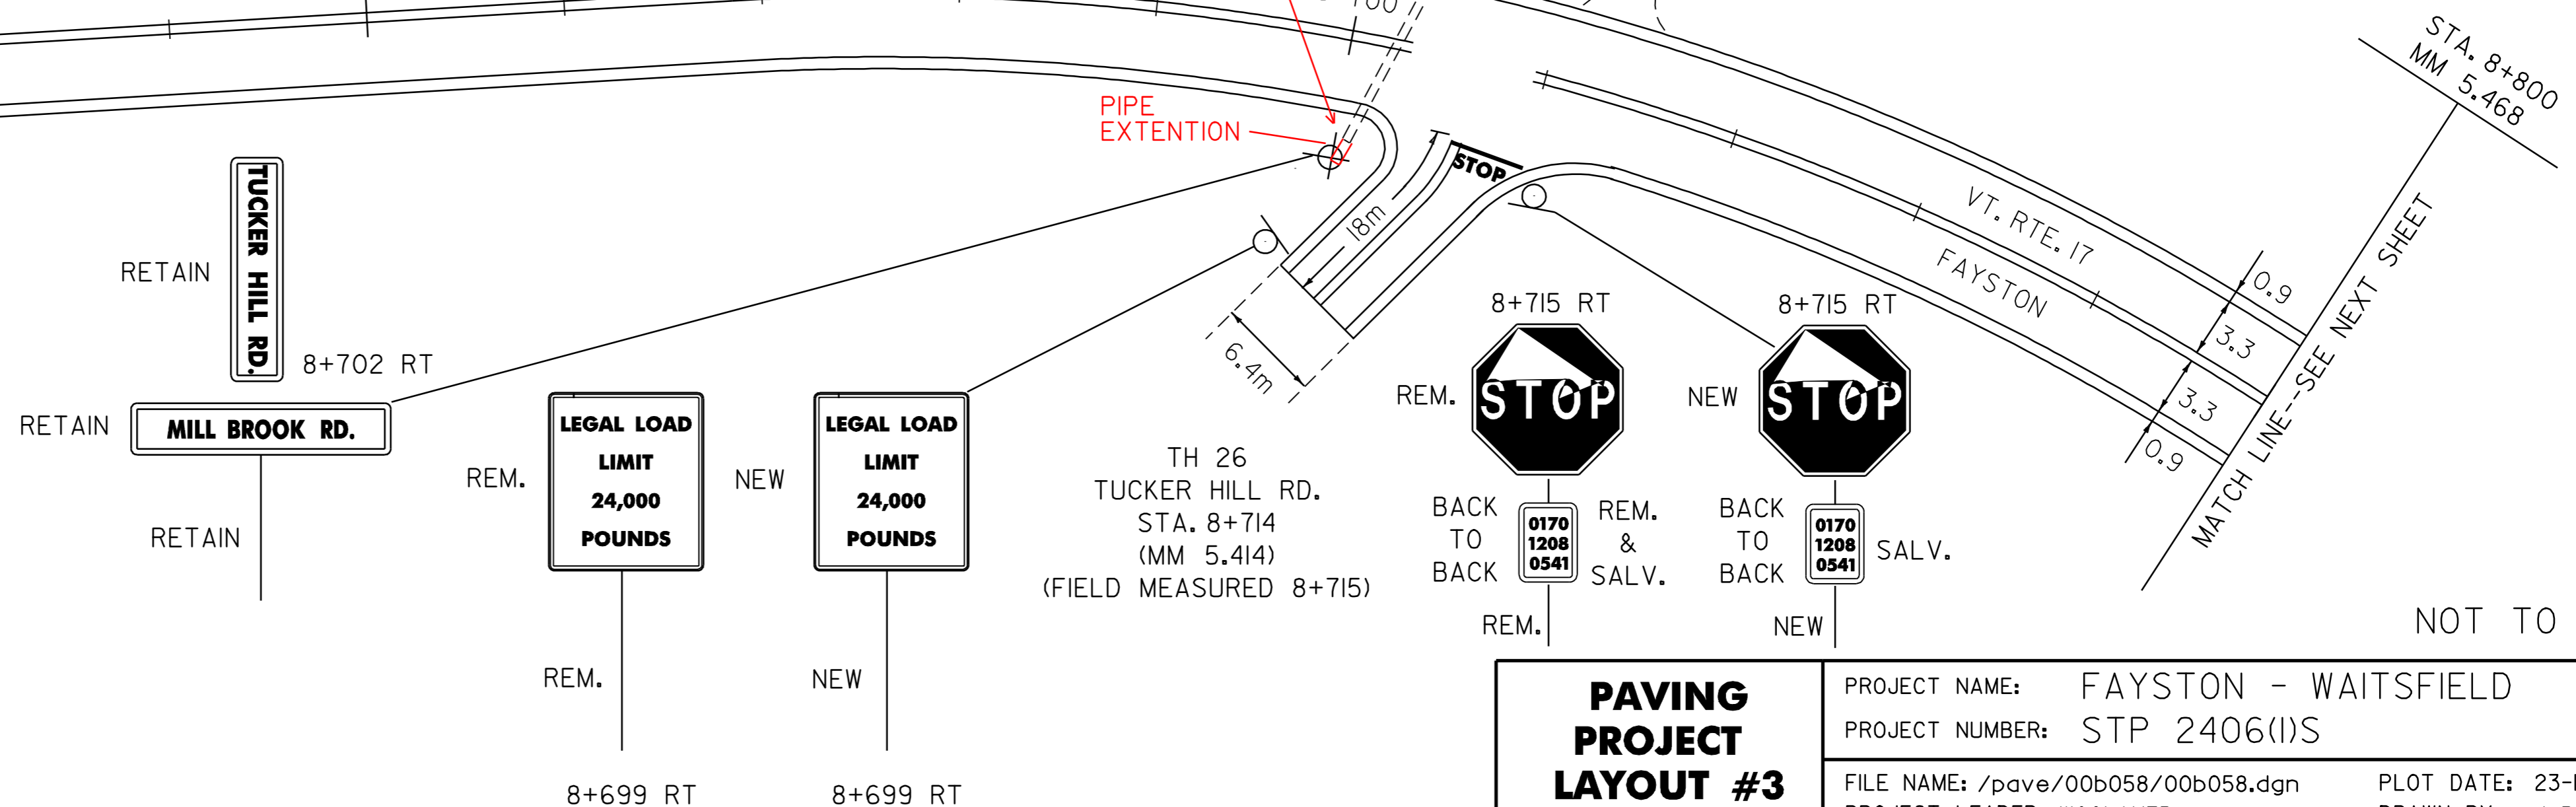

TH 26  
TUCKER HILL RD.  
STA. 8+714  
(MM 5.414)  
(FIELD MEASURED 8+715)

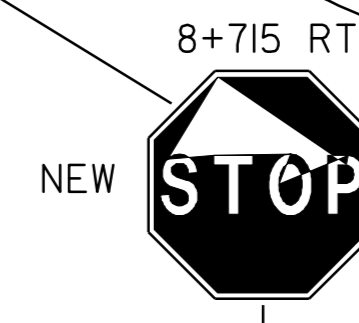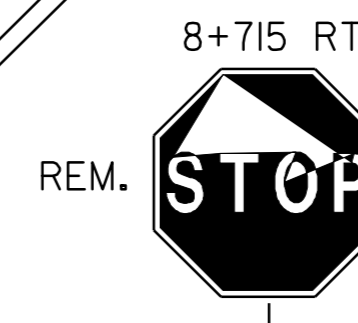

0170  
1208  
0541

0170  
1208  
0541

NOT TO SCALE

NOTE:

1. PAVING LIMIT ON ALL TOWN HIGHWAYS SHALL BE MEASURED 8 m BACK FROM VT. ROUTE 17 EDGE OF SHOULDER UNLESS DENOTED OTHERWISE ON THE PLANS OR AS DIRECTED BY THE RESIDENT ENGINEER.

**PAVING  
PROJECT  
LAYOUT #3  
VT. RTE. 17**

PROJECT NAME: FAYSTON - WAITSFIELD  
PROJECT NUMBER: STP 2406(I)S

FILE NAME: /pave/00b058/00b058.dgn  
PROJECT LEADER: WOOLAVER  
DESIGNED BY: J. REDMOND  
00b058p03.1

PLOT DATE: 23-MAY-2008 12:30  
DRAWN BY: J. REDMOND  
CHECKED BY: J. REDMOND  
SHEET 14 OF 54