

646.40 DURABLE 100 mm WHITE LINE (THERMOPLASTIC)  
 (ALL LINES WILL INCLUDE EDGE LINE BREAKS AND RADIUS FOR TOWN HIGHWAYS)

FAYSTON:  
 STA. 8+800 - STA. 9+372.6 LT & RT

646.60 TEMPORARY 100 mm WHITE LINE (PAINT)  
 (ALL LINES WILL INCLUDE EDGE LINE BREAKS AND RADIUS FOR TOWN HIGHWAYS)

FAYSTON:  
 STA. 8+800 - STA. 9+372.6 LT & RT

646.41 DURABLE 100 mm YELLOW LINE (THERMOPLASTIC)  
 (ALL LINES WILL INCLUDE C/L BREAKS FOR TOWN HIGHWAYS) S=SOLID, D=DASHED

FAYSTON:  
 STA. 8+800 - STA. 9+372.6 LT C RT  
 S - S

646.61 TEMPORARY 100 mm YELLOW LINE (PAINT)  
 (ALL LINES WILL INCLUDE C/L BREAKS FOR TOWN HIGHWAYS) S=SOLID, D=DASHED


FAYSTON:  
 STA. 8+800 - STA. 9+372.6 LT C RT  
 S - S

619.17 YIELDING MARKER POSTS

FAYSTON:  
 STA. 8+915 RT & LT (2)  
 STA. 9+042 RT (1)  
 STA. 9+046 LT (1)  
 STA. 9+123 RT & LT (2)  
 STA. 9+322 RT & LT (2)  
 STA. 9+369 RT & LT (2)

DITCHING LOCATION

FAYSTON:  
~~STA. 8+800 - 8+958 RT~~ 8+923 ~ 8+954 RT  
~~STA. 9+281 - 9+322 RT~~ 8+966 ~ 9+040 RT  
~~STA. 9+369 - 9+373 RT~~ ELIM.

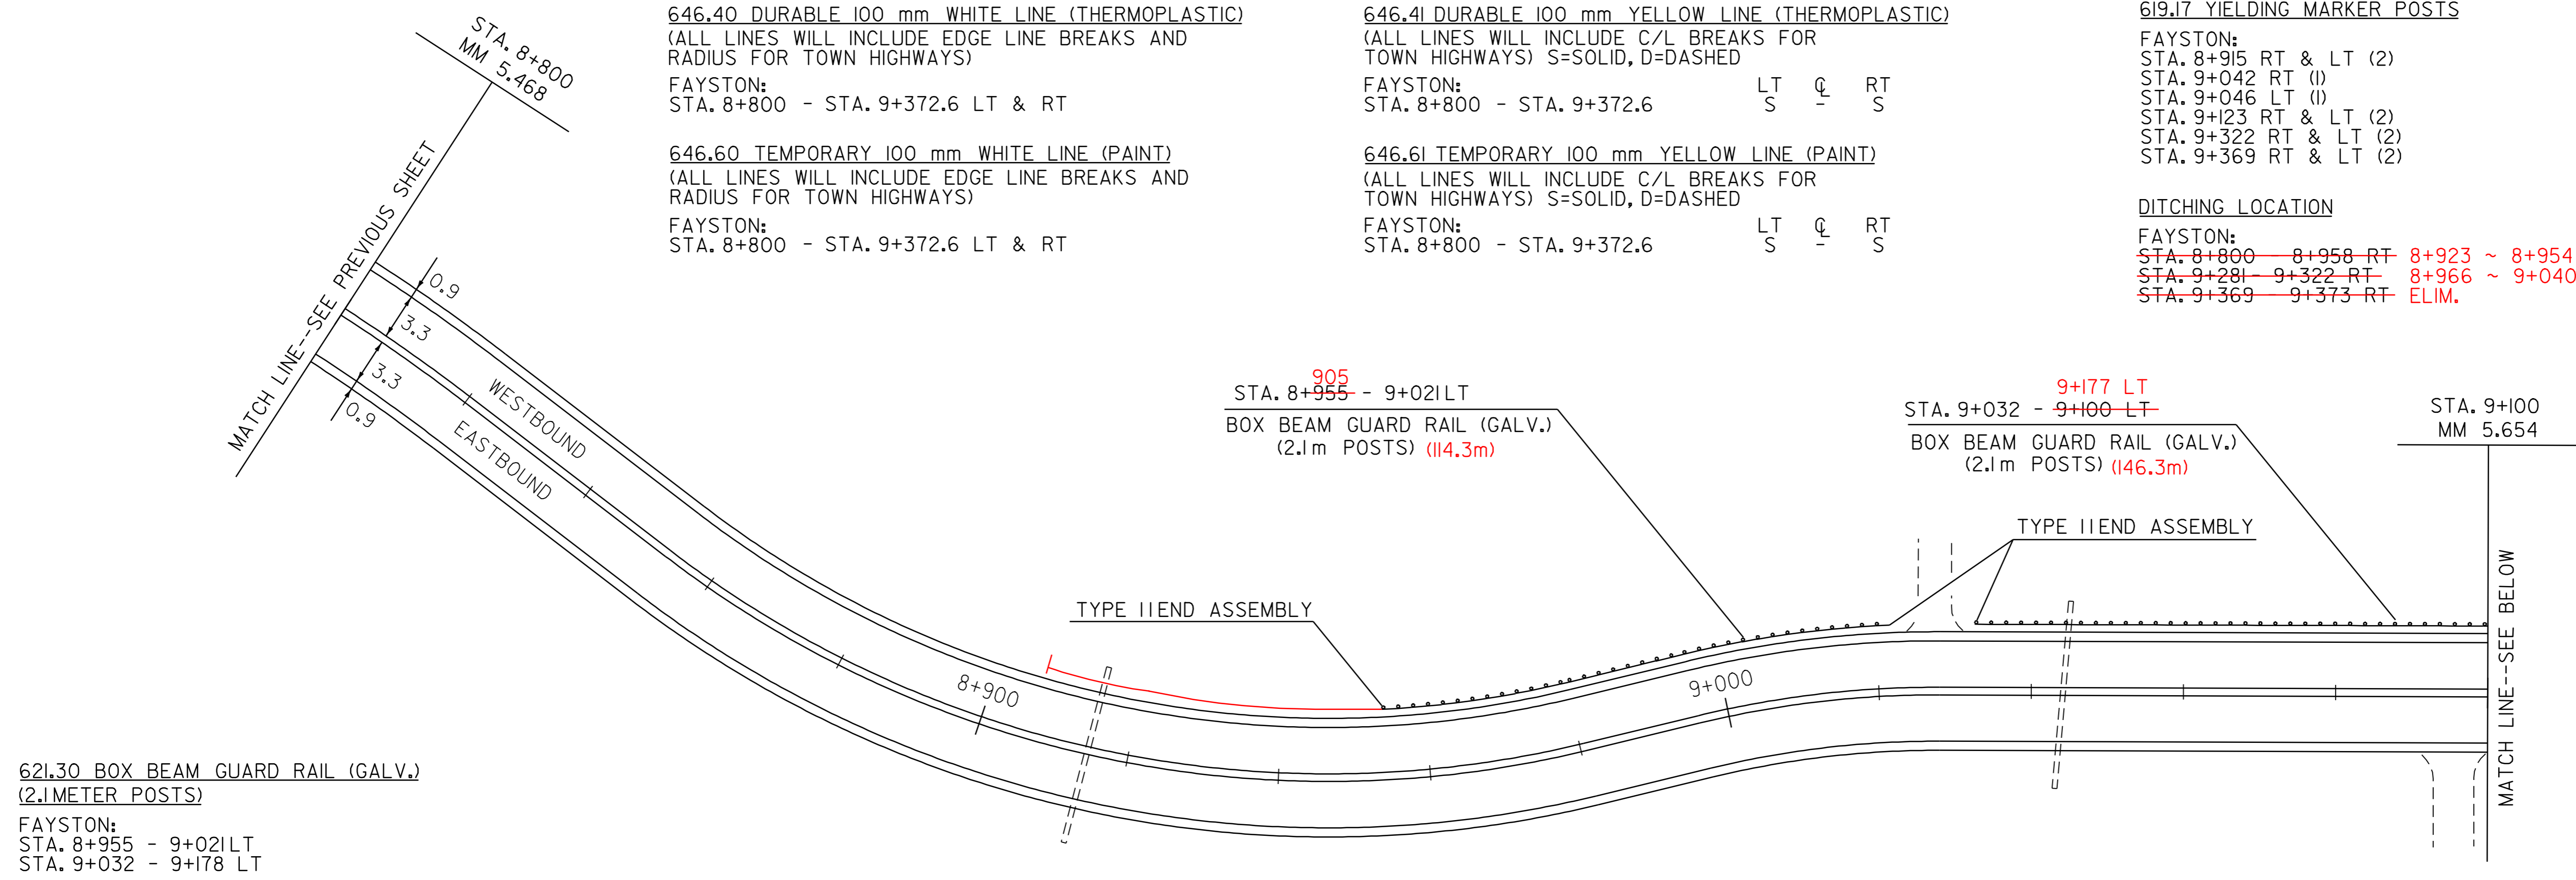


621.30 BOX BEAM GUARD RAIL (GALV.)  
 (2.1METER POSTS)  
 FAYSTON:  
 STA. 8+955 - 9+021 LT  
 STA. 9+032 - 9+178 LT

905  
 STA. 8+955 - 9+021 LT  
 BOX BEAM GUARD RAIL (GALV.)  
 (2.1m POSTS) (114.3m)

9+177 LT  
 STA. 9+032 - 9+100 LT  
 BOX BEAM GUARD RAIL (GALV.)  
 (2.1m POSTS) (146.3m)

STA. 9+100  
 MM 5.654

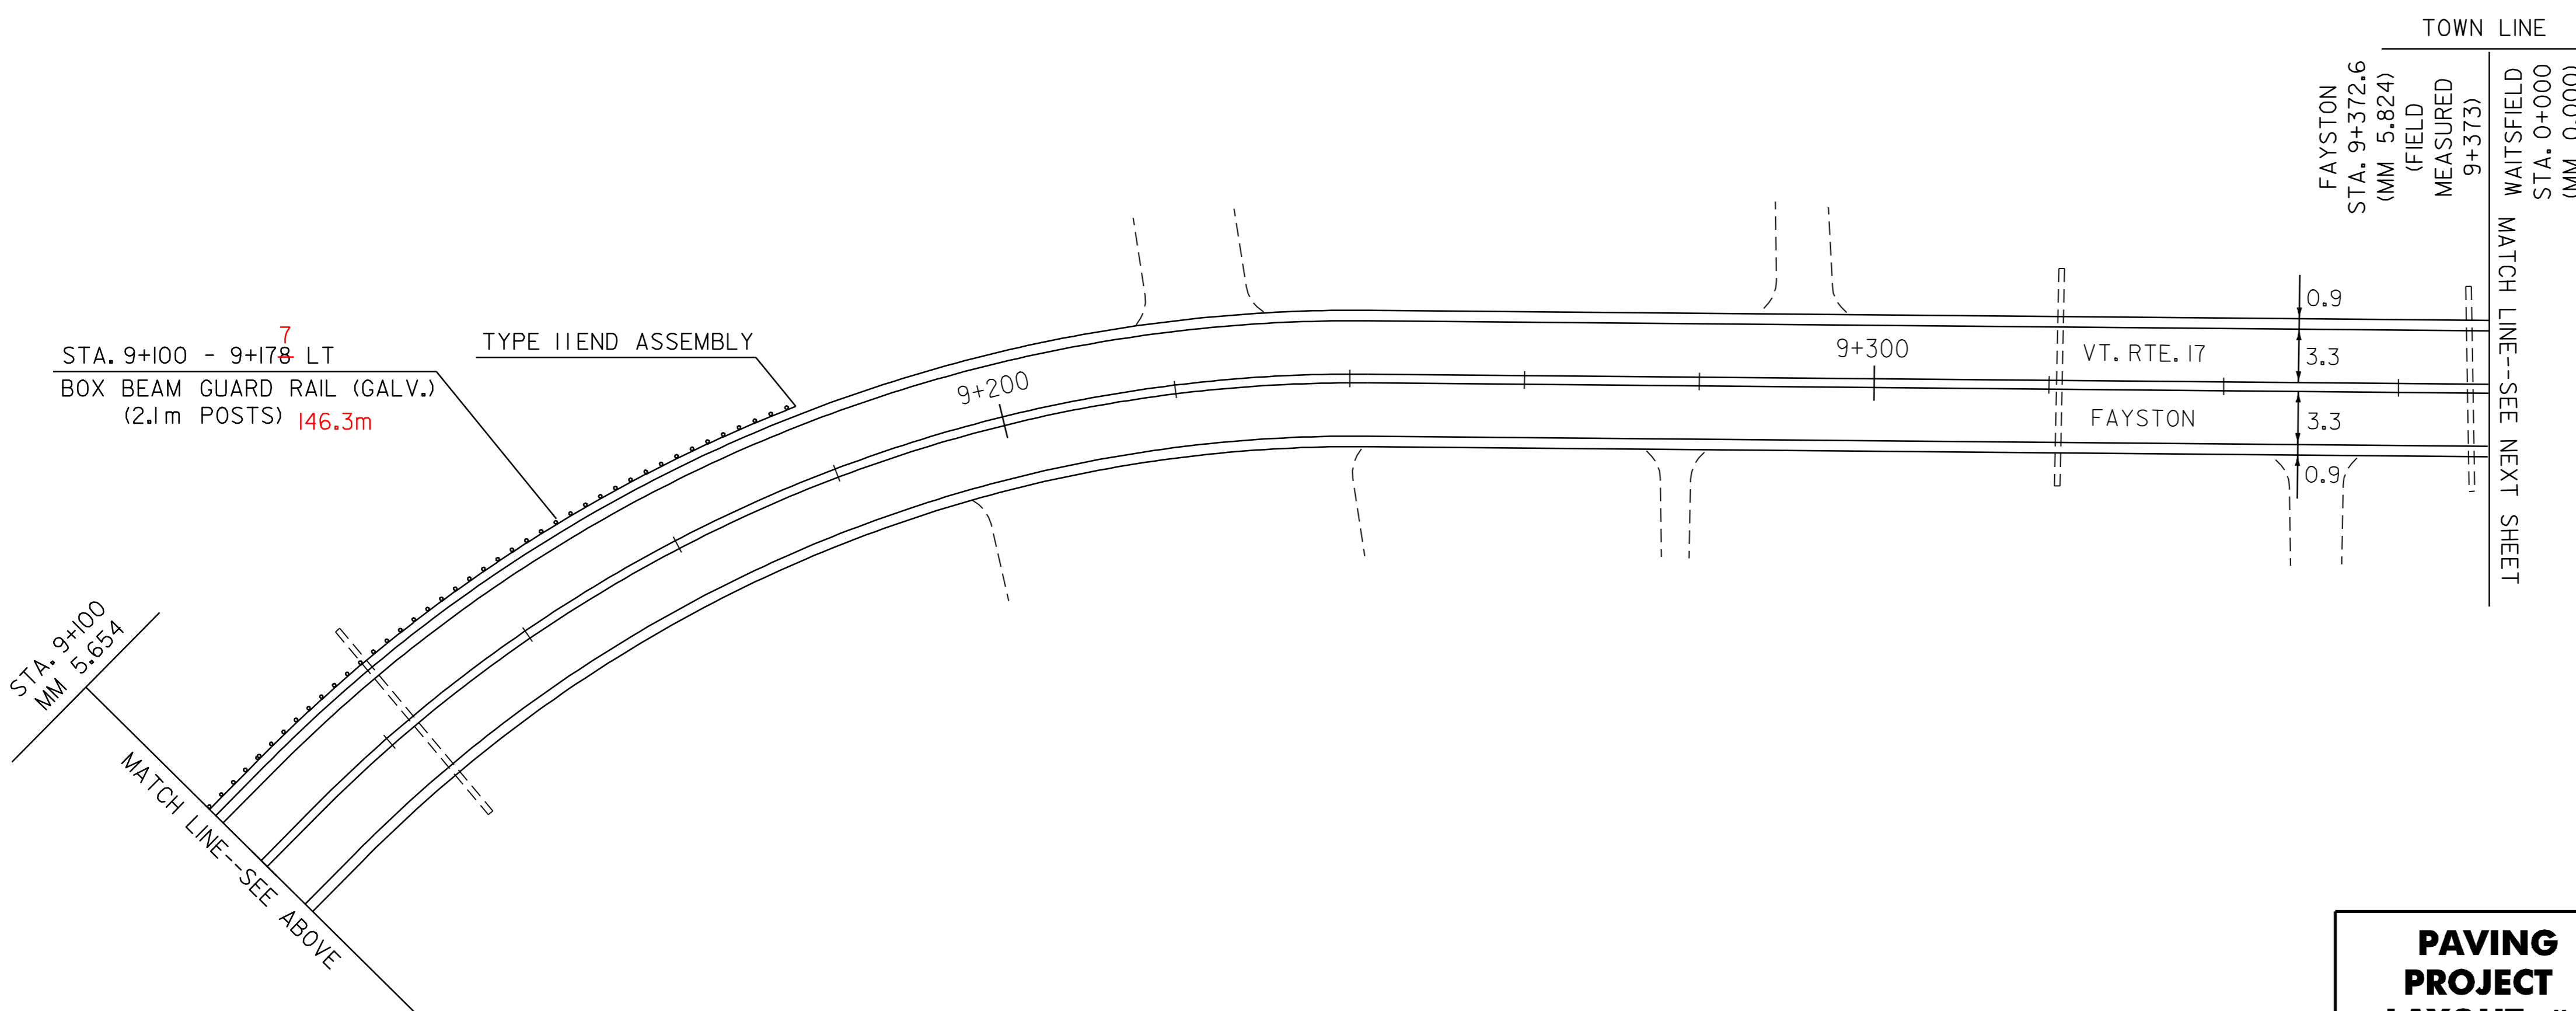

7  
 STA. 9+100 - 9+178 LT  
 BOX BEAM GUARD RAIL (GALV.)  
 (2.1m POSTS) 146.3m

TOWN LINE  
 FAYSTON  
 STA. 9+372.6  
 (MM 5.824)  
 (FIELD  
 MEASURED  
 9+373)  
 WAITSFIELD  
 STA. 0+000  
 (MM 0.000)

MATCH LINE--SEE NEXT SHEET

NOT TO SCALE

<b>PAVING PROJECT LAYOUT #4 VT. RTE. 17</b>	PROJECT NAME: FAYSTON - WAITSFIELD
	PROJECT NUMBER: STP 2406(I)S
	FILE NAME: /pave/00b058/00b058.dgn
	DESIGNED BY: J. REDMOND
	PLOT DATE: 23-MAY-2008 12:5
	DRAWN BY: J. REDMOND
	CHECKED BY: J. REDMOND
	SHEET 15 OF 54