

REMOVING SIGNS
3 AS SHOWN

646.40 DURABLE 100 mm WHITE LINE (THERMOPLASTIC)
(ALL LINES WILL INCLUDE EDGE LINE BREAKS AND RADIUS FOR TOWN HIGHWAYS)
WAITSFIELD:
STA. 0+000 - STA. 0+092 LT & RT

646.60 TEMPORARY 100 mm WHITE LINE (PAINT)
(ALL LINES WILL INCLUDE EDGE LINE BREAKS AND RADIUS FOR TOWN HIGHWAYS)
WAITSFIELD:
STA. 0+000 - STA. 0+092 LT & RT

646.41 DURABLE 100 mm YELLOW LINE (THERMOPLASTIC)
(ALL LINES WILL INCLUDE C/L BREAKS FOR TOWN HIGHWAYS) S=SOLID, D=DASHED
WAITSFIELD:
STA. 0+000 - STA. 0+092 LT S - RT S
STA. 0+087 DOUBLE SOLID RT, T-29

646.61 TEMPORARY 100 mm YELLOW LINE (PAINT)
(ALL LINES WILL INCLUDE C/L BREAKS FOR TOWN HIGHWAYS) S=SOLID, D=DASHED
WAITSFIELD:
STA. 0+000 - STA. 0+092 LT S - RT S
STA. 0+087 DOUBLE SOLID RT, T-29

646.46 DURABLE 600 mm STOP BAR (THERMOPLASTIC)
WAITSFIELD:
STA. 0+087 RT, T-29


646.66 TEMPORARY 600 mm STOP BAR (PAINT)
WAITSFIELD:
STA. 0+087 RT, T-29

646.50 DURABLE LETTER OR SYMBOL (THERMOPLASTIC)
WAITSFIELD:
STA. 0+087 RT, T-29, "S,T,O,P" (4 EA)

646.70 TEMPORARY LETTER OR SYMBOL (PAINT)
WAITSFIELD:
STA. 0+087 RT, T-29, "S,T,O,P" (4 EA)

619.17 YIELDING MARKER POSTS
WAITSFIELD:
STA. 0+025 RT (I)
STA. 0+034 LT (I)
STA. 0+067 RT (I)
STA. 0+071 LT (I)

DITCHING LOCATION
WAITSFIELD:
~~STA. 0+000 - 0+067 RT ELIM.~~

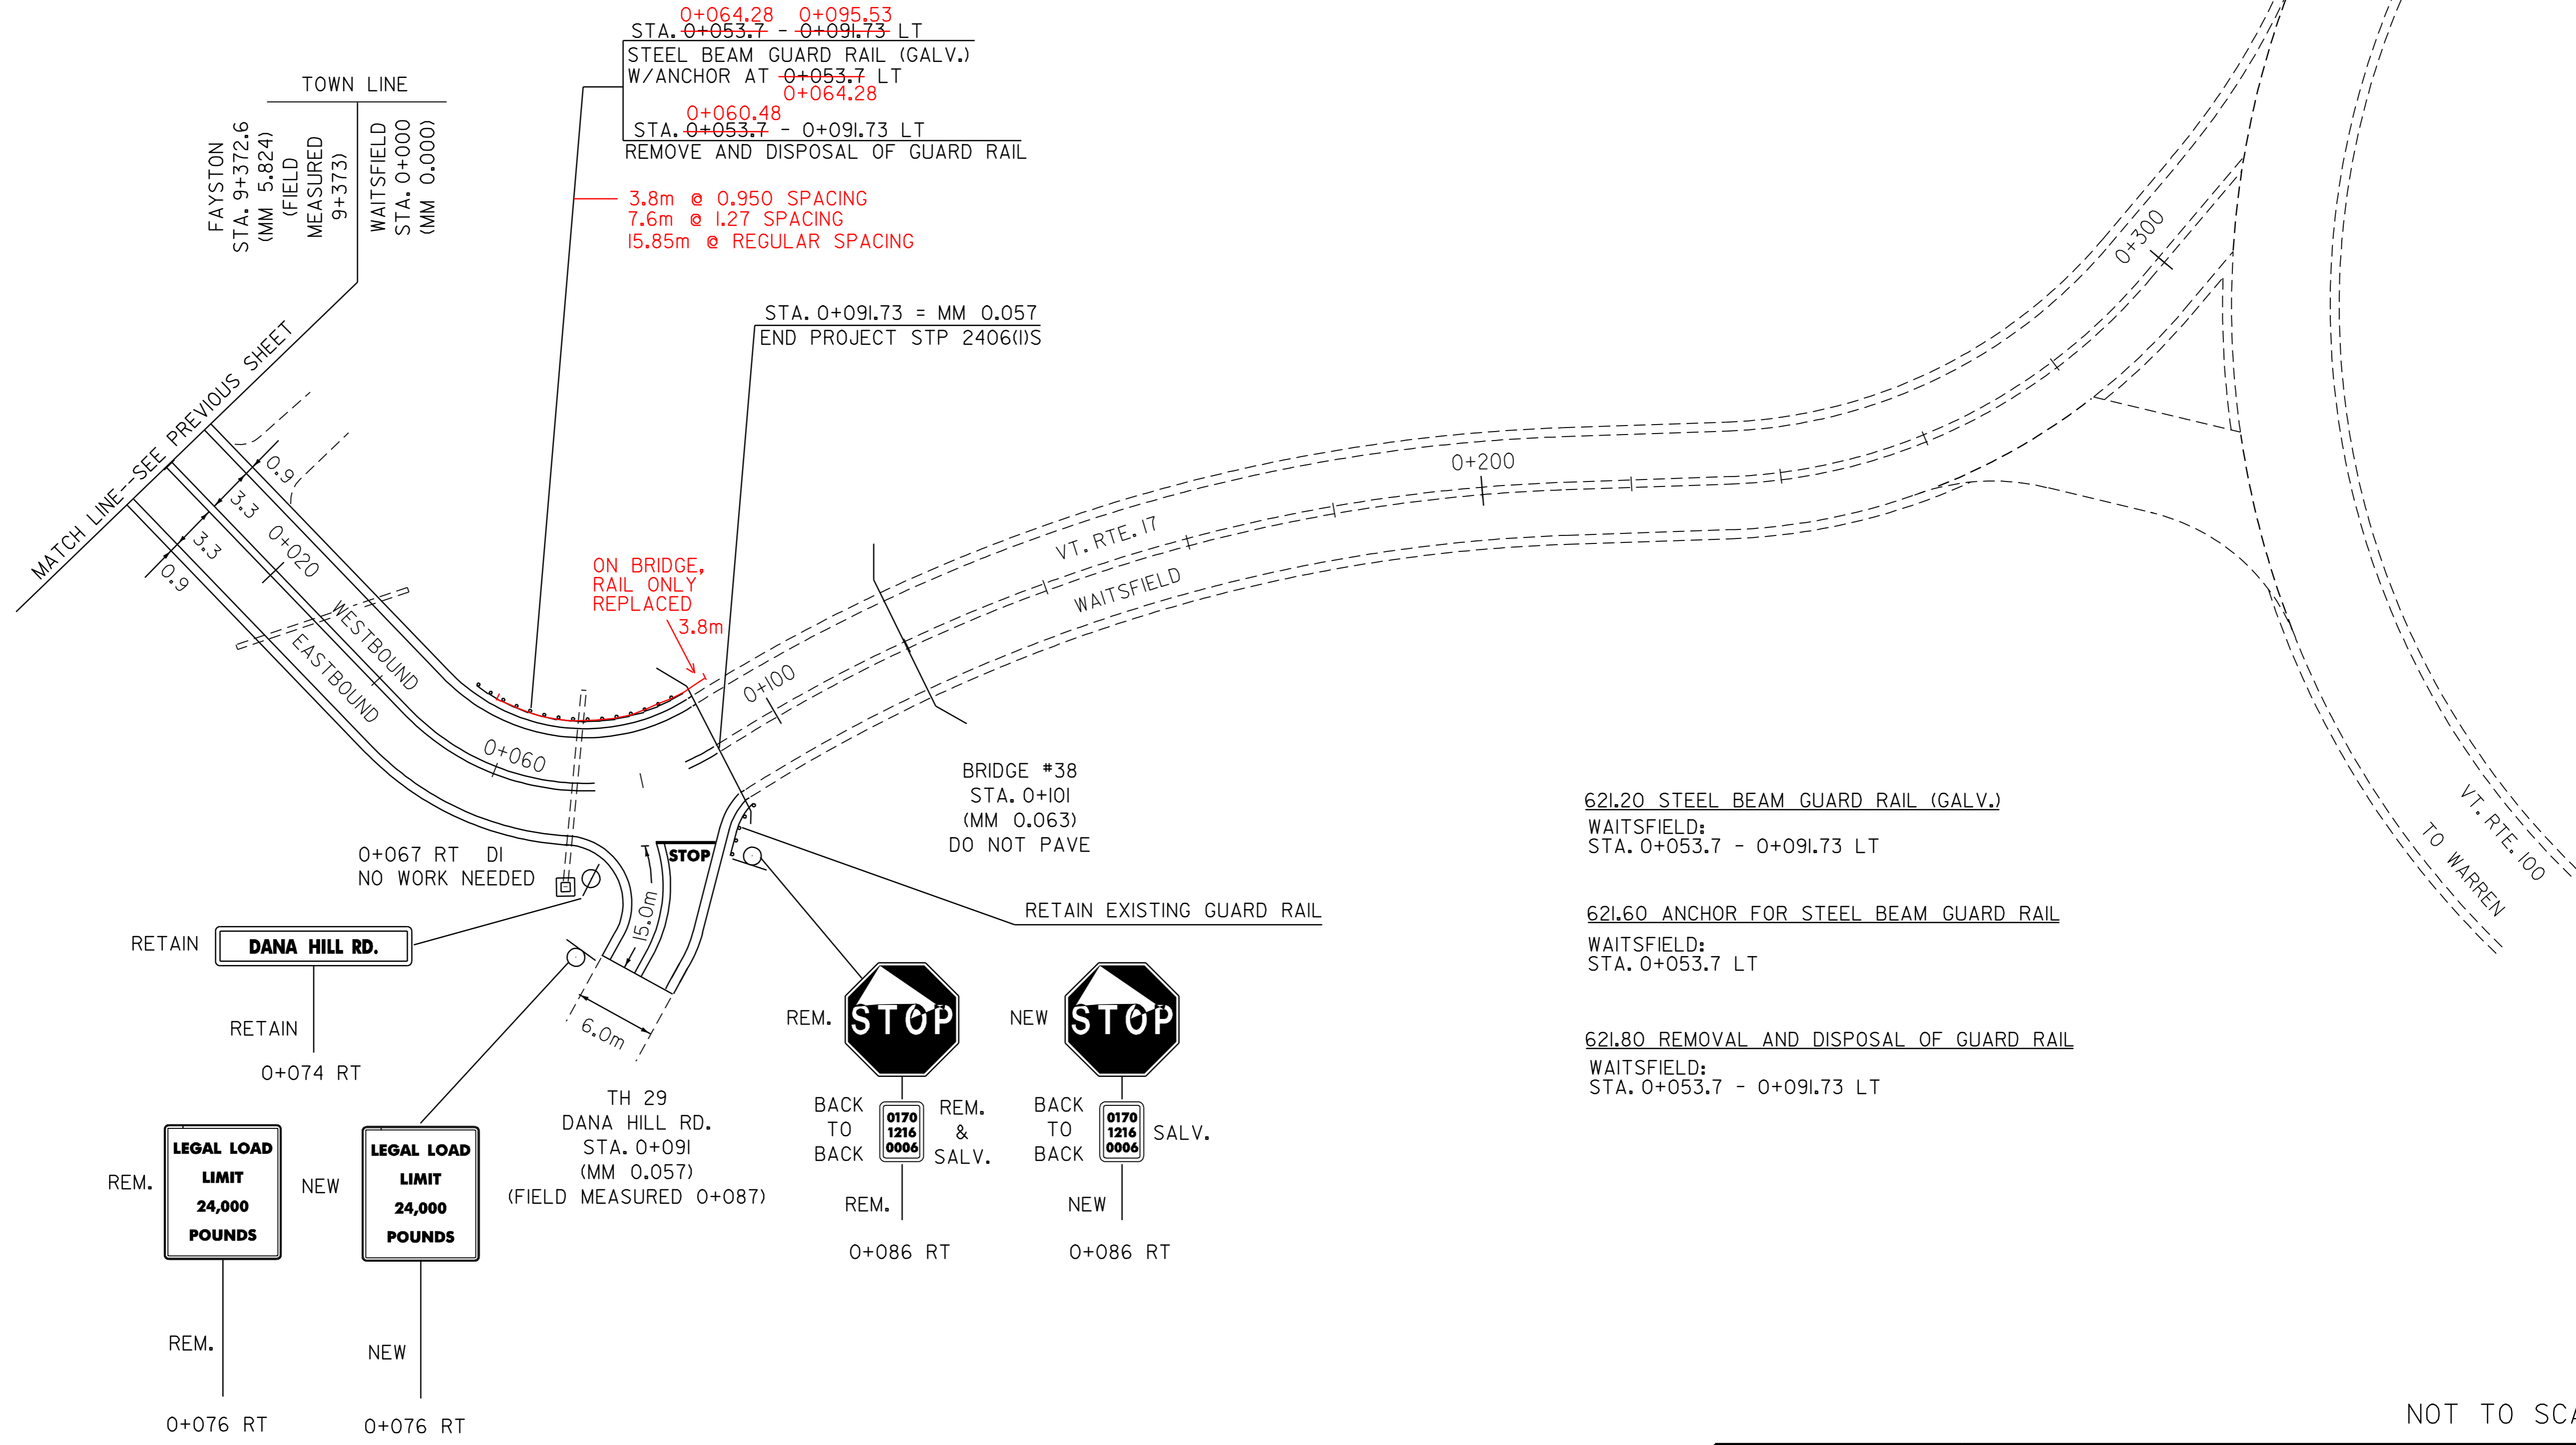

621.20 STEEL BEAM GUARD RAIL (GALV.)
WAITSFIELD:
STA. 0+053.7 - 0+091.73 LT

621.60 ANCHOR FOR STEEL BEAM GUARD RAIL
WAITSFIELD:
STA. 0+053.7 LT

621.80 REMOVAL AND DISPOSAL OF GUARD RAIL
WAITSFIELD:
STA. 0+053.7 - 0+091.73 LT

NOT TO SCALE

NOTE:
1. PAVING LIMIT ON ALL TOWN HIGHWAYS SHALL BE MEASURED 8 m BACK FROM VT. ROUTE 17 EDGE OF SHOULDER UNLESS DENOTED OTHERWISE ON THE PLANS OR AS DIRECTED BY THE RESIDENT ENGINEER.

PAVING PROJECT LAYOUT #5 VT. RTE. 17	PROJECT NAME: FAYSTON - WAITSFIELD	PLOT DATE: 23-MAY-2008 12:3
	PROJECT NUMBER: STP 2406(I)S	DRAWN BY: J. REDMOND
	FILE NAME: /pave/00b058/00b058.dgn	DESIGNED BY: J. REDMOND
	DESIGNED BY: J. REDMOND	CHECKED BY: J. REDMOND
	00b058p05.1	SHEET 16 OF 54