


SECTION	FIELD MEAS. (m)	PAY FACTOR	PAY MEAS. (m)	
(A)	27.3	1.0	27.3	8+062 - 8+089 LT
(B)	72.39	1.0	72.39	322.33 8+107 - 8+441.5 LT
(C)	15.24	1.4	21.34	
(D)	228.60	1.0	228.60	
(E)	7.6	1.0	7.6	8+045 - 8+072 RT
(F)	8.23	1.0	8.23	8+090 - 8+107 RT
			345.17m	ITEM 621.20 S.B.G.R.

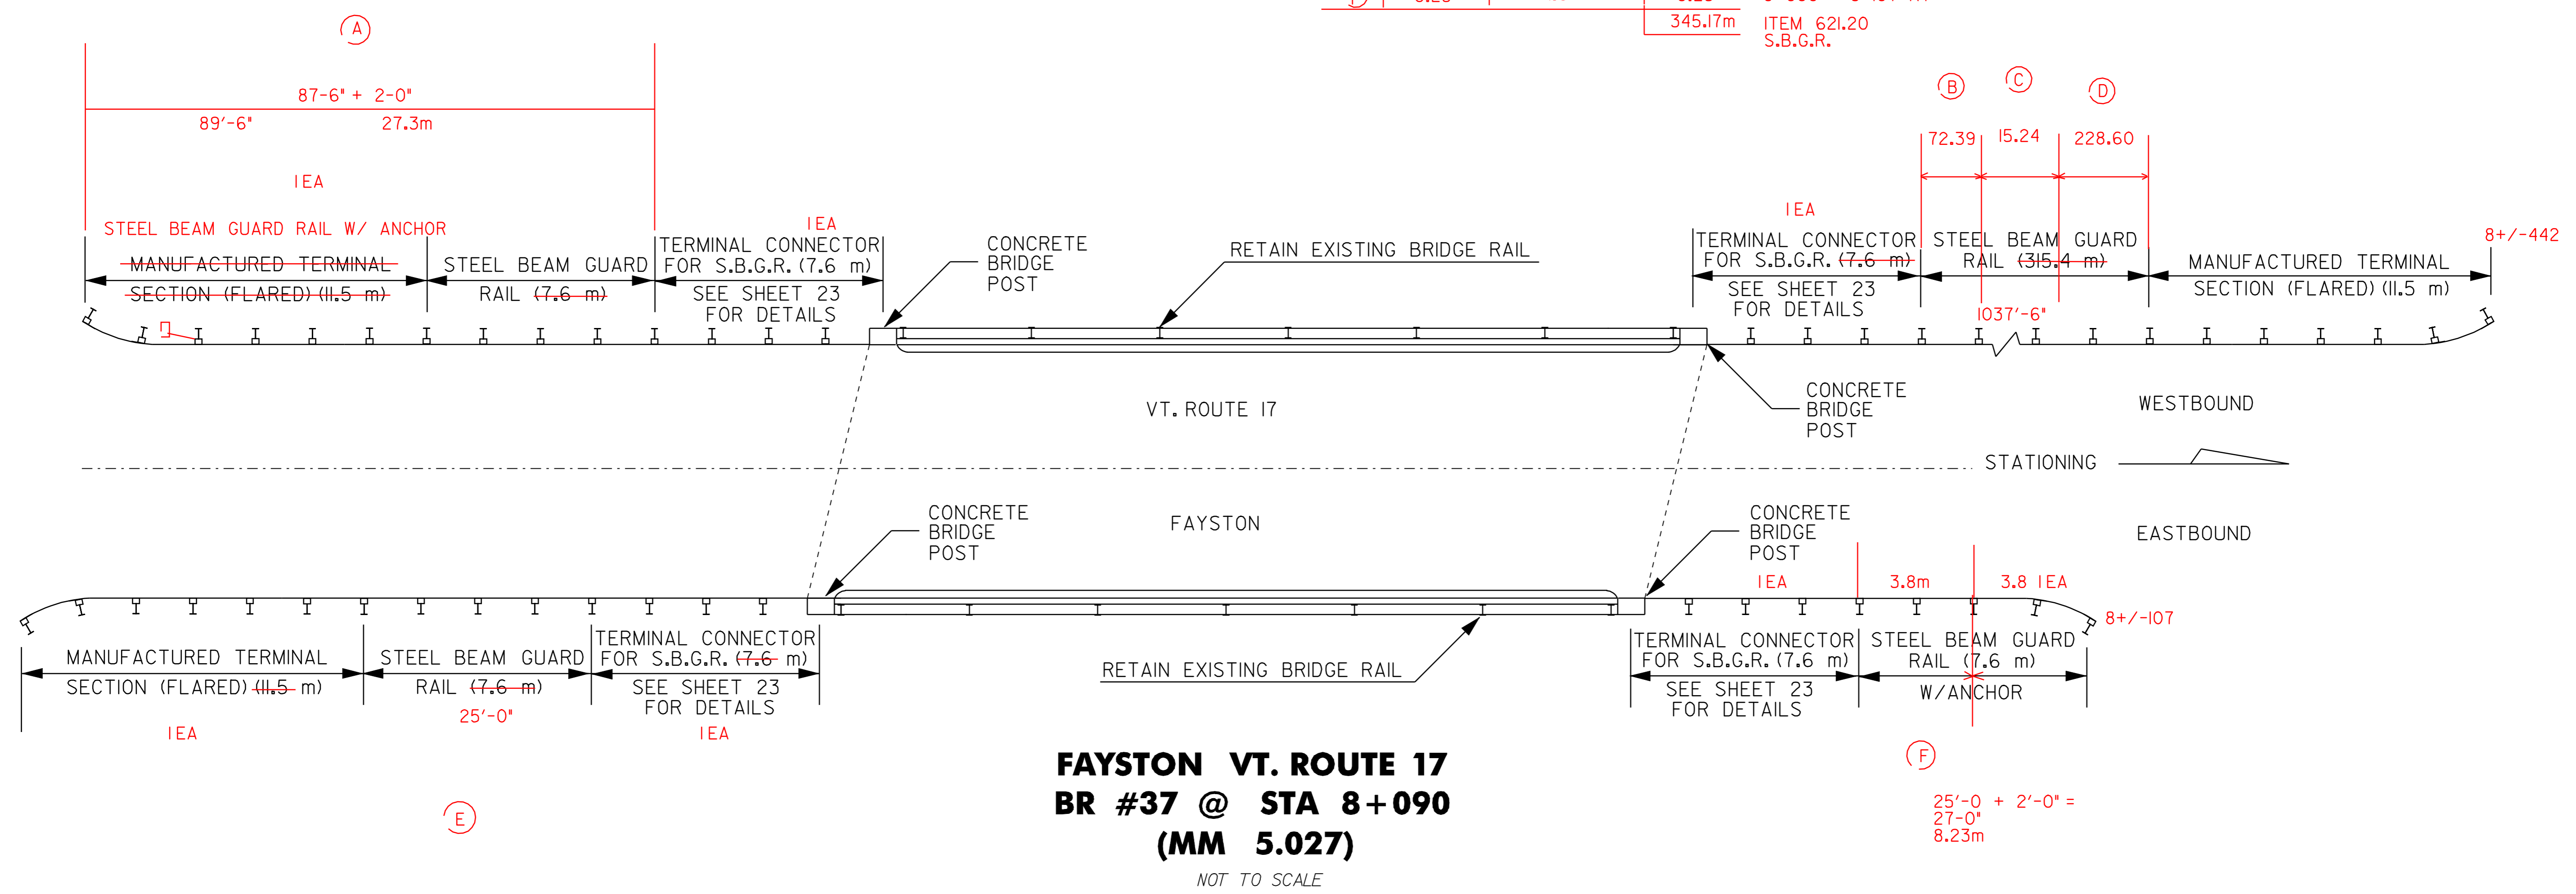

**FAYSTON VT. ROUTE 17  
BR #37 @ STA 8+090  
(MM 5.027)**  
NOT TO SCALE

I. REFER TO SHEET 7 FOR BRIDGE 37 COLD PLANE TRANSITION AND ASPHALTIC PLUG JOINT DETAILS.

NOTE: ALL DIMENSIONS IN MILLIMETERS EXCEPT AS INDICATED

DATUM \_\_\_\_\_  
VERTICAL \_\_\_\_\_  
HORIZONTAL \_\_\_\_\_

<b>BRIDGE DETAIL SHEET #3</b>	PROJECT : FAYSTON - WAITSFIELD	PROJECT NO. : STP_2406(I) S
	DESIGN FILE NAME: <u>pave/00b058/00b058.dgn</u>	
	IPARM FILE NAME: <u>00b058br3.i</u>	PLOT DATE: <u>23-MAY-2008 12:00</u>
	SURVEYED BY: <u>LFW</u>	SURVEY DATE: <u>7/05</u>
	SQUAD LEADER: <u>LFW</u>	DRAWN BY: <u>7/05</u>
		SHEET: <u>21</u> OF <u>54</u>