


SECTION	(m) FIELD MEAS.	PAY FACTOR	(m) PAY MEAS.
(A)	15.85	1.0	15.85
(B)	7.6	1.2	9.12
(C)	3.8	1.4	5.32
(D)	3.8	0.5	1.90
			32.19m

REMOVE AND DISPOSE S.B.G.R.  
0+/-060.5 - 0+/-095.5  
35.05m ITEM 621.80

ITEM 621.20  
S.B.G.R.

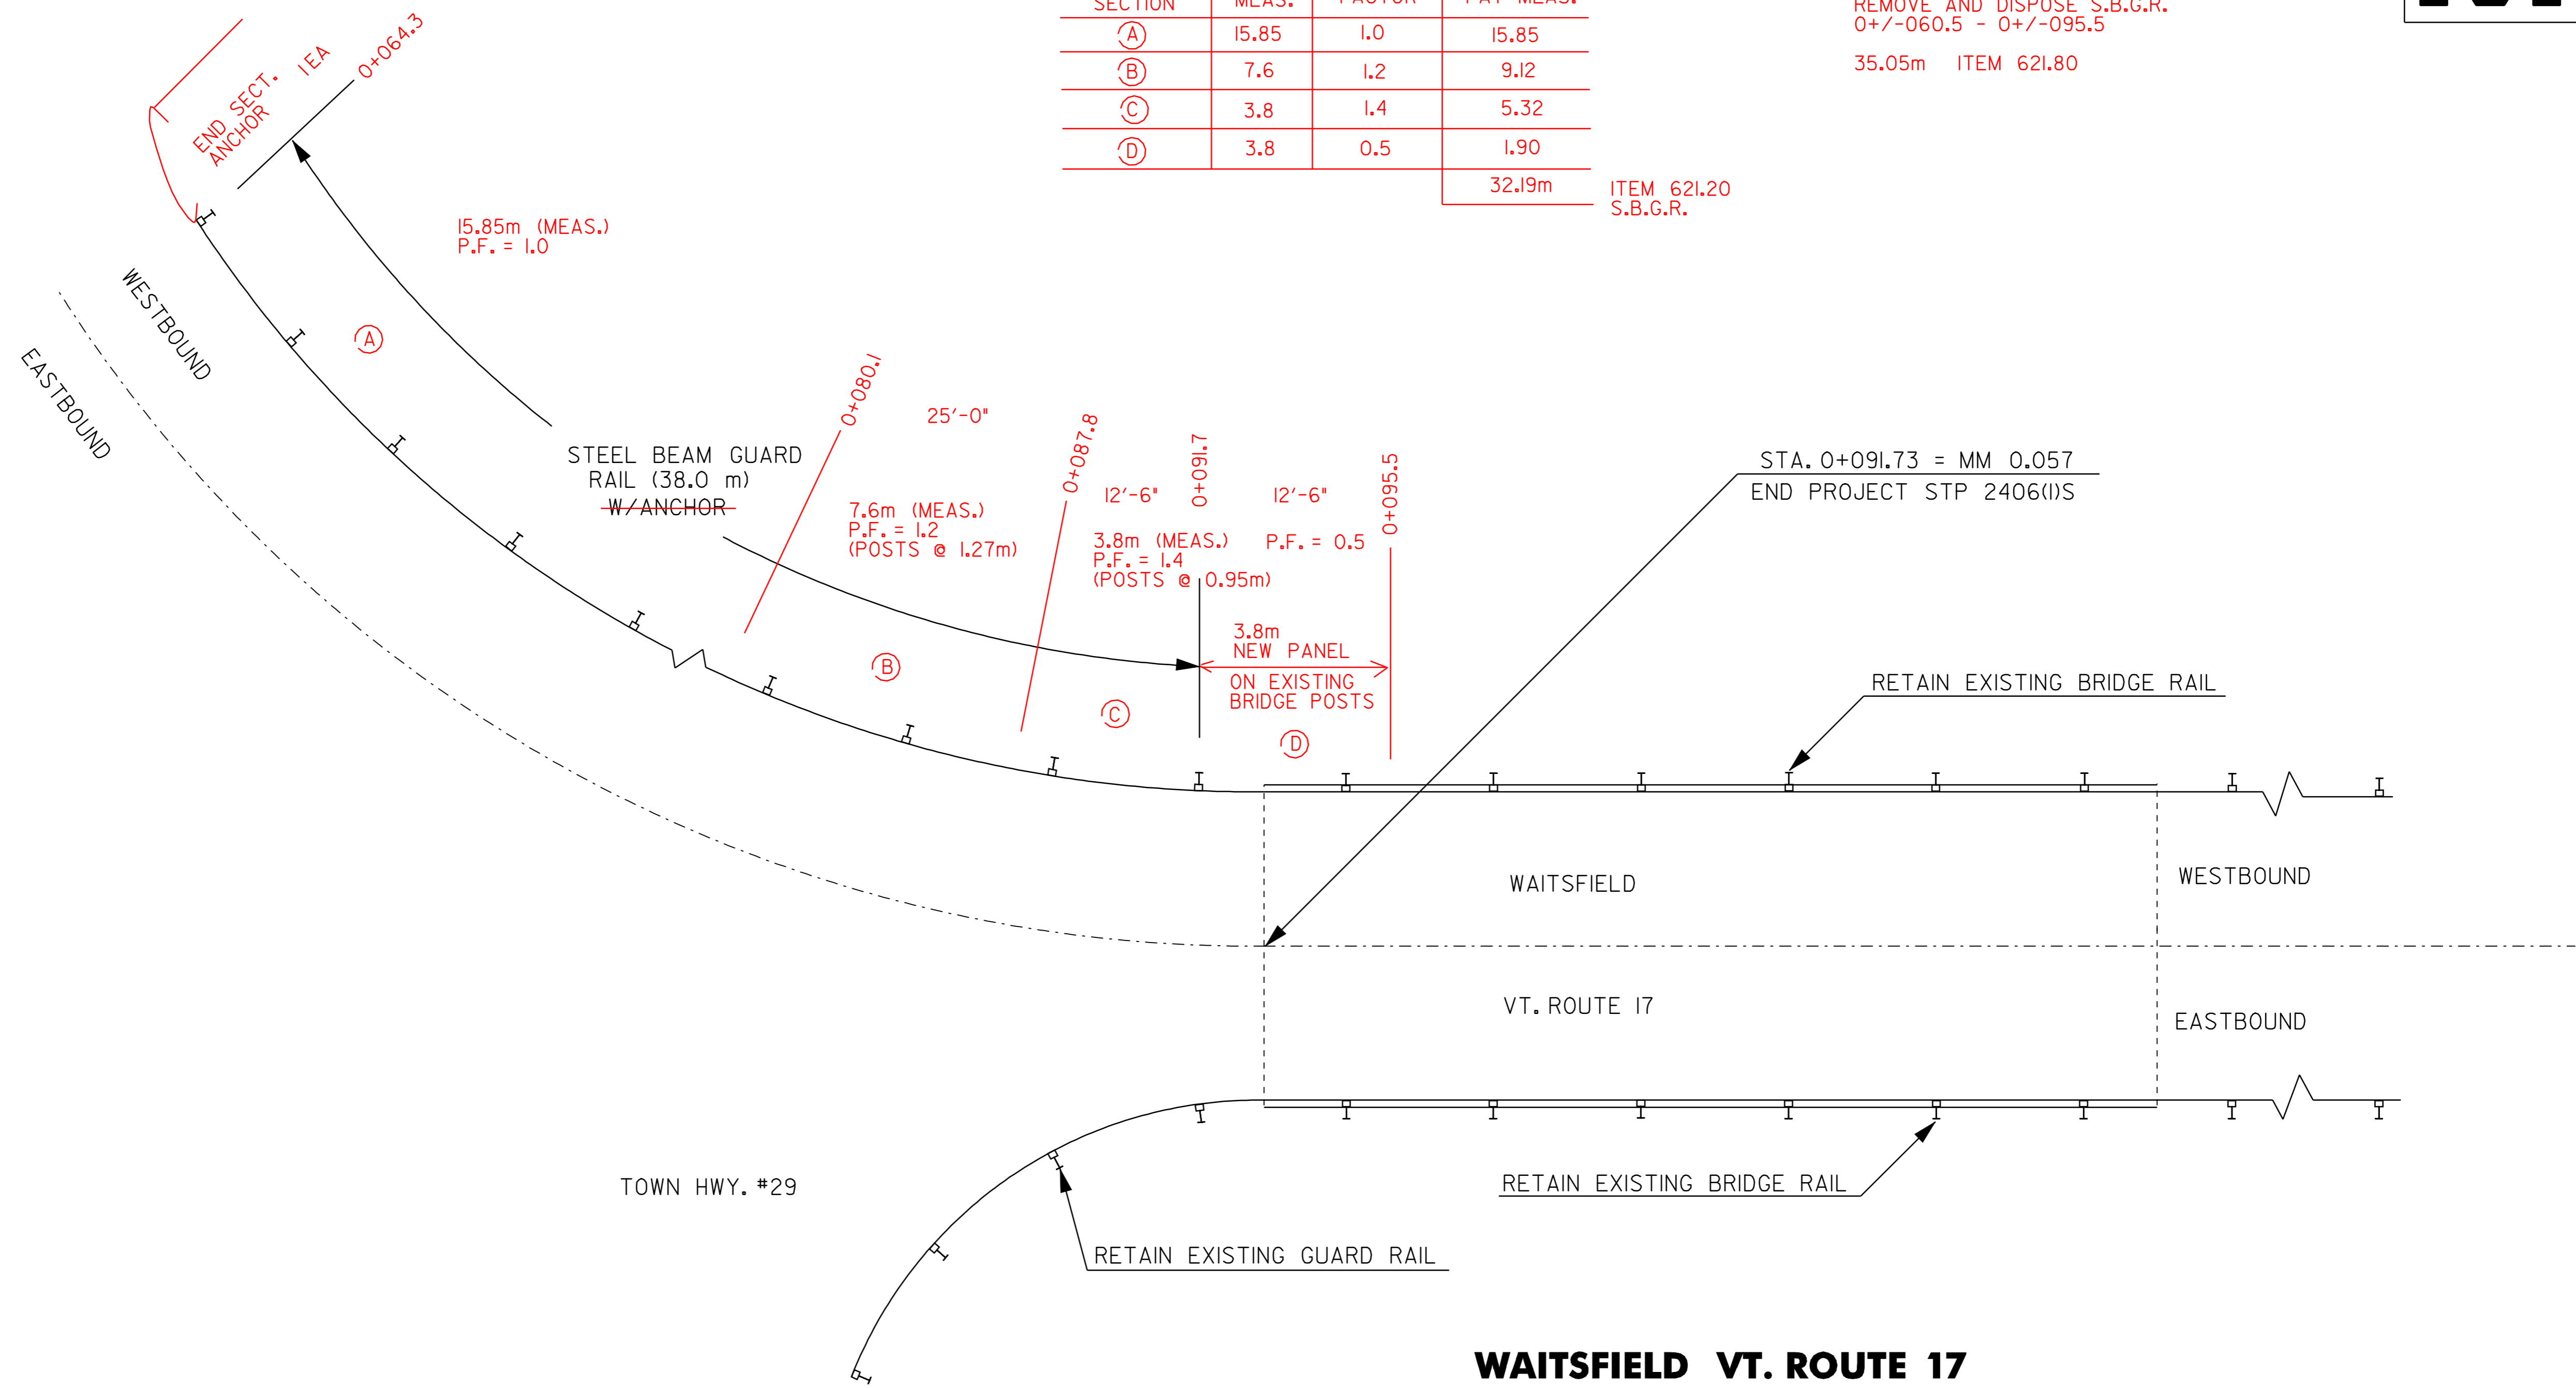

**WAITSFIELD VT. ROUTE 17  
BR #38 @ STA 0+101  
(MM 0.063)**

NOT TO SCALE

I. BRIDGE 38 REPAIRS AND PAVING ARE NOT INCLUDED WITH THIS PROJECT.

NOTE: ALL DIMENSIONS IN MILLIMETERS EXCEPT AS INDICATED

DATUM	_____
VERTICAL	_____
HORIZONTAL	_____

<b>BRIDGE DETAIL SHEET #4</b>	PROJECT :	FAYSTON - WAITSFIELD	PROJECT NO. :	STP 2406(I) S
	DESIGN FILE NAME:	pave/00b058/00b058.dgn	PLOT DATE:	23-MAY-2008
	IPARM FILE NAME:	00b058br4.i	SURVEY DATE:	7/05
	SURVEYED BY:	LFW	DRAWN BY:	7/05
	SQUAD LEADER:	LFW	SHEET:	22 OF 54