

646.40 DURABLE 100 mm WHITE LINE (THERMOPLASTIC)  
 (ALL LINES WILL INCLUDE EDGE LINE BREAKS AND RADIUS FOR TOWN HIGHWAYS)

WAITSFIELD:  
 STA. 6+800 - STA. 7+400 LT & RT

646.60 TEMPORARY 100 mm WHITE LINE (PAINT)  
 (ALL LINES WILL INCLUDE EDGE LINE BREAKS AND RADIUS FOR TOWN HIGHWAYS)

WAITSFIELD:  
 STA. 6+800 - STA. 7+400 LT & RT

646.41 DURABLE 100 mm YELLOW LINE (THERMOPLASTIC)  
 (ALL LINES WILL INCLUDE C/L BREAKS FOR TOWN HIGHWAYS) S=SOLID, D=DASHED

WAITSFIELD:  
 STA. 6+800 - STA. 7+400 LT S C RT S

646.61 TEMPORARY 100 mm YELLOW LINE (PAINT)  
 (ALL LINES WILL INCLUDE C/L BREAKS FOR TOWN HIGHWAYS) S=SOLID, D=DASHED

WAITSFIELD:  
 STA. 6+800 - STA. 7+400 LT S C RT S

619.17 YIELDING MARKER POSTS


WAITSFIELD:  
 STA. 7+155 LT & RT (2)  
 STA. 7+296 RT (1)  
 STA. 7+303 LT (1)

DITCHING LOCATION

WAITSFIELD:  
 STA. 7+176 - 7+240 RT  
 STA. 7+176 - 7+279 LT  
 STA. 7+303 - 7+400 LT

STA. 6+800  
 (MM 4.225)


STA. 7+100  
 (MM 4.412)

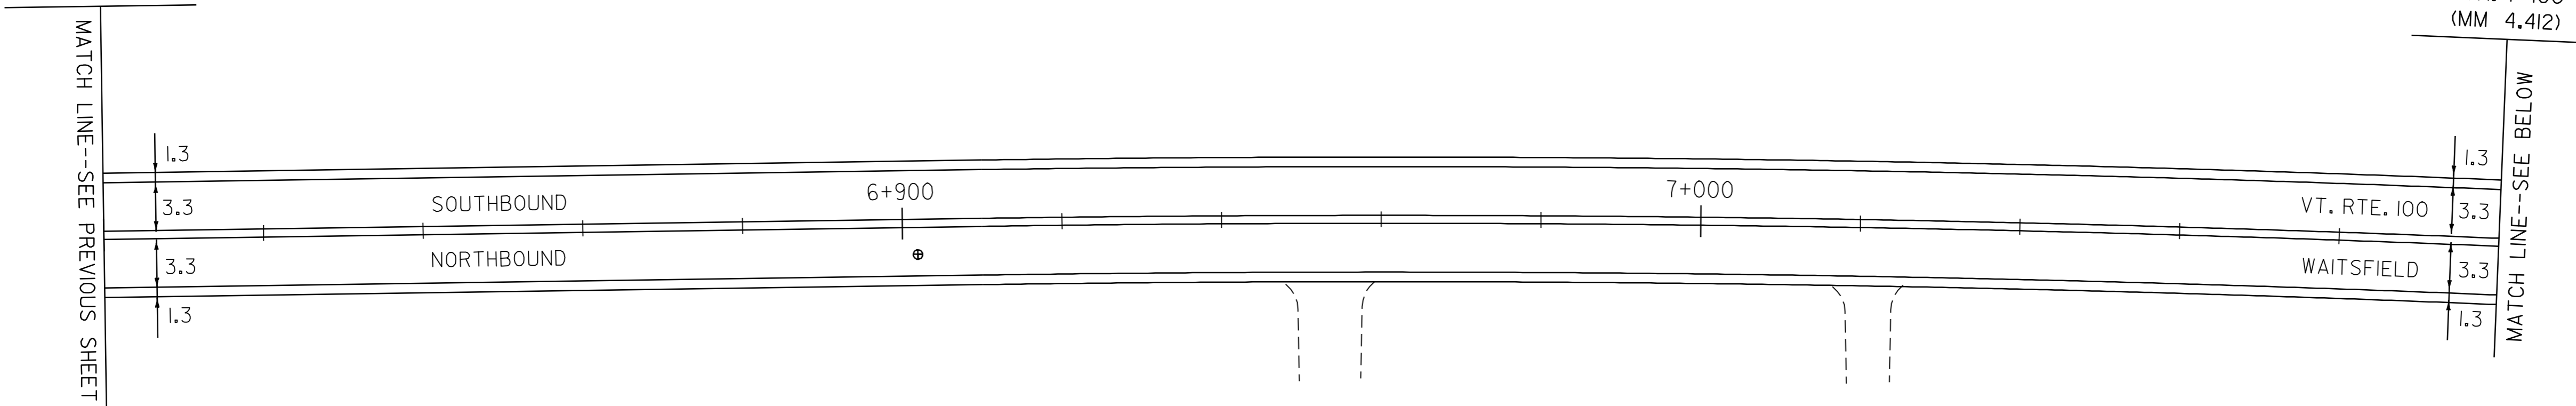

**CURVE #1**  
 PC FIELD STA. 7+135  
 PT FIELD STA. 7+485  
 $\Delta$  8°30' RT  
 T=175m  
 R=2355m  
 SUPERELEVATION=NC  
 RUNOFF=N/A  
 RUNOUT=N/A  
 V=80km/hr (50 m.p.h.)  
 SEE SHEET 50 FOR BANKING DETAIL

STA. 7+100  
 (MM 4.412)

STA. 7+400  
 (MM 4.598)

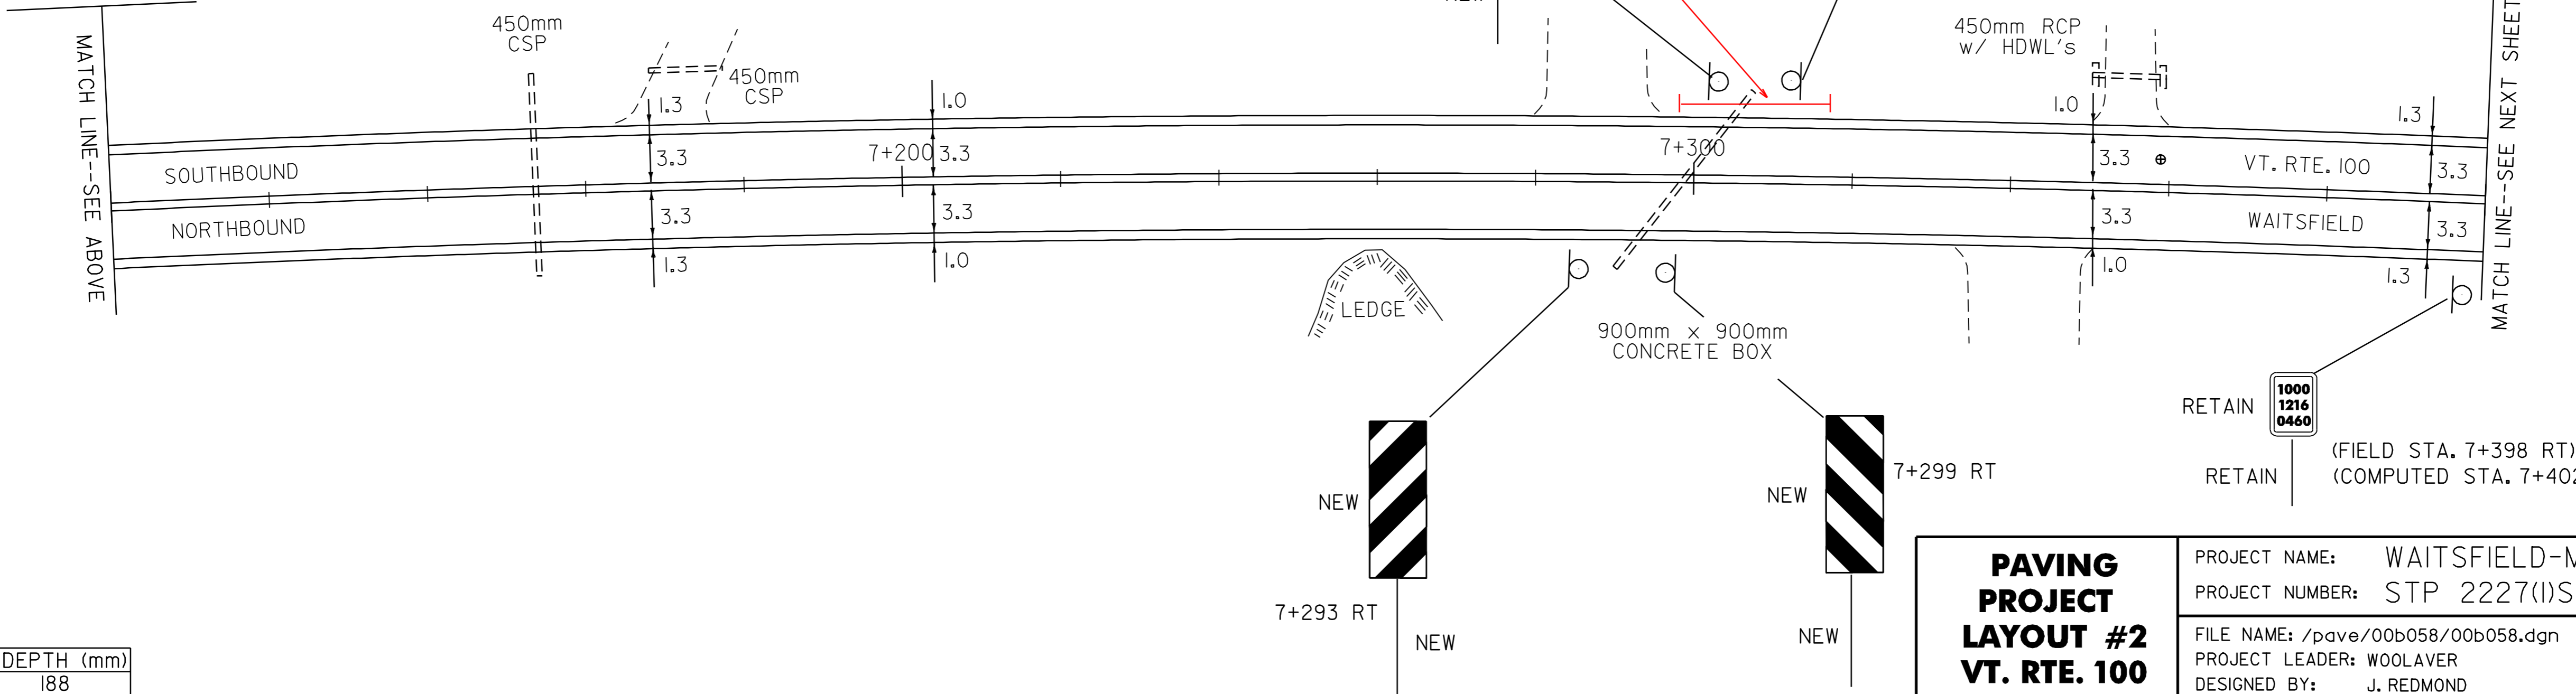

NOT TO SCALE

CORE NO.	LOCATION	DEPTH (mm)
1	6+902 RT	188
6	7+358 LT	175

<b>PAVING          PROJECT          LAYOUT #2          VT. RTE. 100</b>	PROJECT NAME: WAITSFIELD-MORETOWN	PLOT DATE: 23-MAY-2008 12:5
	PROJECT NUMBER: STP 2227(1)S	DRAWN BY: J. REDMOND
	FILE NAME: /pave/00b058/00b058.dgn	CHECKED BY: J. REDMOND
	DESIGNED BY: J. REDMOND	SHEET 32 OF 54