

646.40 DURABLE 100 mm WHITE LINE (THERMOPLASTIC)
 (ALL LINES WILL INCLUDE EDGE LINE BREAKS AND RADIUS FOR TOWN HIGHWAYS)
 WAITSFIELD:
 STA. 8+000 - STA. 8+600 LT & RT

646.41 DURABLE 100 mm YELLOW LINE (THERMOPLASTIC)
 (ALL LINES WILL INCLUDE C/L BREAKS FOR TOWN HIGHWAYS) S=SOLID, D=DASHED
 WAITSFIELD:
 STA. 8+000 - STA. 8+600 LT S C RT S
 STA. 8+450 DOUBLE SOLID LT, T-7

646.46 DURABLE 600 mm STOP BAR (THERMOPLASTIC)
 WAITSFIELD:
 STA. 8+450 LT, T-7
646.66 TEMPORARY 600 mm STOP BAR (PAINT)
 WAITSFIELD:
 STA. 8+450 LT, T-7

604.412 REHABILITATION OF DI, CB OR MH
 WAITSFIELD:
 STA. 8+280 LT (THROATED)
 STA. 8+378 LT (THROATED)
 STA. 8+598 LT (THROATED)

619.17 YIELDING MARKER POSTS
 WAITSFIELD:
 STA. 8+280 LT & RT (2)
 STA. 8+378 LT & RT (2)
 STA. 8+598 LT (1)

646.60 TEMPORARY 100 mm WHITE LINE (PAINT)
 (ALL LINES WILL INCLUDE EDGE LINE BREAKS AND RADIUS FOR TOWN HIGHWAYS)
 WAITSFIELD:
 STA. 8+000 - STA. 8+600 LT & RT


646.61 TEMPORARY 100 mm YELLOW LINE (PAINT)
 (ALL LINES WILL INCLUDE C/L BREAKS FOR TOWN HIGHWAYS) S=SOLID, D=DASHED
 WAITSFIELD:
 STA. 8+000 - STA. 8+600 LT S C RT S
 STA. 8+450 DOUBLE SOLID LT, T-7

646.50 DURABLE LETTER OR SYMBOL (THERMOPLASTIC)
 WAITSFIELD:
 STA. 8+450 LT, T-7, "S,T,O,P" (4 EA)



DITCHING LOCATION
 WAITSFIELD:
 STA. 8+222 - 8+438 LT
 STA. 8+580 - 8+600 LT

646.70 TEMPORARY LETTER OR SYMBOL (PAINT)
 WAITSFIELD:
 STA. 8+450 LT, T-7, "S,T,O,P" (4 EA)

REMOVING SIGNS
 3 AS SHOWN

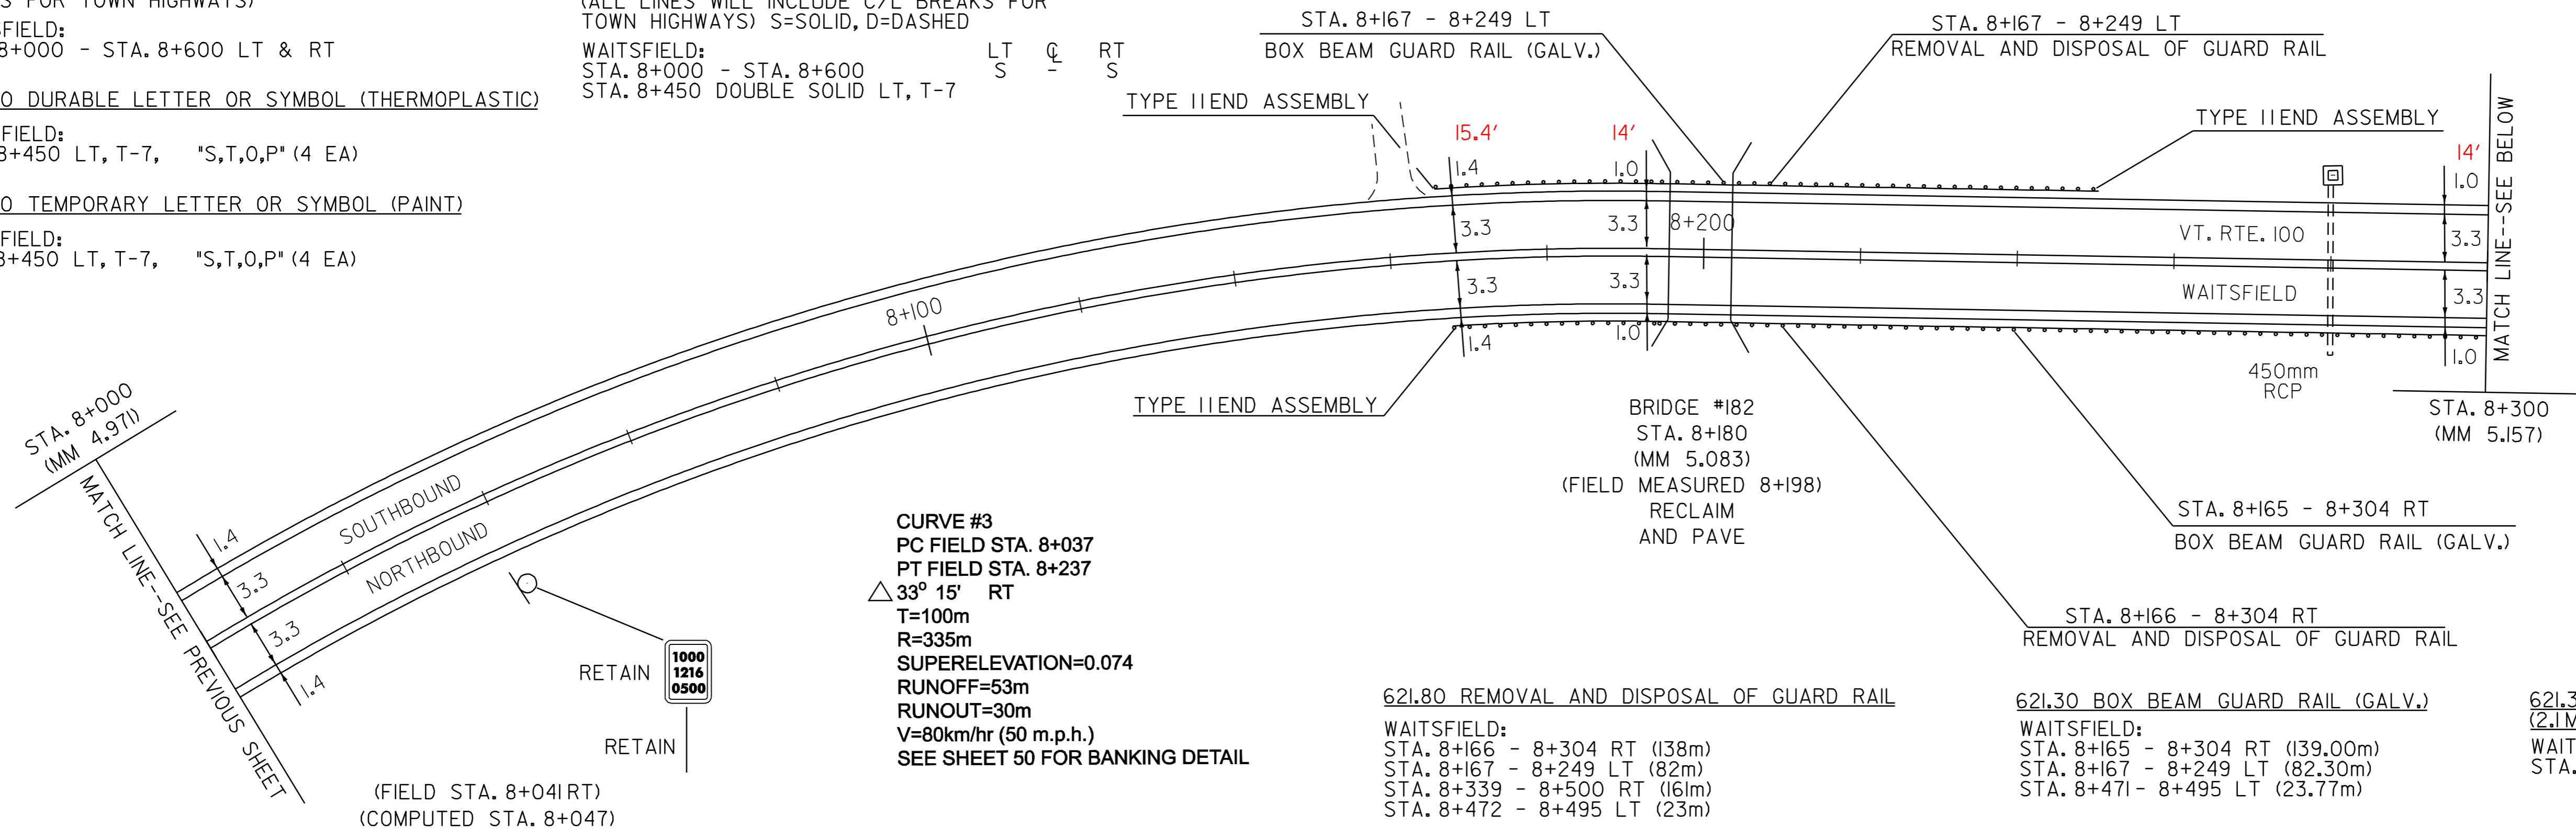

CURVE #4
 PC FIELD STA. 8+340
 PT FIELD STA. 8+460
 $\Delta 9^\circ 00'$ LT
 T=60m
 R=762m
 SUPERELEVATION=0.043
 RUNOFF=32m
 RUNOUT=30m
 V=80km/hr (50 m.p.h.)
 SEE SHEET 50 FOR BANKING DETAIL

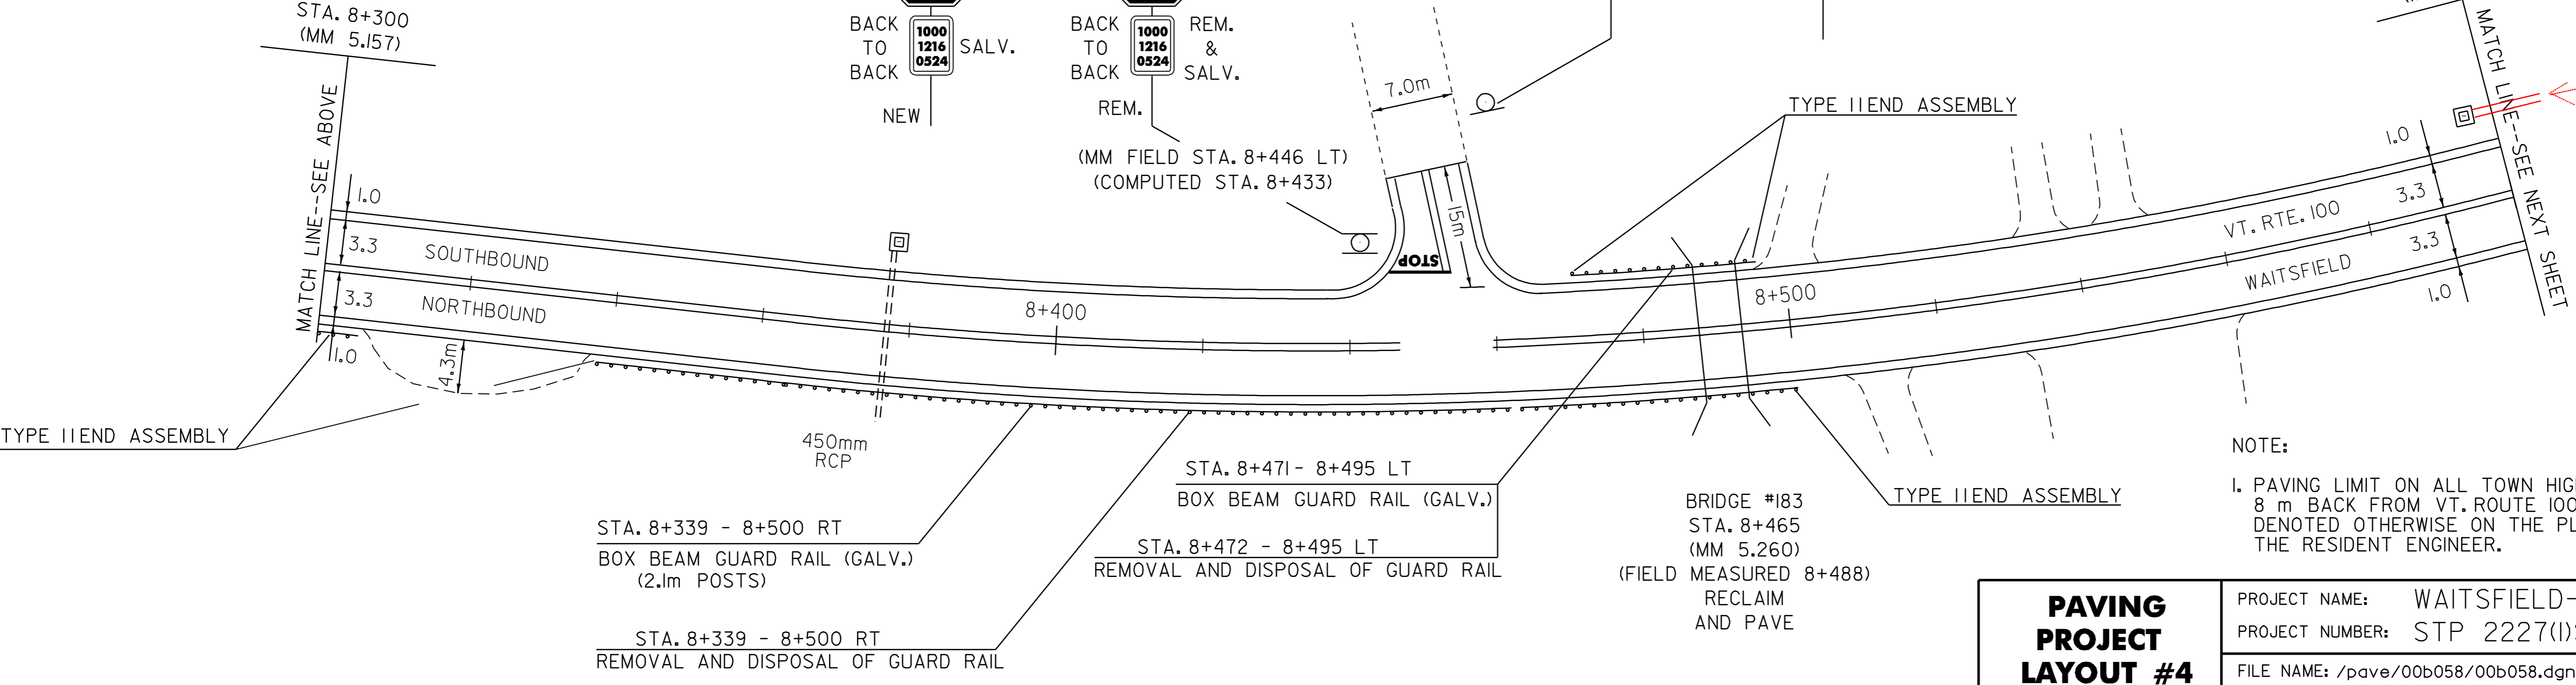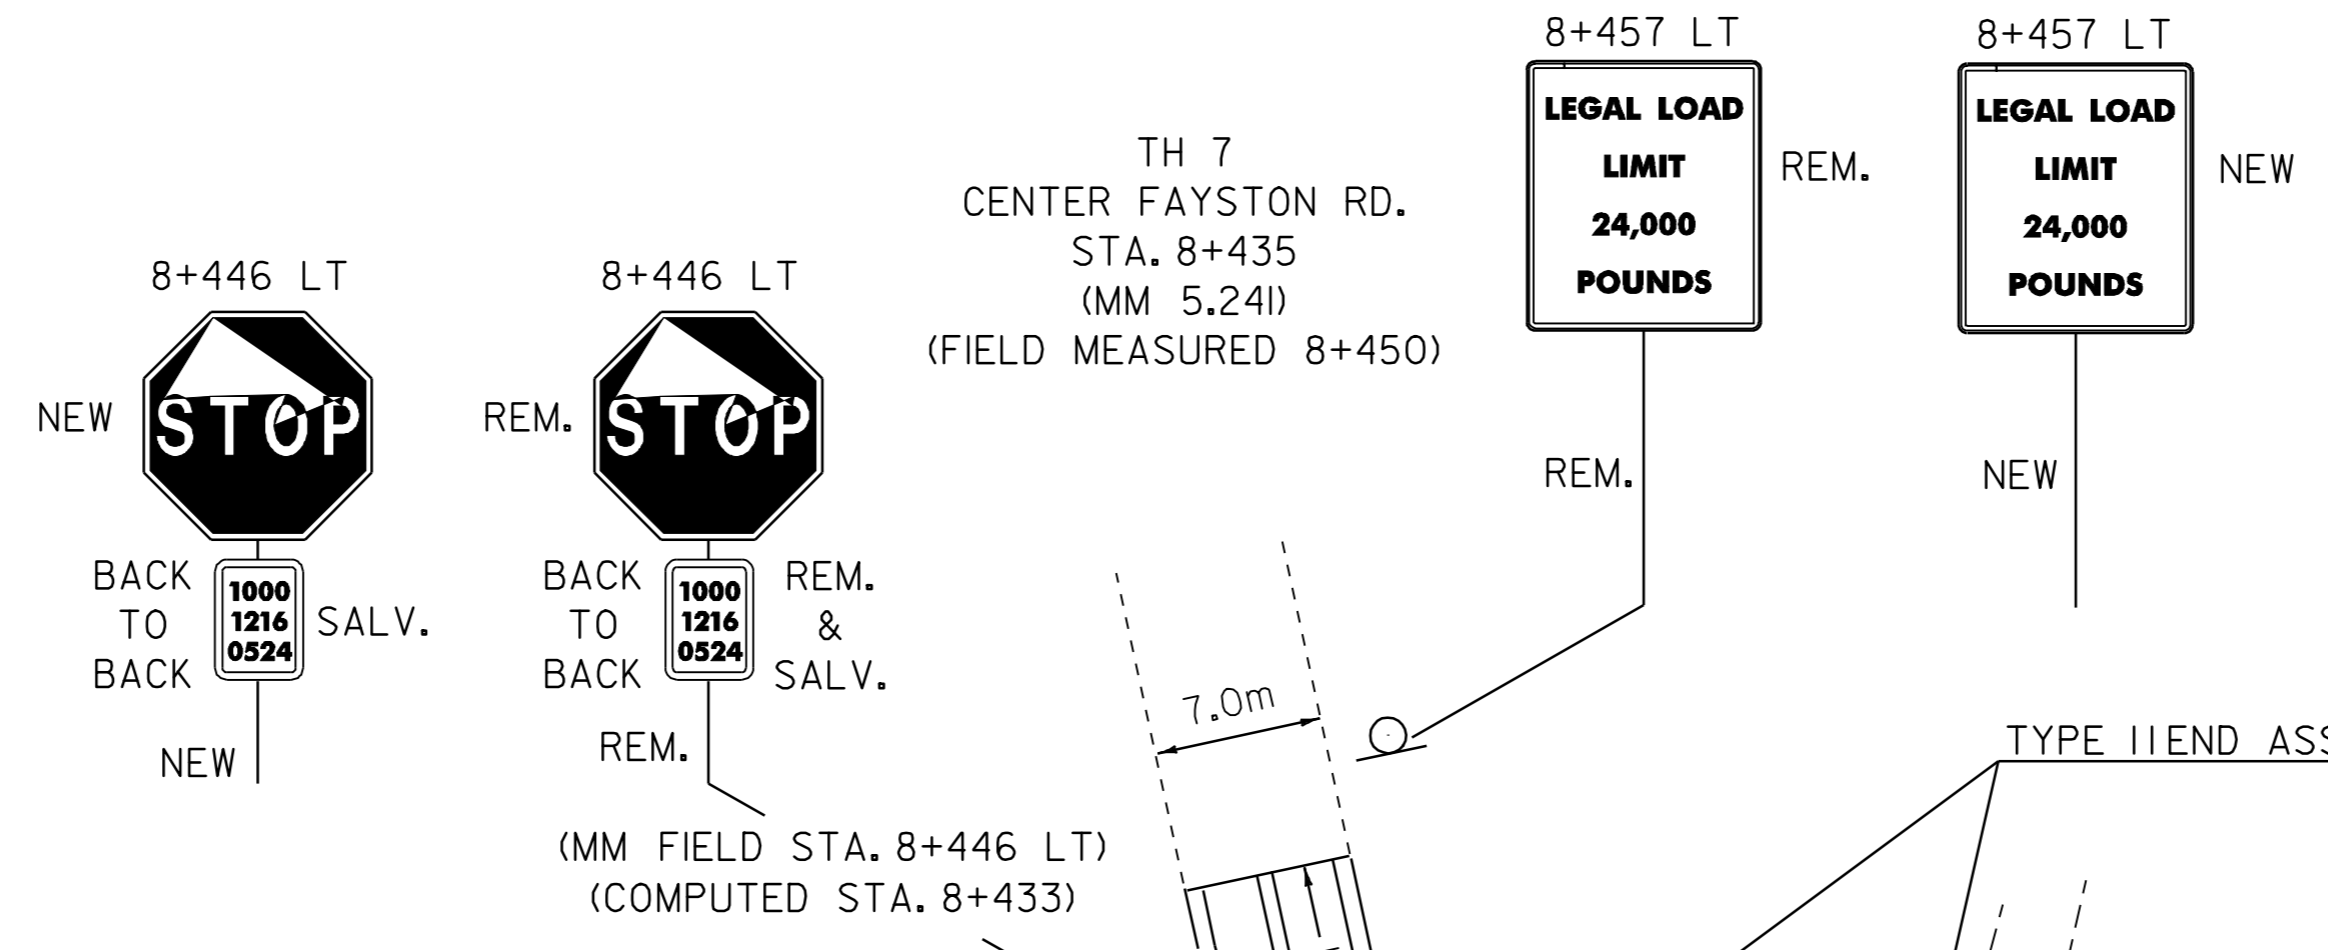

PAVING PROJECT LAYOUT #4 VT. RTE. 100

PROJECT NAME: WAITSFIELD-MORETOWN
 PROJECT NUMBER: STP 2227(1)S
 FILE NAME: /pave/00b058/00b058.dgn
 PROJECT LEADER: WOOLAVER
 DESIGNED BY: J. REDMOND
 00b058104.1
 PLOT DATE: 23-MAY-2008 12:30
 DRAWN BY: J. REDMOND
 CHECKED BY: J. REDMOND
 SHEET 34 OF 54

NOT TO SCALE