

646.40 DURABLE 100 mm WHITE LINE (THERMOPLASTIC)  
 (ALL LINES WILL INCLUDE EDGE LINE BREAKS AND RADIUS FOR TOWN HIGHWAYS)

WAITSFIELD:  
 STA. 9+200 - STA. 9+800 LT & RT

646.60 TEMPORARY 100 mm WHITE LINE (PAINT)  
 (ALL LINES WILL INCLUDE EDGE LINE BREAKS AND RADIUS FOR TOWN HIGHWAYS)

WAITSFIELD:  
 STA. 9+200 - STA. 9+800 LT & RT

646.41 DURABLE 100 mm YELLOW LINE (THERMOPLASTIC)  
 (ALL LINES WILL INCLUDE C/L BREAKS FOR TOWN HIGHWAYS) S=SOLID, D=DASHED

WAITSFIELD:  
 STA. 9+200 - STA. 9+607 LT S C RT S D  
 STA. 9+607 - STA. 9+784 S S D  
 STA. 9+784 - STA. 9+800 S D S  
 STA. 9+227 DOUBLE SOLID LT, T-47

646.61 TEMPORARY 100 mm YELLOW LINE (PAINT)  
 (ALL LINES WILL INCLUDE C/L BREAKS FOR TOWN HIGHWAYS) S=SOLID, D=DASHED

WAITSFIELD:  
 STA. 9+200 - STA. 9+607 LT S C RT S D  
 STA. 9+607 - STA. 9+784 S S D  
 STA. 9+784 - STA. 9+800 S D S  
 STA. 9+227 DOUBLE SOLID LT, T-47

646.46 DURABLE 600 mm STOP BAR (THERMOPLASTIC)

WAITSFIELD:  
 STA. 9+227 LT, T-47

646.66 TEMPORARY 600 mm STOP BAR (PAINT)

WAITSFIELD:  
 STA. 9+227 LT, T-47

646.50 DURABLE LETTER OR SYMBOL (THERMOPLASTIC)

WAITSFIELD:  
 STA. 9+227 LT, T-47, "S,T,O,P" (4 EA)

646.70 TEMPORARY LETTER OR SYMBOL (PAINT)

WAITSFIELD:  
 STA. 9+227 LT, T-47, "S,T,O,P" (4 EA)

REMOVING SIGNS

3 AS SHOWN


619.17 YIELDING MARKER POSTS

WAITSFIELD:  
 STA. 9+740 LT & RT (2)

DITCHING LOCATION


WAITSFIELD:  
 STA. 9+200 - 9+214 LT

TH 47  
 FARNSWORTH RD.  
 STA. 9+194  
 (MM 5.713)  
 (FIELD MEASURED 9+227)

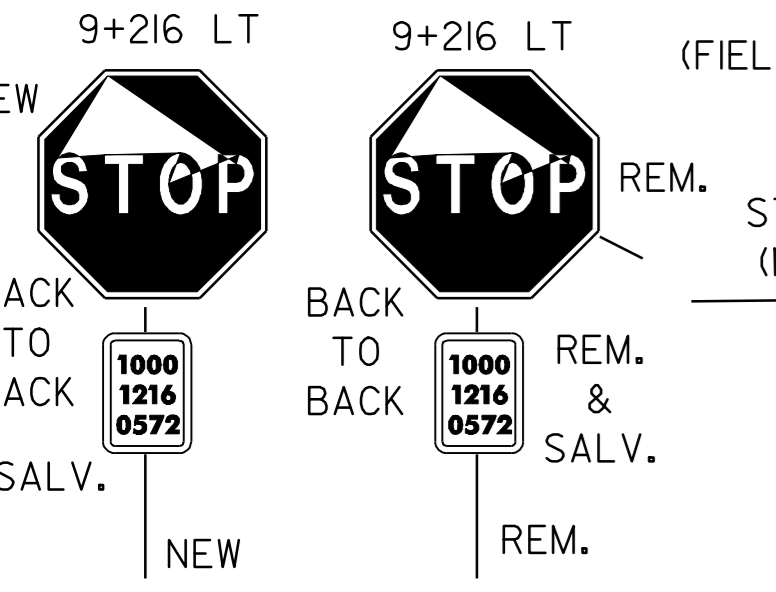

9+216 LT  
 (MM FIELD STA. 9+216 LT)  
 (COMPUTED STA. 9+205)

STA. 9+200.0 - 9+238.0 RT  
 BOX BEAM GUARD RAIL (GALV.)  
 (2.1m POSTS)

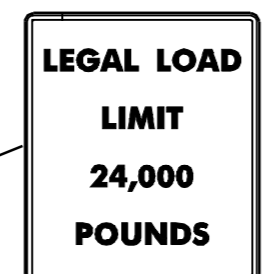

621.80 REMOVAL AND DISPOSAL OF GUARD RAIL

WAITSFIELD:  
 STA. 9+323 - 9+429 RT (106m)  
 STA. 9+336 - 9+359 LT (23m)  
 STA. 9+438 - 9+720 RT (57m)  
 STA. 9+526 - 9+720 RT (194m)

**CURVE #7**  
 PC FIELD STA. 9+346  
 PT FIELD STA. 9+646  
 38° 45' LT  
 T=150m  
 R=427m  
 SUPERELEVATION=0.064  
 RUNOFF=46m  
 RUNOUT=30m  
 V=80km/hr (50 m.p.h.)  
 SEE SHEET 51 FOR BANKING DETAIL

621.30 BOX BEAM GUARD RAIL (GALV.)


WAITSFIELD:  
 STA. 9+323.0 - 9+429.0 RT (106.07m)  
 STA. 9+438.0 - 9+495.0 RT (56.69m)  
 STA. 9+526.0 - 9+720.0 RT (193.85m)

621.30 BOX BEAM GUARD RAIL (GALV.)  
 (2.1METER POSTS)

WAITSFIELD:  
 STA. 9+200.0 - 9+238.0 RT (38.0m)

621.30 BOX BEAM GUARD RAIL (GALV.) (MOD. 3)

WAITSFIELD:  
 STA. 9+335.0 - 9+359.0 LT (23.98m)

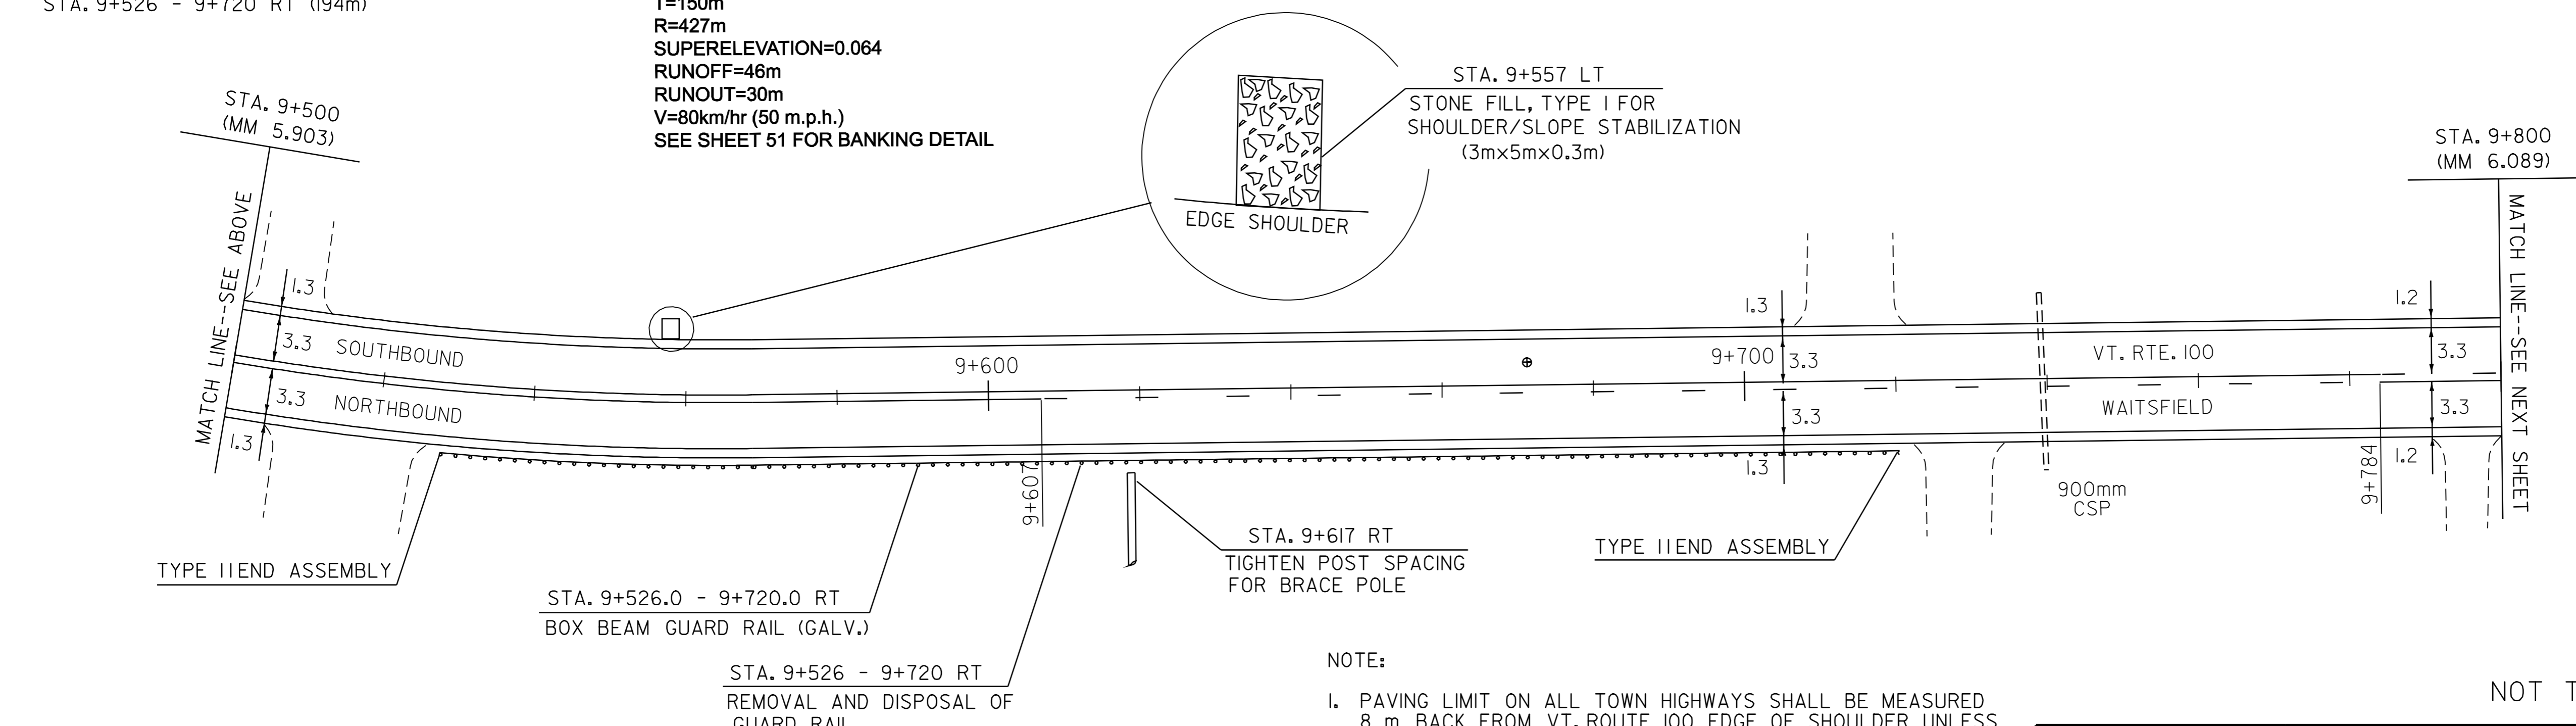

NOTE:

- PAVING LIMIT ON ALL TOWN HIGHWAYS SHALL BE MEASURED 8 m BACK FROM VT. ROUTE 100 EDGE OF SHOULDER UNLESS DENOTED OTHERWISE ON THE PLANS OR AS DIRECTED BY THE RESIDENT ENGINEER.
- REFER TO SHEETS 45 AND 48 FOR DETAILS OF BOX BEAM GUARDRAIL (GALVANIZED) (MOD. 3) ON BRIDGE # 185.
- REFER TO SHEET 49 FOR DETAILS OF BOX BEAM GUARDRAIL POST SPACING AT NON-YIELDING OBJECTS.

NOT TO SCALE

**PAVING PROJECT LAYOUT #6 VT. RTE. 100**

PROJECT NAME:	WAITSFIELD-MORETOWN
PROJECT NUMBER:	STP 2227(1)S
FILE NAME:	/pave/00b058/00b058.dgn
PROJECT LEADER:	WOOLAVER
DESIGNED BY:	J. REDMOND
PLOT DATE:	23-MAY-2008 12:3
DRAWN BY:	J. REDMOND
CHECKED BY:	J. REDMOND
SHEET	36 OF 54

CORE NO.	LOCATION	DEPTH (mm)
3	9+288 RT	175
5	9+672 LT	163