

646.40 DURABLE 100 mm WHITE LINE (THERMOPLASTIC)  
 (ALL LINES WILL INCLUDE EDGE LINE BREAKS AND RADIUS FOR TOWN HIGHWAYS)  
 WAITSFIELD:  
 STA. 9+800 - STA. 10+400 LT & RT

646.41 DURABLE 100 mm YELLOW LINE (THERMOPLASTIC)  
 (ALL LINES WILL INCLUDE C/L BREAKS FOR TOWN HIGHWAYS) S=SOLID, D=DASHED  
 WAITSFIELD:  
 STA. 9+800 - STA. 10+018 LT D S  
 STA. 10+018 - STA. 10+400 S S

604.412 REHABILITATION OF DI, CB OR MH  
 WAITSFIELD:  
 STA. 10+007 LT (THROATED)  
 STA. 10+226 LT (THROATED)  
 STA. 10+393 LT (ROUND)


619.17 YIELDING MARKER POSTS  
 WAITSFIELD:  
 STA. 9+875 LT & RT (2)  
 STA. 10+007 LT & RT (2)  
 STA. 10+226 LT & RT (2)  
 STA. 10+273 LT & RT (2)  
 STA. 10+393 LT & RT (2)

646.60 TEMPORARY 100 mm WHITE LINE (PAINT)  
 (ALL LINES WILL INCLUDE EDGE LINE BREAKS AND RADIUS FOR TOWN HIGHWAYS)  
 WAITSFIELD:  
 STA. 9+800 - STA. 10+400 LT & RT

646.61 TEMPORARY 100 mm YELLOW LINE (PAINT)  
 (ALL LINES WILL INCLUDE C/L BREAKS FOR TOWN HIGHWAYS) S=SOLID, D=DASHED  
 WAITSFIELD:  
 STA. 9+800 - STA. 10+018 LT D S  
 STA. 10+018 - STA. 10+400 S S

617.10 RELOCATE MAILBOX - SINGLE SUPPORT  
 WAITSFIELD:  
 STA. 10+339 RT  
 617.12 RELOCATE MAILBOX - MULTIPLE SUPPORT  
 WAITSFIELD:  
 STA. 9+879 RT (2 BOX SUPPORT)

DITCHING LOCATION  
 WAITSFIELD:  
 STA. 10+100 - 10+117 LT  
 STA. 10+140 - 10+273 LT  
 STA. 10+273 RT (CLEAN CULVERT OUTLET DITCH)  
 REMOVING SIGNS  
 3 AS SHOWN


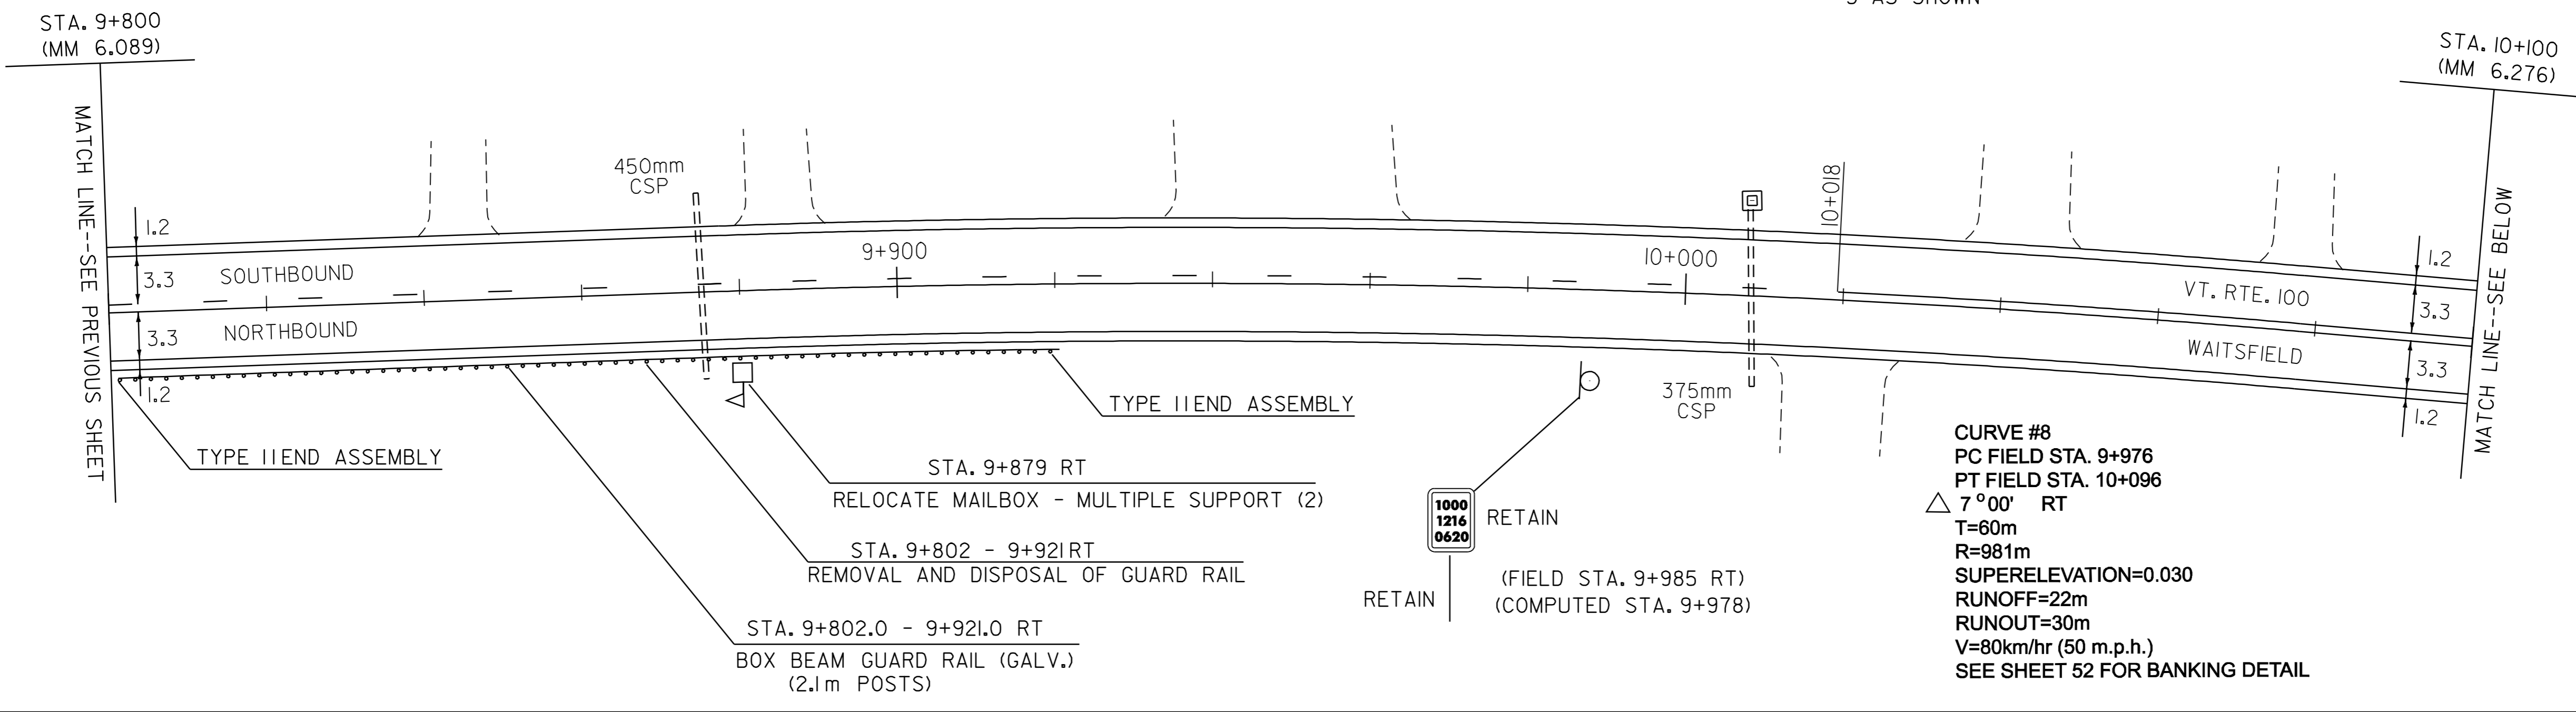


621.81 REMOVAL AND DISPOSAL OF GUIDE POSTS  
 WAITSFIELD:  
 STA. 10+328 RT (1 EACH)  
 621.80 REMOVAL AND DISPOSAL OF GUARD RAIL  
 WAITSFIELD:  
 STA. 9+802 - 9+921 RT (119m)  
 STA. 10+140 - 10+284 RT (144m)  
 STA. 10+316 RT (61m ALONG TH #9)  
 STA. 10+331 - 10+400 RT (69m)

621.30 BOX BEAM GUARD RAIL (GALV.)  
 WAITSFIELD:  
 STA. 10+331.0 - 10+400.0 RT (69.00m)  
 621.30 BOX BEAM GUARD RAIL (GALV.)  
 (2.1 METER POSTS)  
 WAITSFIELD:  
 STA. 9+802.0 - 9+921.0 RT (118.87m)  
 STA. 10+140.0 - 10+284.0 RT (144.48m)  
 STA. 10+316.0 RT (62.18m ALONG TH #9)

STA. 10+331.0 - 10+400.0 RT  
 BOX BEAM GUARD RAIL (GALV.)

**CURVE #9**  
 PC FIELD STA. 10+290  
 PT FIELD STA. 10+490  
 Δ 24° 00' LT  
 T=100m  
 R=524m  
 SUPERELEVATION=0.058  
 RUNOFF=41m  
 RUNOUT=30m  
 V=80km/hr (50 m.p.h.)  
 SEE SHEET 52 FOR DETAIL

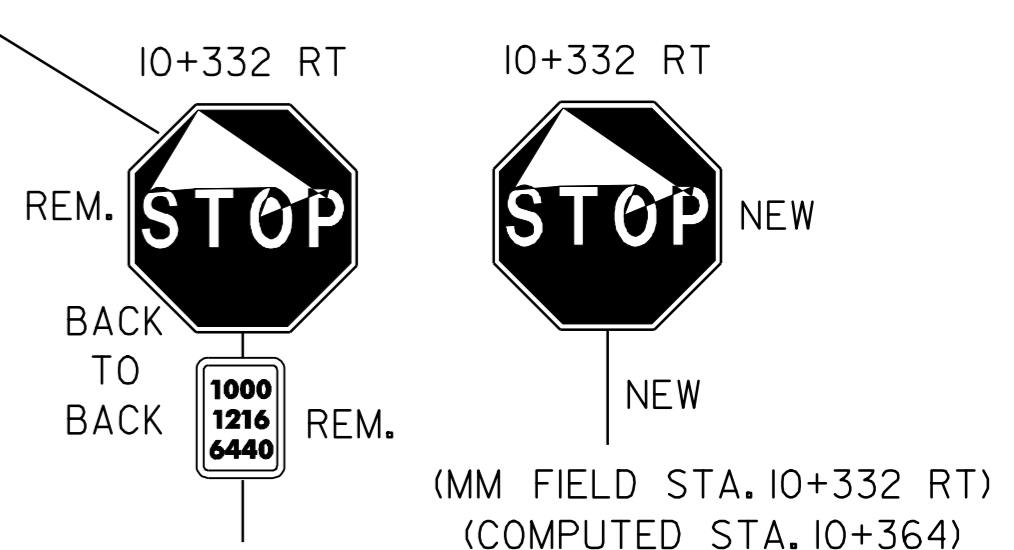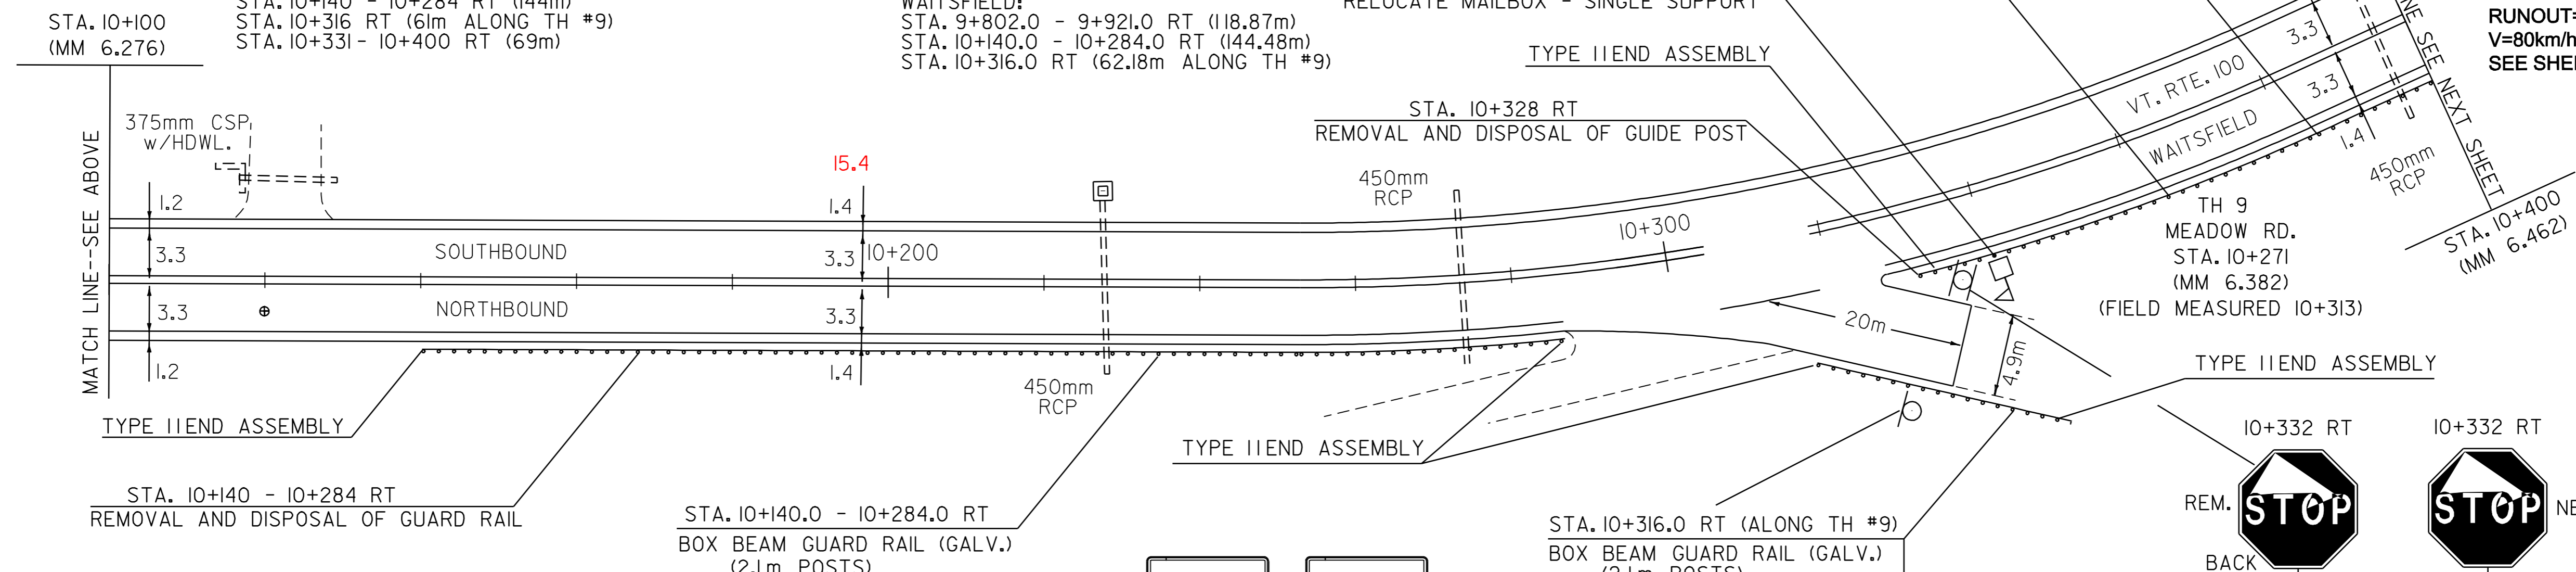

<b>PAVING PROJECT LAYOUT #7 VT. RTE. 100</b>	PROJECT NAME: WAITSFIELD-MORETOWN	FILE NAME: /pave/00b058/00b058.dgn	PLOT DATE: 23-MAY-2008 12:3
	PROJECT NUMBER: STP 2227(1)S	PROJECT LEADER: WOOLAVER	DRAWN BY: J. REDMOND
		DESIGNED BY: J. REDMOND	CHECKED BY: J. REDMOND
		00b058107.1	SHEET 37 OF 54

CORE NO.	LOCATION	DEPTH (mm)
4	10+120 RT	165

NOT TO SCALE