

REMOVING SIGNS
8 AS SHOWN

646.40 DURABLE 100 mm WHITE LINE (THERMOPLASTIC)
(ALL LINES WILL INCLUDE EDGE LINE BREAKS AND RADIUS FOR TOWN HIGHWAYS)

WAITSFIELD:
STA. 10+400 - STA. 11+000 LT & RT

646.60 TEMPORARY 100 mm WHITE LINE (PAINT)
(ALL LINES WILL INCLUDE EDGE LINE BREAKS AND RADIUS FOR TOWN HIGHWAYS)

WAITSFIELD:
STA. 10+400 - STA. 11+000 LT & RT

646.41 DURABLE 100 mm YELLOW LINE (THERMOPLASTIC)
(ALL LINES WILL INCLUDE C/L BREAKS FOR TOWN HIGHWAYS) S=SOLID, D=DASHED

WAITSFIELD:
STA. 10+400 - STA. 10+960 LT S C RT S
STA. 10+960 - STA. 11+000 D S S
STA. 10+775 DOUBLE SOLID LT, T-6

646.61 TEMPORARY 100 mm YELLOW LINE (PAINT)
(ALL LINES WILL INCLUDE C/L BREAKS FOR TOWN HIGHWAYS) S=SOLID, D=DASHED

WAITSFIELD:
STA. 10+400 - STA. 10+960 LT S C RT S
STA. 10+960 - STA. 11+000 D S S
STA. 10+775 DOUBLE SOLID LT, T-6

646.46 DURABLE 600 mm STOP BAR (THERMOPLASTIC)

WAITSFIELD:
STA. 10+775 LT, T-6

646.66 TEMPORARY 600 mm STOP BAR (PAINT)

WAITSFIELD:
STA. 10+775 LT, T-6

646.50 DURABLE LETTER OR SYMBOL (THERMOPLASTIC)

WAITSFIELD:
STA. 10+775 LT, T-6, "S,T,O,P" (4 EA)

646.70 TEMPORARY LETTER OR SYMBOL (PAINT)

WAITSFIELD:
STA. 10+775 LT, T-6, "S,T,O,P" (4 EA)



604.412 REHABILITATION OF
DI, CB OR MH



WAITSFIELD:
STA. 10+480 LT

619.17 YIELDING MARKER POSTS

WAITSFIELD:
STA. 10+480 LT & RT (2)

DITCHING LOCATION

WAITSFIELD:
STA. 10+456 - 10+486 LT
STA. 10+523 - 10+632 LT
STA. 10+643 - 10+676 LT
STA. 10+641 - 10+696 RT

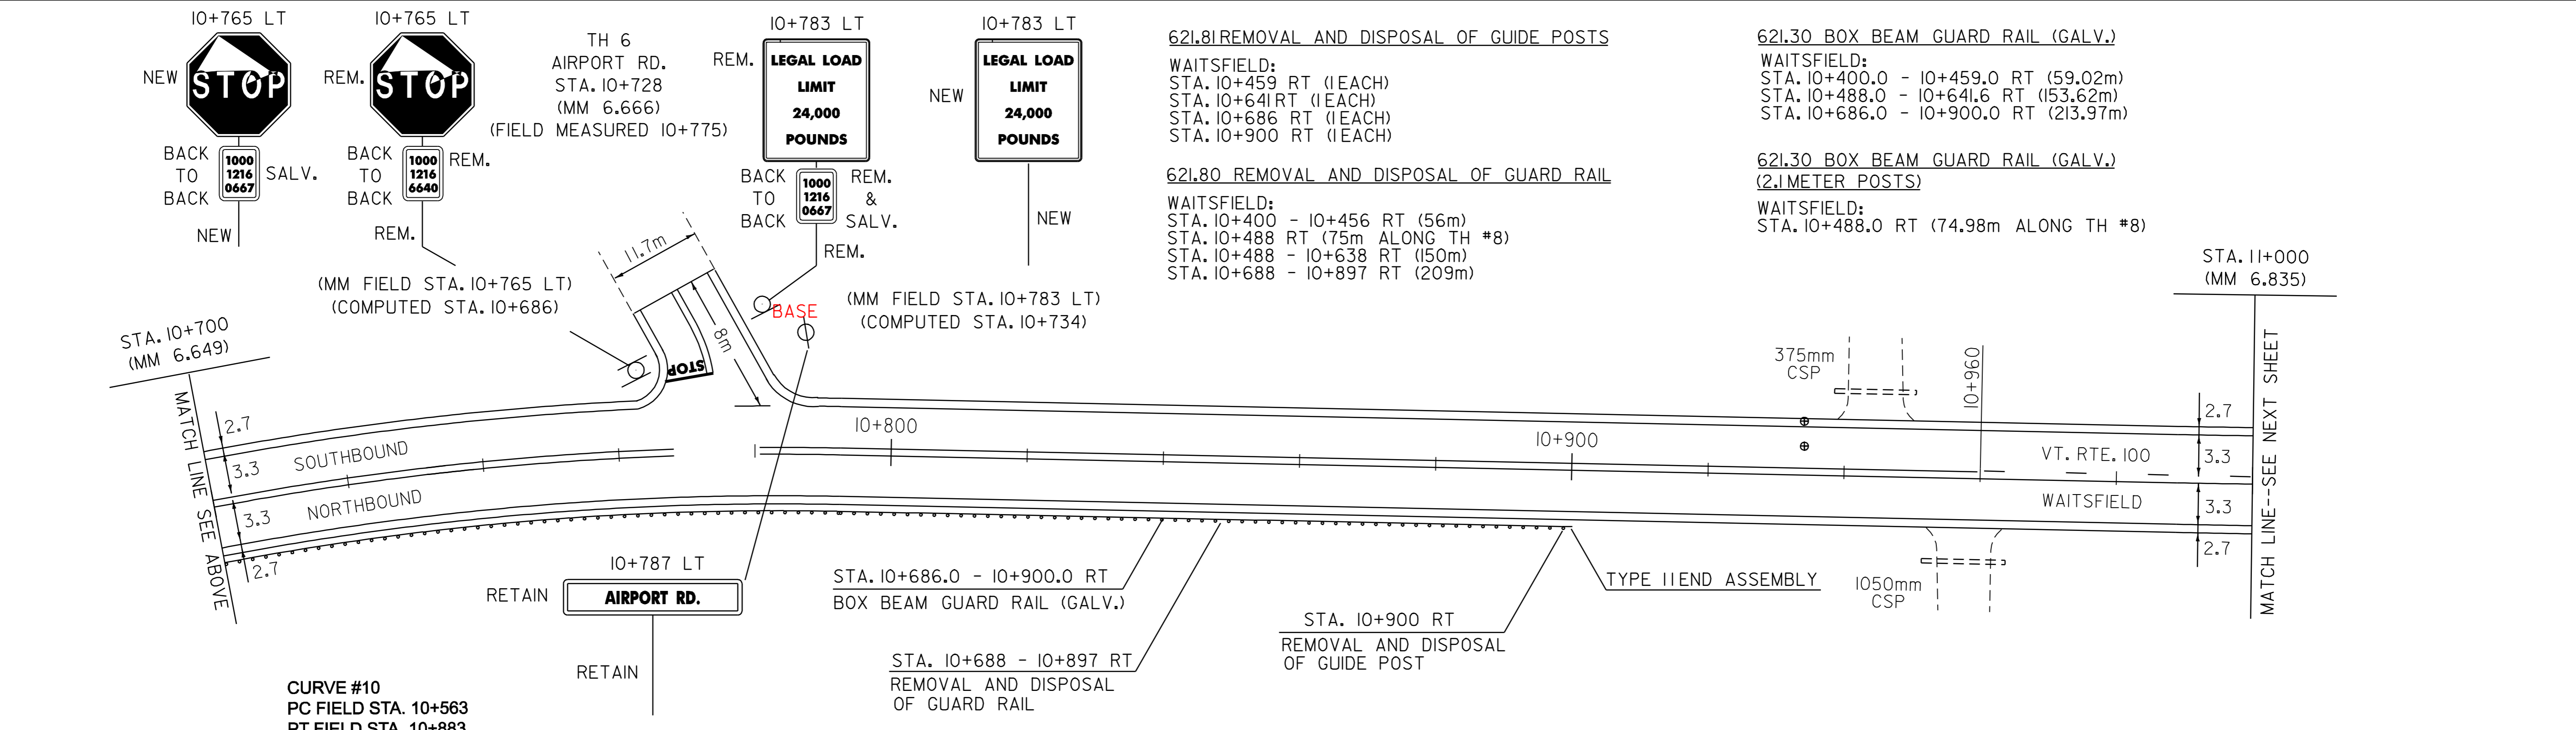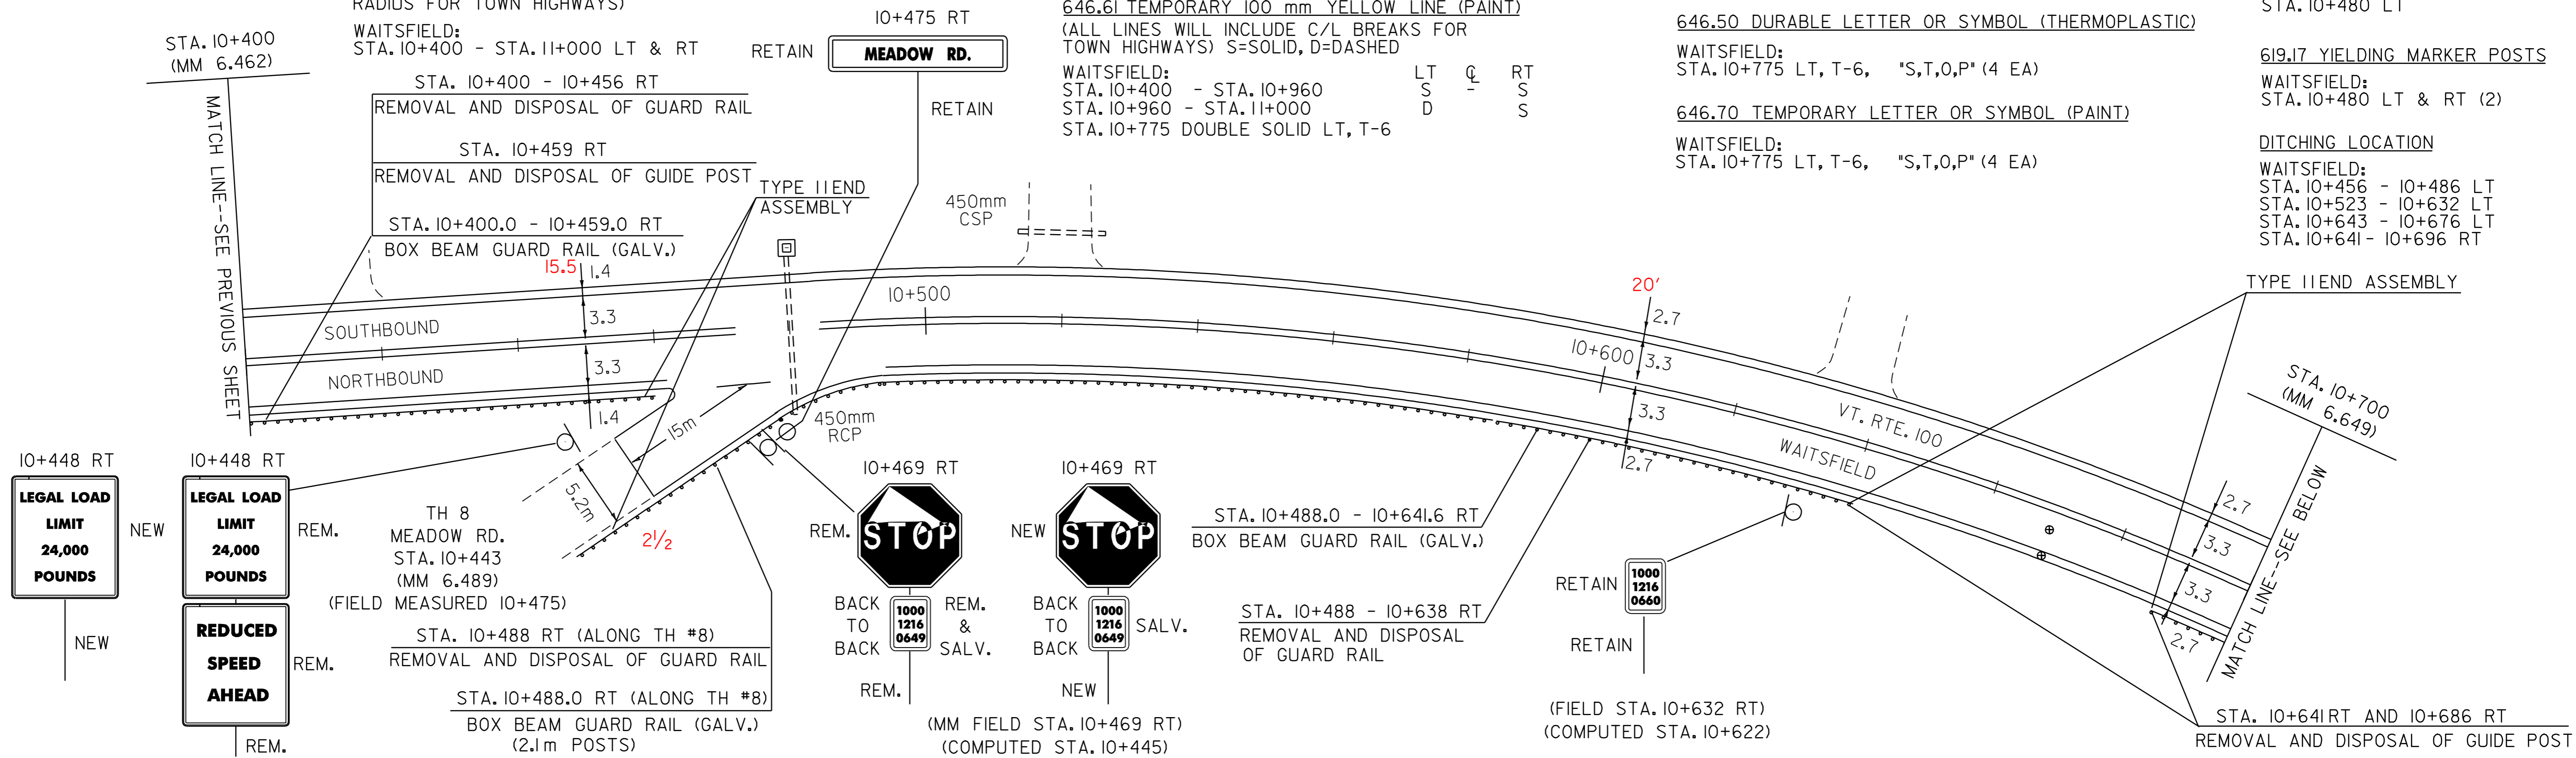

CURVE #10
PC FIELD STA. 10+563
PT FIELD STA. 10+883
39° 00' RT
T=160m
R=452m
SUPERELEVATION=0.062
RUNOFF=45m
RUNOUT=30m
V=80km/hr (50 m.p.h.)
SEE SHEET 52 FOR BANKING DETAIL

- NOTE:
- PAVING LIMIT ON ALL TOWN HIGHWAYS SHALL BE MEASURED 8 m BACK FROM VT. ROUTE 100 EDGE OF SHOULDER UNLESS DENOTED OTHERWISE ON THE PLANS OR AS DIRECTED BY THE RESIDENT ENGINEER.
 - THERE SHALL NOT BE ANY PAVEMENT MARKINGS PLACED ON TH 8. THE MAINLINE EDGELINE AND CENTERLINE SHALL HAVE A GAP FOR THE INTERSECTION.

PAVING PROJECT LAYOUT #8 VT. RTE. 100	PROJECT NAME: WAITSFIELD-MORETOWN	FILE NAME: /pave/00b058/00b058.dgn	PLOT DATE: 23-MAY-2008 12:30
	PROJECT NUMBER: STP 2227(1)S	PROJECT LEADER: WOOLAVER	DRAWN BY: J. REDMOND
		DESIGNED BY: J. REDMOND	CHECKED BY: J. REDMOND

CORE NO.	LOCATION	DEPTH (mm)
7	10+668 RT	119
8	10+668 RT 113 (SHLD.)	
11	10+934 LT	100
12	10+934 LT 119 (SHLD.)	