
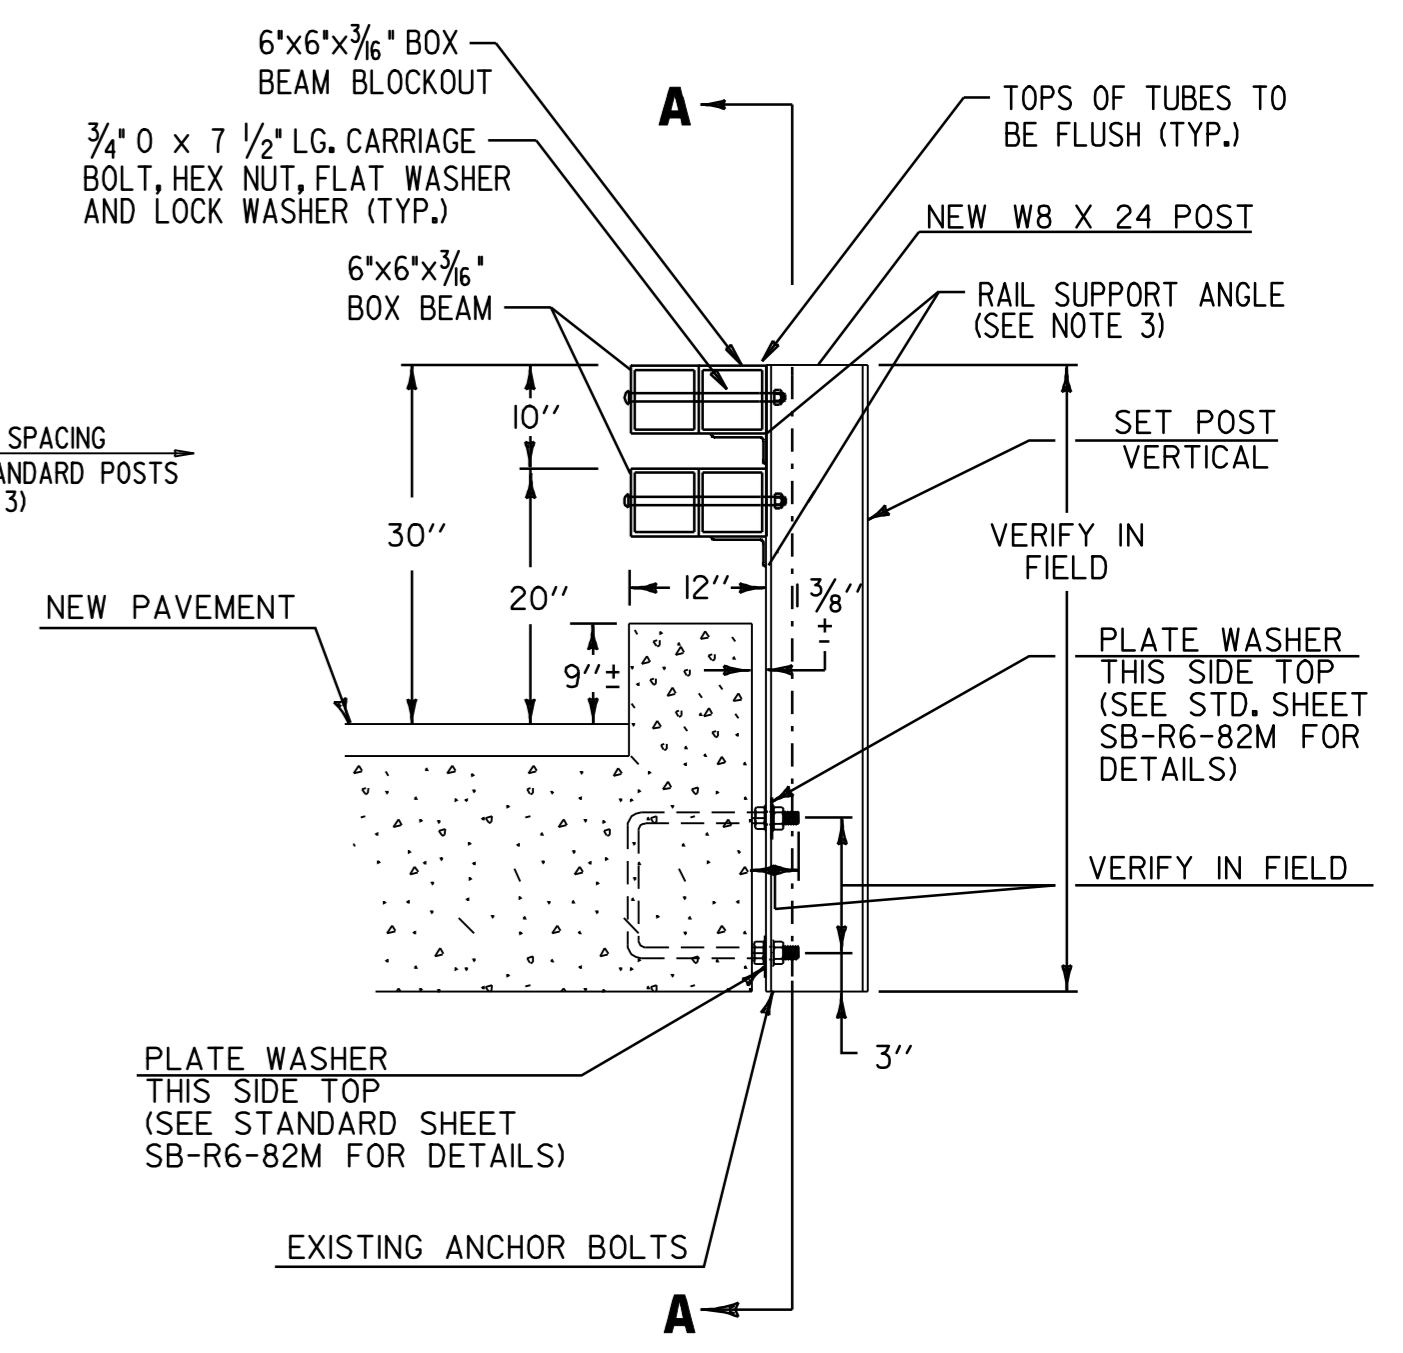
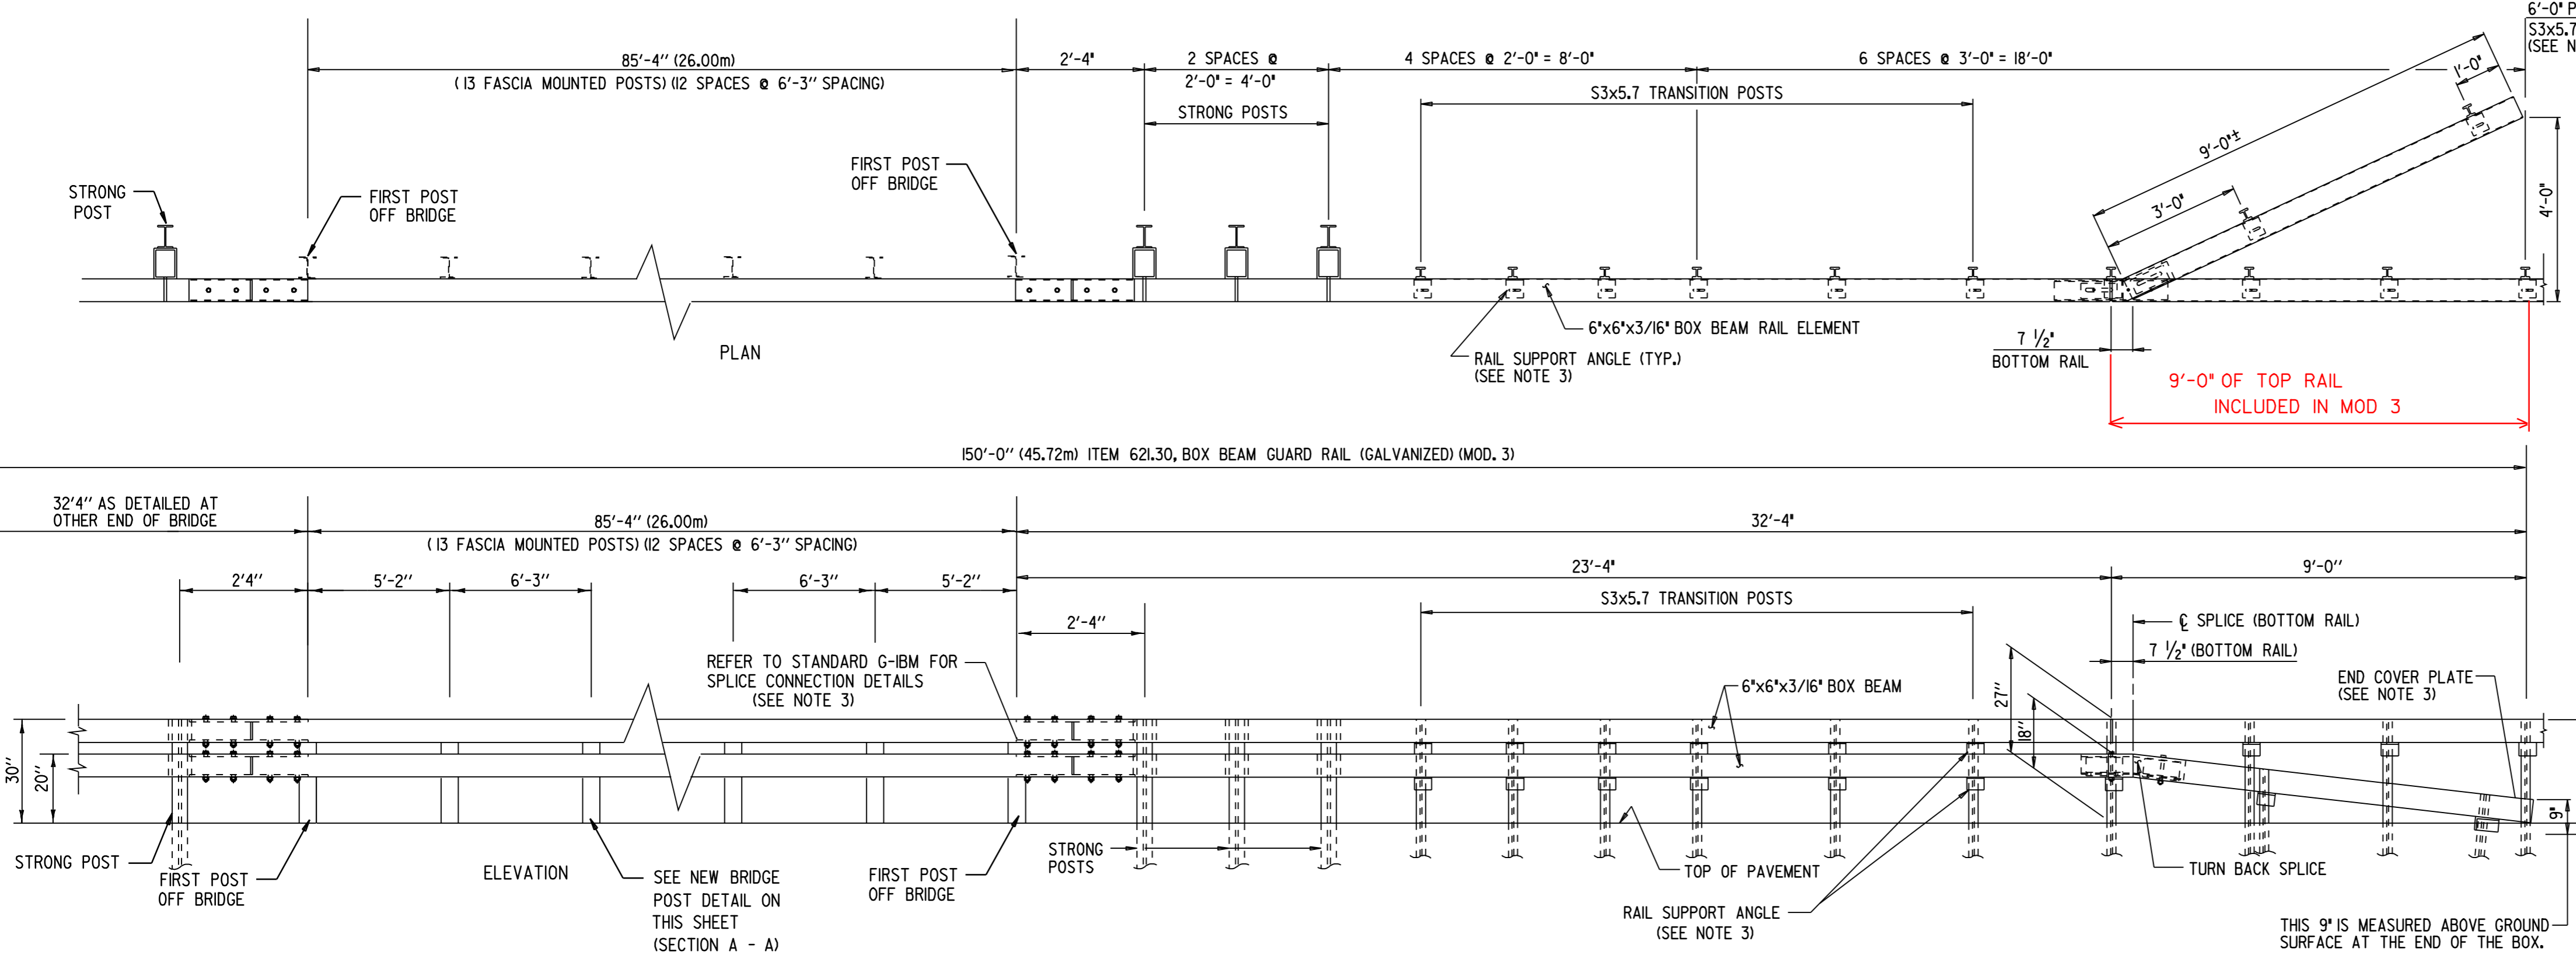


BR 186 WAITSFIELD FIELD STA. 11+479
NOT TO SCALE

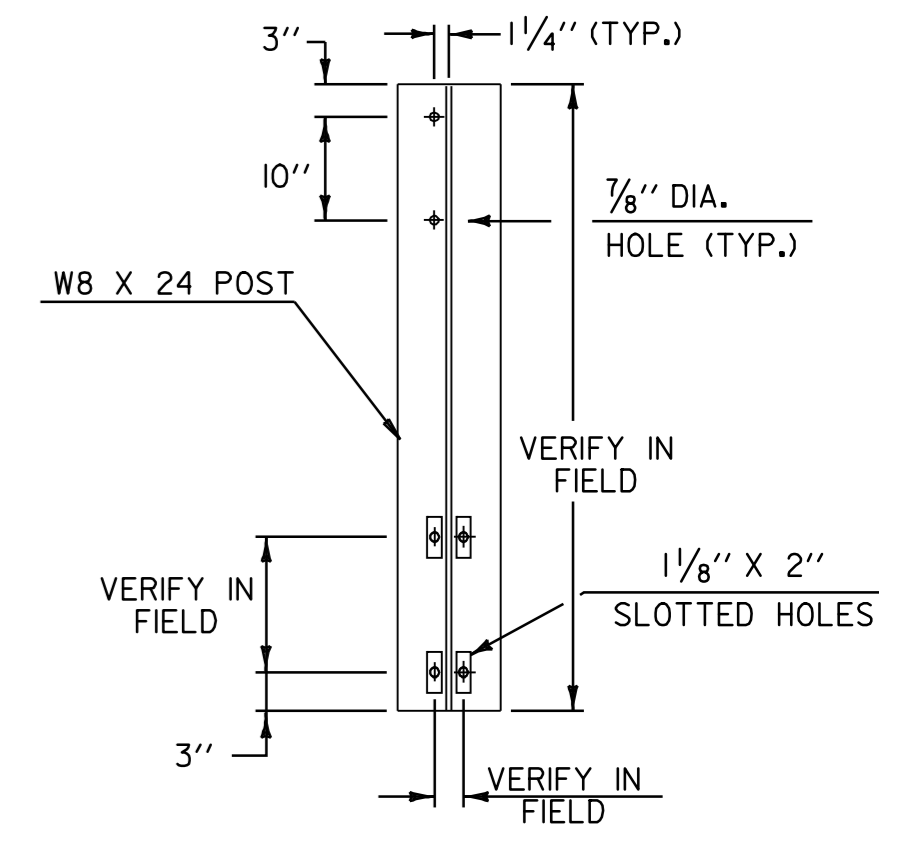

NOTE: REFER TO SHEET 45 FOR THE GENERAL NOTES, STRONG POST DETAILS, TRANSITION POST DETAILS, SPLICE DETAILS AND WELDING DETAILS ASSOCIATED WITH THE BOX BEAM GUARD RAIL (GALVANIZED) (MOD. 3) DETAILED ON THIS SHEET.

<h3>BRIDGE #186 DETAIL SHEET</h3>	PROJECT :	PROJECT NO. :
	WAITSFIELD - MORETOWN	STP 2227(I) S
	DESIGN FILE NAME: pave/00b058/00b058.dgn	PLOT DATE: 23-MAY-2008
	IPARM FILE NAME: 00b058brg3.i	SURVEY DATE: 7/05
	SURVEYED BY: LFW	DRAWN BY: 7/05
SQUAD LEADER: LFW	SHEET: 47 OF 54	