

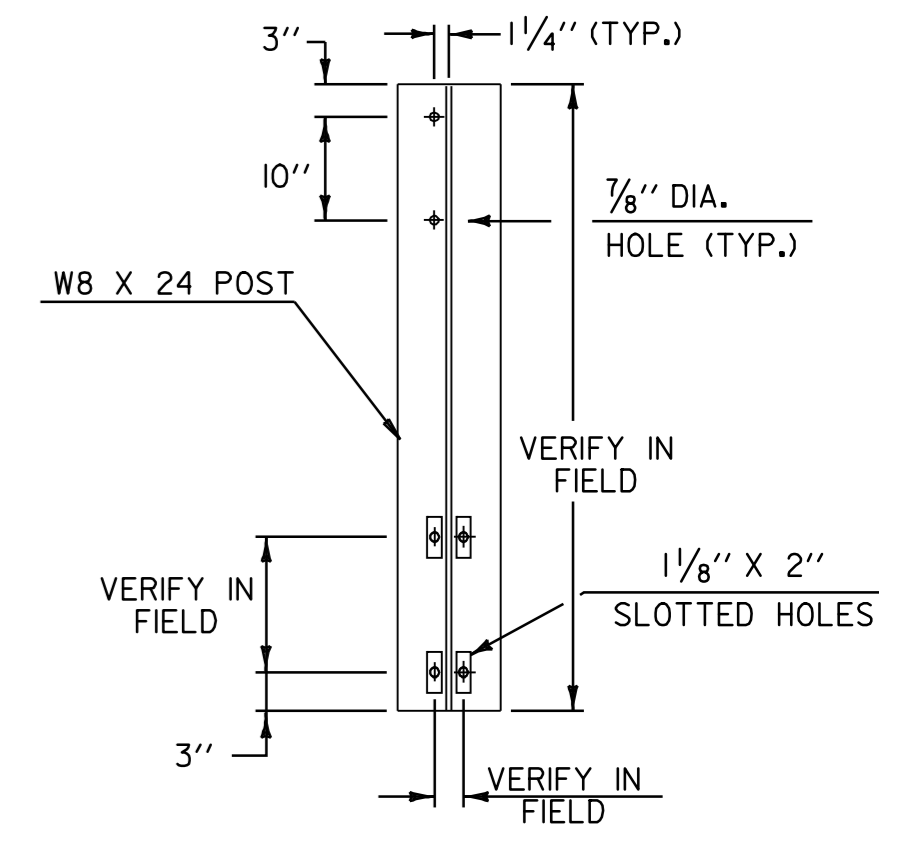


BR 185 WAITSFIELD FIELD STA. 9+353
NOT TO SCALE

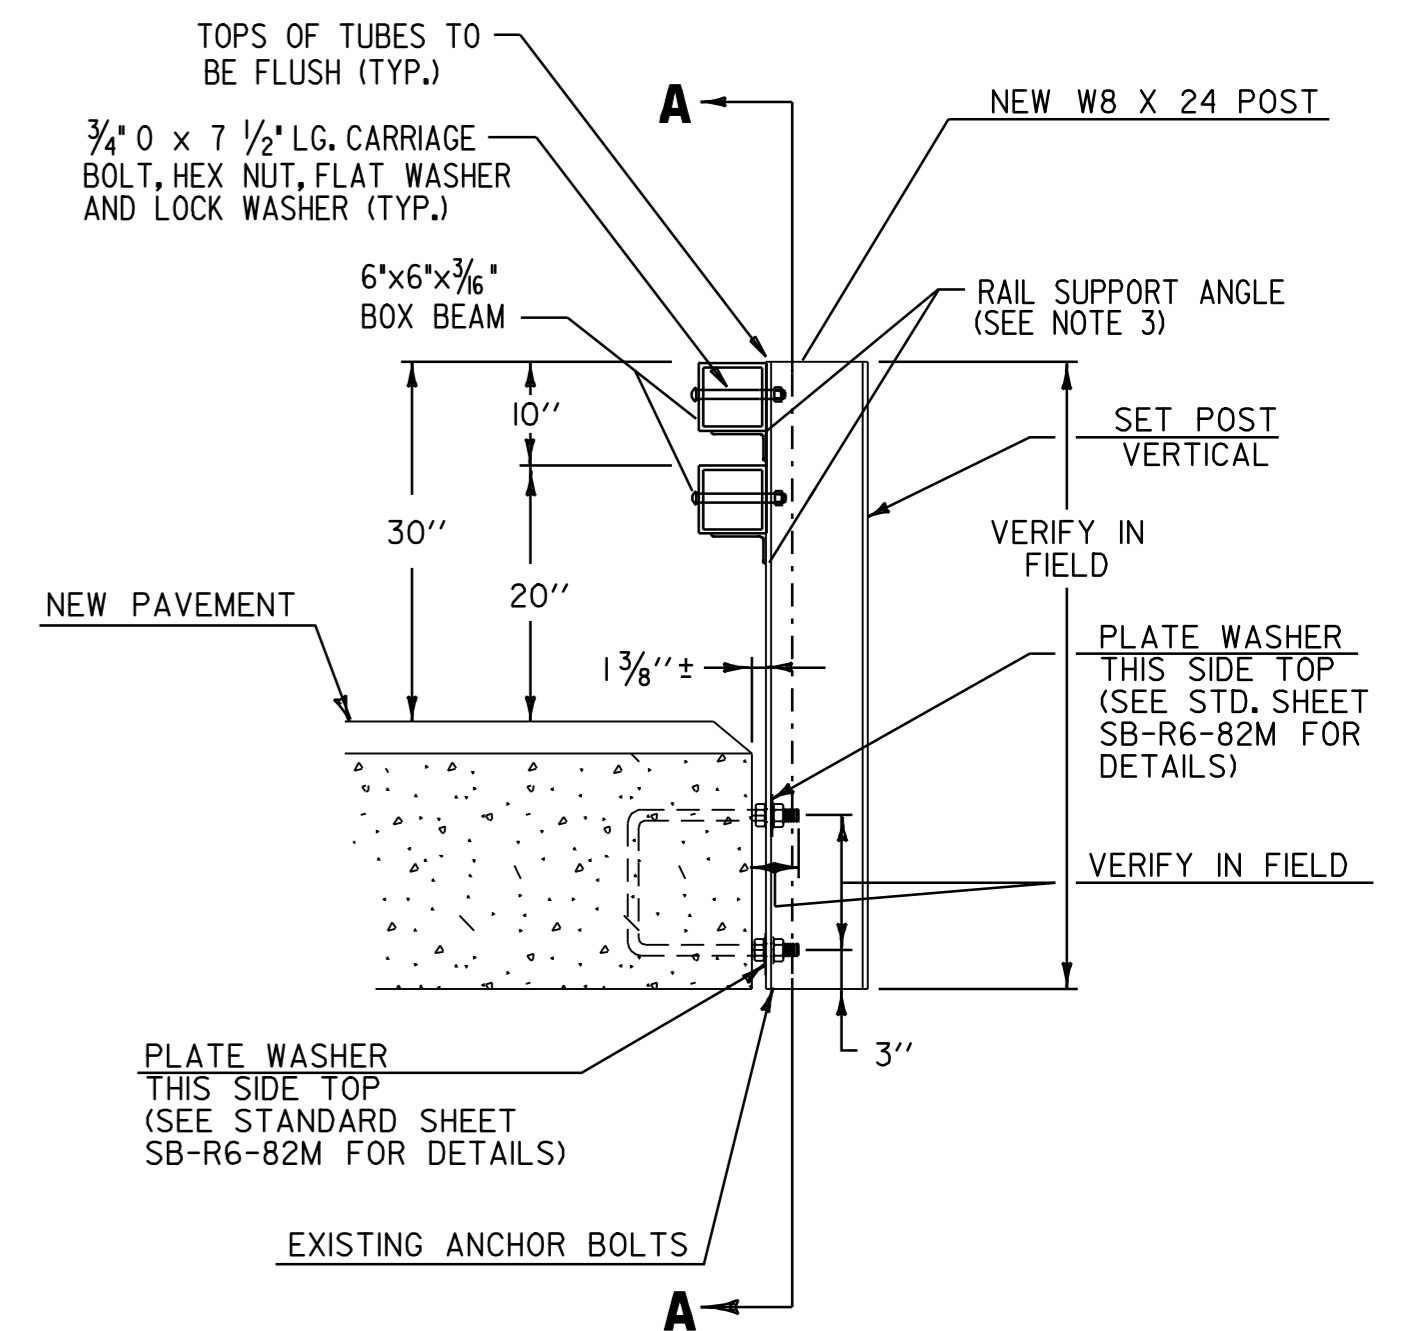


BR 185 BRIDGE POST DETAIL
NOT TO SCALE

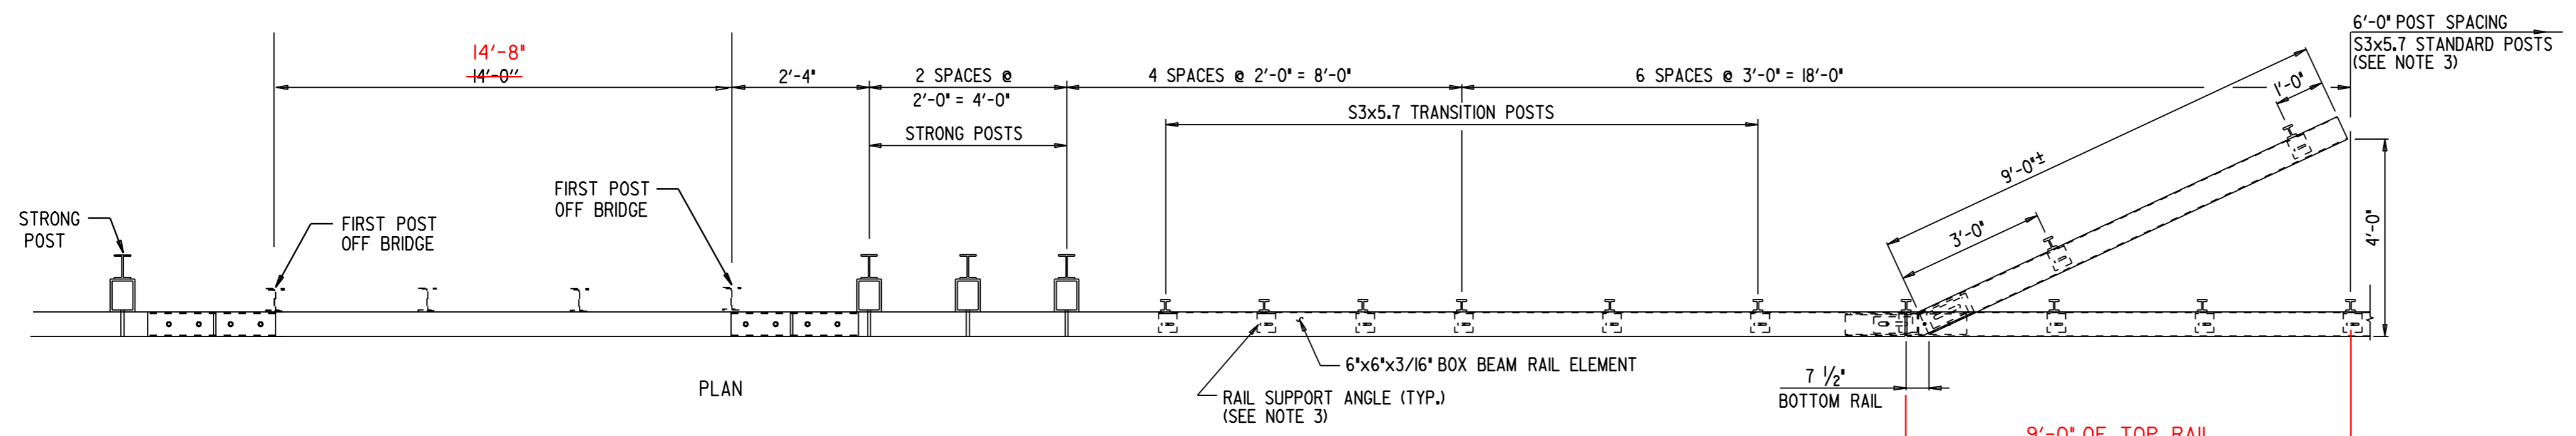

BRIDGE POST DETAIL NOTES

1. LOCATION OF EXISTING ANCHOR BOLTS TO BE VERIFIED IN THE FIELD BY THE CONTRACTOR PRIOR TO ORDERING BRIDGE POSTS.
2. POSTS SHALL BE SHOP CUT AND DRILLED PRIOR TO GALVANIZING.
3. SEE STANDARD SHEET SB-R6-82M FOR ADDITIONAL POST DETAILS.

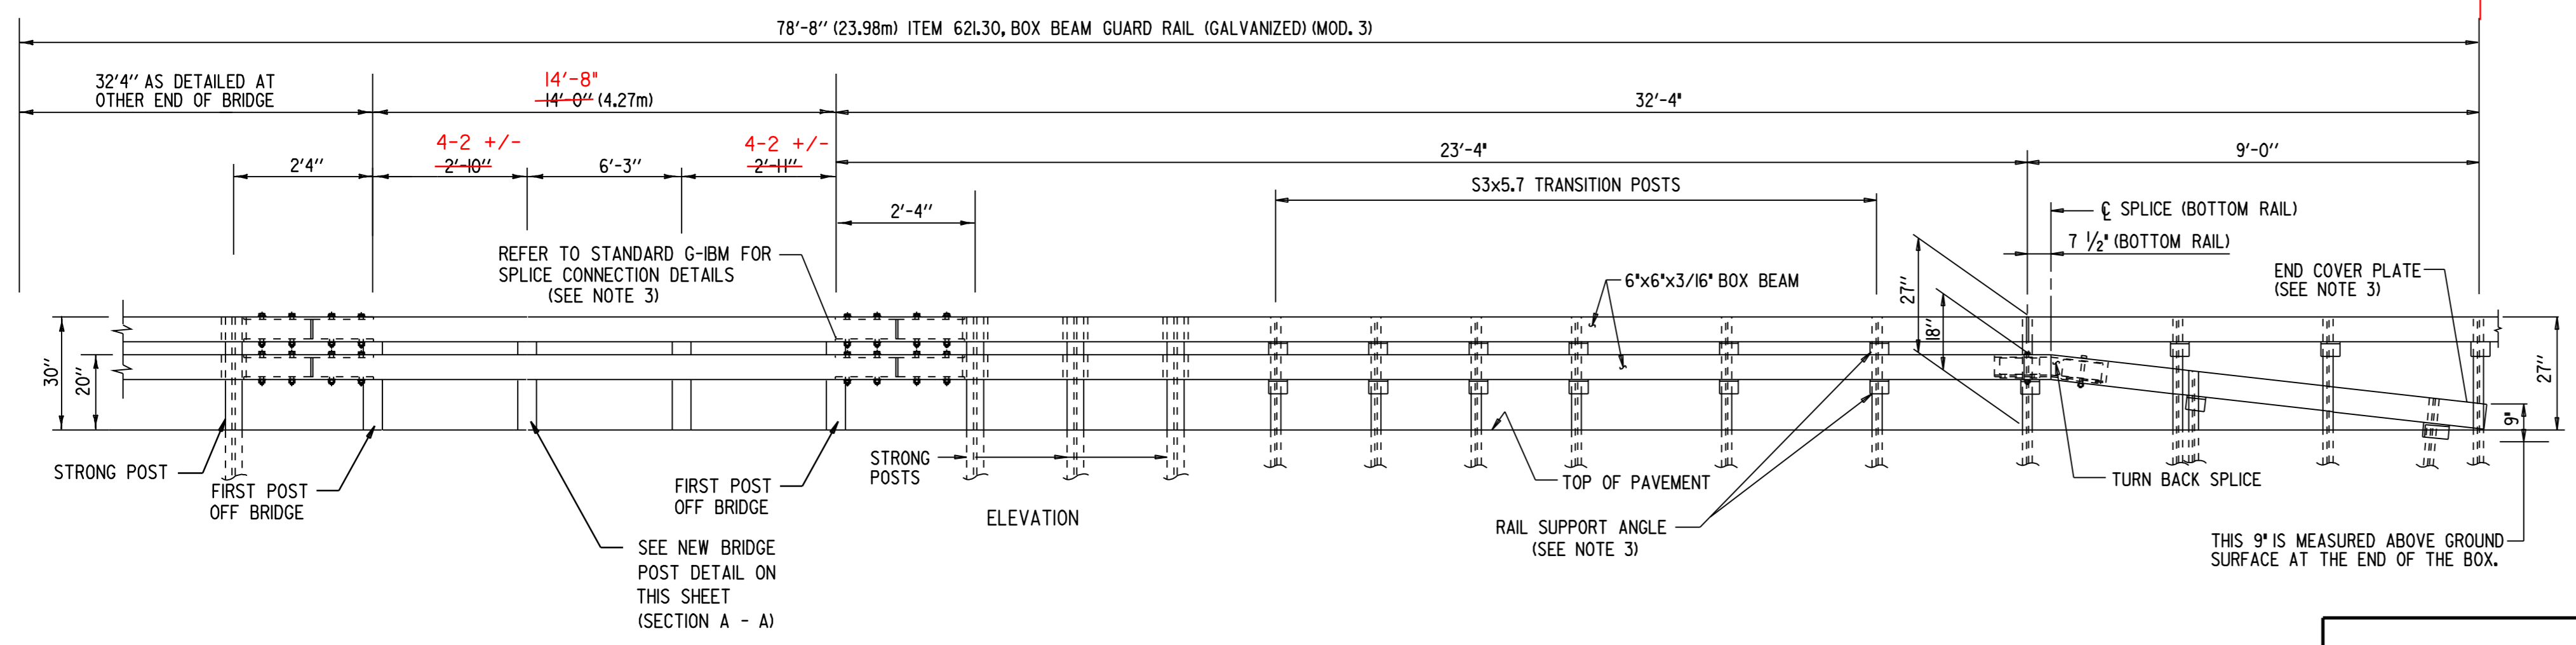

NOTE: REFER TO SHEET 45 FOR THE GENERAL NOTES, STRONG POST DETAILS, TRANSITION POST DETAILS, SPLICE DETAILS AND WELDING DETAILS ASSOCIATED WITH THE BOX BEAM GUARD RAIL (GALVANIZED) (MOD. 3) DETAILED ON THIS SHEET.

<h2>BRIDGE #185 DETAIL SHEET</h2>	PROJECT :	PROJECT NO. :
	WAITSFIELD - MORETOWN	STP 2227(I) S
	DESIGN FILE NAME: pave/00b058/00b058.dgn	PLOT DATE: 23-MAY-2008
	IPARM FILE NAME: 00b058br-g4.i	SURVEY DATE: 7/05
	SURVEYED BY: LFW	DRAWN BY: T/O5
SQUAD LEADER: LFW	SHEET: 48 OF 54	