


PROFILE ALONG TH 41

HORIZONTAL SCALE: 1" = 20'-0"
 VERTICAL SCALE: 1" = 10'-0"

NOTE:

ELEVATIONS SHOWN TO THE NEAREST TENTHS ARE EXISTING GROUND ALONG PROPOSED CENTERLINE.

ELEVATIONS SHOWN TO THE NEAREST HUNDREDTHS ARE FINISH GRADES ALONG PROPOSED CENTERLINE.

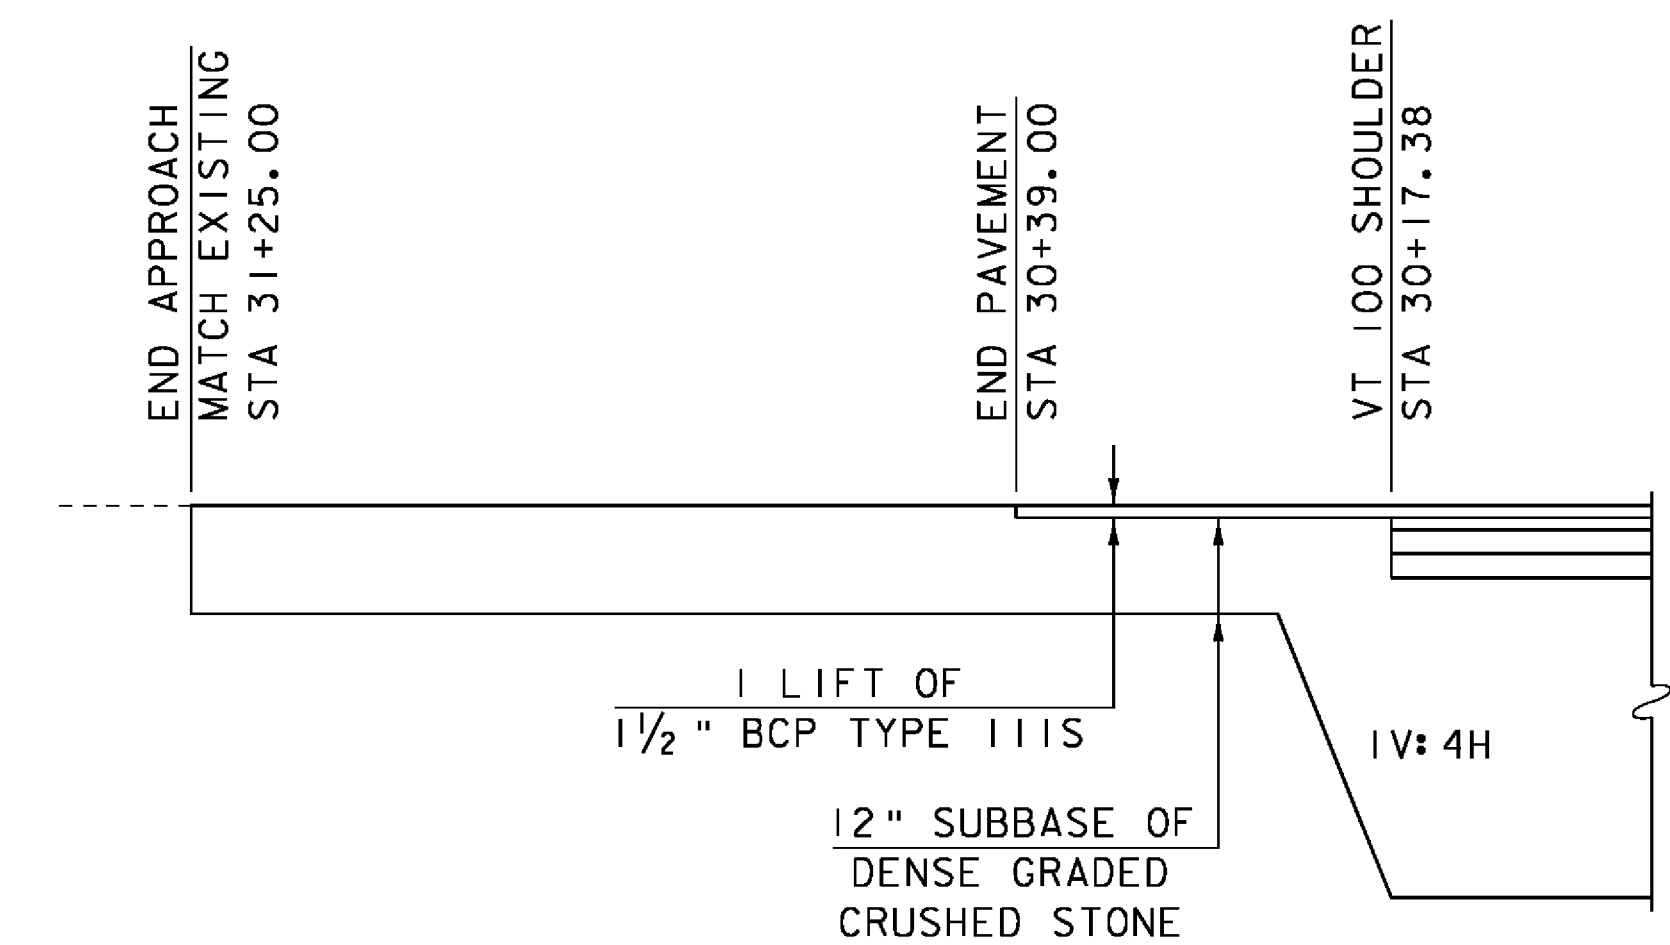

TH 41 MATERIAL TRANSITION DETAIL

HORIZONTAL SCALE: 1" = 20'-0"
 VERTICAL SCALE: 1" = 2'-0"

NOTE: REVISED SHEET FOR POST IRENE

PROJECT NAME: PITTSFIELD-STOCKBRIDGE
 PROJECT NUMBER: STP 022-1(22)S

FILE NAME: s00b122pro.dgn PLOT DATE: 27-OCT-2011
 PROJECT LEADER: C. P. WILLIAMS DRAWN BY: G. ROY
 DESIGNED BY: G. ROY CHECKED BY: R. YOUNG
 TH 41 PROFILE AND MATERIAL TRANSITION SHEET 12 OF 41