


NOTE: SEE REVISED SHEET
 DATED 27-OCT-2011
 FOR POST IRENE REVISIONS

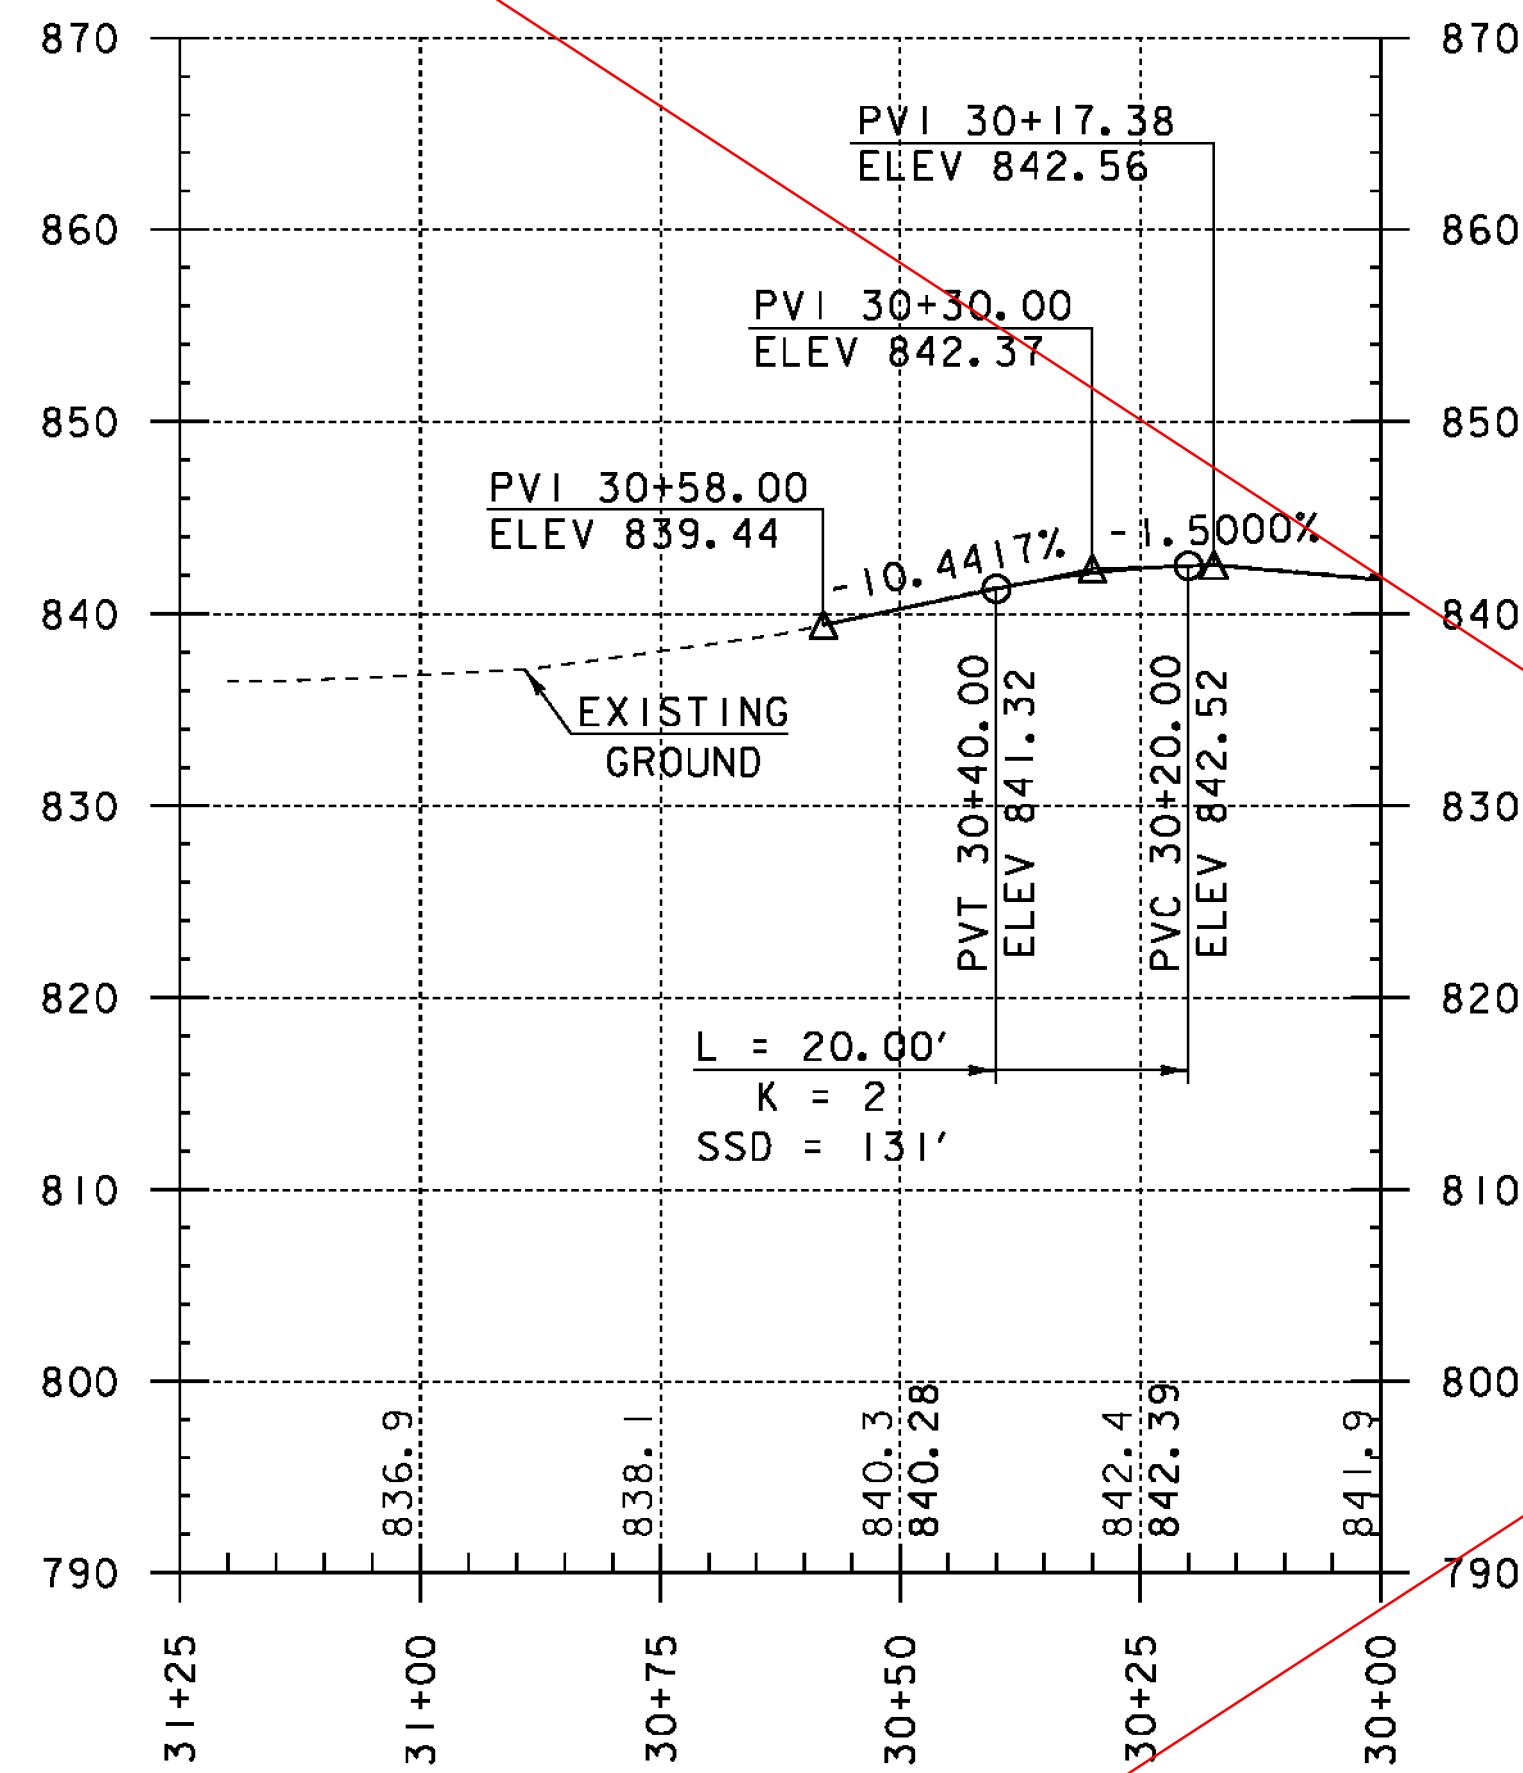


PROFILE ALONG TH 41

HORIZONTAL SCALE: 1" = 20'-0"
 VERTICAL SCALE: 1" = 10'-0"

NOTE:

ELEVATIONS SHOWN TO THE NEAREST TENTHS ARE
 EXISTING GROUND ALONG PROPOSED CENTERLINE.

ELEVATIONS SHOWN TO THE NEAREST HUNDREDTHS ARE
 FINISH GRADES ALONG PROPOSED CENTERLINE.

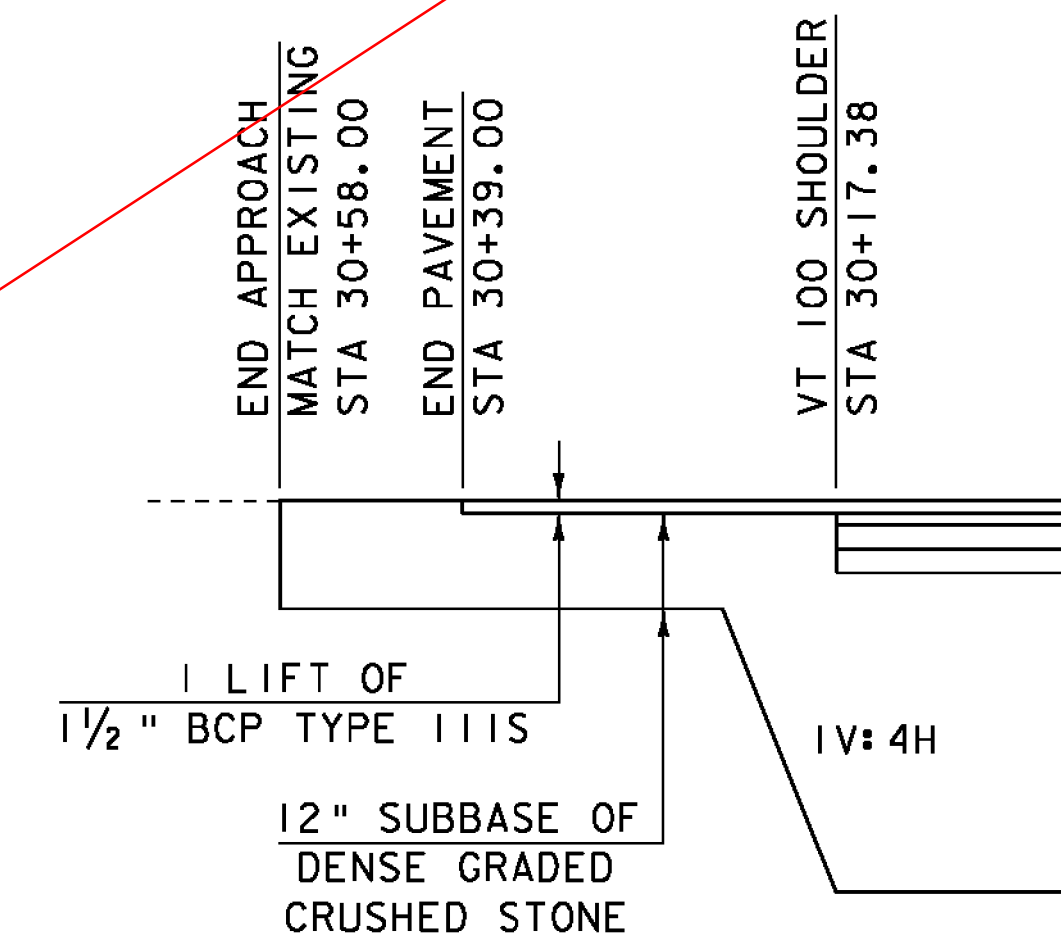

TH 41 MATERIAL TRANSITION DETAIL

HORIZONTAL SCALE: 1" = 20'-0"
 VERTICAL SCALE: 1" = 2'-0"

PROJECT NAME: PITTSFIELD-STOCKBRIDGE	
PROJECT NUMBER: STP 022-1(22)S	
FILE NAME: s00b122pro.dgn	PLOT DATE: 07-SEP-2011
PROJECT LEADER: C. P. WILLIAMS	DRAWN BY: G. ROY
DESIGNED BY: G. ROY	CHECKED BY: R. YOUNG
TH 41 PROFILE AND MATERIAL TRANSITION	SHEET 12 OF 41