




**INLET ELEVATION**  
SCALE: 1/4" = 1'-0"



**OUTLET ELEVATION**  
SCALE: 1/4" = 1'-0"

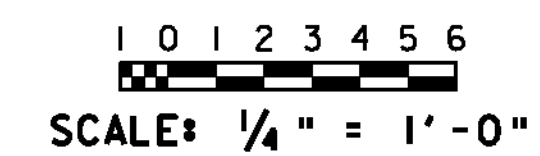

PROJECT NAME: PITSFIELD-STOCKBRIDGE	PLOT DATE: 07-SEP-2011
PROJECT NUMBER: STP 022-1(22)S	DRAWN BY: G. ROY
FILE NAME: s00bl22abu+.dgn	CHECKED BY: R. YOUNG
PROJECT LEADER: C. P. WILLIAMS	SHEET 20 OF 41
DESIGNED BY: G. ROY	
WINGWALL ELEVATIONS	