


VT 100 BANKING DIAGRAM

HORIZONTAL SCALE: 1" = 20'-0"
 VERTICAL SCALE: 1" = 0.02' /'

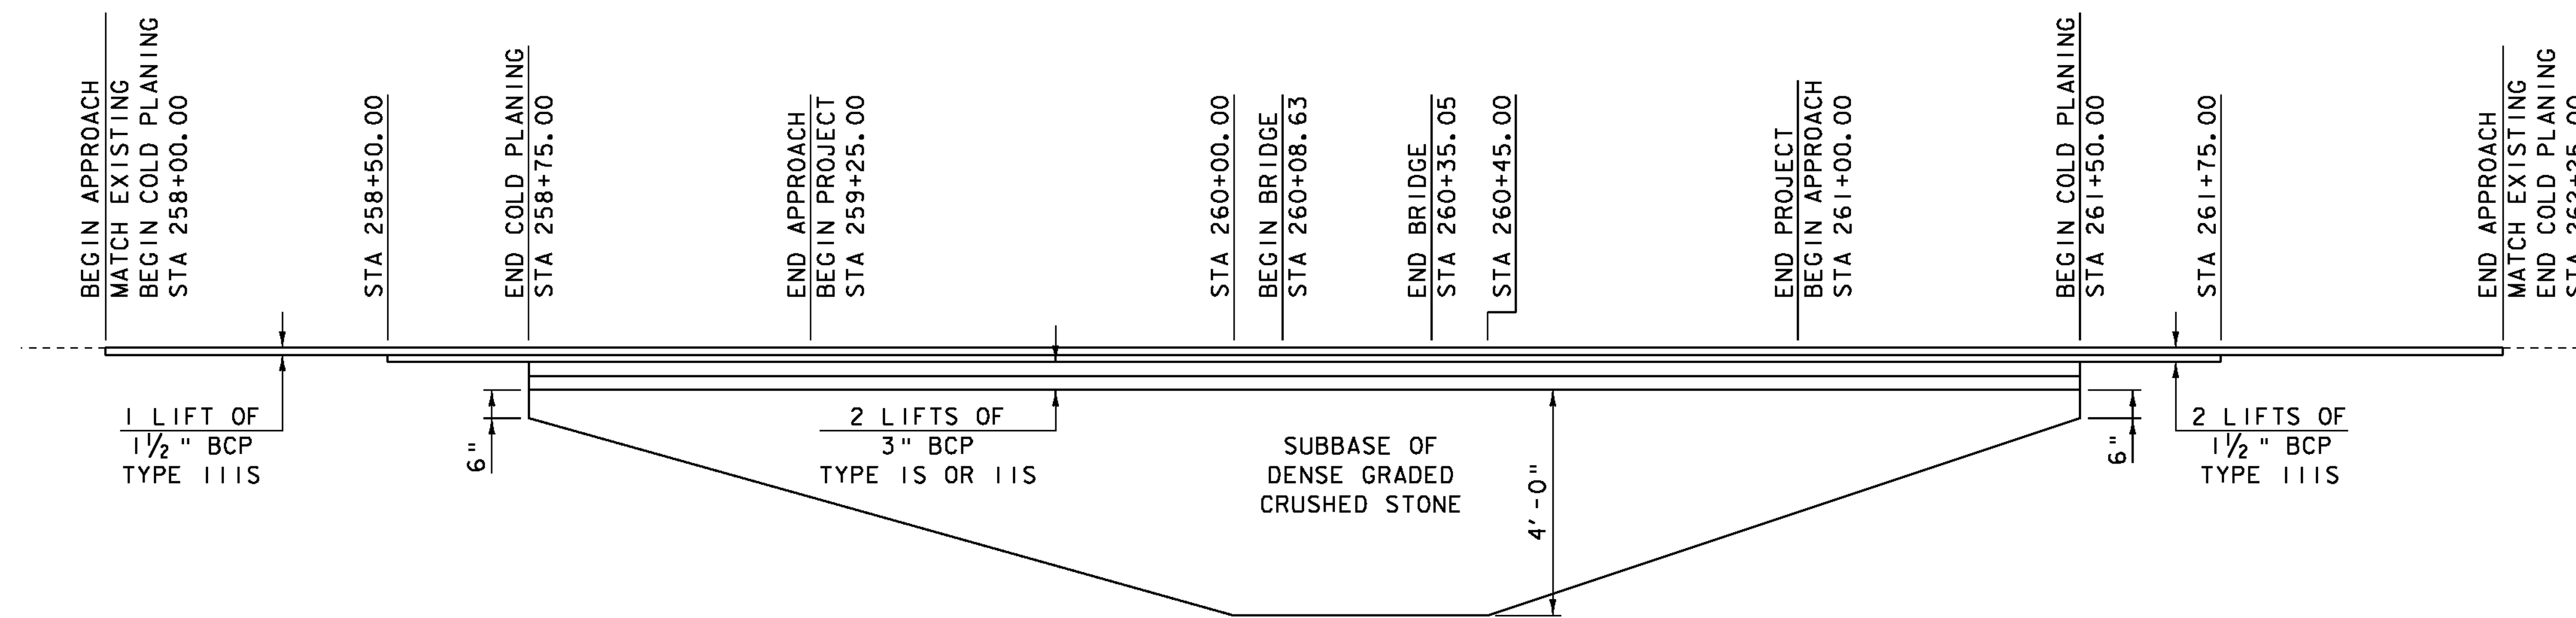

VT 100 MATERIAL TRANSITION DETAIL

HORIZONTAL SCALE: 1" = 20'-0"
 VERTICAL SCALE: 1" = 2'-0"

PROJECT NAME: PITTSFIELD-STOCKBRIDGE
 PROJECT NUMBER: STP 022-1(22)S

FILE NAME: s00b122pro.dgn PLOT DATE: 02-SEP-2011
 PROJECT LEADER: C. P. WILLIAMS DRAWN BY: G. ROY
 DESIGNED BY: G. ROY CHECKED BY: R. YOUNG
 BANKING DIAGRAM AND MATERIAL TRANSITION SHEET 33 OF 41