



258+00

BEGIN APPROACH
MATCH EXISTING
STA 258+00.00

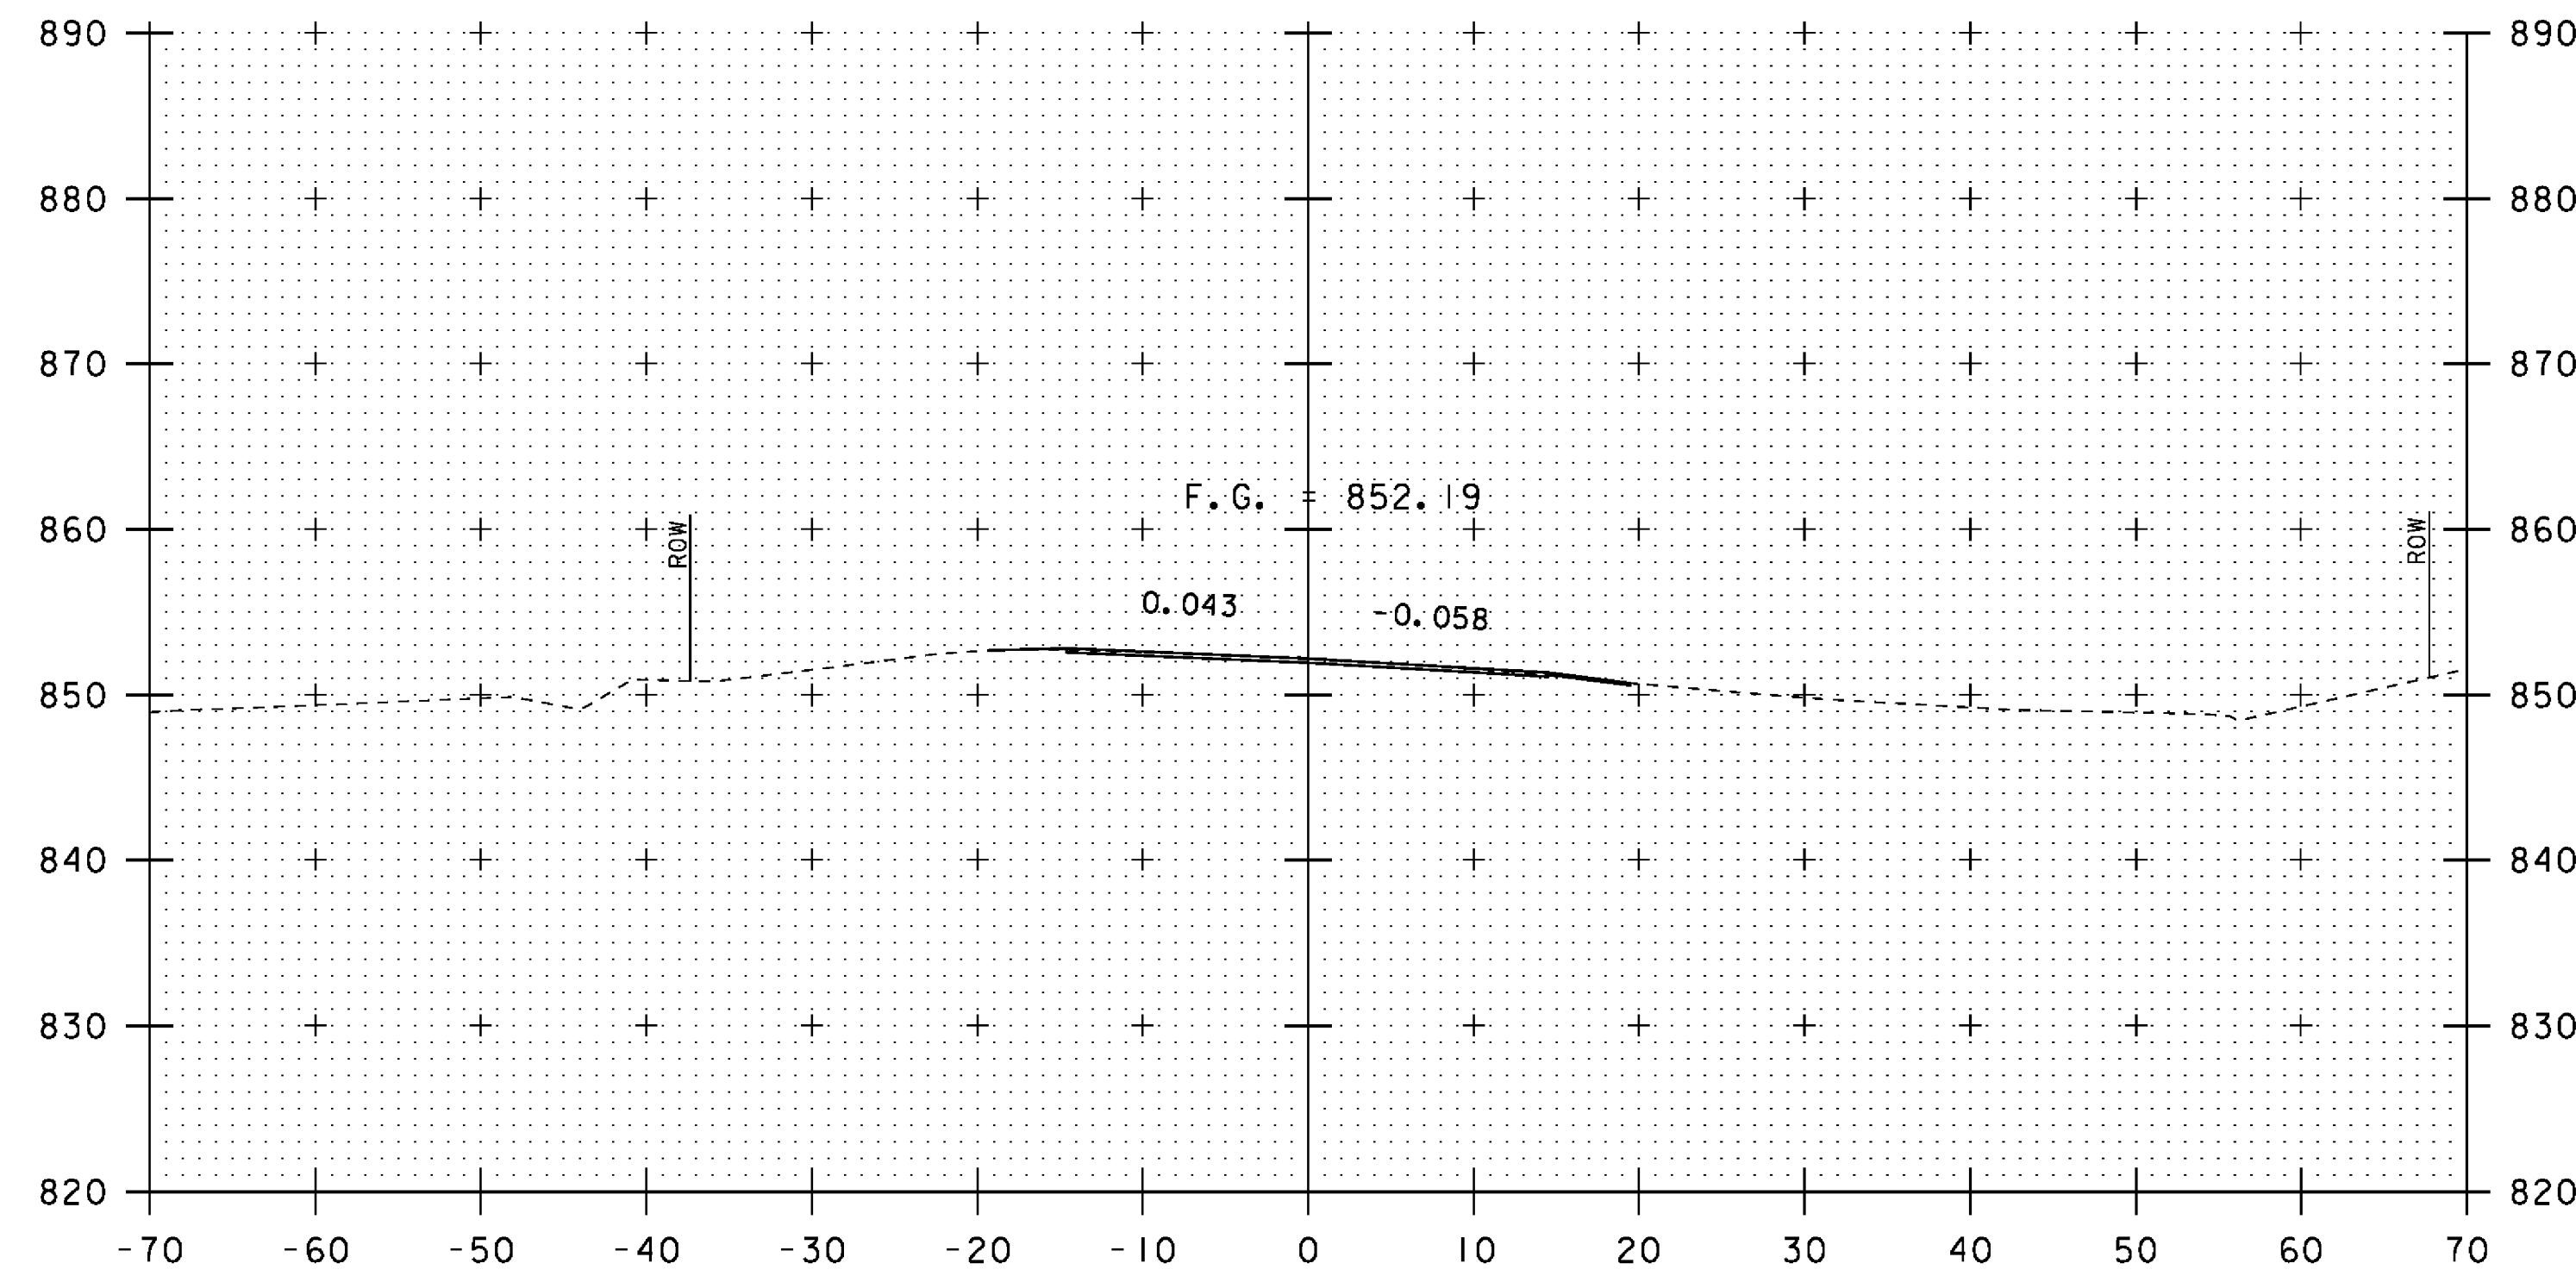


258+50

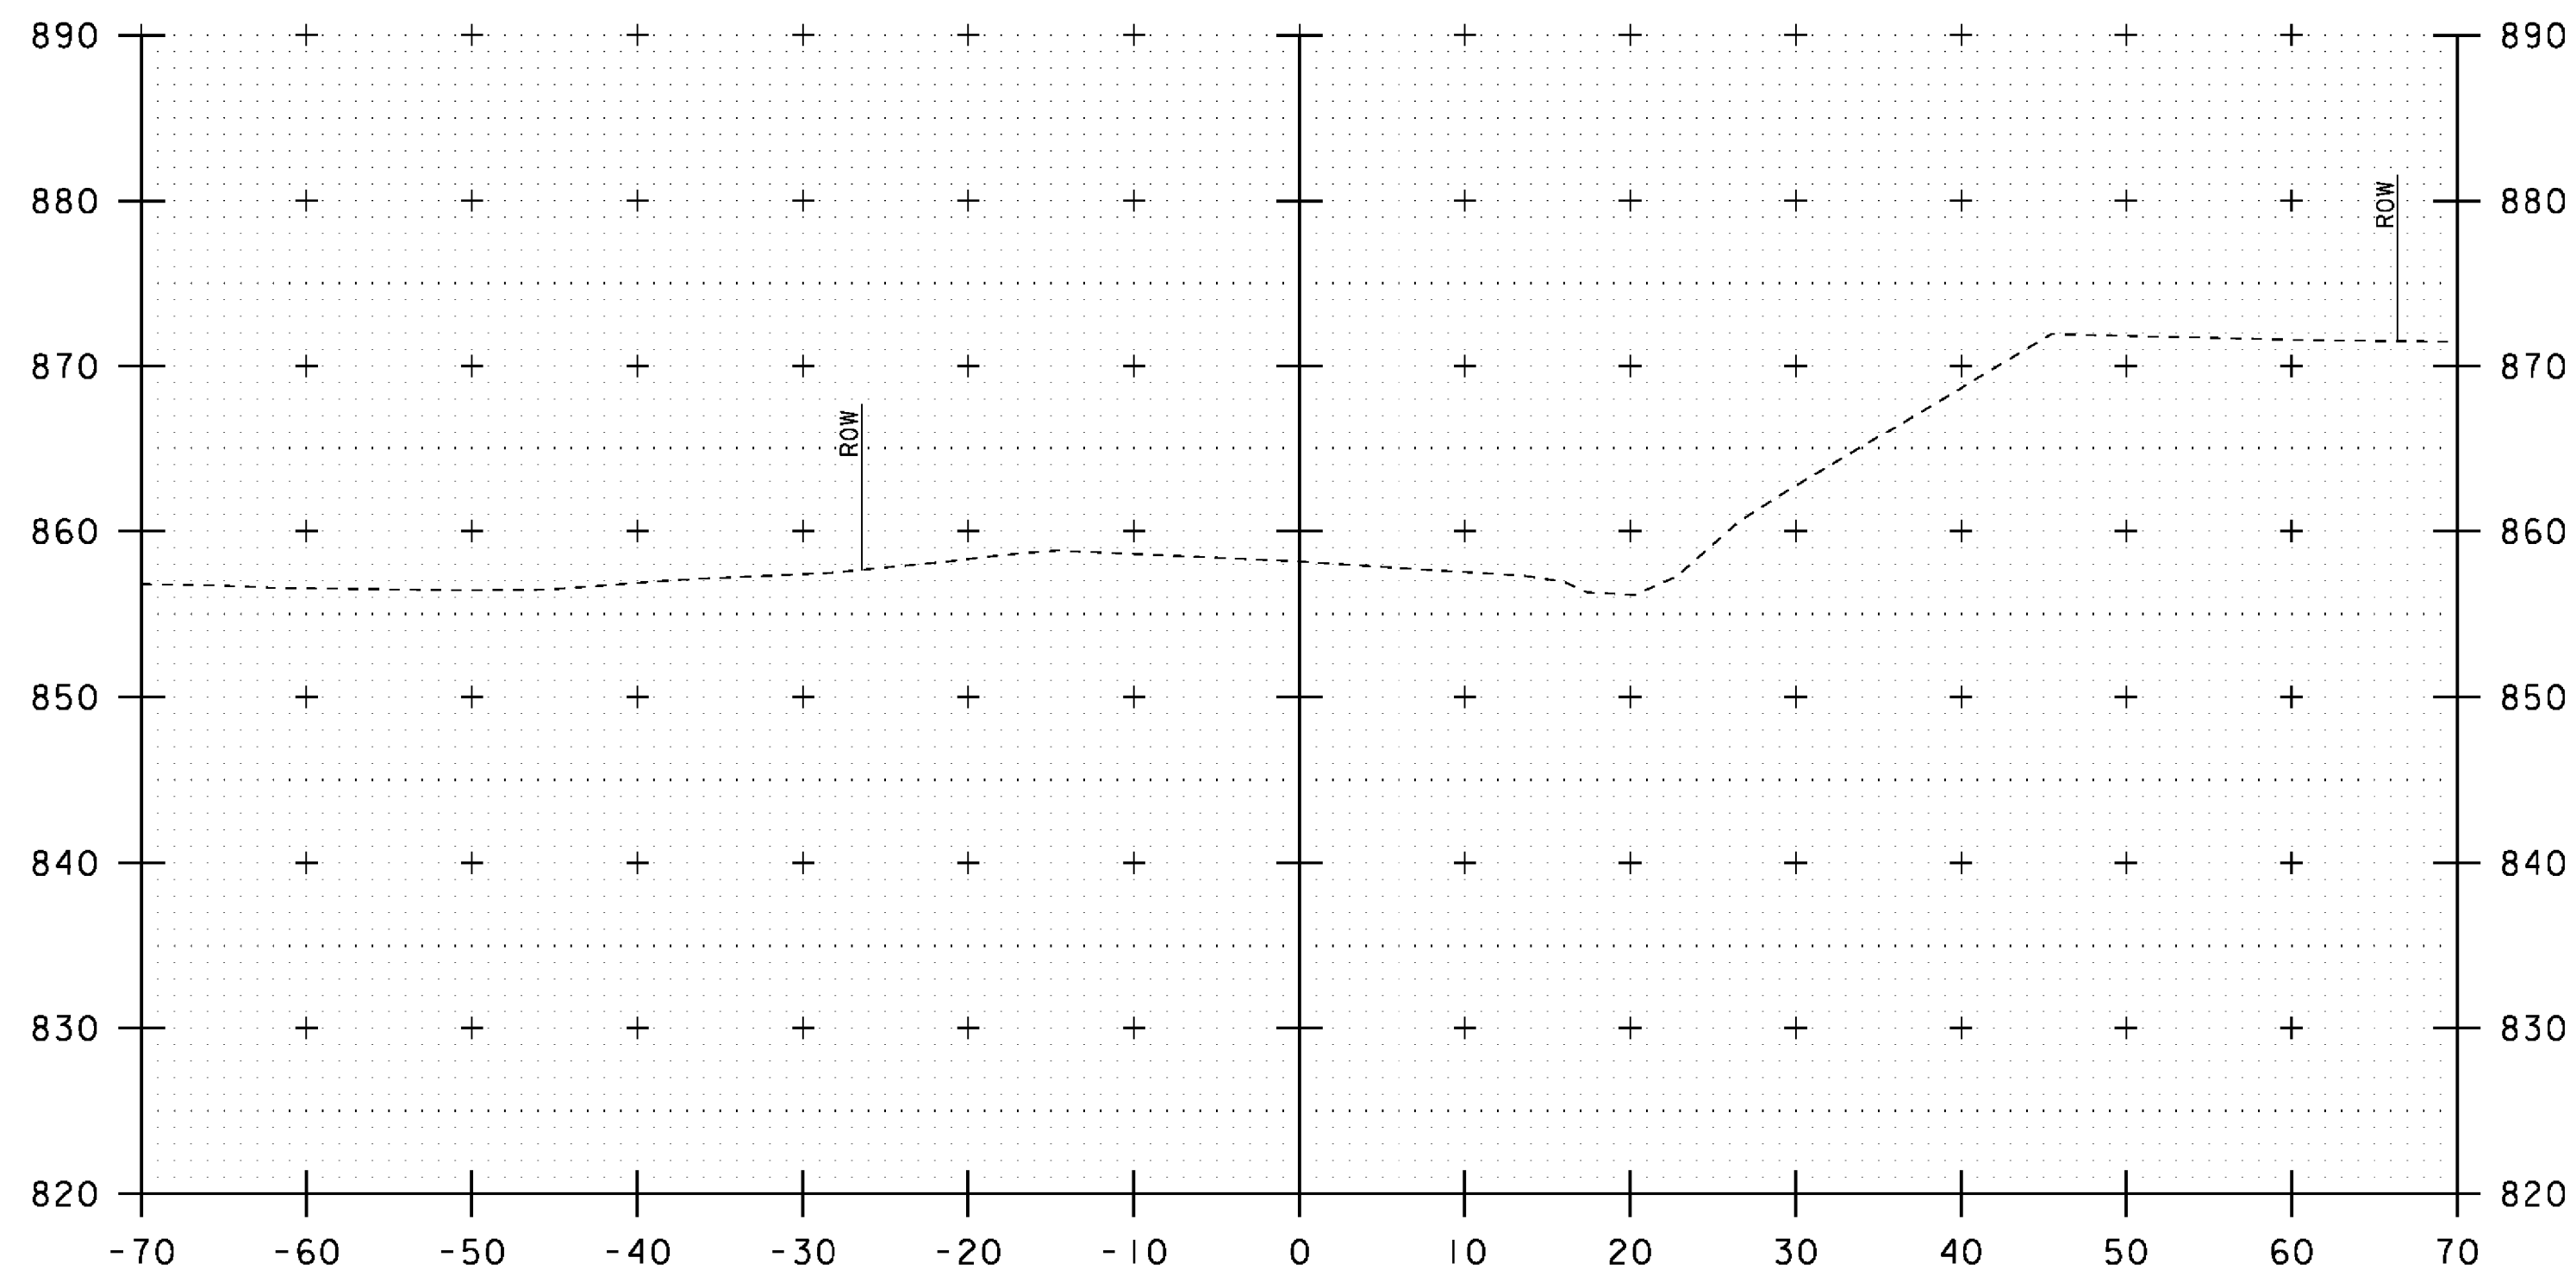


257+75

BEGIN 5' PAVED APRON
STA 258+33.01 RT

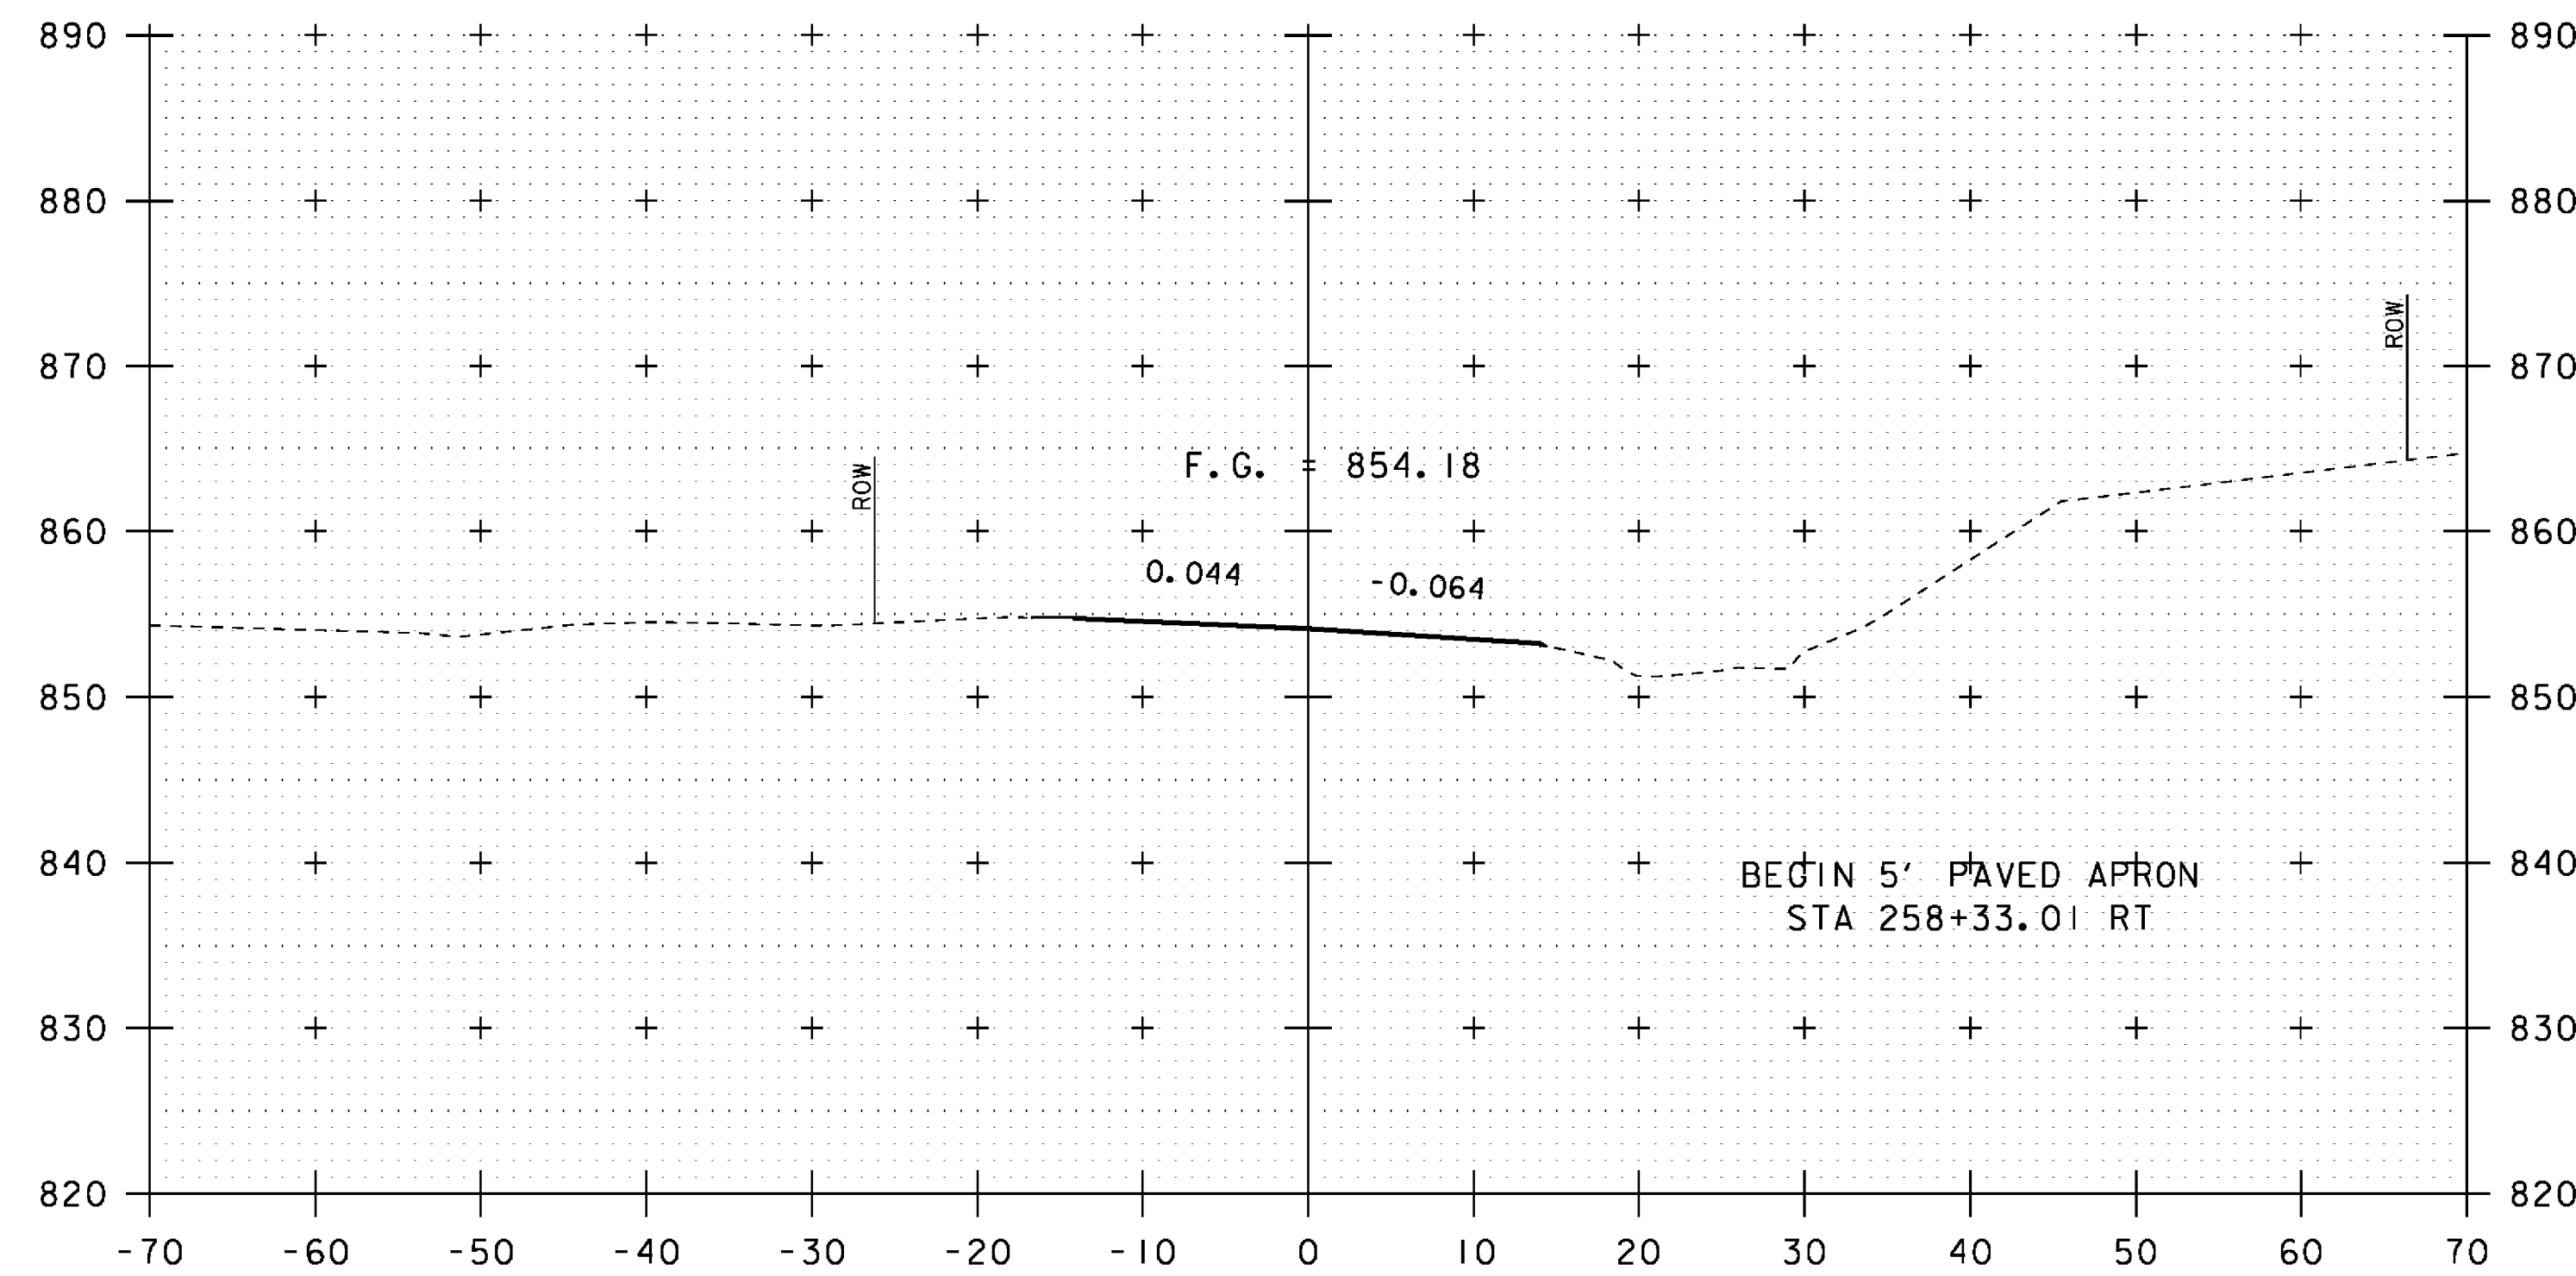

258+25

NOTE: REVISED SHEET
FOR POST IRENE

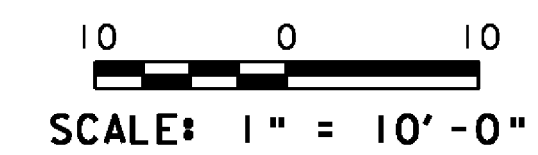

STA. 257+75 TO STA. 258+50

PROJECT NAME: PITTSFIELD-STOCKBRIDGE
PROJECT NUMBER: STP 022-1(22)S

FILE NAME: s00b122xsl.dgn
PROJECT LEADER: C. P. WILLIAMS
DESIGNED BY: G. ROY
VT 100 CROSS SECTIONS (1)

PLOT DATE: 26-OCT-2011
DRAWN BY: G. ROY
CHECKED BY: R. YOUNG
SHEET 34 OF 41