




259+00

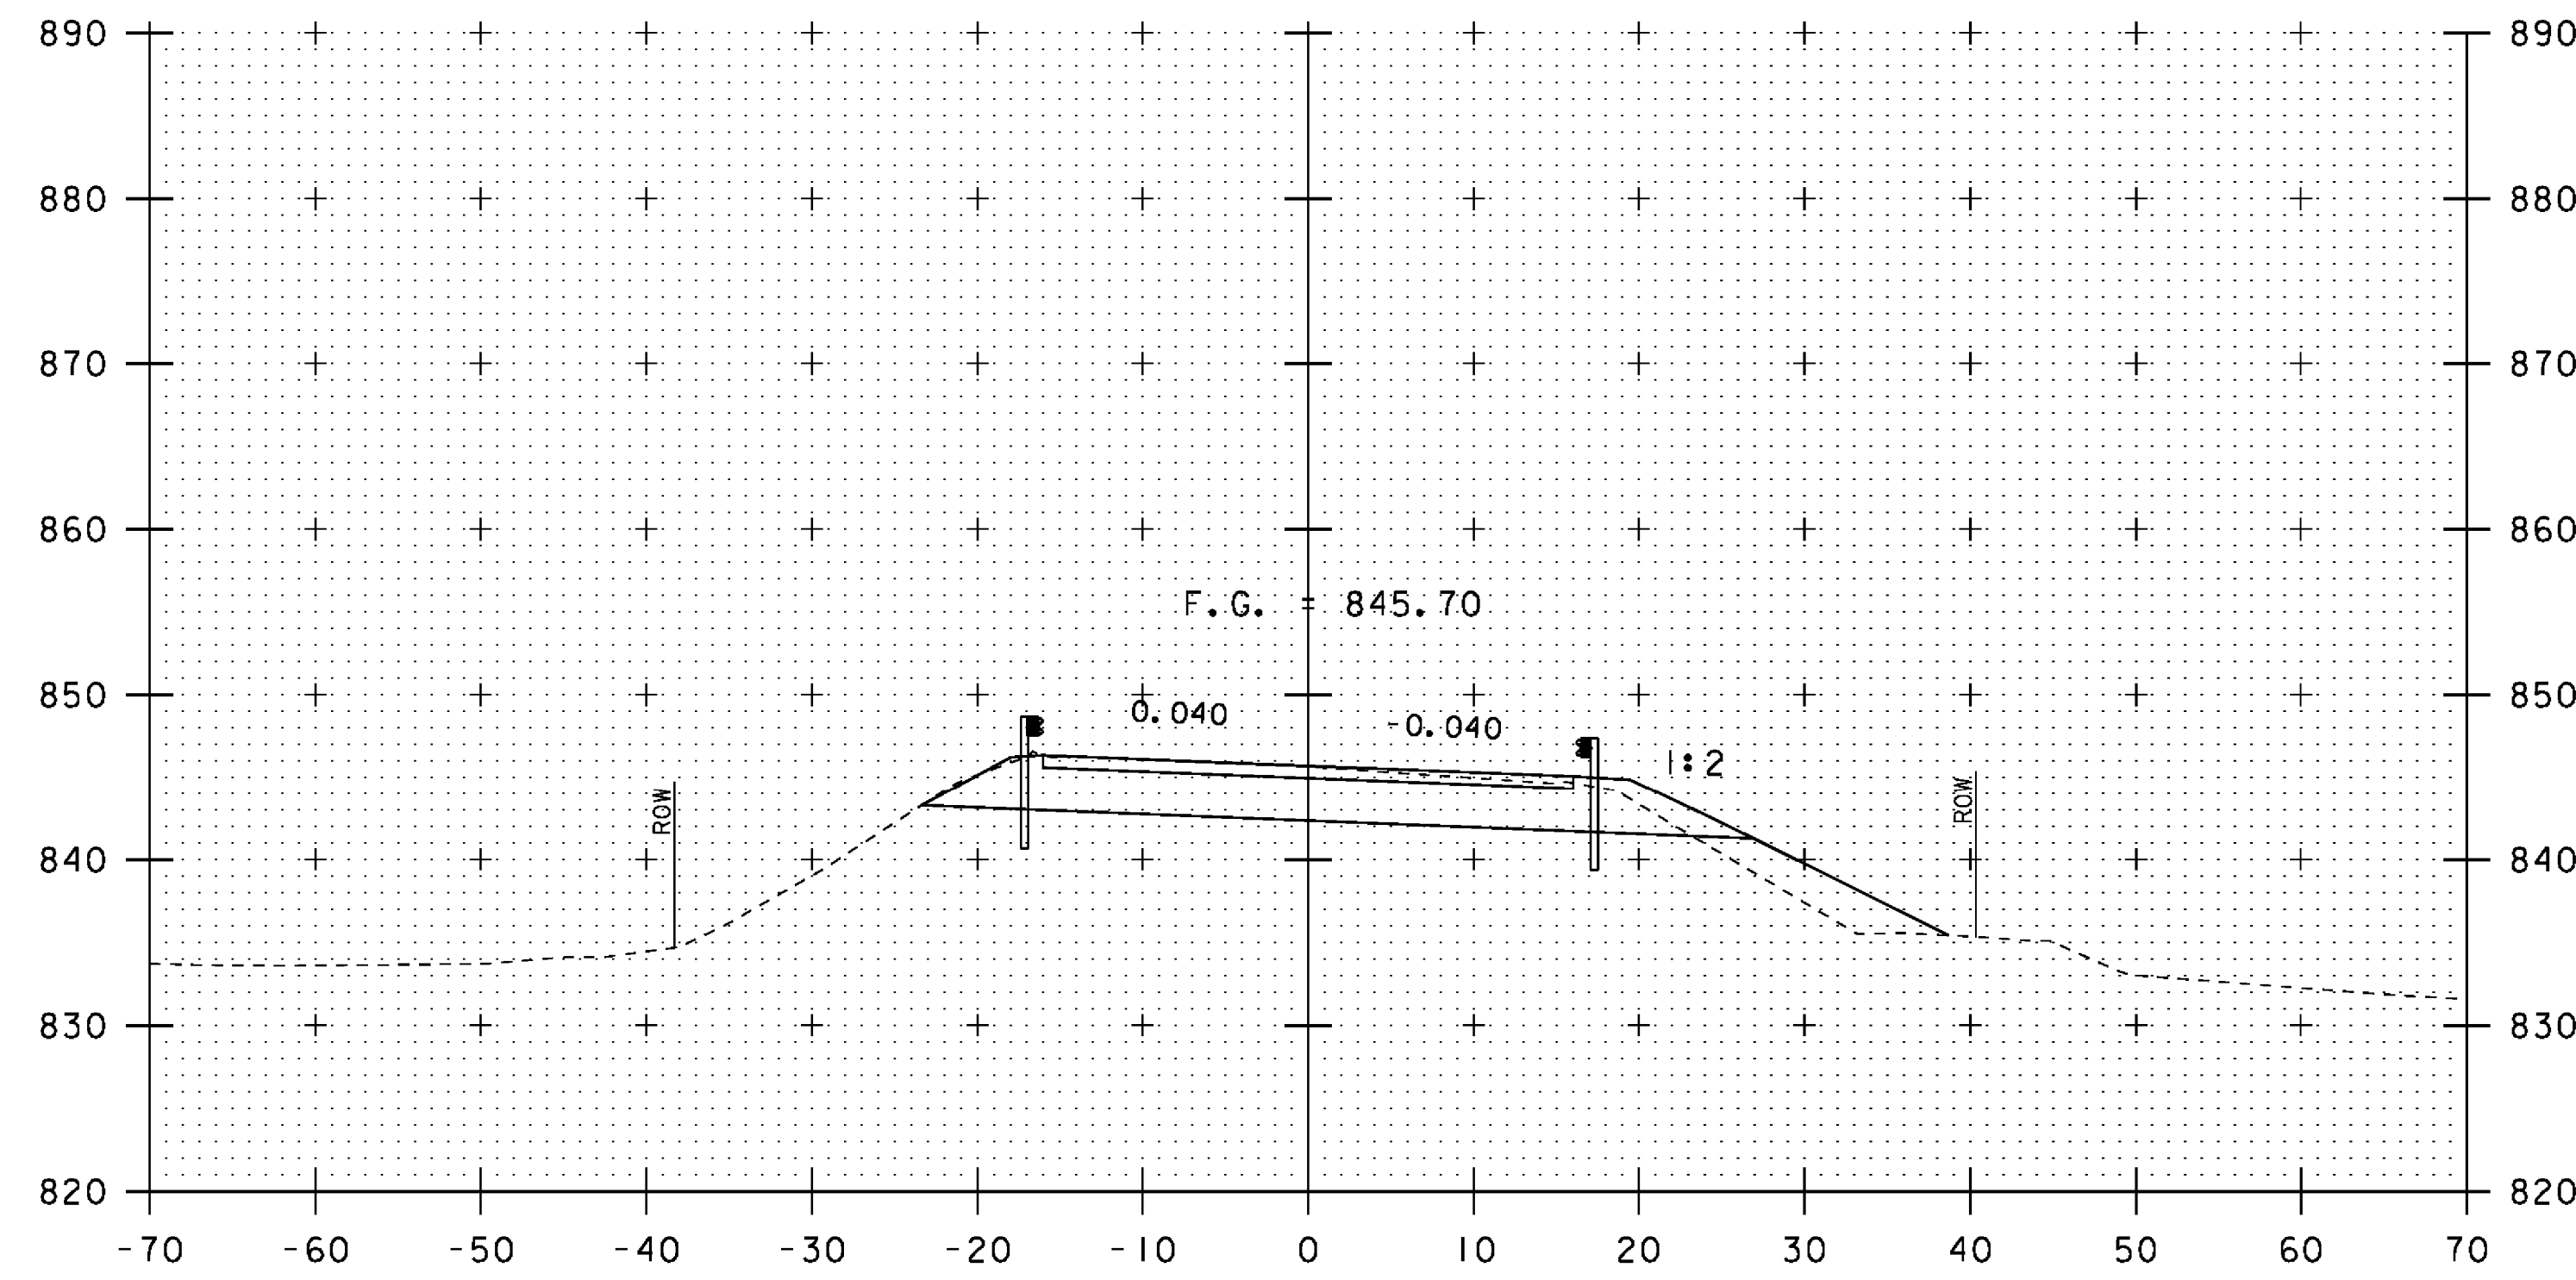

259+50

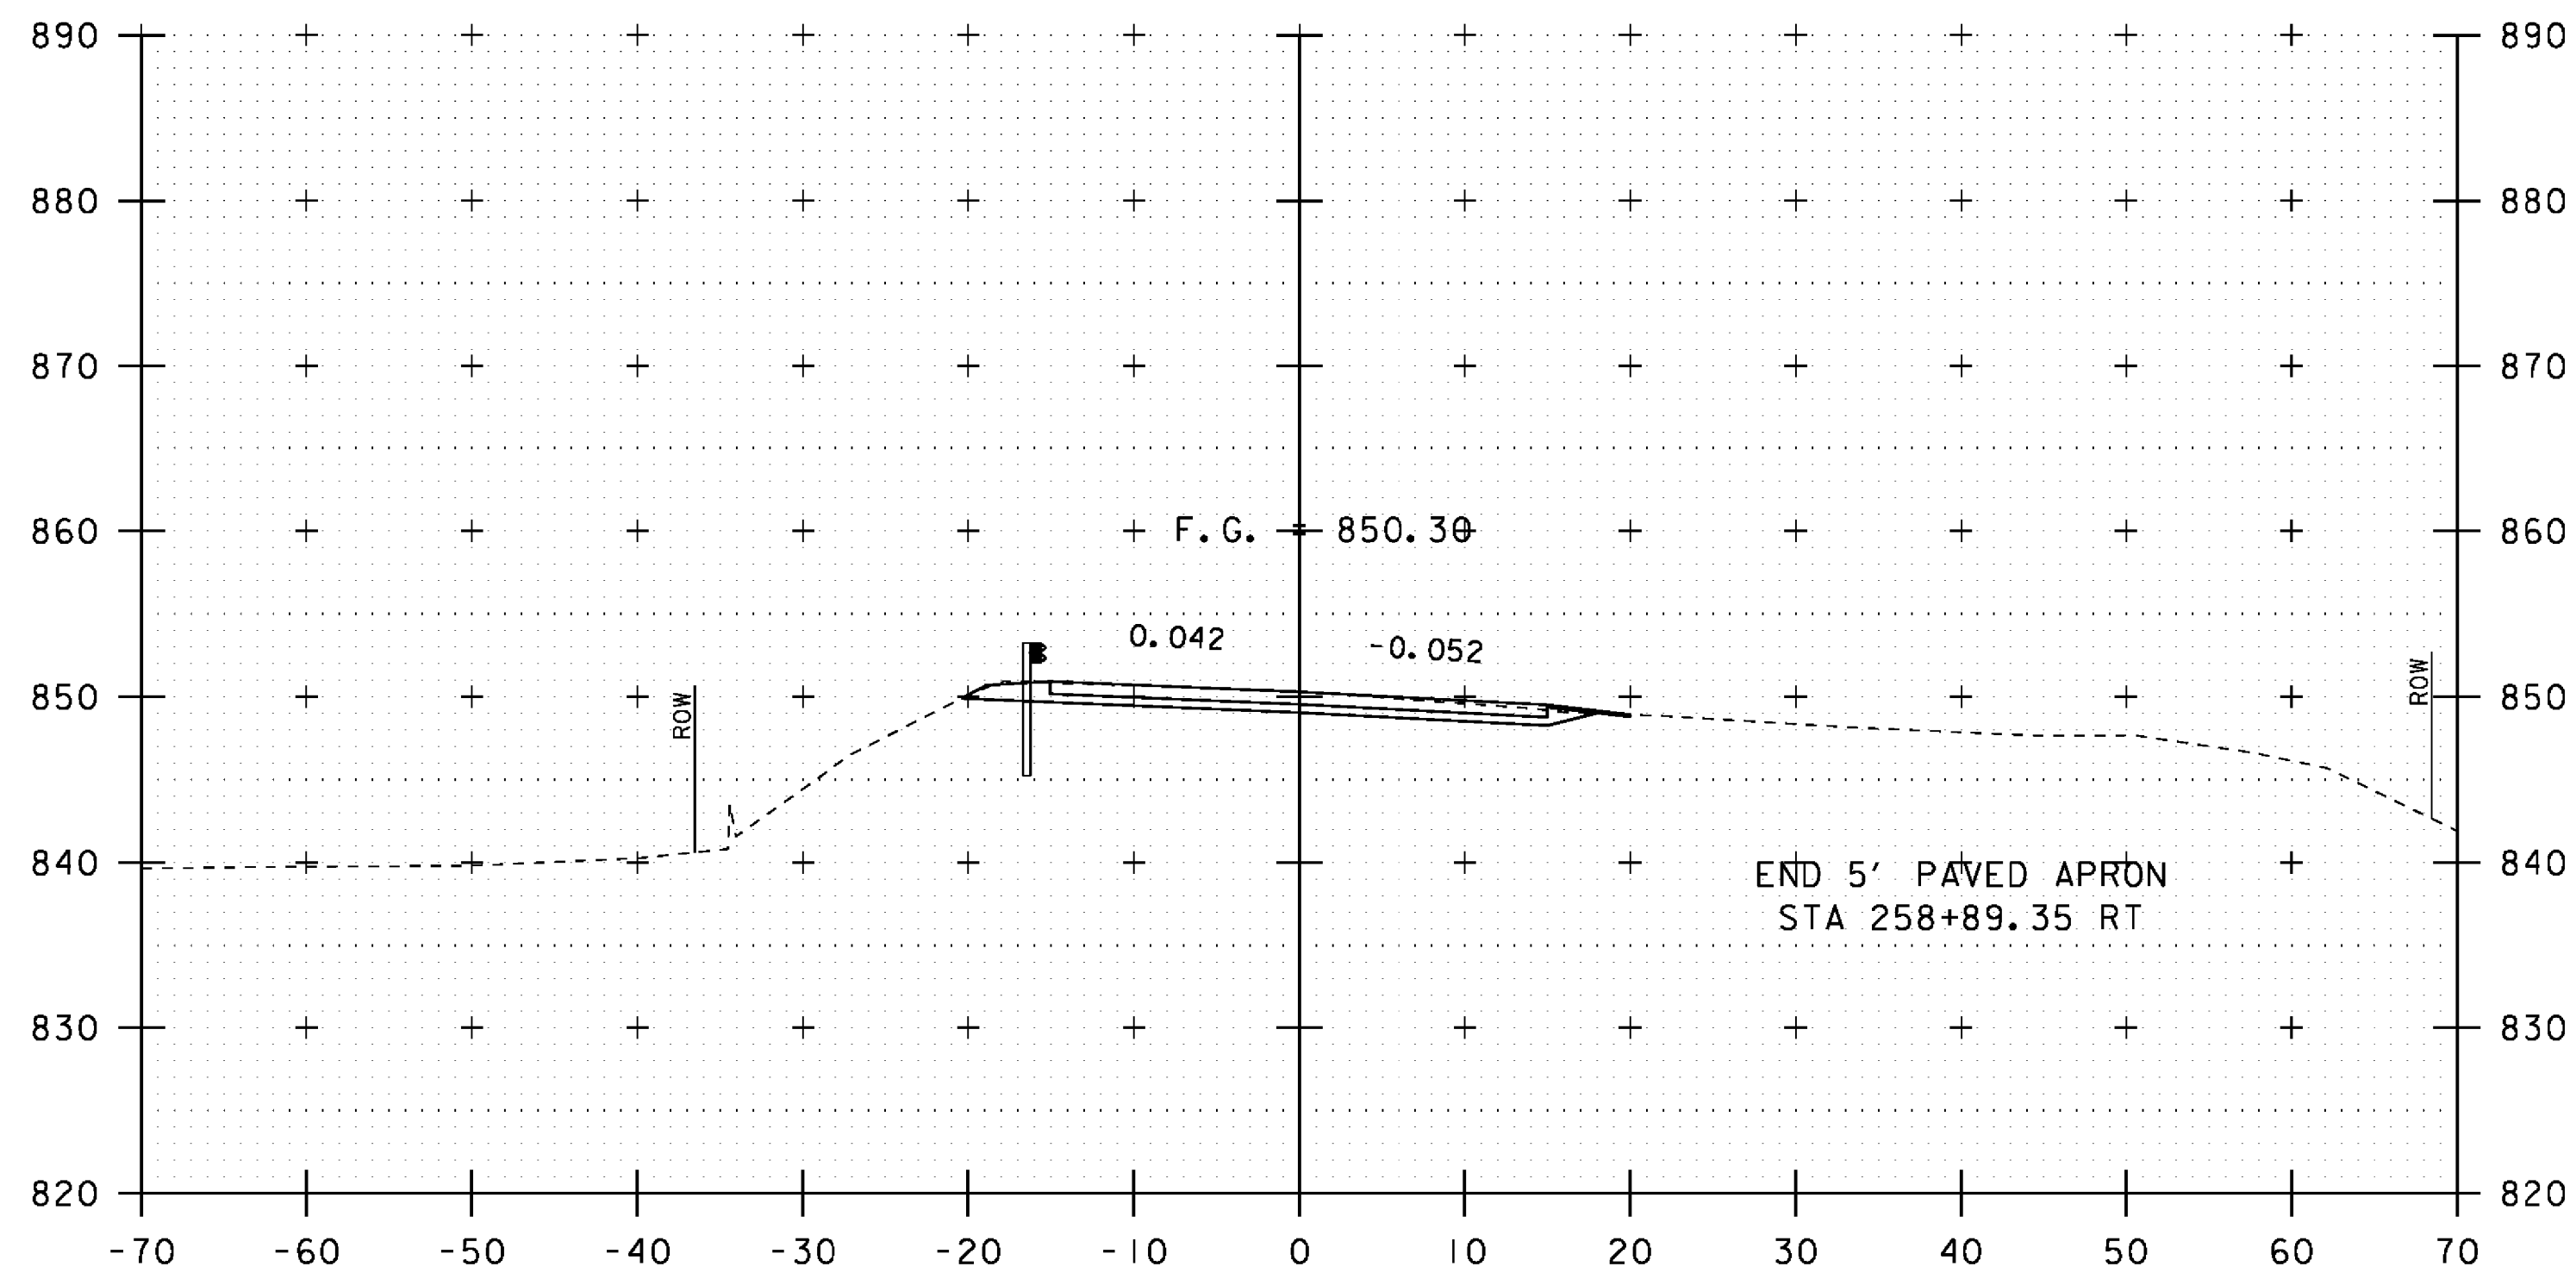


258+75

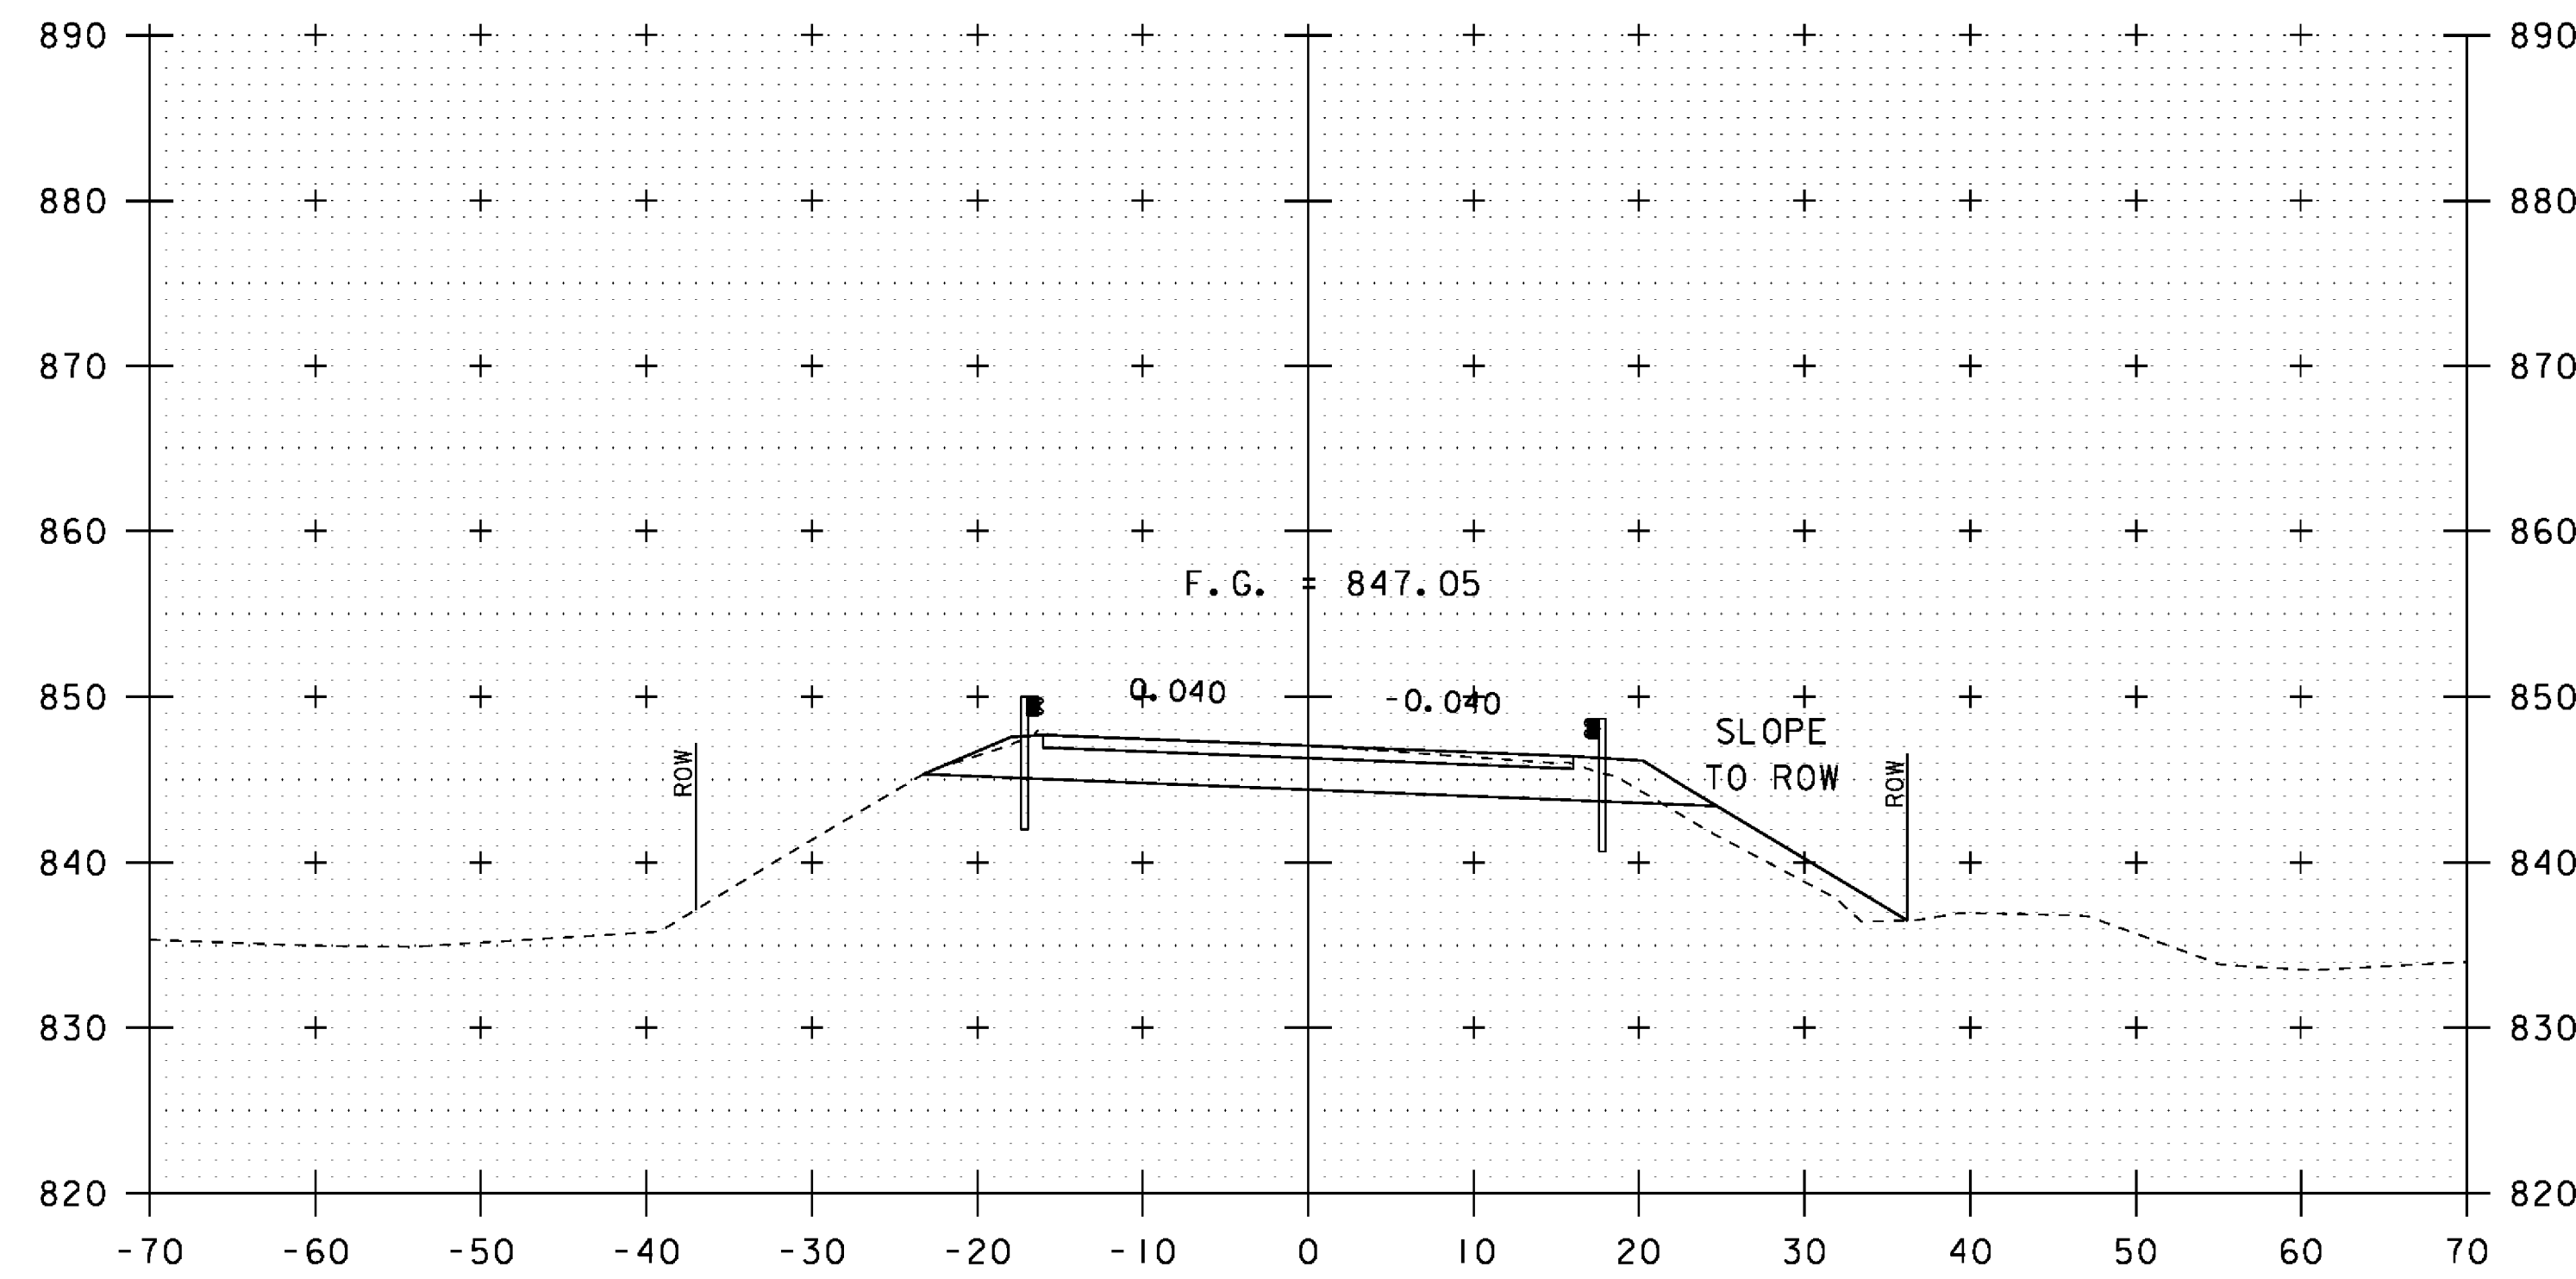

259+25

END APPROACH
BEGIN PROJECT
STA 259+25.00

NOTE: REVISED SHEET
FOR POST IRENE

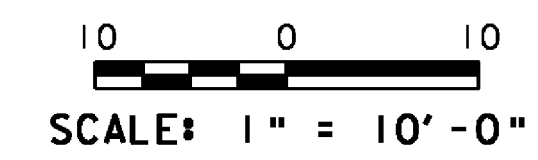

STA. 258+75 TO STA. 259+50

PROJECT NAME: PITTSFIELD-STOCKBRIDGE
PROJECT NUMBER: STP 022-1(22)S

FILE NAME: s00b122xsl.dgn
PROJECT LEADER: C. P. WILLIAMS
DESIGNED BY: G. ROY
VT 100 CROSS SECTIONS (2)

PLOT DATE: 26-OCT-2011
DRAWN BY: G. ROY
CHECKED BY: R. YOUNG
SHEET 35 OF 41