




259+00

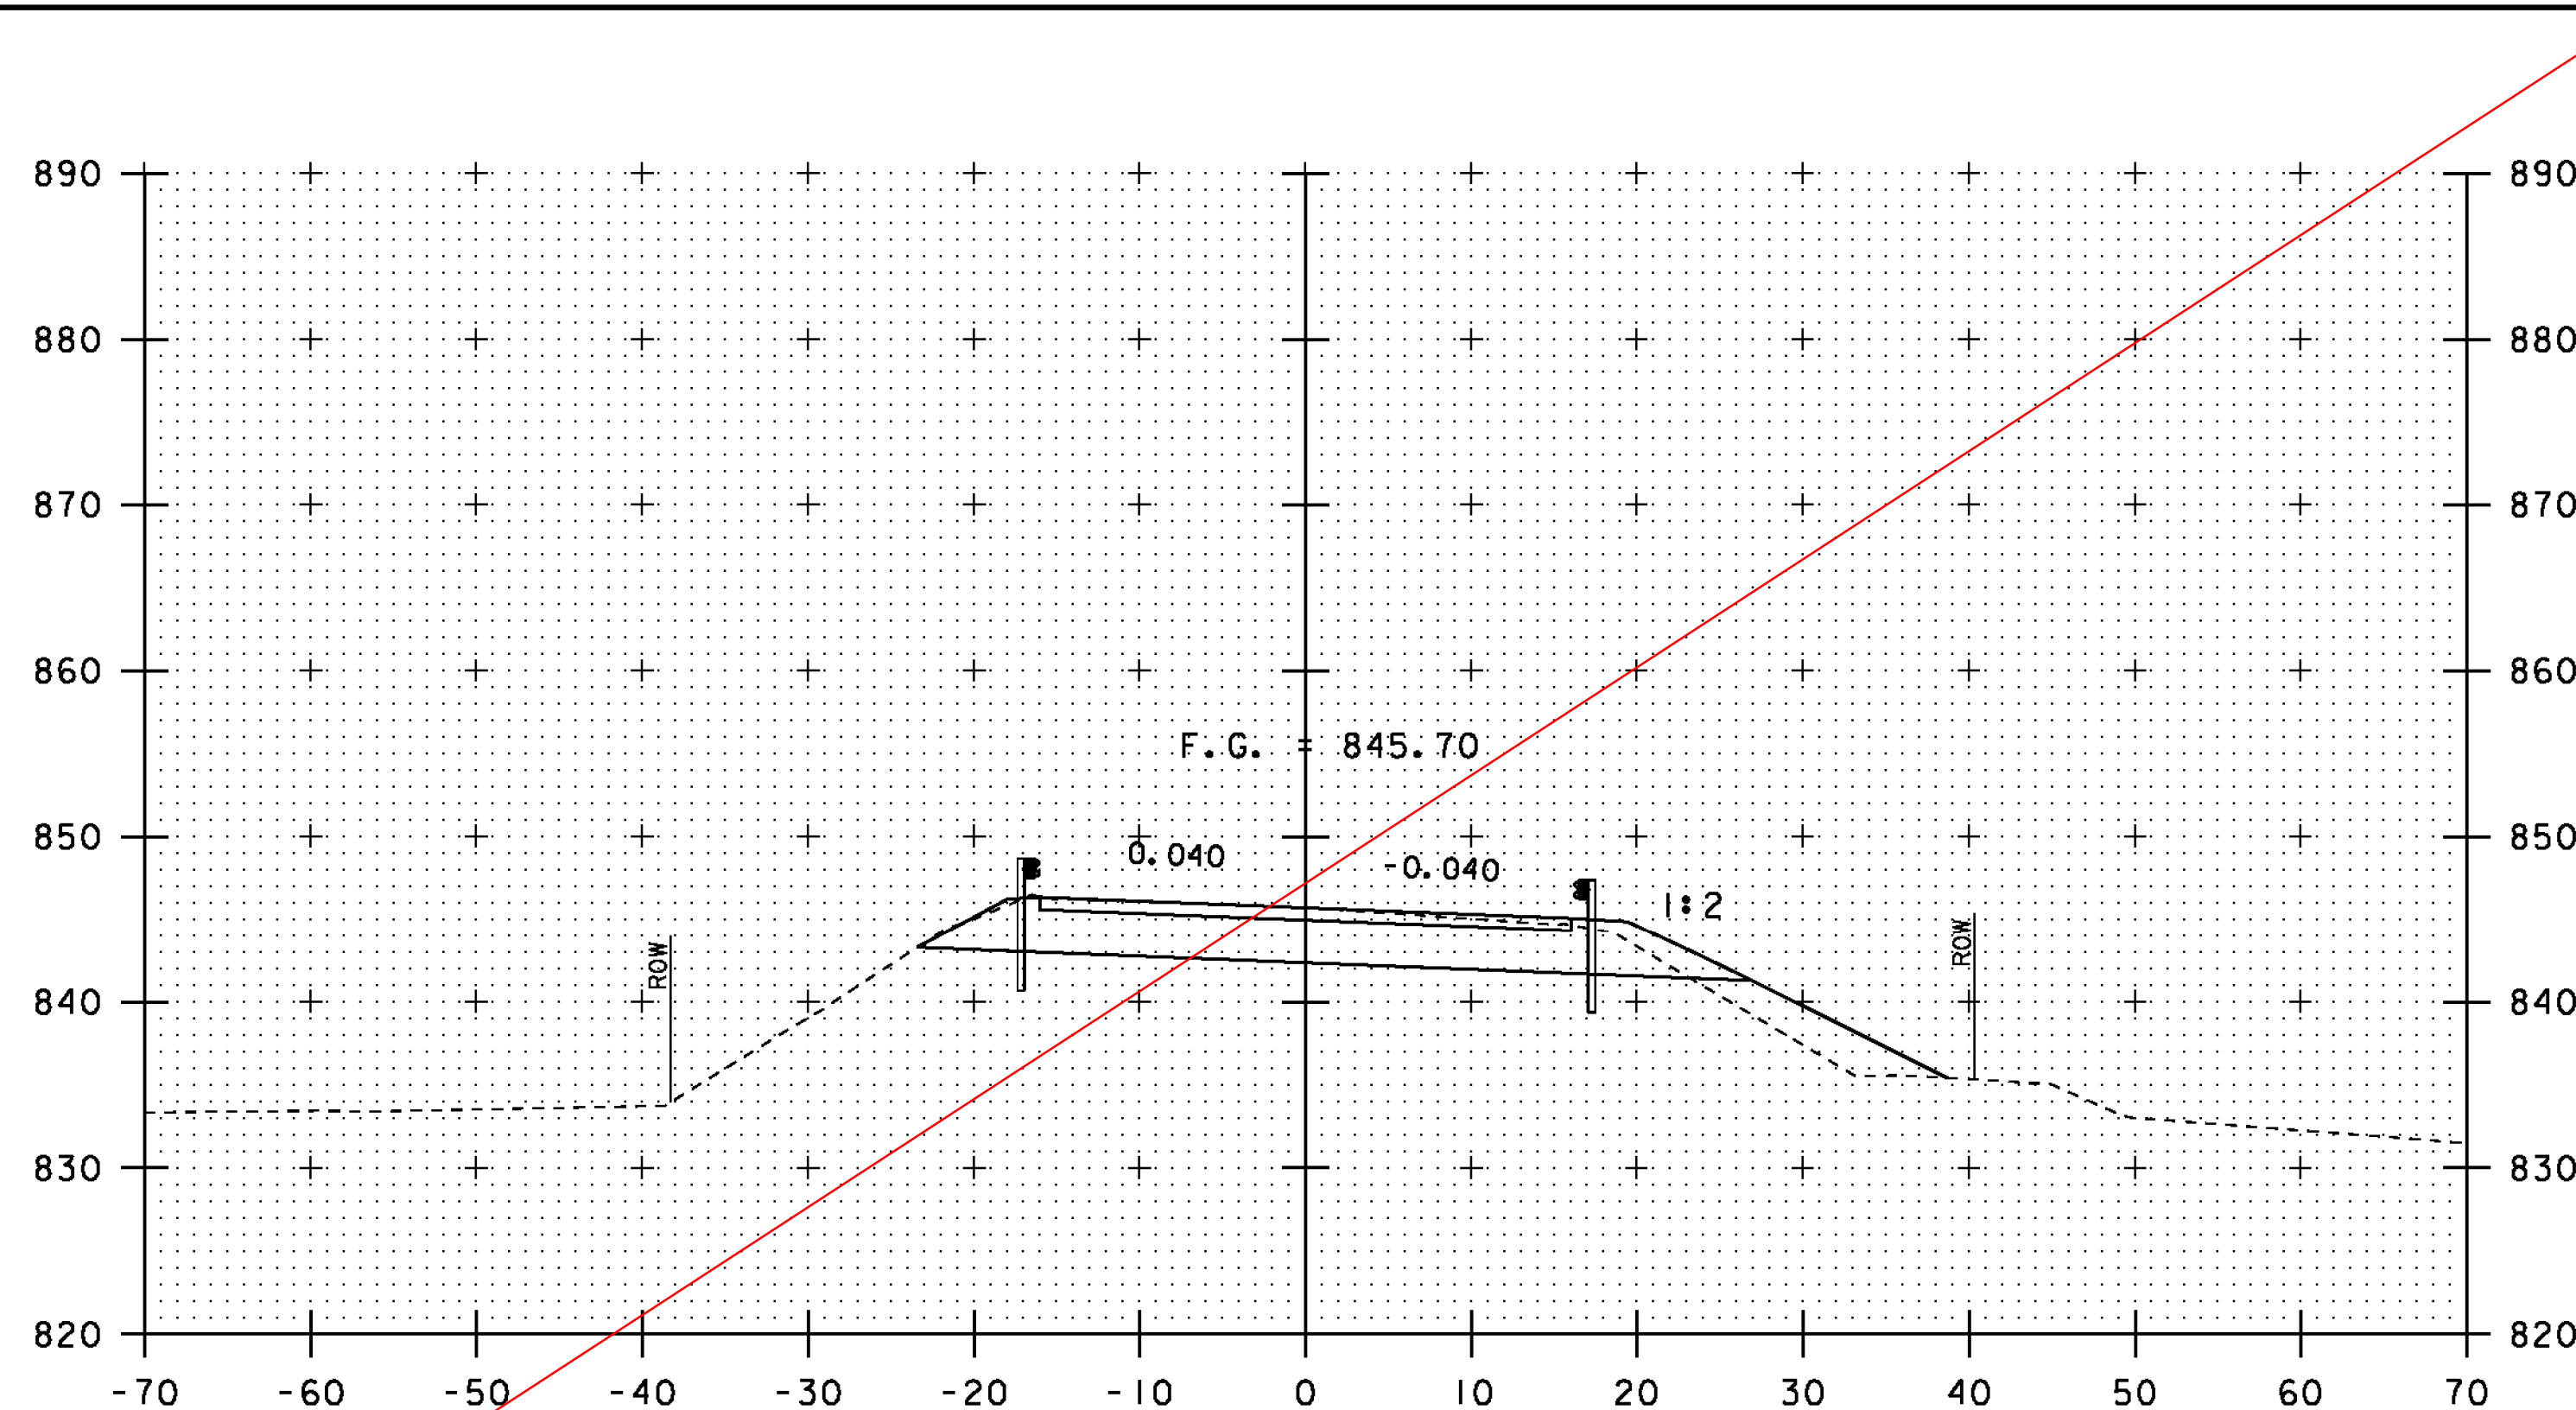

259+50

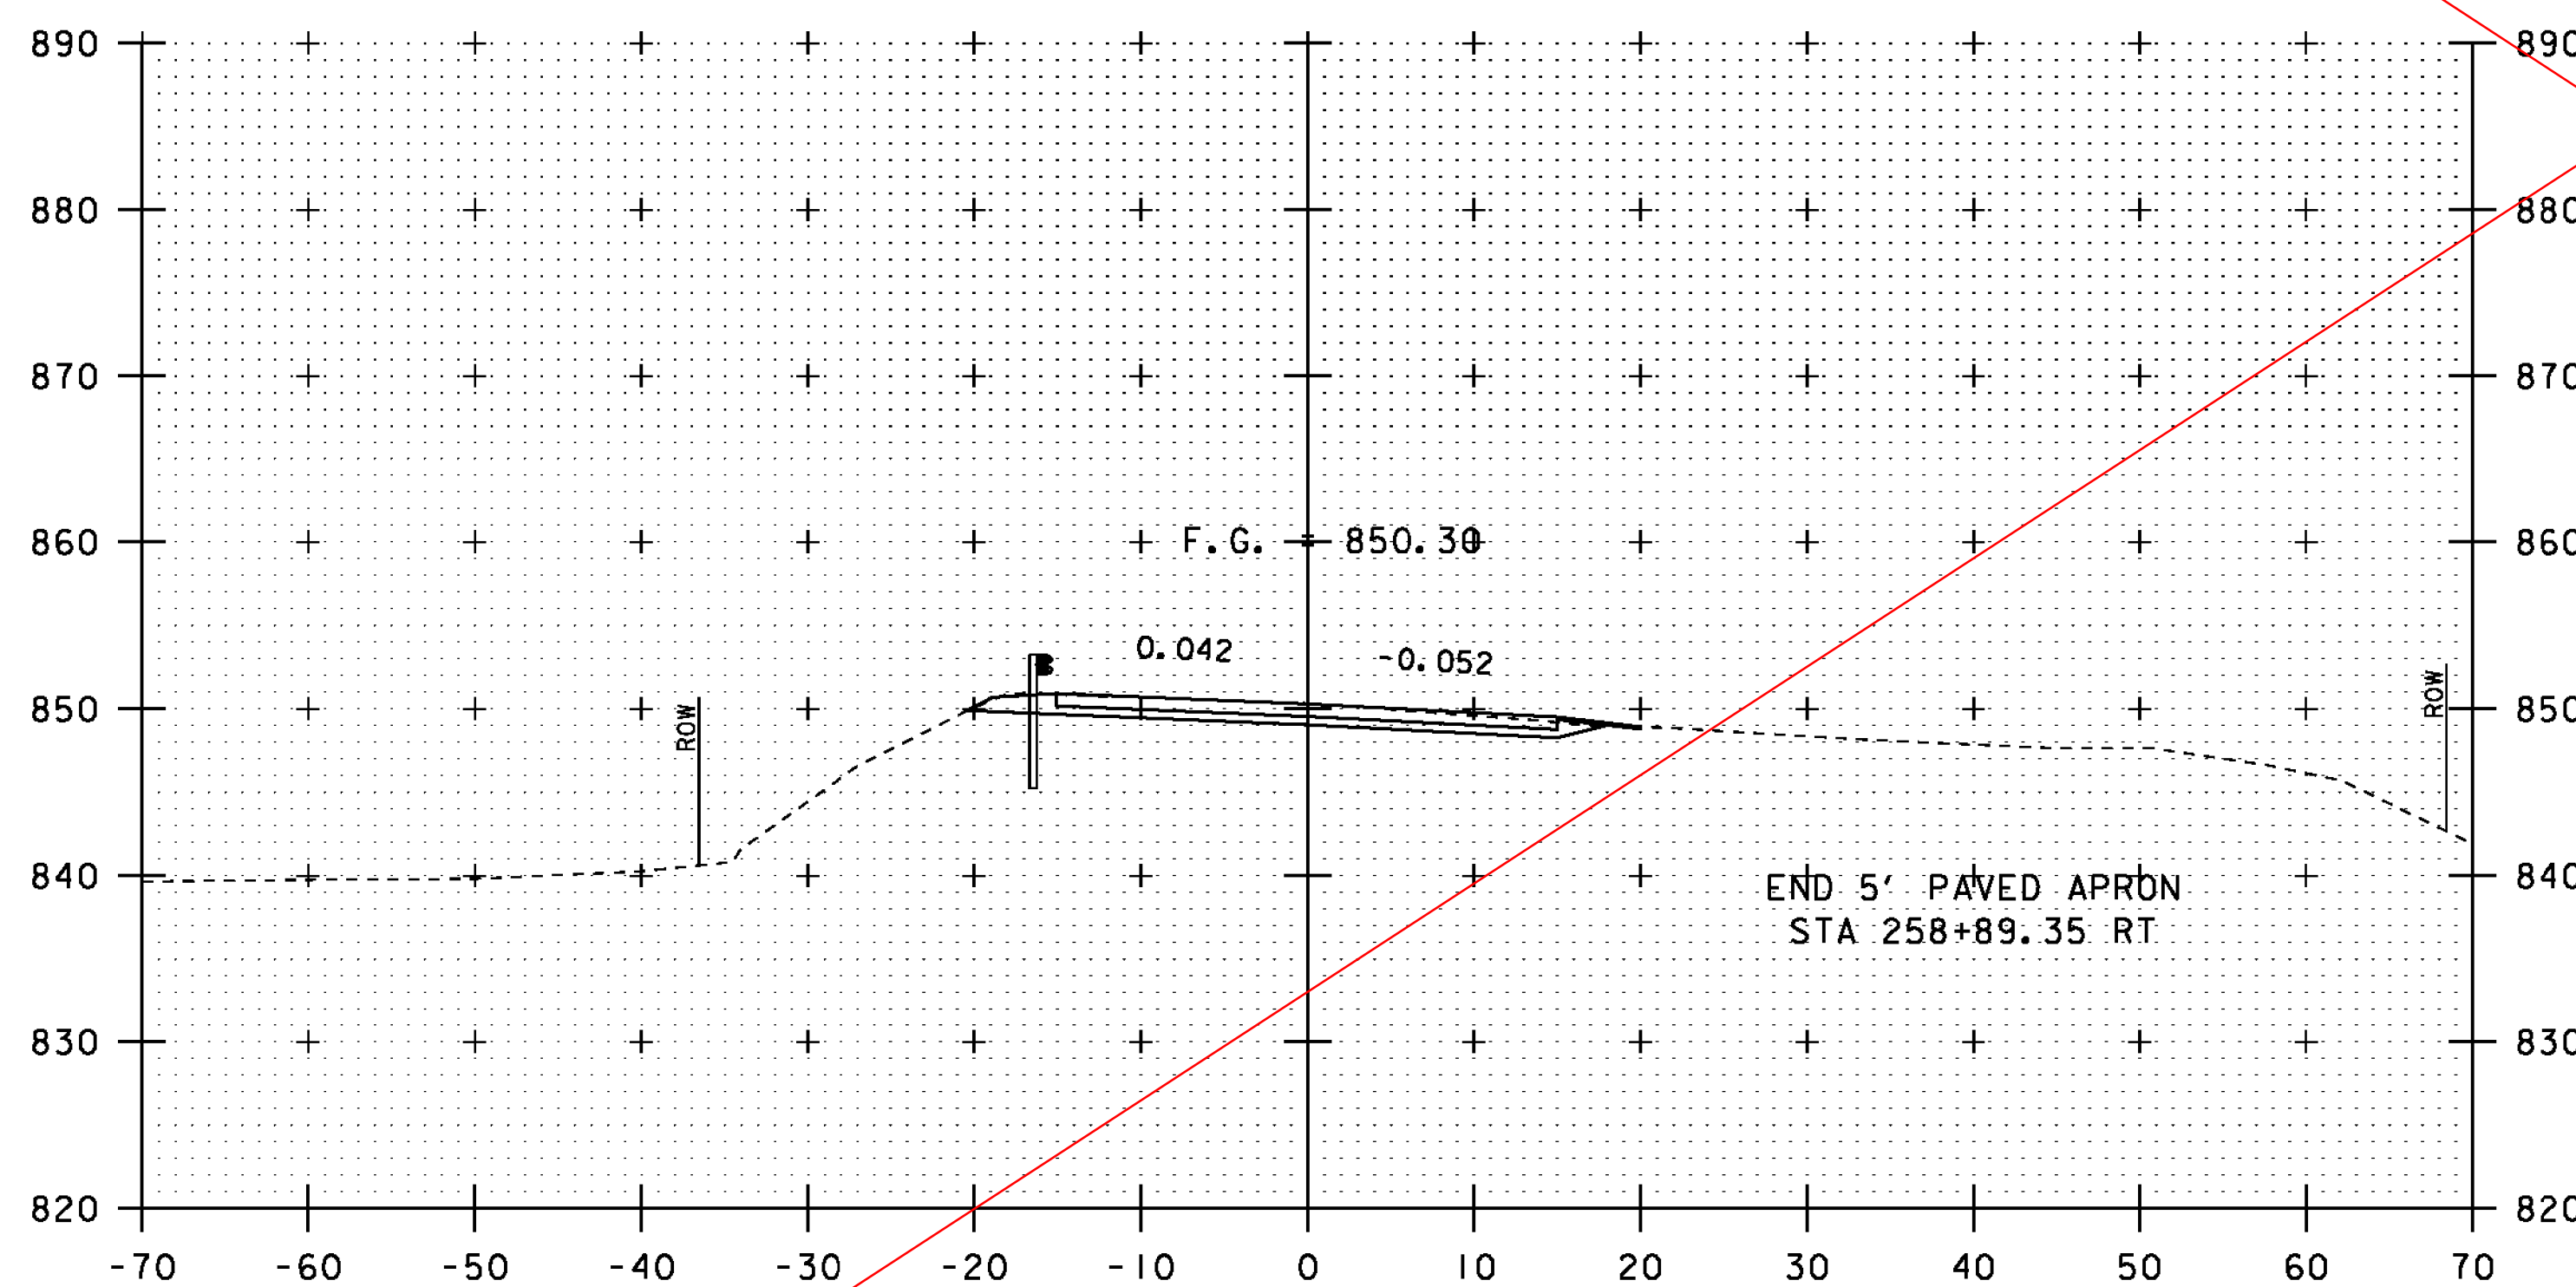


258+75

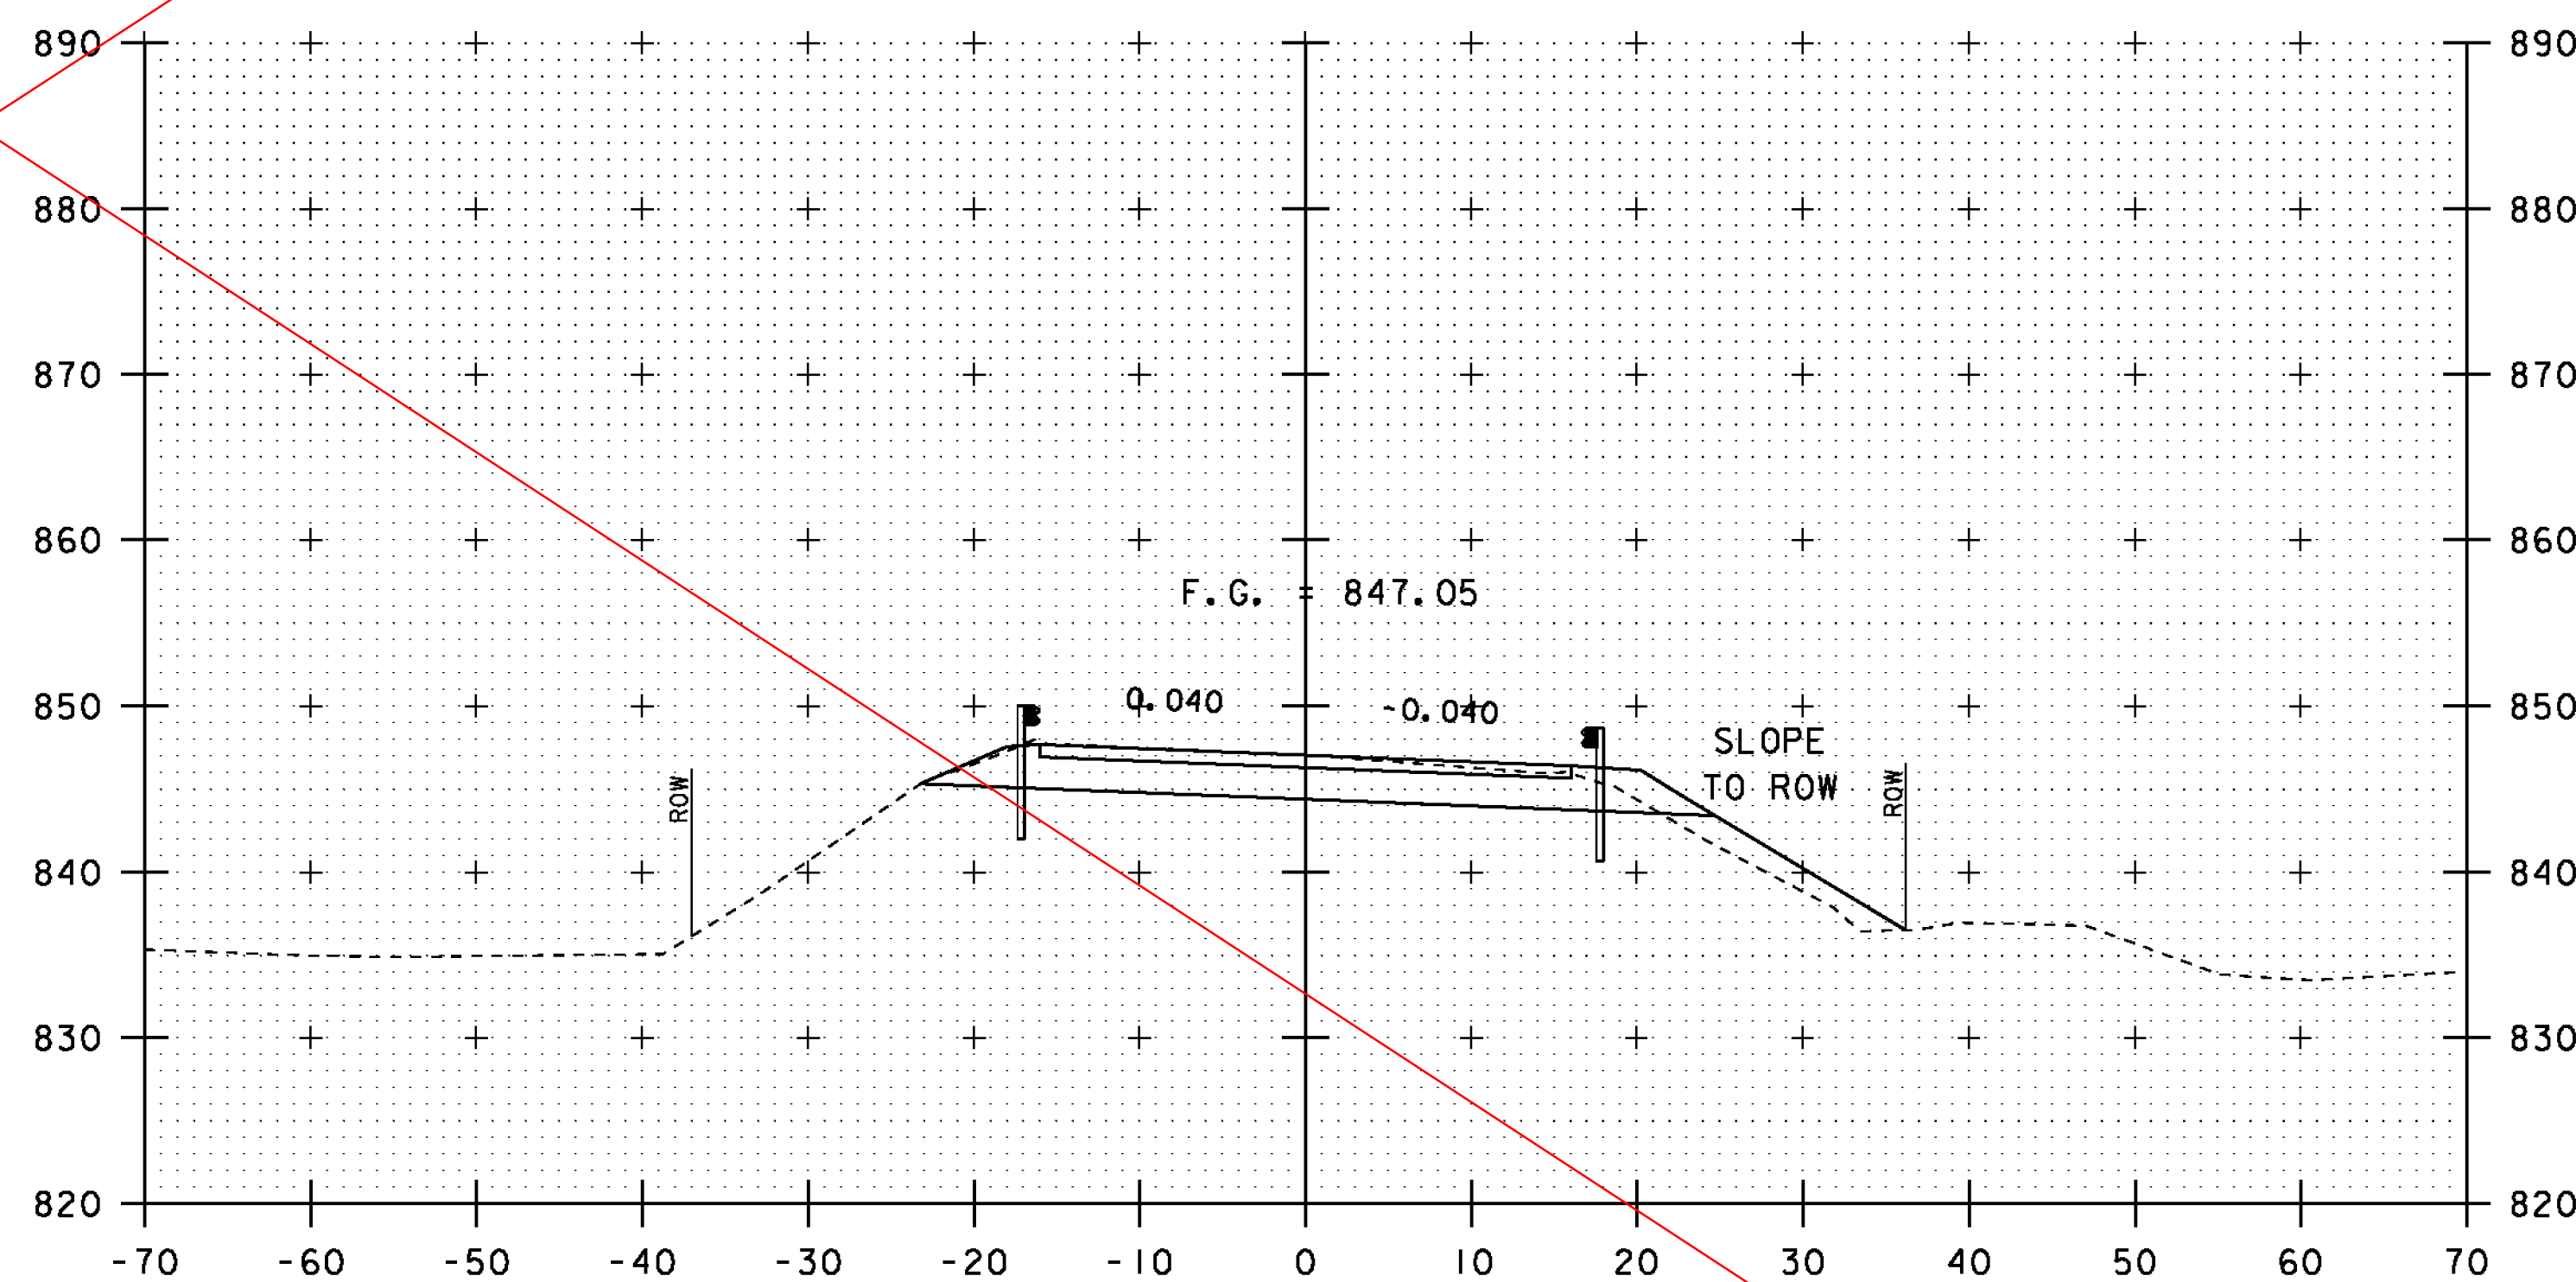

259+25

END APPROACH
BEGIN PROJECT
STA 259+25.00

NOTE: SEE REVISED SHEET
DATED 26-OCT-2011
FOR POST IRENE REVISIONS

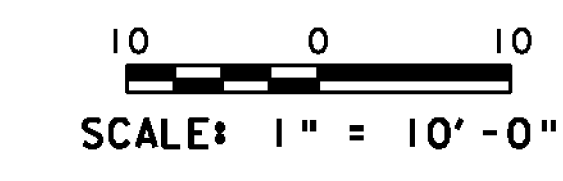

STA. 258+75 TO STA. 259+50

PROJECT NAME: PITTSFIELD-STOCKBRIDGE	PLOT DATE: 02-SEP-2011
PROJECT NUMBER: STP 022-1(22)S	DRAWN BY: G. ROY
FILE NAME: s00b122xsl.dgn	CHECKED BY: R. YOUNG
PROJECT LEADER: C. P. WILLIAMS	SHEET 35 OF 41
DESIGNED BY: G. ROY	
VT 100 CROSS SECTIONS (2)	